



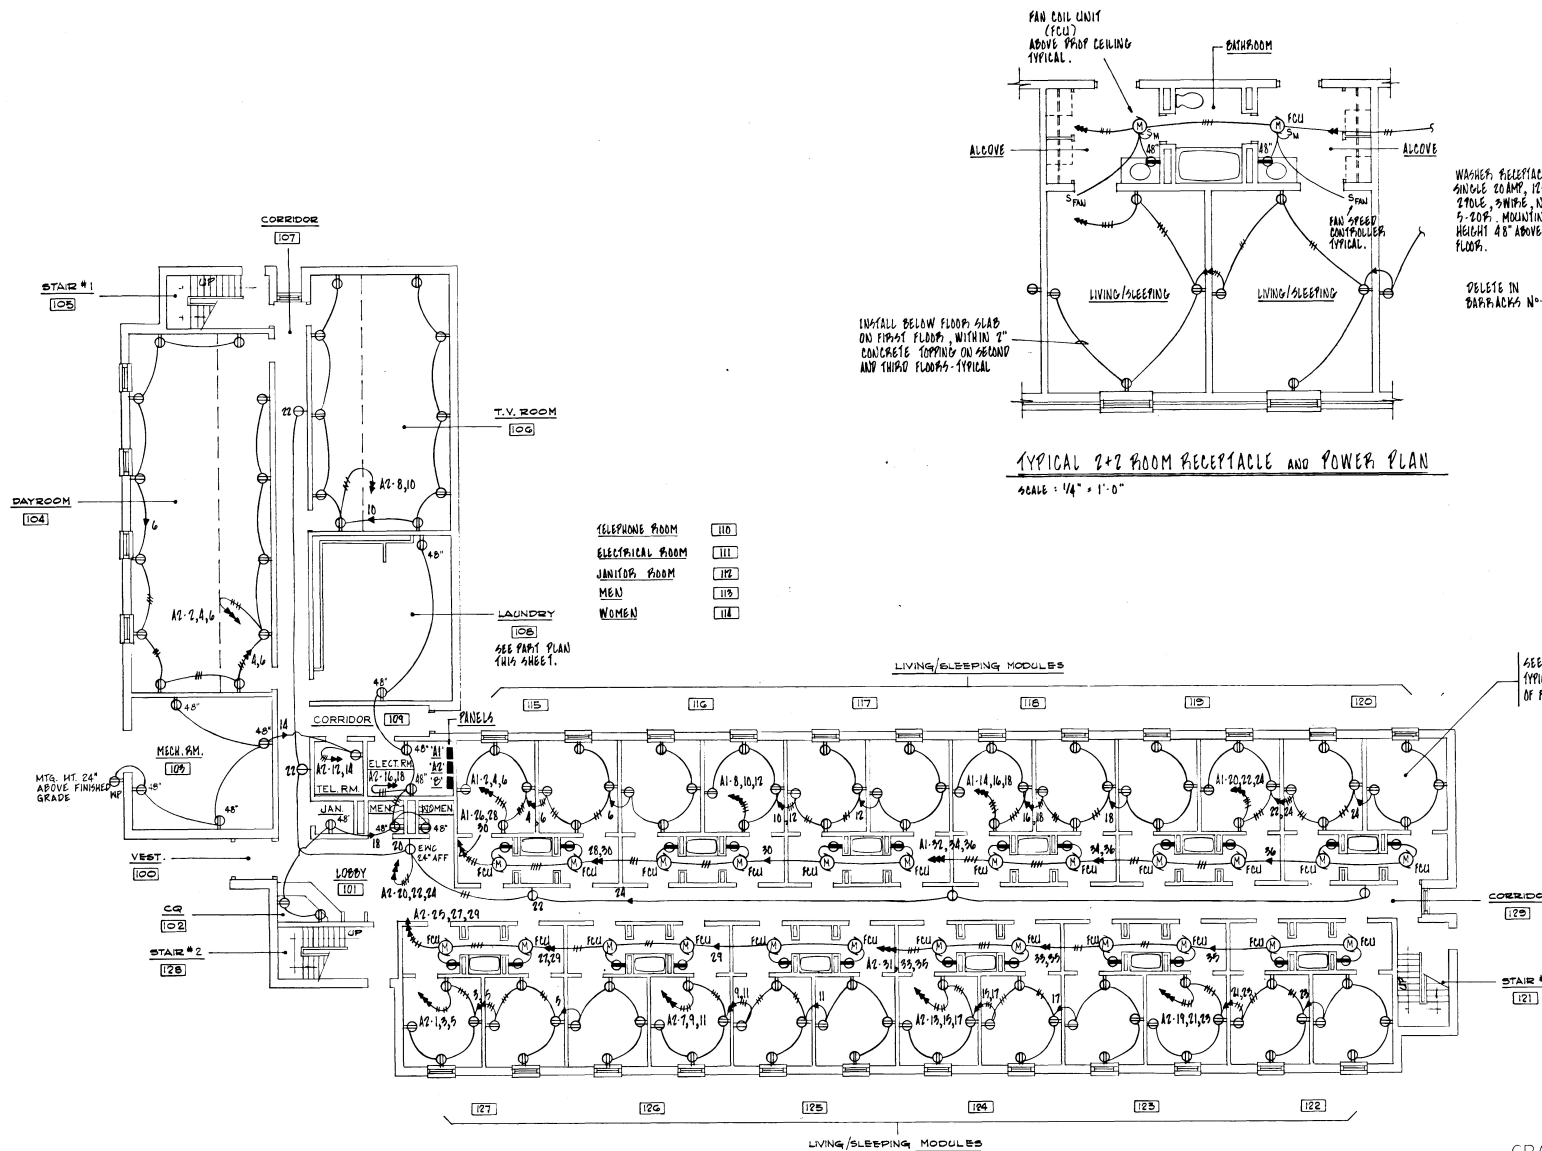


FIRST FLOOR PLAN - RECEPTACLES

SCALE: 1/8" = 1'-0"

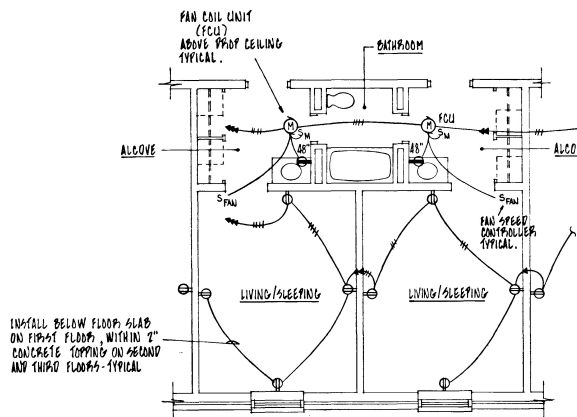

TYPICAL 2x2 ROOM RECEPTACLE AND POWER PLAN


SCALE: 1/4" = 1'-0"

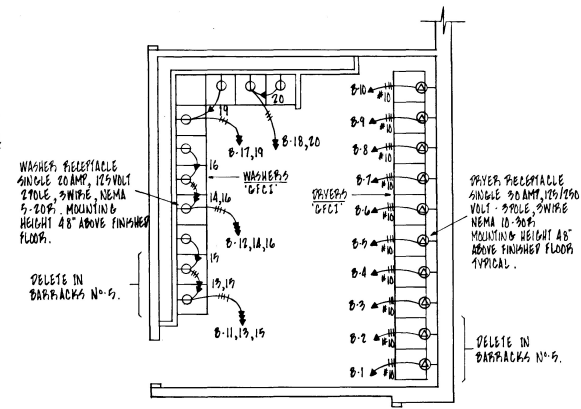

LAUNDRY ROOM PART PLAN

SCALE: 1/4" = 1'-0"

SEE 2x2 PLAN ABOVE FOR TYPICAL WIRING AND LOCATION OF FAN SPEED CONTROLLER.

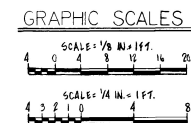

REV	DATE	DESCRIPTION	BY
	MAY 90	AS BUILT	
U.S. ARMY ENGINEER DISTRICT, BALTIMORE CORPS OF ENGINEERS BALTIMORE, MARYLAND			
ABERDEEN PROVING GROUND			
ENLISTED BARRACKS PHASE IV			
BARRACKS BLDG.			
FIRST FLOOR PLAN			
RECEPTACLES			
DRAWING NUMBER			PLATE
F-721-90-12			178
SCALE: AS SHOWN		DATE: 5 FEB. 1987	SHEET E-5

41663