
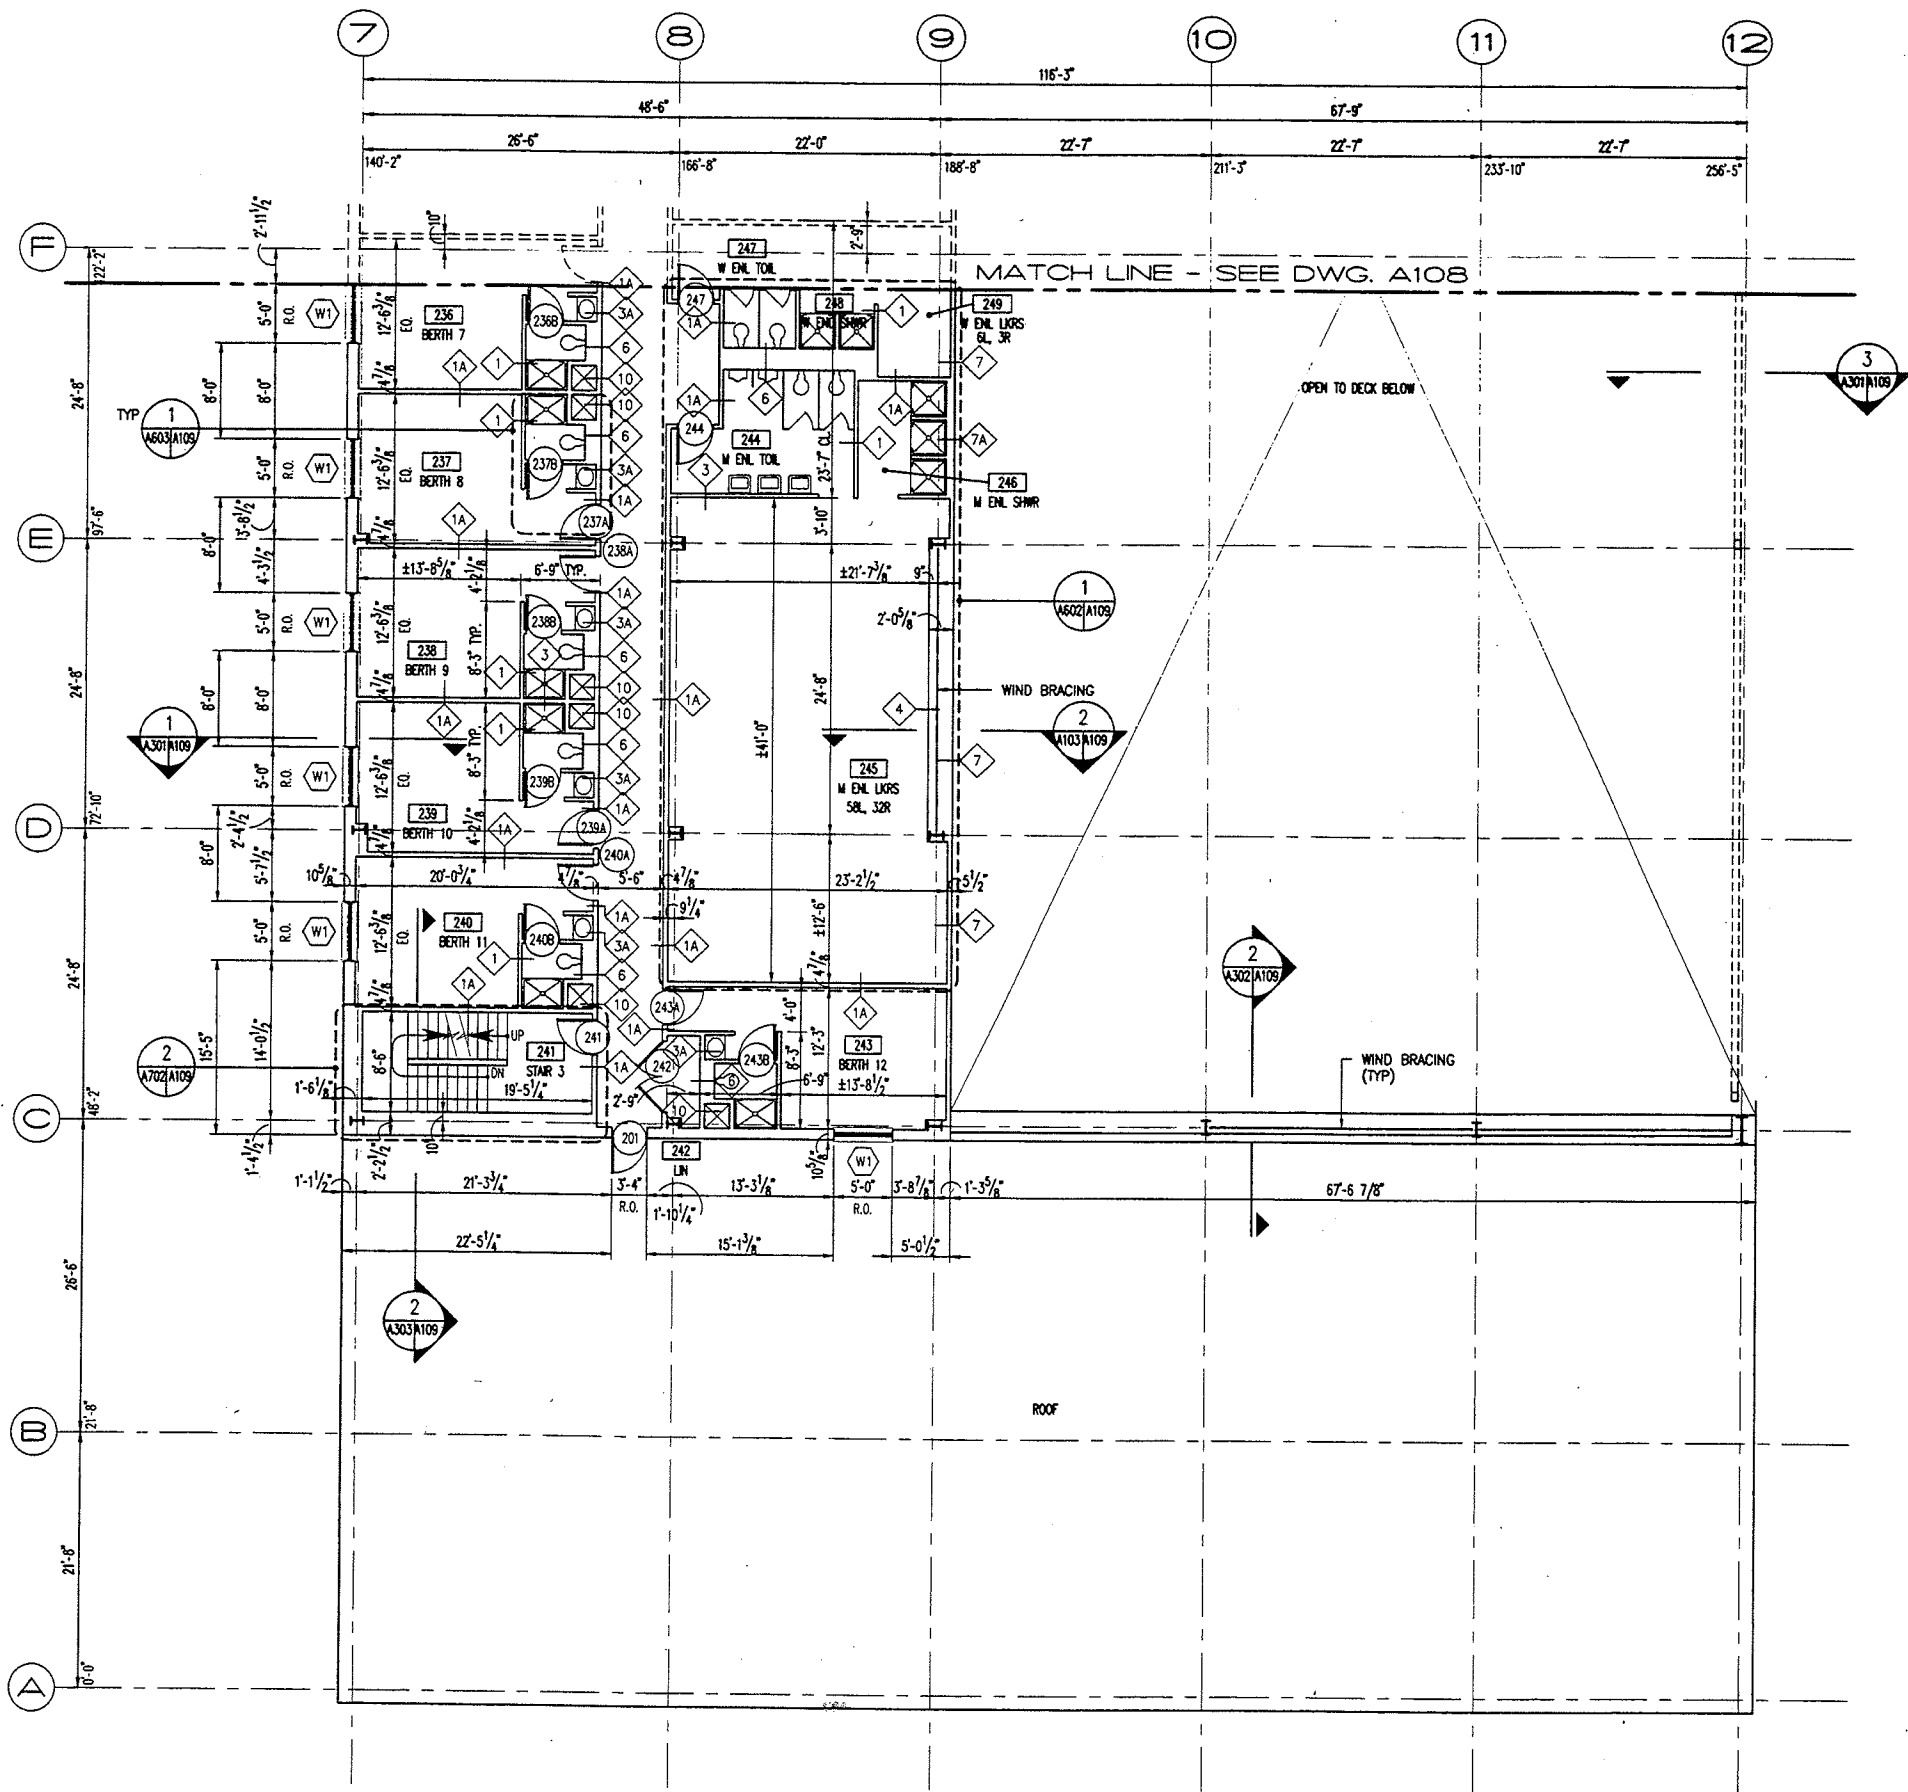


3/30/99			AS-BUILT	
REV.	DATE	APPR.	DESCRIPTION	BY
DESIGNED	A.S.		U.S. COAST GUARD	NORFOLK, VA.
DRAWN	J.O.		FACILITIES DESIGN & CONSTRUCTION CENTER	
EDITED	A.S.		CIVIL ENGINEERING	
CHECKED	D.M.		MID-ATLANTIC AIR STATION CONSOLIDATION	
REVIEWED BY:			AIR STATION ATLANTIC CITY	
PROJECT ENGINEER			ATLANTIC CITY	NEW JERSEY
REVIEWED BY:				
BRANCH CHIEF			ARCHITECTURE	
REVIEWED BY:			SECOND FLOOR PLAN - PART "C"	
APPROVED:				DISCIPLINE/SHT NO
				A109
CHIEF OF DIVISION			DATE	
			DRAWING NUMBER	
			05-X3660	
			SCALE: 1/8"=1'-0"	
			SHEET 50 OF 241	

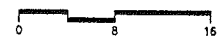

PLOTTING SCALE: 1/8" = 1'-0"

THIS DRAWING HAS BEEN REDUCED TO HALF SIZE

LEV ZETLIN ASSOCIATES
NEW YORK, N.Y. 10011
212-741-1300
JO 3660A109