
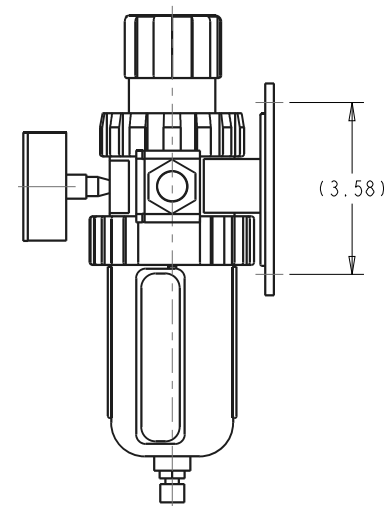


SUGGESTED SOURCE(S) OF SUPPLY			
PART NO.	VENDOR		VENDOR PART NO.
	ADDRESS	CAGE CODE	
11E421029	PARKER HANNIFIN CORP MOTION & CONTROL GROUP PNEUMATIC DIV 8676 E M-89 PO BOX 901 RICHLAND, MI 49083	18925	SEE NOTE 3

REVISIONS				
MODEL REV	DRAW REV	DESCRIPTION	DATE(YEAR-MO-DA)	APPROVED
	-	INITIAL RELEASE-ECP-K1000001	2010-09-23	TAL
	A	NOR K1103022-088	2013-10-17	TAL
	AZ01	MODIFIED PARTS	2023-03-16	ARM

NOTES:

- APPLICABLE STANDARDS/SPECIFICATIONS:
ASME Y14.100
ASME Y14.24-1999
ASME Y14.5M-1994
- IDENTIFICATION OF THE "SUGGESTED SOURCE(S) OF SUPPLY" HEREON IS NOT TO BE CONSTRUED AS A GUARANTEE OF PRESENT OR CONTINUED AVAILABILITY AS A SOURCE OF SUPPLY FOR THE ITEM(S).
- 11E421029 WILL CONSIST OF THE FOLLOWING:
A. FILTER/REGULATOR, P/N ~~07E24B21A~~, QTY 1 **07E44B21A**
B. PORT BLOCK CONNECTORS, P/N ~~PS851P~~, QTY 2 **PS853P**
C. WALL MOUNTING BRACKETS, P/N PS755P, QTY 2
D. REDUCER BUSHING, P/N VS209P-12-6, QTY 2

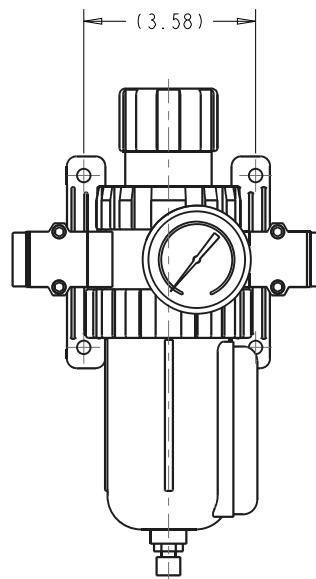

THIS DRAWING WAS GENERATED FROM A SOLID MODEL
AND IS CAD MAINTAINED. CHANGES SHALL BE
INCORPORATED BY THE DESIGN ACTIVITY.

VENDOR ITEM CONTROL DRAWING

PART NO. 11E421029

PMIC				DO NOT SCALE DRAWING		CONTRACT NUMBER W52H0910P0057		DESIGN ACTIVITY US ARMY ARMAMENT RESEARCH, DEVELOPMENT AND ENGINEERING CENTER ROCK ISLAND, ILLINOIS 61299-7300					
				UNLESS OTHERWISE SPECIFIED DIMENSIONS ARE IN INCHES		CONTRACTOR ADVANCED CAD/CAM SERVICE		REGULATOR					
MECHANICAL PROPERTIES				TOLERANCE ON ANGLES ± ° 2 PLACE DECIMALS ± 3 PLACE DECIMALS ±		DRAWN BY C. PRICE						DATE(YEAR-MO-DA) 2010-06-07	
YP				THIRD ANGLE PROJECTION		CHECKER						ENGINEER	
TS						ENGINEER		G. SLAGER					
EL2						DRAWING APPROVAL		DALE HOLLAND					
RA		11E421000	FRS			DESIGN APPROVAL		THOMAS LETTIS		SIZE C	CAGE CODE 59678	DWG NO. 11E421029	
BH		NEXT ASSY	USED ON	MATL ENGR		MODELED BY E. MUMM				SCALE 0.500	UNIT WT. 0.000	SHEET 1 OF 1	
RH		APPLICATION											

DISTRIBUTION STATEMENT A:
THIS IS APPROVED FOR PUBLIC RELEASE:
DISTRIBUTION IS UNLIMITED

NOTES:


1. APPLICABLE STANDARDS/SPECIFICATIONS:

ASME Y14.24-1999
ASME Y14.100
ASME Y14.5M-1994



2. IDENTIFICATION OF THE SUGGESTED SOURCE(S) OF SUPPLY
HEREON IS NOT TO BE CONSTRUED AS A GUARANTEE OF
PRESENT OR CONTINUED AVAILABILITY AS A SOURCE
FOR THE ITEM DESCRIBED ON THIS DRAWING

REVISIONS				
MODEL REV	DRAW REV	DESCRIPTION	DATE(YEAR-MO-DA)	APPROVED
	-	INITIAL RELEASE-ECP-K1060001-NDR 487	2010-09-23	TAL
	-1	ECP K18O3005	2018-xx-xx	CWH

SUGGESTED SOURCE(S) OF SUPPLY			
PART NO.	VENDOR		VENDOR PART NO.
	ADDRESS	CAGE CODE	
11E421059	NOTT COMPANY INC 1005 11TH ST ROCK ISLAND, IL 61201-4002 651-415-3400	3UZE1	V500P-8

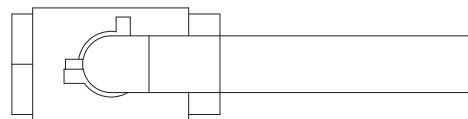

2X 1/2" NPT

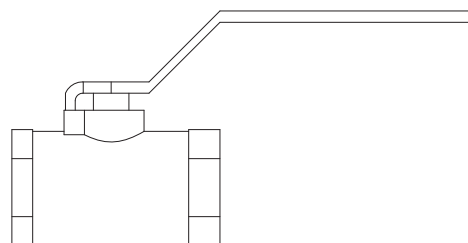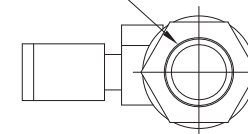

THIS DRAWING WAS GENERATED FROM A SOLID MODEL
AND IS CAD MAINTAINED. CHANGES SHALL BE
INCORPORATED BY THE DESIGN ACTIVITY.

VENDOR ITEM CONTROL DRAWING

PART NO. 11E421059


DISTRIBUTION STATEMENT A:
THIS IS APPROVED FOR PUBLIC RELEASE;
DISTRIBUTION IS UNLIMITED

PMIC				DO NOT SCALE DRAWING		CONTRACT NUMBER W52H0910P0057		US ARMY ARMAMENT RESEARCH, DEVELOPMENT AND ENGINEERING CENTER ROCK ISLAND, ILLINOIS 61299-7300							
				UNLESS OTHERWISE SPECIFIED DIMENSIONS ARE IN INCHES		CONTRACTOR ADVANCED CAD/CAM SERVICE		VALVE, FLOW CONTROL							
MECHANICAL PROPERTIES				TOLERANCE ON ANGLES ± 1° 2 PLACE DECIMALS ± .03 3 PLACE DECIMALS ± .010		DRAWN BY E.MUMM DATE(YEAR-MO-DA) 2010-06-01									
YP						CHECKER ENGINEER G. SLAGER									
TS						ENGINEER QUALITY_ENGINEER									
EL2						DRAWING APPROVAL DALE HOLLAND		SIZE C		CAGE CODE 59678		DWG NO. 11E421059			
RA						DESIGN APPROVAL THOMAS LETTIS									
BH															
RH															
				APPLICATION		MATERIAL ENGR		MODELED BY E.MUMM		SCALE 1.000		UNIT WT. 0.000		SHEET 1 OF 1	

NOTES:


1. APPLICABLE STANDARDS/SPECIFICATIONS:
ASME Y14.100
ASME Y14.24-1999
ASME Y14.5M-1994
2. IDENTIFICATION OF THE SUGGESTED SOURCE(S) OF SUPPLY
HEREON IS NOT TO BE CONSTRUED AS A GUARANTEE OF
PRESENT OR CONTINUED AVAILABILITY AS A SOURCE OF
SUPPLY FOR THE ITEM(S).

REVISIONS				
MODEL REV	DRAW REV	DESCRIPTION	DATE(YEAR-MO-DA)	APPROVED
	-	INITIAL RELEASE-ECP-K10g0001-NDR 199	2010-09-23	TAL

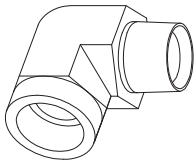

SUGGESTED SOURCE(S) OF SUPPLY				
PART NO.	VENDOR		VENDOR PART NO.	ITEM IDENTIFICATION
	ADDRESS	CAGE CODE		
11E421301	PARKER HANNIFIN CORPORATION TUBE FITTINGS DIVISION COLUMBUS, OHIO 43228 PH 614-279-7070	1KP05	3/4 CD-S	3/4" 90° PIPE ELBOW

ITEM NAME	DESCRIPTION
TYPE	PIPE ELBOW, 3/4" NPTF THRD MALE TO FEMALE THREAD
MATERIAL	STEEL
FINISH	ZINC PLATED
SEAL	NONE
STANDARD	SAE 140239

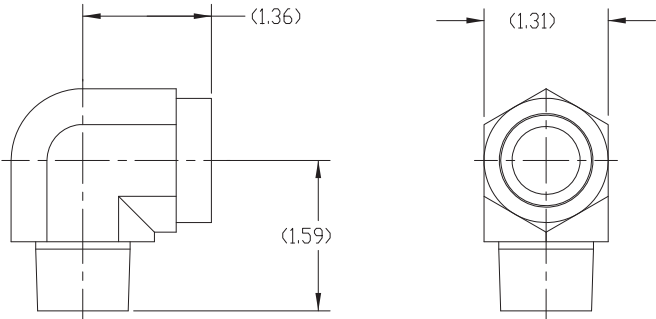


THIS DRAWING WAS GENERATED FROM A SOLID MODEL
AND IS CAD MAINTAINED. CHANGES SHALL BE
INCORPORATED BY THE DESIGN ACTIVITY.

VENDOR ITEM CONTROL DRAWING

PART NO. 11E421301

DISTRIBUTION STATEMENT A.
APPROVED FOR PUBLIC RELEASE:
DISTRIBUTION IS UNLIMITED

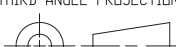PMIC				DO NOT SCALE DRAWING		CONTRACT NUMBER W52H0910P0057		US ARMY ARMAMENT RESEARCH, DEVELOPMENT AND ENGINEERING CENTER ROCK ISLAND, ILLINOIS 61299-7300					
MECHANICAL PROPERTIES				UNLESS OTHERWISE SPECIFIED DIMENSIONS ARE IN INCHES TOLERANCE ON ANGLES ± ° 2 PLACE DECIMALS ± 3 PLACE DECIMALS ±		CONTRACTOR ADVANCED CAD/CAM SERVICE		FITTING, ELBOW , 90°, 3/4 NPTF					
						DRAWN BY JOHN D DATE(YEAR-MO-DA) 2010-5-26							
						CHECKER ENGINEER G. SLAGER							
						ENGINEER QUALITY ENGINEER							
YP				THIRD ANGLE PROJECTION 		DRAWING APPROVAL DALE HOLLAND		SIZE C	CAGE CODE 59678	DWG NO. 11E421301			
TS						DESIGN APPROVAL THOMAS LETTIS		SCALE 1.000		UNIT WT. 0.658		SHEET 1 OF 1	
EL2													
RA													
BH		11E421300	FRS	MTRL ENGR		MODELED BY ERIC M							
		NEXT ASSY	USED ON										
RH		APPLICATION											




NOTES:

1. APPLICABLE STANDARDS/SPECIFICATIONS:
ASME Y14.100
ASME Y14.24-1999
ASME Y14.5M-1994
2. IDENTIFICATION OF THE SUGGESTED SOURCE(S) OF SUPPLY
HEREON IS NOT TO BE CONSTRUED AS A GUARANTEE OF
PRESENT OR CONTINUED AVAILABILITY AS A SOURCE OF
SUPPLY FOR THE ITEM(S).

REVISIONS				
MODEL REV	DRAW REV	DESCRIPTION	DATE(YEAR-MO-DA)	APPROVED
	-	INITIAL RELEASE-ECP-K10c0001-NDR 201	2010-09-23	TAL

SUGGESTED SOURCE(S) OF SUPPLY				
PART NO.	VENDOR		VENDOR PART NO.	ITEM IDENTIFICATION
	ADDRESS	CAGE CODE		
11E421443	PARKER HANNIFIN CORPORATION TUBE FITTINGS DIVISION COLUMBUS, OHIO 43228 PH 614-279-7070	1KP05	1/2 FF-S	PIPE NIPPLE, 1/2" NPTF MALE THREAD

ITEM NAME	DESCRIPTION
TYPE	PIPE NIPPLE, 1/2" NPTF MALE THREAD
MATERIAL	STEEL
FINISH	ZINC PLATED
SEAL	NONE
STANDARD 1	SAE 140137

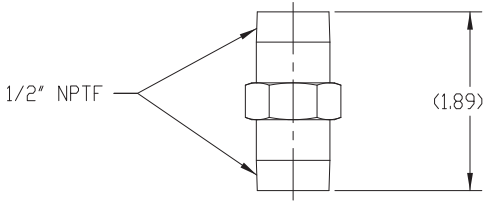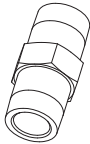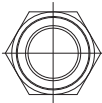

THIS DRAWING WAS GENERATED FROM A SOLID MODEL
AND IS CAD MAINTAINED. CHANGES SHALL BE
INCORPORATED BY THE DESIGN ACTIVITY.

VENDOR ITEM CONTROL DRAWING

PART NO. 11E421303

DISTRIBUTION STATEMENT A.
APPROVED FOR PUBLIC RELEASE:
DISTRIBUTION IS UNLIMITED

PMIC				DO NOT SCALE DRAWING		CONTRACT NUMBER	W52H0910P0057	US ARMY ARMAMENT RESEARCH, DEVELOPMENT AND ENGINEERING CENTER ROCK ISLAND, ILLINOIS 61299-7300	
MECHANICAL PROPERTIES				UNLESS OTHERWISE SPECIFIED DIMENSIONS ARE IN INCHES TOLERANCE ON ANGLES ± ° 2 PLACE DECIMALS ± 3 PLACE DECIMALS ±		CONTRACTOR	ADVANCED CAD/CAM SERVICE	PIPE NIPPLE, 1/2" NPTF	
						DRAWN BY	JOHN D	DATE(YEAR-MO-DA)	2010-5-26
						CHECKER	ENGINEER G. SLAGER	DWG NO. 11E421303	
						ENGINEER	QUALITY ENGINEER		
YP				THIRD ANGLE PROJECTION 		DRAWING APPROVAL DALE HOLLAND		SIZE	C
TS						DESIGN APPROVAL THOMAS LETTIS		CAGE CODE	59678
EL2								SHEET 1 OF 1	
RA									
BH		11E421300	FRS	APPLICATION		MATERIAL ENGR MODELED BY ERIC M		SCALE	1.000
RH		NEXT ASSY	USED ON					UNIT WT.	0.154

NOTES:

1. APPLICABLE STANDARDS/SPECIFICATIONS:

ASME Y14.100
ASME Y14.24-1999
ASME Y14.5M-1994

2. IDENTIFICATION OF THE SUGGESTED SOURCE(S) OF SUPPLY
HEREON IS NOT TO BE CONSTRUED AS A GUARANTEE OF
PRESENT OR CONTINUED AVAILABILITY AS A SOURCE OF
SUPPLY FOR THE ITEM(S).

SUGGESTED SOURCE(S) OF SUPPLY				
PART NO.	VENDOR		VENDOR PART NO.	ITEM IDENTIFICATION
	ADDRESS	CAGE CODE		
11E421304	PARKER HANNIFIN CORPORATION TUBE FITTINGS DIVISION COLUMBUS, OHIO 43228 PH 614-279-7070	1KP05	227T-0-0	PIPE TEE, 1/2" NPTF BRANCH

ITEM NAME	DESCRIPTION
TYPE	1/2" NPTF PIPE TEE, W/ TWO SWIVEL ENDS
MATERIAL	STEEL
FINISH	ZINC PLATED
SEAL	NONE

STANDARD SAE 140438 (J514)




1/2 MMO-S

FEMALE

IAW SAE J514

**REPLACE FIGURE WITH
NON-SWIVEL TEE**

REVISIONS				
MODEL REV	DRAW REV	DESCRIPTION	DATE(YEAR-MO-DA)	APPROVED
	-	INITIAL RELEASE-ECP-K10g0001-NDR 202	2010-09-23	TAL
-1 ECP K1903005 2019-XX-XX CWH				

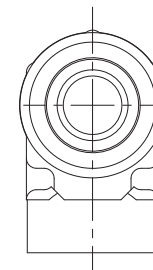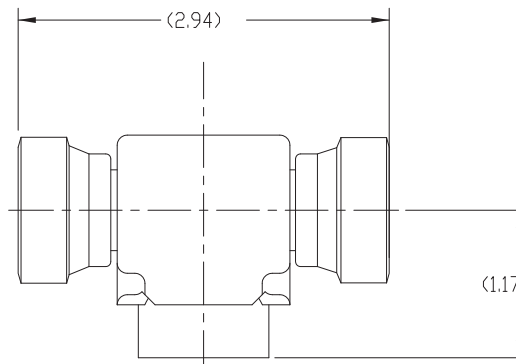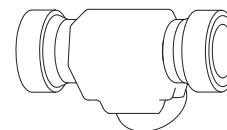

FEMALE

THIS DRAWING WAS GENERATED FROM A SOLID MODEL
AND IS CAD MAINTAINED. CHANGES SHALL BE
INCORPORATED BY THE DESIGN ACTIVITY.

VENDOR ITEM CONTROL DRAWING

PART NO. 11E421304

PMIC		DO NOT SCALE DRAWING		CONTRACT NUMBER	W52H0910P0057	US ARMY ARMAMENT RESEARCH, DEVELOPMENT AND ENGINEERING CENTER ROCK ISLAND, ILLINOIS 61299-7300	
MECHANICAL PROPERTIES		UNLESS OTHERWISE SPECIFIED DIMENSIONS ARE IN INCHES TOLERANCE ON ANGLES ± ° 2 PLACE DECIMALS ± 3 PLACE DECIMALS ±		CONTRACTOR	ADVANCED CAD/CAM SERVICE	FITTING, BRANCH, PIPE TEE	
				DRAWN BY	JOHN D	DATE(YEAR-MO-DA)	2010-5-26
YP		THIRD ANGLE PROJECTION		CHECKER	ENGINEER G. SLAGER	SIZE	
TS				ENGINEER	QUALITY ENGINEER		
EL2				DRAWING APPROVAL	DALE HOLLAND	CAGE CODE	59678
RA				DESIGN APPROVAL	THOMAS LETTIS	DWG NO.	11E421304
BH		11E421300	FRS	MATL ENGR	MODELED BY	SCALE	1.333
RH		NEXT ASSY	USED ON		ERIC M	UNIT WT.	0.000
		APPLICATION				SHEET	1 OF 1

DISTRIBUTION STATEMENT A.
APPROVED FOR PUBLIC RELEASE:
DISTRIBUTION IS UNLIMITED

NOTES:

1. APPLICABLE STANDARDS/SPECIFICATIONS:

ASME Y14.100
ASME Y14.24-1999
ASME Y14.5M-1994

2. IDENTIFICATION OF THE SUGGESTED SOURCE(S) OF SUPPLY
HEREON IS NOT TO BE CONSTRUED AS A GUARANTEE OF
PRESENT OR CONTINUED AVAILABILITY AS A SOURCE OF
SUPPLY FOR THE ITEM(S).

SUGGESTED SOURCE(S) OF SUPPLY

PART NO.	VENDOR		VENDOR PART NO.	ITEM IDENTIFICATION
	ADDRESS	CAGE CODE		
11E421305	PARKER HANNIFIN CORPORATION TUBE FITTINGS DIVISION COLUMBUS, OHIO 43228 PH 614-279-7070	1KP05	B37	FEMALE QUICK COUPLER, 1/2" NPTF, BRASS

ITEM NAME	DESCRIPTION
TYPE	FEMALE QUICK COUPLER, 1/2" NPTF THREAD, BRASS BODY
MATERIAL	BRASS
PORT SIZE	1/2" NPTF
SEAL	NITRILE
TEMPERATURE RATING	-40°F TO 250°F
PRESSURE RATING	300 PSI
VALVE TYPE	TUBULAR
LOCKING MECHANISM	PAWL
SLEEVE TYPE	PUSH TO CONNECT
STANDARD	CID A-A-59439

BODY SIZE 1/2" INDUSTRIAL INTERCHANGE

1/2" INDUSTRIAL INTERCHANGE

QUICK CONNECT

(3.00)

1/2" NPTF

THIS DRAWING WAS GENERATED FROM A SOLID MODEL
AND IS CAD MAINTAINED. CHANGES SHALL BE
INCORPORATED BY THE DESIGN ACTIVITY.

VENDOR ITEM CONTROL DRAWING

PART NO. 11E421305

DISTRIBUTION STATEMENT A.
APPROVED FOR PUBLIC RELEASE:
DISTRIBUTION IS UNLIMITED

PMIC		DO NOT SCALE DRAWING		CONTRACT NUMBER W52H0910P0057		US ARMY ARMAMENT RESEARCH, DEVELOPMENT AND ENGINEERING CENTER ROCK ISLAND, ILLINOIS 61299-7300	
MECHANICAL PROPERTIES		UNLESS OTHERWISE SPECIFIED DIMENSIONS ARE IN INCHES TOLERANCE ON ANGLES ± ° 2 PLACE DECIMALS ± 3 PLACE DECIMALS ±		CONTRACTOR ADVANCED CAD/CAM SERVICE		FITTING, FEMALE QUICK COUPLING	
YP		THIRD ANGLE PROJECTION		DRAWN BY JOHN D	DATE(YEAR-MO-DA) 2010-5-26		
TS				CHECKER ENGINEER G. SLAGER	ENGINEER QUALITY ENGINEER		
EL2				DRAWING APPROVAL DALE HOLLAND		SIZE C	CAGE CODE 59678
RA		11E421300	FRS	DESIGN APPROVAL THOMAS LETTIS		DWG NO. 11E421305	
BH		NEXT ASSY	USED ON			SCALE 1.000	UNIT WT. 0.000
RH		APPLICATION				SHEET 1 OF 1	

NOTES:

1. APPLICABLE STANDARDS/SPECIFICATIONS:




ASME Y14.100
ASME Y14.24-1999
ASME Y14.5M-1994

2. IDENTIFICATION OF THE SUGGESTED SOURCE(S) OF SUPPLY
HEREON IS NOT TO BE CONSTRUED AS A GUARANTEE OF
PRESENT OR CONTINUED AVAILABILITY AS A SOURCE OF
SUPPLY FOR THE ITEM(S).

SUGGESTED SOURCE(S) OF SUPPLY				
PART NO.	VENDOR		VENDOR PART NO.	ITEM IDENTIFICATION
	ADDRESS	CAGE CODE		
11E421306	PARKERHANNIFIN CORPORATION HOSE PRODUCTS DIVISION WICKLIFF, OHIO 44092 PH 440-943-5700	1KP05	1/2 DD-S	1/2" NPTF 90° FEMALE PIPE ELBOW

ITEM NAME	DESCRIPTION
TYPE	1/2" NPTF 90° FEMALE PIPE ELBOW
MATERIAL	STEEL
FINISH	ZINC PLATED
STANDARD	SAE 140238

REVISIONS				
MODEL REV	DRAW REV	DESCRIPTION	DATE(YEAR-MO-DA)	APPROVED
	-	INITIAL RELEASE-ECP-K10o0001-NDR 204	2010-09-23	TAL

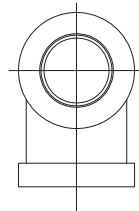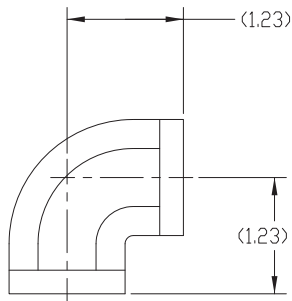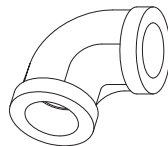

THIS DRAWING WAS GENERATED FROM A SOLID MODEL
AND IS CAD MAINTAINED. CHANGES SHALL BE
INCORPORATED BY THE DESIGN ACTIVITY.

VENDOR ITEM CONTROL DRAWING

PART NO. 11E421306

DISTRIBUTION STATEMENT A.
APPROVED FOR PUBLIC RELEASE:
DISTRIBUTION IS UNLIMITED

PMIC				DO NOT SCALE DRAWING		CONTRACT NUMBER W52H0910P0057		US ARMY ARMAMENT RESEARCH, DEVELOPMENT AND ENGINEERING CENTER ROCK ISLAND, ILLINOIS 61299-7300			
MECHANICAL PROPERTIES				UNLESS OTHERWISE SPECIFIED DIMENSIONS ARE IN INCHES TOLERANCE ON ANGLES ± ° 2 PLACE DECIMALS ± 3 PLACE DECIMALS ±		CONTRACTOR ADVANCED CAD/CAM SERVICE		90° ELBOW, 1/2" NPTF			
						DRAWN BY JOHN D DATE(YEAR-MO-DA) 2010-5-26					
						CHECKER ENGINEER G. SLAGER					
						ENGINEER QUALITY_ENGINEER					
YP				THIRD ANGLE PROJECTION 		DRAWING APPROVAL DALE HOLLAND		SIZE C	CAGE CODE 59678	DWG NO. 11E421306	
TS						DESIGN APPROVAL THOMAS LETTIS					
EL2											
RA											
BH		11E421300	FRS	APPLICATION				SCALE 1.000	UNIT WT. 0.364	SHEET 1 OF 1	
		NEXT ASSY	USED ON								
RH											

NOTES:

1. APPLICABLE STANDARDS/SPECIFICATIONS:

ASME Y14.100
ASME Y14.24-1999
ASME Y14.5M-1994

2. IDENTIFICATION OF THE SUGGESTED SOURCE(S) OF SUPPLY
HEREON IS NOT TO BE CONSTRUED AS A GUARANTEE OF
PRESENT OR CONTINUED AVAILABILITY AS A SOURCE OF
SUPPLY FOR THE ITEM(S).



SUGGESTED SOURCE(S) OF SUPPLY

PART NO.	VENDOR		VENDOR PART NO.	ITEM IDENTIFICATION
	ADDRESS	CAGE CODE		
11E421307	PARKER HANNIFIN CORPORATION TUBE FITTINGS DIVISION COLUMBUS, OHIO 43228 PH 614-279-7070	1KP05	12 CTX-S	90° MALE ELBOW, 1 3/16-12 37° FLARE TUBE TO 3/4" NPTF PIPE,

ITEM NAME	DESCRIPTION
TYPE	90° MALE ELBOW, 1 3/16-12 37° FLARE TUBE TO 3/4" NPTF PIPE,
MATERIAL	STEEL
FINISH	
SEAL	NONE
STANDARD	SAE 070202

3/4" 37° FLARE TUBE**(J514)**

REVISIONS				
MODEL REV	DRAW REV	DESCRIPTION	DATE(YEAR-MO-DA)	APPROVED
	-	INITIAL RELEASE-ECP-K100001-NDR 205	2010-09-23	TAL

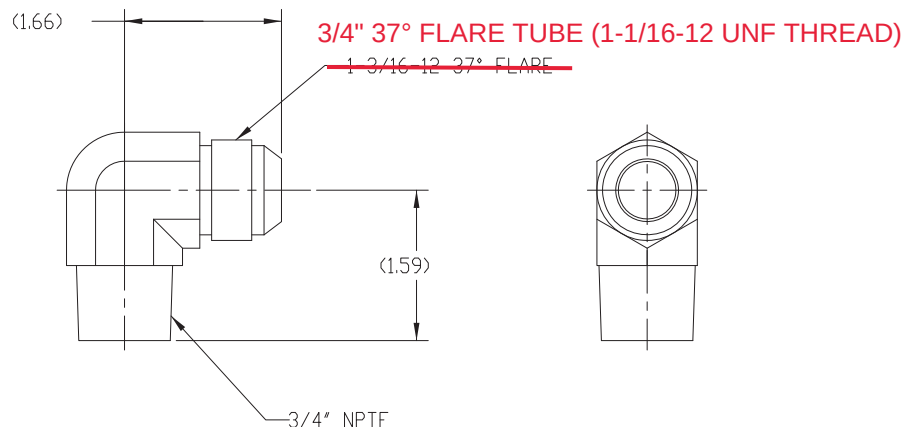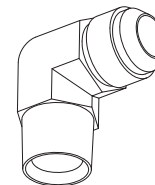-1 ECP K19O3005 2019-XX-XX CWH

THIS DRAWING WAS GENERATED FROM A SOLID MODEL
AND IS CAD MAINTAINED. CHANGES SHALL BE
INCORPORATED BY THE DESIGN ACTIVITY.

VENDOR ITEM CONTROL DRAWING

PART NO. 11E421307

PMIC		DO NOT SCALE DRAWING		CONTRACT NUMBER	W52H0910P0057	US ARMY ARMAMENT RESEARCH, DEVELOPMENT AND ENGINEERING CENTER ROCK ISLAND, ILLINOIS 61299-7300	
MECHANICAL PROPERTIES		UNLESS OTHERWISE SPECIFIED DIMENSIONS ARE IN INCHES TOLERANCE ON ANGLES ± ° 2 PLACE DECIMALS ± 3 PLACE DECIMALS ±		CONTRACTOR	ADVANCED CAD/CAM SERVICE	FITTING, MALE ELBOW,	
				DRAWN BY	JOHN D		
				CHECKER	ENGINEER G. SLAGER		
				ENGINEER	QUALITY ENGINEER		
YP		THIRD ANGLE PROJECTION 		DRAWING APPROVAL DALE HOLLAND		SIZE	C
TS				DESIGN APPROVAL THOMAS LETTIS		CAGE CODE	59678
EL2						DWG NO.	11E421307
RA						SCALE	1.000
BH		11E421300	FRS	MATL ENGR	MODELED BY ERIC M	UNIT WT.	0.485
RH		NEXT ASSY	USED ON			SHEET	1 OF 1
		APPLICATION					

DISTRIBUTION STATEMENT A.
APPROVED FOR PUBLIC RELEASE:
DISTRIBUTION IS UNLIMITED

NOTES:

1. APPLICABLE STANDARDS/SPECIFICATIONS:

ASME Y14.100
ASME Y14.24-1999
ASME Y14.5M-1994

2. IDENTIFICATION OF THE SUGGESTED SOURCE(S) OF SUPPLY
HEREON IS NOT TO BE CONSTRUED AS A GUARANTEE OF
PRESENT OR CONTINUED AVAILABILITY AS A SOURCE OF
SUPPLY FOR THE ITEM(S).

SUGGESTED SOURCE(S) OF SUPPLY

PART NO.	VENDOR		VENDOR PART NO.	ITEM IDENTIFICATION
	ADDRESS	CAGE CODE		
11E421308	PARKER HANNIFIN CORPORATION TUBE FITTINGS DIVISION COLUMBUS, OHIO 43228 PH 614-279-7070	1KP05	12 FTX-S	MALE CONNECTOR, TUBE TO PIPE, 1-3/16-12 37° FLARE TO 3/4" NPTF

ITEM NAME	DESCRIPTION
TYPE	MALE CONNECTOR, 1-3/16-12 37° FLARE TUBE TO 3/4" NPTF PIPE
MATERIAL	STEEL
FINISH	
SEAL	NONE
STANDARD	SAE 070102 (J514)

3/4" 37° FLARE TUBE

3/4" 37° FLARE TUBE
(1-1/16-12 UNF THREAD)


3/4" NPTF

THIS DRAWING WAS GENERATED FROM A SOLID MODEL
AND IS CAD MAINTAINED. CHANGES SHALL BE
INCORPORATED BY THE DESIGN ACTIVITY.

VENDOR ITEM CONTROL DRAWING

PART NO. 11E421308

DISTRIBUTION STATEMENT A.
APPROVED FOR PUBLIC RELEASE:
DISTRIBUTION IS UNLIMITED

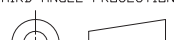PMIC				DO NOT SCALE DRAWING		CONTRACT NUMBER W52H0910P0057		US ARMY ARMAMENT RESEARCH, DEVELOPMENT AND ENGINEERING CENTER ROCK ISLAND, ILLINOIS 61299-7300							
MECHANICAL PROPERTIES				UNLESS OTHERWISE SPECIFIED DIMENSIONS ARE IN INCHES TOLERANCE ON ANGLES ± ° 2 PLACE DECIMALS ± 3 PLACE DECIMALS ±		CONTRACTOR ADVANCED CAD/CAM SERVICE		FITTING, CONNECTOR, MALE, TUBE TO PIPE							
						DRAWN BY JOHN D						DATE(YEAR-MO-DA) 2010-5-26			
						CHECKER ENGINEER G. SLAGER									
						ENGINEER QUALITY_ENGINEER									
YP				THIRD ANGLE PROJECTION 		DRAWING APPROVAL DALE HOLLAND		SIZE C		CAGE CODE 59678		DWG NO. 11E421308			
TS						DESIGN APPROVAL THOMAS LETTIS									
EL2															
RA															
BH		11E421300	FRS												
		NEXT ASSY	USED ON	MATL ENGR		MODELED BY ERIC M									
RH		APPLICATION								SCALE 1.000		UNIT WT. 0.261		SHEET 1 OF 1	

SUGGESTED SOURCE(S) OF SUPPLY

PART NO.	VENDOR		VENDOR PART NO.	ITEM IDENTIFICATION
	ADDRESS	CAGE CODE		
11E421309	PARKER HANNIFIN CORPORATION TUBE FITTINGS DIVISION COLUMBUS, OHIO 43228 PH 614-279-7070	1KP05	12 C6X-S	FITTING, ELBOW, 90° TUBE ADAPTOR, 1-3/16-12 37° FLARE TO 1-3/16-12 37° FLARE

REVISIONS

MODEL REV	DRAW REV	DESCRIPTION	DATE(YEAR-MO-DA)	APPROVED
	-	INITIAL RELEASE-ECP-K1000001	2010-09-23	TAL
	A	ECP K1103022-027	2013-10-17	TAL

A-1

ECP K1903005

2019-XX-XX

CWH

NOTES:

- APPLICABLE STANDARDS/SPECIFICATIONS:
ASME Y14.100
ASME Y14.24-1999
ASME Y14.5M-1994
- IDENTIFICATION OF THE SUGGESTED SOURCE(S) OF SUPPLY
HEREON IS NOT TO BE CONSTRUED AS A GUARANTEE OF
PRESENT OR CONTINUED AVAILABILITY AS A SOURCE OF
SUPPLY FOR THE ITEM(S).

ITEM NAME	DESCRIPTION
TYPE	90° TUBE ADAPTOR ELBOW FITTING, 1-3/16-12 37° FLARE MALE TO 1-3/16-12 37° FLARE FEMALE
MATERIAL	STEEL
FINISH	ZINC PLATED
SEAL	NONE
STANDARD	SAE J518

SAE 070221 (J514)

3/4" 37° FLARE MALE TO
3/4" 37° FLARE FEMALE SWIVEL

(1.75)

~~1-3/16-12 37° FLARE~~
3/4" 37° FLARE MALE
(1-1/16-12 UNF THREADS)

(1.66)

~~1-3/16-12 37° FLARE~~
3/4" 37° FLARE FEMALE SWIVEL
(1-1/16-12 UNF THREADS)

THIS DRAWING WAS GENERATED FROM A SOLID MODEL
AND IS CAD MAINTAINED. CHANGES SHALL BE
INCORPORATED BY THE DESIGN ACTIVITY.

VENDOR ITEM CONTROL DRAWING

PART NO. 11E421309

DISTRIBUTION STATEMENT A.
APPROVED FOR PUBLIC RELEASE:
DISTRIBUTION IS UNLIMITED

PMIC		DO NOT SCALE DRAWING		CONTRACT NUMBER W52H0910P0057		DESIGN ACTIVITY US ARMY ARMAMENT RESEARCH, DEVELOPMENT AND ENGINEERING CENTER ROCK ISLAND, ILLINOIS 61299-7300			
MECHANICAL PROPERTIES		UNLESS OTHERWISE SPECIFIED DIMENSIONS ARE IN INCHES		CONTRACTOR ADVANCED CAD/CAM SERVICE		FITTING, ELBOW, TUBE ADAPTOR			
TOLERANCE ON ANGLES ± °		TOLERANCE ON ANGLES ± °		DRAWN BY JOHN D					
2 PLACE DECIMALS ±		2 PLACE DECIMALS ±		DATE(YEAR-MO-DA) 2010-5-26					
3 PLACE DECIMALS ±		3 PLACE DECIMALS ±		CHECKER ENGINEER G. SLAGER					
THIRD ANGLE PROJECTION		THIRD ANGLE PROJECTION		ENGINEER QUALITY ENGINEER					
DRAWING APPROVAL DALE HOLLAND		DRAWING APPROVAL DALE HOLLAND		DESIGN APPROVAL THOMAS LETTIS		SIZE C			
MATERIAL ERIC M		MATERIAL ERIC M		CAGE CODE 59678		DWG NO. 11E421309			
APPLICATION		APPLICATION		SCALE 1.000		UNIT WT. 0.538			
SHEET 1 OF 1		SHEET 1 OF 1		SHEET 1 OF 1		SHEET 1 OF 1			




NOTES:

1. APPLICABLE STANDARDS/SPECIFICATIONS:
ASME Y14.100
ASME Y14.24-1999
ASME Y14.5M-1994
2. IDENTIFICATION OF THE SUGGESTED SOURCE(S) OF SUPPLY
HEREON IS NOT TO BE CONSTRUED AS A GUARANTEE OF
PRESENT OR CONTINUED AVAILABILITY AS A SOURCE OF
SUPPLY FOR THE ITEM(S).

REVISIONS				
MODEL REV	DRAW REV	DESCRIPTION	DATE(YEAR-MO-DA)	APPROVED
	-	INITIAL RELEASE-ECP-K10o0001-NDR 208	2010-09-23	TAL

SUGGESTED SOURCE(S) OF SUPPLY				
PART NO.	VENDOR		VENDOR PART NO.	ITEM IDENTIFICATION
	ADDRESS	CAGE CODE		
11E421310	PARKER HANNIFIN CORPORATION TUBE FITTINGS DIVISION COLUMBUS, OHIO 43228 PH 614-279-7070	1KP05	1-1/4 X 3/4 PTR-S	PIPE FITTING, REDUCING, 1-1/4 NPTF MALE TO 3/4 NPTF FEMALE

ITEM NAME	DESCRIPTION
TYPE	PIPE FITTING, REDUCING, 1-1/4 NPTF MALE TO 3/4 NPTF FEMALE
MATERIAL	STEEL
FINISH	ZINC PLATED
SEAL	NONE
STANDARD	SAE 140140

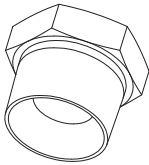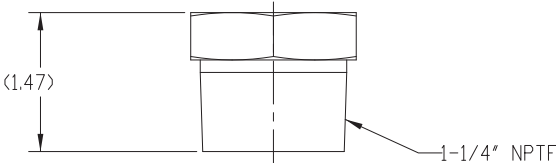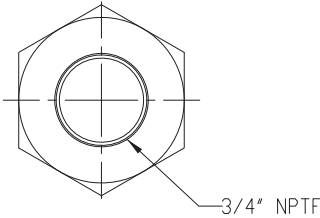


THIS DRAWING WAS GENERATED FROM A SOLID MODEL
AND IS CAD MAINTAINED. CHANGES SHALL BE
INCORPORATED BY THE DESIGN ACTIVITY.

VENDOR ITEM CONTROL DRAWING

PART NO. 11E421310

DISTRIBUTION STATEMENT A:
APPROVED FOR PUBLIC RELEASE:
DISTRIBUTION IS UNLIMITED

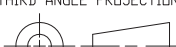PMIC				DO NOT SCALE DRAWING		CONTRACT NUMBER		V52H0910P0057		US ARMY ARMAMENT RESEARCH, DEVELOPMENT AND ENGINEERING CENTER ROCK ISLAND, ILLINOIS 61299-7300			
MECHANICAL PROPERTIES				UNLESS OTHERWISE SPECIFIED DIMENSIONS ARE IN INCHES TOLERANCE ON ANGLES ± ° 2 PLACE DECIMALS ± 3 PLACE DECIMALS ±		CONTRACTOR		ADVANCED CAD/CAM SERVICE					
						DRAWN BY		DATE(YEAR-MO-DA)					
						JOHN D		20105-27					
						CHECKER		ENGINEER					
YP				THIRD ANGLE PROJECTION 				ENGINEER		FITTING, REDUCING 1-1/4 NPTF TO 3/4 NPTF			
TS								G. SLAGER					
EL2						ENGINEER		QUALITY ENGINEER					
RA													
BH		11E421300	FRS			DRAWING APPROVAL		DALE HOLLAND		SIZE	CAGE CODE	DWG NO.	
RH		NEXT ASSY	USED ON	MATL ENGR		MODELED BY		DESIGN APPROVAL		C	59678	11E421310	
APPLICATION						ERIC M		THOMAS LETTIS		SCALE 1.000	UNIT WT. 0.548	SHEET 1 OF 1	

NOTES:

1. APPLICABLE STANDARDS/SPECIFICATIONS:

ASME Y14.100
ASME Y14.24-1999
ASME Y14.5M-1994

2. IDENTIFICATION OF THE SUGGESTED SOURCE(S) OF SUPPLY
HEREON IS NOT TO BE CONSTRUED AS A GUARANTEE OF
PRESENT OR CONTINUED AVAILABILITY AS A SOURCE OF
SUPPLY FOR THE ITEM(S).

SUGGESTED SOURCE(S) OF SUPPLY

PART NO.	VENDOR		VENDOR PART NO.	ITEM IDENTIFICATION
	ADDRESS	CAGE CODE		
11E421311	PARKER HANNIFIN CORPORATION TUBE FITTINGS DIVISION COLUMBUS, OHIO 43228 PH 614-279-7070	1KP05	6 CTX-S	FITTING, ELBOW, TUBE TO PIPE, 90° 1 1/16-16 37° FLARE TO 1/4" NPTF PIPE

ITEM NAME	DESCRIPTION
TYPE	90° TUBE TO PIPE ELBOW 1 1/16-16 37° FLARE TO 1/4" NPTF
MATERIAL	STEEL
FINISH	
SEAL	NONE
STANDARD	SAE 070202

3/8" 37° FLARE
MALE TO 1/4"
NPTF MALE

(J514)

1/4" NPTF

(1.06)

3/8" 37° FLARE (9/16-18 UNF THREADS)

~~1 1/16-16 37° FLARE~~

(1.09)

THIS DRAWING WAS GENERATED FROM A SOLID MODEL
AND IS CAD MAINTAINED. CHANGES SHALL BE
INCORPORATED BY THE DESIGN ACTIVITY.

VENDOR ITEM CONTROL DRAWING

PART NO. 11E421311

DISTRIBUTION STATEMENT A.
APPROVED FOR PUBLIC RELEASE:
DISTRIBUTION IS UNLIMITED

PMIC			DO NOT SCALE DRAWING	CONTRACT NUMBER	W52H0910P0057	US ARMY ARMAMENT RESEARCH, DEVELOPMENT AND ENGINEERING CENTER ROCK ISLAND, ILLINOIS 61299-7300	
			UNLESS OTHERWISE SPECIFIED DIMENSIONS ARE IN INCHES TOLERANCE ON ANGLES ± ° 2 PLACE DECIMALS ± 3 PLACE DECIMALS ±	CONTRACTOR	ADVANCED CAD/CAM SERVICE	FITTING, ELBOW, TUBE TO PIPE	
MECHANICAL PROPERTIES				DRAWN BY	JOHN D	DATE(YEAR-MO-DA)	2010-5-27
YP				CHECKER	ENGINEER G. SLAGER		
TS				ENGINEER	QUALITY ENGINEER		
EL2				DRAWING APPROVAL	DALE HOLLAND	SIZE	C
RA				DESIGN APPROVAL	THOMAS LETTIS	CAGE CODE	59678
BH	11E421300	FRS				DWG NO.	11E421311
RH	NEXT ASSY	USED ON				SCALE	2.000
	APPLICATION		MATL ENGR	MODELED BY	ERIC M	UNIT WT.	0.099
						SHEET	1 OF 1

NOTES:

1. APPLICABLE STANDARDS/SPECIFICATIONS:
ASME Y14.100
ASME Y14.24-1999
ASME Y14.5M-1994
2. IDENTIFICATION OF THE SUGGESTED SOURCE(S) OF SUPPLY
HEREON IS NOT TO BE CONSTRUED AS A GUARANTEE OF
PRESENT OR CONTINUED AVAILABILITY AS A SOURCE OF
SUPPLY FOR THE ITEM(S).

REVISIONS				
MODEL REV	DRAW REV	DESCRIPTION	DATE(YEAR-MO-DA)	APPROVED
	-	INITIAL RELEASE-ECP-K10c0001-NDR 211	2010-09-23	TAL

-1 ECP K1903005 2019-XX-XX CWH

SUGGESTED SOURCE(S) OF SUPPLY				
PART NO.	VENDOR		VENDOR PART NO.	ITEM IDENTIFICATION
	ADDRESS	CAGE CODE		
11E421313	PARKER HANNIFIN CORPORATION TUBE FITTINGS DIVISION COLUMBUS, OHIO 43228 PH 614-279-7070	1KP05	12 R6X-S	FITTING, TEE, 3/4" TUBE 1 3/16-12 37° FLARE


FITTING, SWIVEL NUT RUN TEE,
3/4" 37° FLARE TUBE

ITEM NAME	DESCRIPTION
TYPE	3/4" TUBE TEE 1 3/16-12 37° FLARE W/ ONE SWIVEL END
MATERIAL	STEEL
FINISH	ZINC PLATED
SEAL	NONE
STANDARD	SAE 070432

FITTING, RUN TEE,
3/4" 37° FLARE TUBE

(J514)

~~(3) 1 3/16-12 37° FLARE~~
3X 3/4" 37° FLARE TUBE
(1-1/16-12 UNF THREAD)

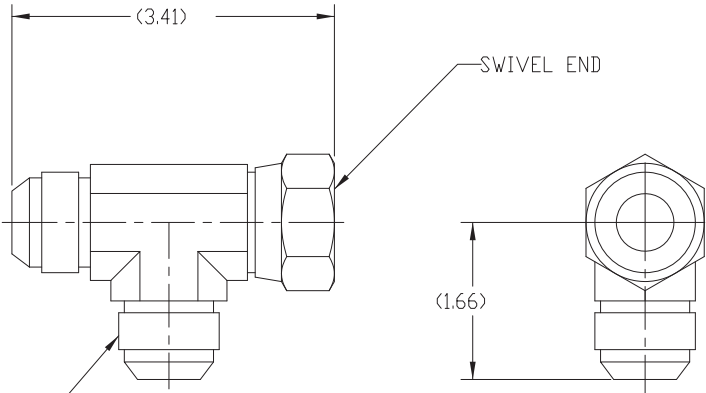

THIS DRAWING WAS GENERATED FROM A SOLID MODEL
AND IS CAD MAINTAINED. CHANGES SHALL BE
INCORPORATED BY THE DESIGN ACTIVITY.

VENDOR ITEM CONTROL DRAWING

PART NO. 11E421313

DISTRIBUTION STATEMENT A:
APPROVED FOR PUBLIC RELEASE:
DISTRIBUTION IS UNLIMITED

PMIC				DO NOT SCALE DRAWING		CONTRACT NUMBER W52H0910P0057		US ARMY ARMAMENT RESEARCH, DEVELOPMENT AND ENGINEERING CENTER ROCK ISLAND, ILLINOIS 61299-7300			
MECHANICAL PROPERTIES				UNLESS OTHERWISE SPECIFIED DIMENSIONS ARE IN INCHES TOLERANCE ON ANGLES ± ° 2 PLACE DECIMALS ± 3 PLACE DECIMALS ±		CONTRACTOR ADVANCED CAD/CAM		FITTING, TEE, TUBE			
					DRAWN BY JOHN D	SERVICE DATE (YEAR-MO-DA) 2010-5-27					
					CHECKER ENGINEER	G. SLAGER					
YP				THIRD ANGLE PROJECTION		ENGINEER QUALITY ENGINEER					
TS						DRAWING APPROVAL DALE HOLLAND		SIZE C	CAGE CODE 59678	DWG NO. 11E421313	
EL2						DESIGN APPROVAL THOMAS LETTIS					
RA		11E421300	FRS	MATL ENGR	MODELED BY E. MUMM			SCALE 1.000	UNIT WT. 0.716	SHEET 1 OF 1	
BH		NEXT ASSY	USED ON								
RH		APPLICATION									

NOTES:

1. APPLICABLE STANDARDS/SPECIFICATIONS:

ASME Y14.100
ASME Y14.24-1999
ASME Y14.5M-1994

2. IDENTIFICATION OF THE SUGGESTED SOURCE(S) OF SUPPLY
HEREON IS NOT TO BE CONSTRUED AS A GUARANTEE OF
PRESENT OR CONTINUED AVAILABILITY AS A SOURCE OF
SUPPLY FOR THE ITEM(S).

SUGGESTED SOURCE(S) OF SUPPLY

PART NO.	VENDOR		VENDOR PART NO.	ITEM IDENTIFICATION
	ADDRESS	CAGE CODE		
11E421315	PARKER HANNIFIN CORPORATION TUBE FITTINGS DIVISION COLUMBUS, OHIO 43228 PH 614-279-7070	1KP05	6-6 CTX-S	FITTING, 90° ELBOW TUBE TO PIPE 1 3/16 12 37° FLARE 3/8" NPTF



ITEM NAME	DESCRIPTION
TYPE	90° TUBE TO PIPE ELBOW 1 3/16 12 37° FLARE TO 3/8" NPTF
MATERIAL	STEEL
FINISH	
SEAL	NONE
STANDARD	SAE 070202

3/8" 37° FLARE

(J514)

3/8" NPTF


REVISIONS				
MODEL REV	DRAW REV	DESCRIPTION	DATE(YEAR-MO-DA)	APPROVED
	-	INITIAL RELEASE-ECP-K10c0001-NDR 213	2010-09-23	TAL
-1 ECP K1903005 2019-XX-XX CWH				

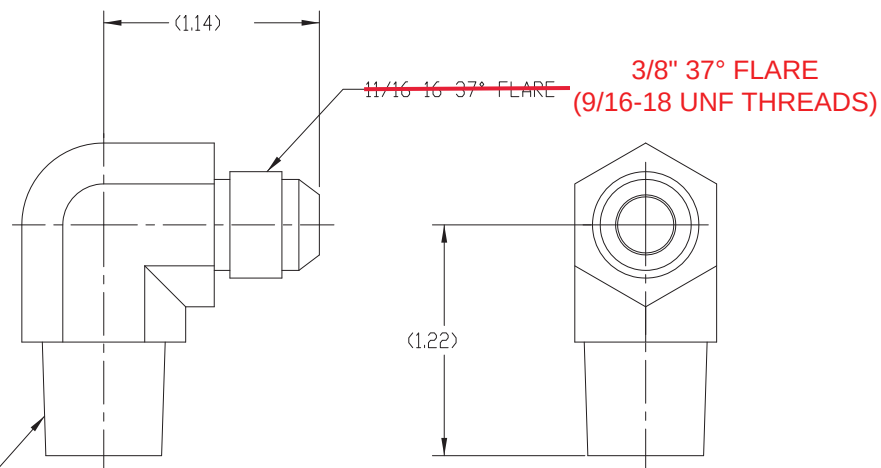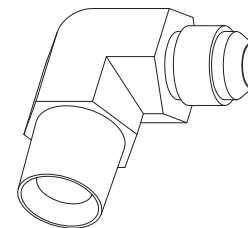

THIS DRAWING WAS GENERATED FROM A SOLID MODEL
AND IS CAD MAINTAINED. CHANGES SHALL BE
INCORPORATED BY THE DESIGN ACTIVITY.

VENDOR ITEM CONTROL DRAWING

 PART NO. 11E421315

PMIC				DO NOT SCALE DRAWING		CONTRACT NUMBER W52H0910P0057		US ARMY ARMAMENT RESEARCH, DEVELOPMENT AND ENGINEERING CENTER ROCK ISLAND, ILLINOIS 61299-7300			
				UNLESS OTHERWISE SPECIFIED DIMENSIONS ARE IN INCHES TOLERANCE ON ANGLES ± ° 2 PLACE DECIMALS ± 3 PLACE DECIMALS ±		CONTRACTOR ADVANCED CAD/CAM SERVICE		FITTING, ELBOW 90°, TUBE TO PIPE			
MECHANICAL PROPERTIES						DRAWN BY JOHN D DATE(YEAR-MO-DA) 2010-5-27					
YP						CHECKER ENGINEER G. SLAGER					
TS				THIRD ANGLE PROJECTION		ENGINEER QUALITY ENGINEER					
EL2								DRAWING APPROVAL DALE HOLLAND		SIZE C	
RA		11E421300	FRS							CAGE CODE 59678	DWG NO. 11E421315
BH		NEXT ASSY	USED ON	MATL ENGR	MODELED BY ERIC M	DESIGN APPROVAL THOMAS LETTIS		SCALE 2:000		UNIT WT. 0.187	SHEET 1 OF 1
RH		APPLICATION									

DISTRIBUTION STATEMENT A:
APPROVED FOR PUBLIC RELEASE:
DISTRIBUTION IS UNLIMITED

NOTES:

1. APPLICABLE STANDARDS/SPECIFICATIONS:

ASME Y14.100
ASME Y14.24-1999
ASME Y14.5M-1994

2. IDENTIFICATION OF THE SUGGESTED SOURCE(S) OF SUPPLY
HEREON IS NOT TO BE CONSTRUED AS A GUARANTEE OF
PRESENT OR CONTINUED AVAILABILITY AS A SOURCE OF
SUPPLY FOR THE ITEM(S).

6-8 CTX-S

SUGGESTED SOURCE(S) OF SUPPLY			
PART NO.	VENDOR		ITEM IDENTIFICATION
	ADDRESS	VENDOR PART NO.	
11E421443	PARKERHANNIFIN CORPORATION HOSE PRODUCTS DIVISION WICKLIFF, OHIO 44092 PH 440-943-5700	SM 751 16FB	FITTING, 90° ELBOW TUBE TO PIPE 11/16-12 37° FLARE 1/2" NPTF



ITEM NAME	DESCRIPTION
TYPE	90° TUBE TO PIPE ELBOW 11/16-12 37° FLARE TO 1/2" NPTF
MATERIAL	STEEL
FINISH	
SEAL	NONE
STANDARD	SAE 070202

3/8" 37° FLARE

(J514)

SUGGESTED SOURCE IS INACCURATE - PLEASE IGNORE

REVISIONS				
MODEL REV	DRAW REV	DESCRIPTION	DATE(YEAR-MO-DA)	APPROVED
	-	INITIAL RELEASE-ECP-K10o0001-NOR 214	2010-09-23	TAL
-1 ECP K1903005 2019-XX-XX CWH				

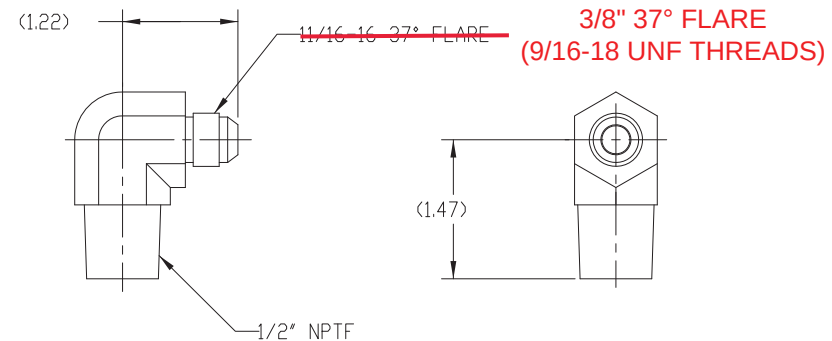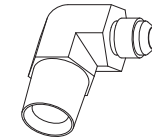

THIS DRAWING WAS GENERATED FROM A SOLID MODEL
AND IS CAD MAINTAINED. CHANGES SHALL BE
INCORPORATED BY THE DESIGN ACTIVITY.

VENDOR ITEM CONTROL DRAWING

PART NO. 11E421316

PMIC				DO NOT SCALE DRAWING		CONTRACT NUMBER		V52H0910P0057		US ARMY ARMAMENT RESEARCH, DEVELOPMENT AND ENGINEERING CENTER ROCK ISLAND, ILLINOIS 61299-7300													
MECHANICAL PROPERTIES				UNLESS OTHERWISE SPECIFIED DIMENSIONS ARE IN INCHES TOLERANCE ON ANGLES ± ° 2 PLACE DECIMALS ± 3 PLACE DECIMALS ±		CONTRACTOR		ADVANCED CAD/CAM SERVICE		FITTING, ELBOW, 90°, TUBE TO PIPE													
						DRAWN BY		DATE(YEAR-MO-DA)															
						JOHN D		2010-5-27															
						CHECKER		ENGINEER															
YP				THIRD ANGLE PROJECTION 		ENGINEER		G. SLAGER		SIZE C				CAGE CODE		DWG NO.							
TS						QUALITY ENGINEER		QUALITY ENGINEER						59678		11E421316							
EL2						DRAWING APPROVAL		DALE HOLLAND															
RA						DESIGN APPROVAL		THOMAS LETTIS															
BH		11E421300	FRS			MATERIAL ENGR		MODELED BY				SCALE		1.000		UNIT WT.		0.295		SHEET		1 OF 1	
RH		NEXT ASSY	USED ON																				

DISTRIBUTION STATEMENT A:
APPROVED FOR PUBLIC RELEASE:
DISTRIBUTION IS UNLIMITED

DRAWING SIZE C4

3

2

1

NOTES:

1. APPLICABLE STANDARDS/SPECIFICATIONS:
ASME Y14.100
ASME Y14.24-1999
ASME Y14.5M-1994

2. IDENTIFICATION OF THE SUGGESTED SOURCE(S) OF SUPPLY HEREON IS NOT TO BE CONSTRUED AS A GUARANTEE OF PRESENT OR CONTINUED AVAILABILITY AS A SOURCE OF SUPPLY FOR THE ITEM(S).

3. SPECIFICATIONS: 4650 PSI MIN WORKING PRESSURE AT 4:1 SAFETY FACTOR.

DETAIL 1: TUBE NUT, O-RING FACE SEAL, SEAL-LOK, STAINLESS STEEL.


DETAIL 2: TUBE, 0.250 OD, 0.028-0.035 WALL, STAINLESS STEEL, IAW ASTM A249 OR A269, GRADES 304 OR 316.

DETAIL 3: BRAZE SLEEVE, O-RING FACE SEAL, SEAL-LOK, STAINLESS STEEL.
OR: PARFLANGE SLEEVE, O-RING FACE SEAL, SEAL-LOK, STAINLESS STEEL.

DETAIL 4: SILVER BRAZE RING, SEAL-LOK.

SUGGESTED SOURCE(S) OF SUPPLY			
PART NO.	VENDOR		VENDOR PART NO.
	ADDRESS	CAGE CODE	
11E421405	PARKER HANNIFIN CORPORATION TUBE FITTINGS DIVISION 3385 GATEWAY BLVD. COLUMBUS, OH 43228 (614) 279-7685	1KPD5	SEE TABLE 1

TABLE 1		
DETAIL	VENDOR PART NO.	QTY
1	4 BL-SS	2
2	SEE NOTE 3	1
3	4 TL-SS	2
OR	4 TPL-SS	
4	4 SBR-SS	2

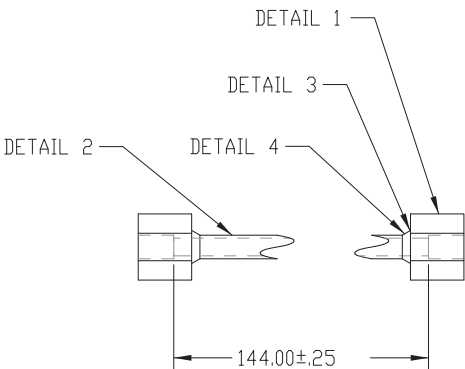

THIS DRAWING WAS GENERATED FROM A SOLID MODEL AND IS CAD MAINTAINED. CHANGES SHALL BE INCORPORATED BY THE DESIGN ACTIVITY.

VENDOR ITEM CONTROL DRAWING

PART NO. 11E421405

PMIC

MECHANICAL PROPERTIES

YP

TS

EL2

RA

BH

RH

11E421400

NEXT ASSY

APPLICATION

FRS

USED ON

DO NOT SCALE DRAWING

UNLESS OTHERWISE SPECIFIED
DIMENSIONS ARE IN INCHES
TOLERANCE ON ANGLES ± °
2 PLACE DECIMALS ±
3 PLACE DECIMALS ±

THIRD ANGLE PROJECTION

MATL ENGR

MODELED BY

CONTRACT NUMBER

CONTRACTOR

DRAWN BY

CHECKER

ENGINEER

DRAWING APPROVAL

DESIGN APPROVAL

WS2H0910P0057

ADVANCED CAD/CAM SERVICE

VANCE

ENGINEER

QUALITY ENGINEER

DALE HOLLAND

THOMAS LETTIS

US ARMY

ARMAMENT RESEARCH, DEVELOPMENT AND ENGINEERING CENTER

ROCK ISLAND, ILLINOIS 61299-7300

HYDRAULIC TUBE, SOLID

SIZE

CAGE CODE

DWG NO.

SCALE

UNIT WT.

SHEET

C

59678

11E421405

1.000

0.996

1 OF 1

DISTRIBUTION STATEMENT A:
APPROVED FOR PUBLIC RELEASE:
DISTRIBUTION IS UNLIMITED

4

3

2

1

FORMAT: C,TACOM_ENG_1.0

4

3

2

1

NOTES:

1. APPLICABLE STANDARDS/SPECIFICATIONS:
ASME Y14.100
ASME Y14.24-1999
ASME Y14.5M-1994
2. IDENTIFICATION OF THE SUGGESTED SOURCE(S) OF SUPPLY
HEREON IS NOT TO BE CONSTRUED AS A GUARANTEE OF
PRESENT OR CONTINUED AVAILABILITY AS A SOURCE OF
SUPPLY FOR THE ITEM(S).
3. SPECIFICATIONS: 3950 PSI MIN WORKING PRESSURE AT 4:1 SAFETY FACTOR.

DETAIL 1: TUBE NUT, O-RING FACE SEAL, SEAL-LOK, STAINLESS STEEL.

DETAIL 2: TUBE, 0.750 OD, 0.072-0.095 WALL, STAINLESS STEEL,
IAW ASTM A249 OR A269, GRADES 304 OR 316.

DETAIL 3: BRAZE SLEEVE, O-RING FACE SEAL, SEAL-LOK, STAINLESS STEEL.
OR: PARFLANGE SLEEVE, O-RING FACE SEAL, SEAL-LOK, STAINLESS STEEL.

DETAIL 4: SILVER BRAZE RING, SEAL-LOK.

SUGGESTED SOURCE(S) OF SUPPLY			
PART NO.	VENDOR		VENDOR PART NO.
	ADDRESS	CAGE CODE	
11E421406	PARKER HANNIFIN CORPORATION TUBE FITTINGS DIVISION 3385 GATEWAY BLVD. COLUMBUS, OH 43228 (614) 279-7685	1KPD5	SEE TABLE 1

REVISIONS				
MODEL REV	DRAW REV	DESCRIPTION	DATE(YEAR-MO-DA)	APPROVED
	-	INITIAL RELEASE-ECP-K10c0001-NDR 231	2010-09-23	TAL

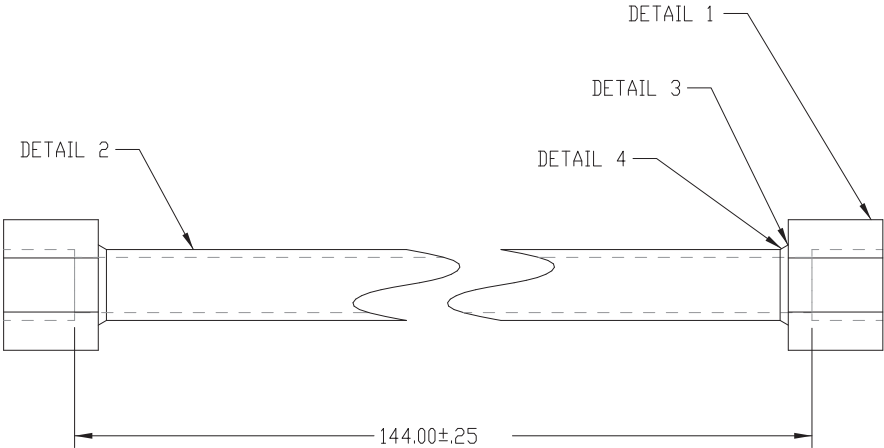


TABLE 1		
DETAIL	VENDOR PART NO.	QTY
1	12 BL-SS	2
2	SEE NOTE 3	1
3	12 TL-SS	2
OR	12 TPL-SS	
4	12 SBR-SS	2

THIS DRAWING WAS GENERATED FROM A SOLID MODEL
AND IS CAD MAINTAINED. CHANGES SHALL BE
INCORPORATED BY THE DESIGN ACTIVITY.

VENDOR ITEM CONTROL DRAWING

PART NO. 11E421406

DISTRIBUTION STATEMENT A:
APPROVED FOR PUBLIC RELEASE;
DISTRIBUTION IS UNLIMITED

PMIC			DO NOT SCALE DRAWING		CONTRACT NUMBER	W52H0910P0057	US ARMY ARMAMENT RESEARCH, DEVELOPMENT AND ENGINEERING CENTER ROCK ISLAND, ILLINOIS 61299-7300		
			UNLESS OTHERWISE SPECIFIED DIMENSIONS ARE IN INCHES TOLERANCE ON ANGLES ± ° 2 PLACE DECIMALS ± 3 PLACE DECIMALS ±		CONTRACTOR	ADVANCED CAD/CAM SERVICE			
	MECHANICAL PROPERTIES		THIRD ANGLE PROJECTION		DRAWN BY	DATE(YEAR-MO-DA) VANCE 2010-04-13	HYDRAULIC TUBE, SOLID		
	YP				CHECKER	ENGINEER G. SLAGER			
	TS				ENGINEER	QUALITY ENGINEER			
EL2			11E421400	FRS	DRAWING APPROVAL	DALE HOLLAND	SIZE	CAGE CODE	DWG NO.
RA			NEXT ASSY	USED ON	DESIGN APPROVAL	THOMAS LETTIS	C	59678	11E421406
BH			APPLICATION				SCALE	UNIT WT.	SHEET
RH							1.000	7.765	1 OF 1

NOTES:

1. APPLICABLE STANDARDS/SPECIFICATIONS:

ASME Y14.100
ASME Y14.24-1999
ASME Y14.5M-1994

2. IDENTIFICATION OF THE SUGGESTED SOURCE(S) OF SUPPLY
HEREON IS NOT TO BE CONSTRUED AS A GUARANTEE OF
PRESENT OR CONTINUED AVAILABILITY AS A SOURCE OF
SUPPLY FOR THE ITEM(S).

3. SPECIFICATIONS: 1350 PSI MIN WORKING PRESSURE AT 4:1 SAFETY FACTOR.

DETAIL 1: TUBE NUT, O-RING FACE SEAL, SEAL-LOK, STAINLESS STEEL.

DETAIL 2: TUBE, 1.000 OD, 0.035-0.065 WALL, STAINLESS STEEL,
IAW ASTM A249 OR A269, GRADES 304 OR 316.DETAIL 3: BRAZE SLEEVE, O-RING FACE SEAL, SEAL-LOK, STAINLESS STEEL.
OR: PARFLANGE SLEEVE, O-RING FACE SEAL, SEAL-LOK, STAINLESS STEEL.

DETAIL 4: SILVER BRAZE RING, SEAL-LOK.

SUGGESTED SOURCE(S) OF SUPPLY

PART NO.	VENDOR		VENDOR PART NO.
	ADDRESS	CAGE CODE	
11E421407	PARKER HANNIFIN CORPORATION TUBE FITTINGS DIVISION 3385 GATEWAY BLVD. COLUMBUS, OH 43228 (614) 279-7685	1KPD5	SEE TABLE 1

REVISIONS				
MODEL REV	DRAW REV	DESCRIPTION	DATE(YEAR-MO-DA)	APPROVED
	-	INITIAL RELEASE-ECP-K10c0001-NDR 232	2010-09-23	TAL

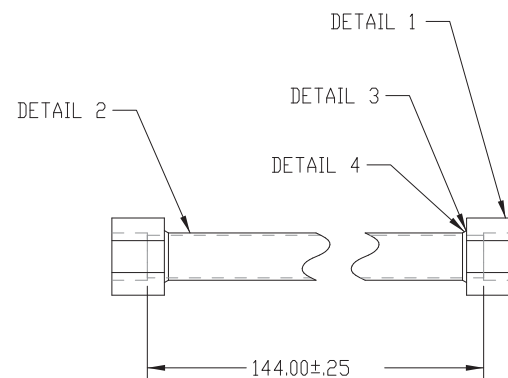


TABLE 1		
DETAIL	VENDOR PART NO.	QTY
1	16 BL-SS	2
2	SEE NOTE 3	1
3	16 TL-SS	2
OR	16 TPL-SS	
4	16 SBR-SS	2

THIS DRAWING WAS GENERATED FROM A SOLID MODEL
AND IS CAD MAINTAINED. CHANGES SHALL BE
INCORPORATED BY THE DESIGN ACTIVITY.

VENDOR ITEM CONTROL DRAWING

PART NO. 11E421407

DISTRIBUTION STATEMENT A:
APPROVED FOR PUBLIC RELEASE:
DISTRIBUTION IS UNLIMITED

PMIC			DO NOT SCALE DRAWING		CONTRACT NUMBER	WS2H0910P0057	US ARMY ARMAMENT RESEARCH, DEVELOPMENT AND ENGINEERING CENTER ROCK ISLAND, ILLINOIS 61299-7300		
			UNLESS OTHERWISE SPECIFIED DIMENSIONS ARE IN INCHES TOLERANCE ON ANGLES ± ° 2 PLACE DECIMALS ± 3 PLACE DECIMALS ±		CONTRACTOR	ADVANCED CAD/CAM SERVICE			
	MECHANICAL PROPERTIES		THIRD ANGLE PROJECTION		DRAWN BY	DATE(YEAR-MO-DA) VANCE 2010-04-11	HYDRAULIC TUBE, SOLID		
	YP				CHECKER	ENGINEER G. SLAGER			
TS			MATERIAL		ENGINEER	QUALITY ENGINEER	SIZE	CAGE CODE	DWG NO.
EL2			11E421400		DRAWING APPROVAL	DALE HOLLAND	C	59678	11E421407
RA			NEXT ASSY		DESIGN APPROVAL	THOMAS LETTIS	SCALE	0.500	UNIT WT. 6.972
BH			USED ON						SHEET 1 OF 1
RH			APPLICATION						

REVISIONS				
MODEL REV	DRAWING REV	DESCRIPTION	DATE/YEAR(MO-DA)	APPROVE
	-	INITIAL RELEASE- ECP-K1000001	2010-09-23	TAL
	A	ECP K1103022-037	2013-10-17	TAL
	A-1	ECP K1803005	2018-XX-XX	CW

NOTES:

1. APPLICABLE STANDARDS/SPECIFICATIONS:
ASME Y14.100
ASME Y14.24-1999
ASME Y14.5M-1994
2. IDENTIFICATION OF THE SUGGESTED SOURCE(S) OF SUPPLY
HEREON IS NOT TO BE CONSTRUED AS A GUARANTEE OF
PRESENT OR CONTINUED AVAILABILITY AS A SOURCE OF
SUPPLY FOR THE ITEM(S).
3. OVERALL LENGTH OF HOSE ASSEMBLY IS MEASURED FROM THE END OF THE STRAIGHT FITTING
OR CENTERLINE OF THE FITTING SEAT.
OVERALL LENGTH OF SEAL-LOK STYLE HOSE ASSEMBLIES ARE MEASURED TO THE SEALING SURFACE
OF THE STRAIGHT FITTING OR TO THE CENTERLINE OF THE ELBOW FITTING
4. DISPLACEMENT ANGLE: SPECIFIED ONLY IF (2) ELBOW FITTINGS ARE USED.
START WITH 1ST FITTING AS FAR END, MEASURE ANGLE CLOCKWISE FROM
1ST FITTING TO 2ND FITTING TO DETERMINE THE DISPLACEMENT ANGLE.
5. CAP PLUGS TO BE PLACED ON ASSEMBLY ENDS

THIS DRAWING WAS GENERATED FROM A SOLID MODEL
AND IS CAD MAINTAINED. CHANGES SHALL BE
INCORPORATED BY THE DESIGN ACTIVITY.

VENDOR ITEM CONTROL DRAWING

PART NO. 11E421410

PWC			DO NOT SCALE DRAWING		CONTRACT NUMBER W52H0910P0057		DESIGN ACTIVITY US ARMY	
			UNLESS OTHERWISE SPECIFIED DIMENSIONS ARE IN INCHES		CONTRACTOR ADVANCED CAD/CAM SERVICE		ARMAMENT RESEARCH, DEVELOPMENT AND ENGINEERING CENTER ROCK ISLAND, ILLINOIS 61206-7300	
MECHANICAL PROPERTIES			TOLERANCES ON ANGLES ± 2 PLACE DECIMALS ± 3 PLACE DECIMALS ±		DRAWN BY JOHN D		1-1/4" HOSE ASSY	
YP			THIRD ANGLE PROJECTION		DATE/TEAM/ORD 2010-5-28		ST LNG F ORFS SWIV	
TS					ENGINEER G. SLAGER		SAE CODE 61 FH	
BL2					CHECKER			
RA	11E421400 FRS				ENGINEER DALE HOLLAND		SIZE D	
BH	NEXT ASSY USED ON		MATERIAL		DRAWING APPROVAL		CASE CODE 59678	
GH	APPLICATION		MODELED BY		DESIGN APPROVAL		DWG NO. 11E421410	
			FRED E		THOMAS LETTIS		SCALE 1.000	
							UNIT WT. 0.000	
							SHEET 1 OF 1	

DISTRIBUTION STATEMENT A:
APPROVED FOR PUBLIC RELEASE:
DISTRIBUTION IS UNLIMITED

REVISIONS				
MODEL REV	DRAWING REV	DESCRIPTION	DATE/YEAR/MO/DA	APPROVAL
	-	INITIAL RELEASE-ECP-K1000001	2010-09-23	TAL
	A	ECP K1103022-038	2013-10-17	TAL

1. APPLICABLE STANDARDS/SPECIFICATIONS:

1. APPLICABLE STANDARDS/SPECIFICATIONS:
ASME Y14.100
ASME Y14.24-1999
ASME Y14.5M-1994
2. IDENTIFICATION OF THE SUGGESTED SOURCE(S) OF SUPPLY
HEREON IS NOT TO BE CONSTRUED AS A GUARANTEE OF
PRESENT OR CONTINUED AVAILABILITY AS A SOURCE OF
SUPPLY FOR THE ITEM(S).
3. OVERALL LENGTH OF HOSE ASSEMBLY IS MEASURED FROM THE END OF THE STRAIGHT FITTING
OR CENTERLINE OF THE FITTING SEAT.
OVERALL LENGTH OF SEAL-LOK STYLE HOSE ASSEMBLIES ARE MEASURED TO THE SEALING SURFACE
OF THE STRAIGHT FITTING OR TO THE CENTERLINE OF THE ELBOW FITTING
4. DISPLACEMENT ANGLE: SPECIFIED ONLY IF (2) ELBOW FITTINGS ARE USED.
START WITH 1ST FITTING AS FAR END. MEASURE ANGLE CLOCKWISE FROM
1ST FITTING TO 2ND FITTING TO DETERMINE THE DISPLACEMENT ANGLE
5. CAP PLUGS TO BE PLACED ON ASSEMBLY ENDS

THIS DRAWING WAS GENERATED FROM A SOLID MODEL
AND IS CAD MAINTAINED. CHANGES SHALL BE
INCORPORATED BY THE DESIGN ACTIVITY.

VENDOR ITEM CONTROL DRAWING

PART NO. 11E421411

PWC		DO NOT SCALE DRAWING		CONTRACT NUMBER W52H0910P0057		DESIGN ACTIVITY US ARMY	
		UNLESS OTHERWISE SPECIFIED DIMENSIONS ARE IN INCHES		CONTRACTOR		ARMAMENT RESEARCH, DEVELOPMENT AND ENGINEERING CENTER ROCK ISLAND, ILLINOIS 61226-7300	
MECHANICAL PROPERTIES				ADVANCED CAD/CAM SERVICE			
		TOLERANCES ON ANGLES ±		DRAWN BY DATE/ENTRY-ROOM/DA		1" HOSE ASSY	
YP		2 PLACE DECIMALS ±		JOHN D 2010-5-28		ST SHT F ORFS SWIV	
TS		3 PLACE DECIMALS ±		CHECKER ENGINEER		ST SHT F ORFS SWIV	
BL2				G. SLAGER			
RA				ENGINEER QUALITY ENGINEER			
BH		THIRD ANGLE PROJECTION		DRAWING APPROVAL		SIZE	
				DALE HOLLAND		DWG NO.	
11E421400		FRS				D	
NEXT ASSY		USED ON		DESIGN APPROVAL		59678	
APPLICATION		MATERIAL		THOMAS LETTIS		11E421411	
		MODELED BY				SCALE	
		FRED E				1.000	
						UNIT WT.	
						0.000	
						SHEET	
						1 OF 1	

DISTRIBUTION STATEMENT A:
APPROVED FOR PUBLIC RELEASE:
DISTRIBUTION IS UNLIMITED

REVISIONS				
MODEL REV	DRAWING REV	DESCRIPTION	DATE/YEAR-MO-DA	APPROVE
	-	INITIAL RELEASE-ECR-K1000001	2010-09-23	TAL
	A	ECR K1103022-039	2013-10-17	TAL

I. APPLICABLE STANDARDS/SPECIFICATIONS:
ASME Y14.100
ASME Y14.24-1999
ASME Y14.5M-1994

2. IDENTIFICATION OF THE SUGGESTED SOURCE(S) OF SUPPLY HEREON IS NOT TO BE CONSTRUED AS A GUARANTEE OF PRESENT OR CONTINUED AVAILABILITY AS A SOURCE OF SUPPLY FOR THE ITEM(S).
3. OVERALL LENGTH OF HOSE ASSEMBLY IS MEASURED FROM THE END OF THE STRAIGHT FITTING OR CENTERLINE OF THE FITTING SEAM. OVERALL LENGTH OF SEAL-LOK STYLE HOSE ASSEMBLIES ARE MEASURED TO THE SEALING SURFACE OF THE STRAIGHT FITTING OR TO THE CENTERLINE OF THE ELBOW FITTING.
4. DISPLACEMENT ANGLE: SPECIFIED ONLY IF (2) ELBOW FITTINGS ARE USED. START WITH 1ST FITTING AS FAR END. MEASURE ANGLE CLOCKWISE FROM 1ST FITTING TO 2ND FITTING TO DETERMINE THE DISPLACEMENT ANGLE.
5. CAP PLUGS TO BE PLACED ON ASSEMBLY ENDS

Technical drawing of a pipe assembly. The main view shows a pipe of length 112.4" ± 0.8" with two 90° elbows. Callout #1 points to the first elbow, and callout #2 points to the second elbow. A detail view on the right shows the 270° ± 2° bend angle.

THIS DRAWING WAS GENERATED FROM A SOLID MODEL
AND IS CAD MAINTAINED. CHANGES SHALL BE
INCORPORATED BY THE DESIGN ACTIVITY.

VENDOR ITEM CONTROL DRAWING

PART NO. 11E421412

PWC				DO NOT SCALE DRAWING		CONTRACT NUMBER W52H0910P0057		DESIGN ACTIVITY US ARMY	
				UNLESS OTHERWISE SPECIFIED DIMENSIONS ARE IN INCHES		CONTRACTOR		ARMAMENT RESEARCH, DEVELOPMENT AND ENGINEERING CENTER ROCK ISLAND, ILLINOIS 61206-7300	
MECHANICAL PROPERTIES				TOLERANCES ON ANGLES ± 2 PLACE DECIMALS 3 PLACE DECIMALS		ADVANCED CAD/CAM SERVICE		1 1/2" HOSE ASSY	
YP				THIRD ANGLE PROJECTION		DRAWN BY JOHN D		DATE/ENTRY/REV 2010-05-28	
TS						CHECKER G. SLAGER		90° SHT F ORFS SWIV	
BL2						ENGINEER QUALITY ENGINEER		90° SHT F ORFS SWIV	
RA		11E421400 FRS				DRAWING APPROVAL DALE HOLLAND		SIZE D	
BH		NEXT ASSY USED ON		MATERIAL		THOMAS LETTIS		CAGE CODE 59678	
GH		APPLICATION		MODELED BY FRED E		DESIGN APPROVAL		DWG NO. 11E421412	
								SCALE 0.500	
								UNIT WT. 3.324	
								SHEET 1 OF 1	

DISTRIBUTION STATEMENT A:
APPROVED FOR PUBLIC RELEASE:
DISTRIBUTION IS UNLIMITED


REVISIONS				
MODEL REV	DRAWING REV	DESCRIPTION	DATE/YEAR(MO-DA)	APPROVE
	-	INITIAL RELEASE- ECP-K1000001	2010-09-23	TAL
	A	ECP K1103022-040	2013-10-17	TAL
	A-3	ERR K1903005	2020-XX-XX	CWH

I. APPLICABLE STANDARDS/SPECIFICATIONS:
ASME Y14.100
ASME Y14.24-1999
ASME Y14.5M-1994

2. IDENTIFICATION OF THE SUGGESTED SOURCE(S) OF SUPPLY
HEREON IS NOT TO BE CONSTRUED AS A GUARANTEE OF
PRESENT OR CONTINUED AVAILABILITY AS A SOURCE OF
SUPPLY FOR THE ITEM(S).
3. OVERALL LENGTH OF HOSE ASSEMBLY IS MEASURED FROM THE END OF THE
STRAIGHT FITTING OR CENTERLINE OF THE FITTING SEAT.
OVERALL LENGTH OF SEAL-LOK STYLE HOSE ASSEMBLIES ARE MEASURED TO
THE SEALING SURFACE OF THE STRAIGHT FITTING OR TO THE CENTERLINE
OF THE ELBOW FITTING.
4. DISPLACEMENT ANGLE: SPECIFIED ONLY IF (2) ELBOW
FITTINGS ARE USED. START WITH 1ST FITTING AS FAR END,
MEASURE ANGLE CLOCKWISE FROM 1ST FITTING TO 2ND
FITTING TO DETERMINE THE DISPLACEMENT ANGLE.
5. CAP PLUGS TO BE PLACED ON ASSEMBLY ENDS

CORRECT ORDER OF
1ST AND 2ND

CRIMPED HOSE ASSEMBLY		
ITEM NAME	DESCRIPTION	DESCRIPTION
PREFIX DESCRIPTION	PARKCRIMP CRIMP FITTINGS F 722TC 19 J9 20 12 12 46 155	PARKCRIMP CRIMP HOSE ASSEMBLY F 787TC 19 J9 20 12 12 46 155
HOSE TYPE	HYDRAULIC HOSE, SAE 100R12 INNER TUBE: SYNTHETIC RUBBER, REINFORCE: FOUR SPIRAL STEEL WIRE, COVER: SYN RUBBER ABRASION RESISTANT, TEMP RANGE -40°F TO 257°F	HYDRAULIC HOSE, SAE 100R12 / ISO 18752, INNER TUBE: SYNTHETIC RUBBER, REINFORCE: FOUR SPIRAL STEEL WIRE, COVER: SYN RUBBER ABRASION RESISTANT TEMP RANGE -40°F TO 257°F
2ND 1ST FITTING END CONFIGURATION	FEMALE ORFS SEAL-LOK SWIVEL, 90° ELBOW, SHORT, 13943-12-12 IAW ISO 12151-1-SWE590 PARKER REF # 13971-12-12	FEMALE ORFS SEAL-LOK SWIVEL, 90° ELBOW, SHORT IAW ISO 12151-1-SWE590 PARKER REF # 13977-12-12
1ST 2ND FITTING END CONFIGURATION	SAE CODE 61 FLANGE HEAD 90° ELBOW IAW ISO 12151-3-E90S-L PARKER REF 11977-20-12	SAE CODE 61 FLANGE HEAD 90° ELBOW IAW ISO 12151-3-E90S-L PARKER REF 11977-20-12
2ND 1ST FITTING END SIZE	3/4", 1-3/16-12 THREAD	3/4", 1-3/16-12 THREAD
1ST 2ND FITTING END SIZE	1-1/4" FLANGE	1-1/4" FLANGE
HOSE SIZE	3/4" (-12)	3/4" (-12)
FITTING MATERIAL	STEEL, Zn CHROMATE PLATED	STEEL, Zn CHROMATE PLATED
OAL	46"	46"
DISPLACEMENT ANGLE	-205° 155°	155°
HOSE ASSY GUARD	N/A	N/A
HOSE SPECIFICATIONS	3/4" HOSE ID, 4000 PSI WORKING PRESSURE, 4.75" MIN BEND RADIUS, .94 LBS/FT PARKER REF 722TC SERIES	3/4" HOSE ID, 5000 PSI WORKING PRESSURE, 4.75" MIN BEND RADIUS, PARKER REF 787TC SERIES
LABELING	SLEEVE SHRINK LABEL, "11E241413" AND "VENDOR NAME AND PART NUMBER"	

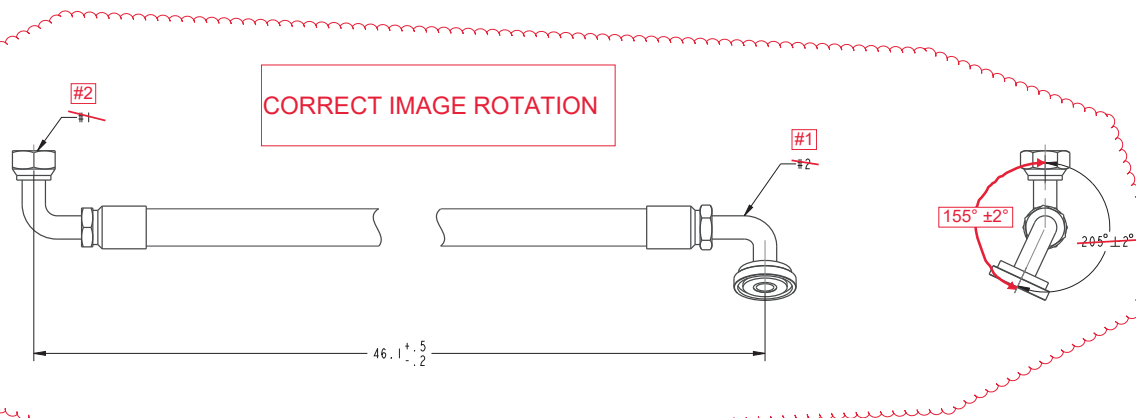

THIS DRAWING WAS GENERATED FROM A SOLID MODEL
AND IS CAD MAINTAINED. CHANGES SHALL BE
INCORPORATED BY THE DESIGN ACTIVITY.

VENDOR ITEM CONTROL DRAWING

PART NO. 11E421413

PMC				DO NOT SCALE DRAWING		CONTRACT NUMBER 1520910P0057		DESIGN ACTIVITY US ARMY ARMAMENT RESEARCH, DEVELOPMENT AND ENGINEERING CENTER ROCK ISLAND, ILLINOIS 61206-7300	
				UNLESS OTHERWISE SPECIFIED DIMENSIONS ARE IN INCHES		CONTRACTOR ADVANCED CAD/CAM SERVICE			
MECHANICAL PROPERTIES				TOLERANCES ON ANGLES ± 2 PLACE DECIMALS 3 PLACE DECIMALS		DRAWN BY JOHN D		DATE/TEAM/MDA 20/05-31	
						CHECKER ENGINEER		3 1/4" HOSE ASSY 90° SHT F ORFS SWIV 90° SAE CODE 61 FH	
YP				THIRD ANGLE PROJECTION 		ENGINEER G. SLAGER			
TS						QUALITY ENGINEER			
BL2									
RA									
BH		11E421400 FRS		MATERIAL		DRAWING APPROVAL DALE HOLLAND		SIZE D	
RH		NEXT ASSY USED ON		MODELED BY E820 F		DESIGN APPROVAL THOMAS J FTTIS		CAGE CODE 59678	
		APPLICATION						DIMO NO. 11E421413	
								SCALE 0.500	
								UNIT WT. 4.923	
								SHEET 1 OF 1	

DISTRIBUTION STATEMENT A:
APPROVED FOR PUBLIC RELEASE:
DISTRIBUTION IS UNLIMITED


REVISIONS				
MODEL REV	DRAWING REV	DESCRIPTION	DATE(YEAR-MO-DA)	APPROVE
	-	INITIAL RELEASE-ECP-K1000001	2010-09-23	TAL
	A	ECP K1103022-041	2013-10-17	TAL
	A-1	ECP K1903005	2020-XX-XX	CWH

I. APPLICABLE STANDARDS/SPECIFICATIONS:
ASME Y14.100
ASME Y14.24-1999
ASME Y14.5M-1994

2. IDENTIFICATION OF THE SUGGESTED SOURCE(S) OF SUPPLY
HEREON IS NOT TO BE CONSTRUED AS A GUARANTEE OF
PRESENT OR CONTINUED AVAILABILITY AS A SOURCE OF
SUPPLY FOR THE ITEM(S).
3. OVERALL LENGTH OF HOSE ASSEMBLY IS MEASURED FROM THE END OF THE
STRAIGHT FITTING OR CENTERLINE OF THE FITTING SEAT.
OVERALL LENGTH OF SEAL-LOK STYLE HOSE ASSEMBLIES ARE MEASURED TO
THE SEALING SURFACE OF THE STRAIGHT FITTING OR TO THE CENTERLINE
OF THE ELBOW FITTING.
4. DISPLACEMENT ANGLE: SPECIFIED ONLY IF (2) ELBOW
FITTINGS ARE USED. START WITH 1ST FITTING AS FAR END,
MEASURE ANGLE CLOCKWISE FROM 1ST FITTING TO 2ND
FITTING TO DETERMINE THE DISPLACEMENT ANGLE.
5. CAP PLUGS TO BE PLACED ON ASSEMBLY ENDS

-1J943-12-12

722TC

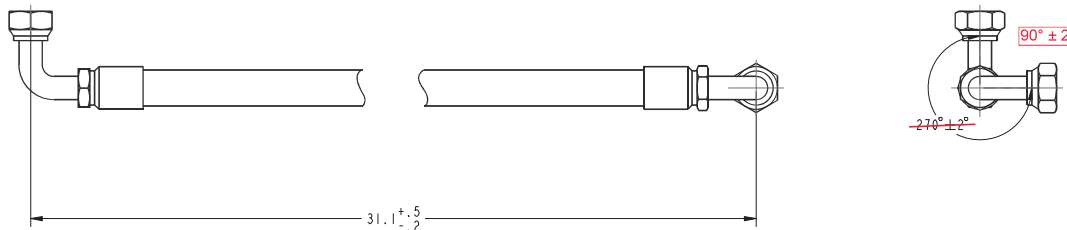

THIS DRAWING WAS GENERATED FROM A SOLID MODEL
AND IS CAD MAINTAINED. CHANGES SHALL BE
INCORPORATED BY THE DESIGN ACTIVITY.

PART NO. 11E421414

VENDOR ITEM CONTROL DRAWING

FMC				DO NOT SCALE DRAWING		CONTRACT NUMBER WS200901SP0057		DESIGN ACTIVITY US ARMY ARMAMENT RESEARCH, DEVELOPMENT AND ENGINEERING CENTER ROCK ISLAND, ILLINOIS 61209-7300	
MECHANICAL PROPERTIES				UNLESS OTHERWISE SPECIFIED DIMENSIONS ARE IN INCHES		CONTRACTOR ADVANCED CAD/CAM SERVICE			
				TOLERANCES ON ANGLES ± ° 2 PLACE DECIMALS ±		DRAWN BY JOHN D		DATE/TIME-NO DAY 2/10/09-5:31	
				THIRD ANGLE PROJECTION		CHECKER G. SLAGER		90° SHT F ORFS SWIV 90° SHT F ORFS SWIV	
						ENGINEER QUALITY ENGINEER			
YP						DRAWING APPROVAL		SIZE	
TS						DALE HOLLAND		D	
BL		11E421400	FRS					CAGE CODE	
BA								DWG NO.	
RH		NEXT ASSY	USED ON	MATL ENGR	MODELED BY	DESIGN APPROVAL		SCALE	
		APPLICATION			FRED F	THOMAS LETTIS		0.500	
								UNIT WT. 3.868	
								SHEET 1 OF 1	

DISTRIBUTION STATEMENT A:
APPROVED FOR PUBLIC RELEASE:
DISTRIBUTION IS UNLIMITED

REVISIONS				
MODEL REV	DRAWING REV	DESCRIPTION	DATE/YEAR-MO-DA	APPROVE
	-	INITIAL RELEASE-ECIP-K1000001	2010-09-23	TAL
	A	ECIP K1103022-042	2013-10-17	TAL

I. APPLICABLE STANDARDS/SPECIFICATIONS:
ASME Y14.100
ASME Y14.24-1999
ASME Y14.5M-1994

2. IDENTIFICATION OF THE SUGGESTED SOURCE(S) OF SUPPLY HEREON IS NOT TO BE CONSTRUED AS A GUARANTEE OF PRESENT OR CONTINUED AVAILABILITY AS A SOURCE OF SUPPLY FOR THE ITEM(S).
3. OVERALL LENGTH OF HOSE ASSEMBLY IS MEASURED FROM THE END OF THE STRAIGHT FITTING OR CENTERLINE OF THE FITTING SEAT. OVERALL LENGTH OF SEAL-LOK STYLE HOSE ASSEMBLIES ARE MEASURED TO THE SEALING SURFACE OF THE STRAIGHT FITTING OR TO THE CENTERLINE OF THE ELBOW FITTING.
4. DISPLACEMENT ANGLE: SPECIFIED ONLY IF (2) ELBOW FITTINGS ARE USED. START WITH 1ST FITTING AS FAR END, MEASURE ANGLE CLOCKWISE FROM 1ST FITTING TO 2ND FITTING TO DETERMINE THE DISPLACEMENT ANGLE.
5. CAP PLUGS TO BE PLACED ON ASSEMBLY ENDS

Technical drawing of the cable assembly. The drawing includes a side view and a detail view of the connector. The side view shows a cable with two connectors, labeled #1 and #2, with a length dimension of 23.2 ± 0.5 . The detail view shows the connector with a $180^\circ \pm 2^\circ$ angle.

THIS DRAWING WAS GENERATED FROM A SOLID MODEL
AND IS CAD MAINTAINED. CHANGES SHALL BE
INCORPORATED BY THE DESIGN ACTIVITY.

PART NO. 11E421415

VENDOR ITEM CONTROL DRAWING

PMIC				DO NOT SCALE DRAWING		CONTRACT NUMBER W52H010P0057		DESIGN ACTIVITY US ARMY	
				UNLESS OTHERWISE SPECIFIED DIMENSIONS ARE IN INCHES		CONTRACTOR ADVANCED CAD/CAM SERVICE		ARMAMENT RESEARCH, DEVELOPMENT AND ENGINEERING CENTER ROCK ISLAND, ILLINOIS 61206-7300	
MECHANICAL PROPERTIES				TOLERANCES ON ANGLES ± 2 PLACE DECIMALS 3 PLACE DECIMALS		DRAWN BY JOHN D		DATE/YEAR-MO-DA 2010-05-31	
YP				THIRD ANGLE PROJECTION		CHECKER G. SLAGER		1 1/4" HOSE ASSY	
TS						ENGINEER QUALITY ENGINEER		90° SHT F ORFS SWIV	
BL2						DRAWING APPROVAL DALE HOLLAND		90° SHT F ORFS SWIV	
RA		11E421400 FRS				SIZE D		CASE CODE 59678	
BH		NEXT ASSY USED ON		MATERIAL ENGR		DESIGN APPROVAL THOMAS LETTIS		DWG NO. 11E421415	
RH		APPLICATION		MODELED BY FRED E		SCALE 0.500		UNIT WT. 2.978	
								SHEET 1 OF 1	

DISTRIBUTION STATEMENT A:
APPROVED FOR PUBLIC RELEASE:
DISTRIBUTION IS UNLIMITED

REVISIONS				
MODEL REV	DRAWING REV	DESCRIPTION	DATE/YEAR-MO-DA	APPROVE
	-	INITIAL RELEASE-ECIP-K1000001	2010-09-23	TAL
	A	ECIP K1103022-043	2013-10-17	TAL

I. APPLICABLE STANDARDS/SPECIFICATIONS
ASME Y14.24-1999
ASME Y14.100
ASME Y14.5M-1994

2. IDENTIFICATION OF THE SUGGESTED SOURCE(S) OF SUPPLY
HEREON IS NOT TO BE CONSTRUED AS A GUARANTEE OF
PRESENT OR CONTINUED AVAILABILITY AS A SOURCE
FOR THE ITEM DESCRIBED ON THIS DRAWING
3. OVERALL LENGTH OF HOSE ASSEMBLY IS MEASURED FROM THE END OF THE
STRAIGHT FITTING OR CENTERLINE OF THE FITTING SEAT.
OVERALL LENGTH OF SEAL-LOK STYLE HOSE ASSEMBLIES ARE MEASURED TO
THE SEALING SURFACE OF THE STRAIGHT FITTING OR TO THE CENTERLINE
OF THE ELBOW FITTING.
4. DISPLACEMENT ANGLE: SPECIFIED ONLY IF (2) ELBOW
FITTINGS ARE USED. START WITH 1ST FITTING AS FAR END,
MEASURE ANGLE CLOCKWISE FROM 1ST FITTING TO 2ND
FITTING TO DETERMINE THE DISPLACEMENT ANGLE.
5. CAP PLUGS TO BE PLACED ON ASSEMBLY ENDS

Figure 1 is a schematic diagram of the experimental setup. It shows a horizontal tube connected to a vertical tube on the left. The vertical tube has a pressure tap labeled #1. The horizontal tube has a pressure tap labeled #2. A dimension line below the horizontal tube indicates a length of 32.0 ± 0.5 cm.

THIS DRAWING WAS GENERATED FROM A SOLID MODEL
AND IS CAD MAINTAINED. CHANGES SHALL BE
INCORPORATED BY THE DESIGN ACTIVITY.

PART NO. 11E421416

VENDOR ITEM CONTROL DRAWING

P/MC				DO NOT SCALE DRAWING UNLESS OTHERWISE SPECIFIED DIMENSIONS ARE IN INCHES		CONTRACT NUMBER W52H010P0057		DESIGN ACTIVITY US ARMY ARMAMENT RESEARCH, DEVELOPMENT AND ENGINEERING CENTER ROCK ISLAND, ILLINOIS 61296-7300	
MECHANICAL PROPERTIES				TOLERANCES ON ANGLES ± 2 PLACE DECIMALS ± 3 PLACE DECIMALS ±		CONTRACTOR ADVANCED CAD/CAM SERVICE			
						DRAWN BY JOHN D		DATE/YEAR-AD-DAY 2010-5-28	
						CHECKER ENGINEER		1/4" HOSE ASSY ST SHT F ORFS SWIV	
						ENGINEER G. SLAGER		QUALITY ENGINEER ST SHT F ORFS SWIV	
YP						DRAWING APPROVAL			
TS						DALE HOLLAND			
EL2						DESIGN APPROVAL			
RA						THOMAS LETTIS			
BH		11E421400	FRS	MTRL ENGR		MODELED BY		FRED E	
GH		NEXT ASSY	USED ON	APPLICATION		SCALE		0.500	
						UNIT WT.		2.756	
						SHEET		1 OF 1	

DISTRIBUTION STATEMENT A:
APPROVED FOR PUBLIC RELEASE:
DISTRIBUTION IS UNLIMITED

REVISIONS				
MODEL REV	DRAWING REV	DESCRIPTION	DATE/REV(MO-DA)	APPROVE
	-	INITIAL RELEASE- ECP-K1000001	2010-09-23	TAL
	A	ECP K1103022-044	2013-10-17	TAL
	A-1	ECP K1903005	2020-XX-XX	CWH


I. APPLICABLE STANDARDS/SPECIFICATIONS
ASME Y14.24-1999
ASME Y14.100
ASME Y14.5-1994

2. IDENTIFICATION OF THE SUGGESTED SOURCE(S) OF SUPPLY
HEREON IS NOT TO BE CONSTRUED AS A GUARANTEE OF
PRESENT OR CONTINUED AVAILABILITY AS A SOURCE
FOR THE ITEM DESCRIBED ON THIS DRAWING
3. OVERALL LENGTH OF HOSE ASSEMBLY IS MEASURED FROM THE END OF THE
STRAIGHT FITTING OR CENTERLINE OF THE FITTING SEAT.
OVERALL LENGTH OF SEAL-LOK STYLE HOSE ASSEMBLIES ARE MEASURED TO
THE SEALING SURFACE OF THE STRAIGHT FITTING OR TO THE CENTERLINE
OF THE ELBOW FITTING.
4. DISPLACEMENT ANGLE: SPECIFIED ONLY IF (2) ELBOW
FITTINGS ARE USED. START WITH 1ST FITTING AS BAR END,
MEASURE ANGLE CLOCKWISE FROM 1ST FITTING TO 2ND
FITTING TO DETERMINE THE DISPLACEMENT ANGLE.
5. CAP PLUGS TO BE PLACED ON ASSEMBLY ENDS

1JC43-12-12

1JC43-12-12

-722TC

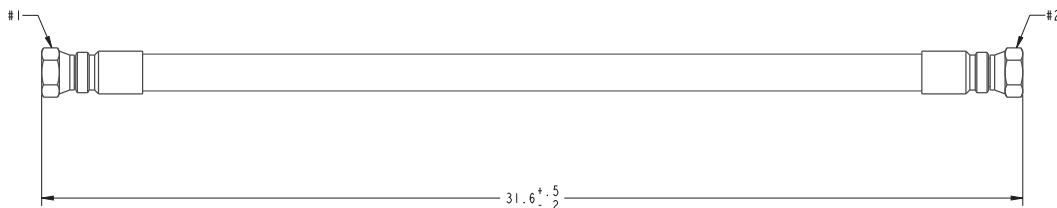

THIS DRAWING WAS GENERATED FROM A SOLID MODEL
AND IS CAD MAINTAINED. CHANGES SHALL BE
INCORPORATED BY THE DESIGN ACTIVITY.

PART NO. 11E421417

VENDOR ITEM CONTROL DRAWING


PWC		DO NOT SCALE DRAWING		CONTRACT NUMBER W52H0910P0057	DESIGN ACTIVITY US ARMY	
		UNLESS OTHERWISE SPECIFIED DIMENSIONS ARE IN INCHES		CONTRACTOR ADVANCED CAD/CAM SERVICE	ARMAMENT RESEARCH, DEVELOPMENT AND ENGINEERING CENTER ROCK ISLAND, ILLINOIS 61206-7300	
Mechanical Properties		TOLERANCES ON ANGLES ± 2 PLACE DECIMALS ± 3 PLACE DECIMALS ±		DRAWN BY JOHN D	DATE/TIME-MOD-DAY 2010-5-28	
YP				CHECKER G. SLAGER	3/4" HOSE ASSY	
TS				ENGINEER QUALITY ENGINEER	ST SHT F ORFS SWIV	
B/L					ST SHT F ORFS SWIV	
RA						
BH	11E421400	FRS		DRAWING APPROVAL DALE HOLLAND	SIZE D	CAGE CODE 59678
GH	NEXT ASSY	USED ON	MATL ENGR	DESIGN APPROVAL THOMAS LETTIS	DWG NO. 11E421417	
	APPLICATION		FRED E		SCALE 0.500	UNIT WT. 3.533
					SHEET 1	OF 1

DISTRIBUTION STATEMENT A:
APPROVED FOR PUBLIC RELEASE:
DISTRIBUTION IS UNLIMITED

REVISIONS				
MODEL REV	DRAWING REV	DESCRIPTION	DATE/YEAR-MO-DA	APPROVE
	-	INITIAL RELEASE- ECP-K1000001	2010-09-23	TAL
	A	ECP K1103022-045	2013-10-17	TAL

ASME Y14.100
ASME Y14.24-1999
ASME Y14.5M-1994

- | ITEM NAME | DESCRIPTION |
|-------------------------------|---|
| PREFIX DESCRIPTION | PARKCRIMP CRIMP FITTINGS |
| HOSE TYPE | HYDRAULIC HOSE, SAE 100R1
TYPE AT, INNER TUBE: NITRILE,
REINFORCE: ONE BRAID STEEL WIRE
COVER: SYN RUBBER
TEMP RANGE -40°F TO 212°F |
| 1ST FITTING END CONFIGURATION | FEMALE ORFS SEAL-LOK SWIVEL,
STRAIGHT, SHORT, 1AW
ISO 12151-1-SWSA
PARKER REF # 1JC43-16-16 |
| 2ND FITTING END CONFIGURATION | FEMALE ORFS SEAL-LOK SWIVEL,
STRAIGHT, SHORT, 1AW
ISO 12151-1-SWSA
PARKER REF # 1JC43-16-16 |
| 1ST FITTING END SIZE | 1", 1-7/16-12 THREAD |
| 2ND FITTING END SIZE | 1", 1-7/16-12 THREAD |
| HOSE SIZE | 1" |
| FITTING MATERIAL | STEEL, Zn CHROMATE PLATED |
| OAL | 32" |
| DISPLACEMENT ANGLE | N/A |
| HOSE ASSY GUARD | N/A |
| HOSE SPECIFICATIONS | 1" HOSE ID, 1275 PSI WORKING
PRESSURE, 12" MIN BEND RADIUS,
.63 LBS/FT,
PARKER REF 422 SERIES |
| LABELING | SLEEVE SHRINK LABEL, "11E421418"
AND "VENDOR NAME AND PART NUMBER" |

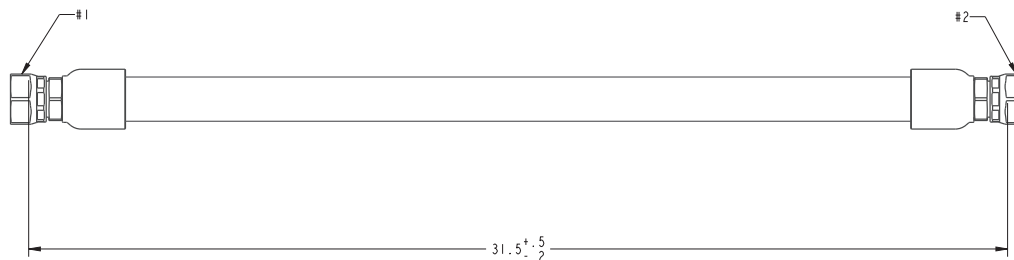

THIS DRAWING WAS GENERATED FROM A SOLID MODEL
AND IS CAD MAINTAINED. CHANGES SHALL BE
INCORPORATED BY THE DESIGN ACTIVITY.

PART NO. 11E421418

PWC				DO NOT SCALE DRAWING		CONTRACT NUMBER W52H0910P0057		DESIGN ACTIVITY US ARMY			
				UNLESS OTHERWISE SPECIFIED DIMENSIONS ARE IN INCHES		CONTRACTOR		ARMAMENT RESEARCH, DEVELOPMENT AND ENGINEERING CENTER ROCK ISLAND, ILLINOIS 61226-7300			
MECHANICAL PROPERTIES				TOLERANCES ON ANGLES ± 2 PLACE DECIMALS ± 3 PLACE DECIMALS ±		ADVANCED CAD/CAM SERVICE		1" HOSE ASSY			
YP				THIRD ANGLE PROJECTION 		DRAWN BY JOHN D		DATE/TIME-ROOM 2010-5-28			
TS						CHECKER G. SLAGER		ENGINEER QUALITY ENGINEER		ST SHT F ORFS SWIV	
BL2						DRAWING APPROVAL DALE HOLLAND		SIZE D		CAGE CODE 59678	
RA		11E421400 FRS				DESIGN APPROVAL THOMAS LETTIS		DWG NO. 11E421418		SCALE 0.500	
BH		NEXT ASSY USED ON		MATERIAL FRED F		UNIT WT. 3.387		SHEET 1 OF 1			
GH		APPLICATION									

DISTRIBUTION STATEMENT A:
APPROVED FOR PUBLIC RELEASE:
DISTRIBUTION IS UNLIMITED

REVISIONS				
MODEL REV	DRAWING REV	DESCRIPTION	DATE/YEAR-MO-DA	APPROVE
	-	INITIAL RELEASE-ECP-K1000001	2010-09-23	TAL
	A	ECP K1103022-046	2013-10-17	TAL

ASME Y14.100
ASME Y14.24-1999
ASME Y14.5M-1994

IDENTIFICATION OF THE SUGGESTED SOURCE(S) OF SUPPLY
HEREON IS NOT TO BE CONSTRUED AS A GUARANTEE OF
PRESENT OR CONTINUED AVAILABILITY AS A SOURCE OF
SUPPLY FOR THE ITEM(S)

DISPLACEMENT ANGLE: SPECIFIED ONLY IF (2) ELBOW FITTINGS ARE USED. START WITH 1ST FITTING AS FAR END, MEASURE ANGLE CLOCKWISE FROM 1ST FITTING TO 2ND FITTING TO DETERMINE THE DISPLACEMENT ANGLE.

Technical drawing of a cable assembly. The drawing shows a cable with a length dimension of $87.8^{+0.8}$. Callout #1 points to the left end of the cable, and callout #2 points to the right end. The cable is shown in a bent configuration, with the ends labeled #1 and #2. The drawing is a line drawing with no shading.

PART NO. 11E421419

PART NO. 11E421419

DISTRIBUTION STATEMENT A:
APPROVED FOR PUBLIC RELEASE:
DISTRIBUTION IS UNLIMITED

REVISIONS				
MODEL REV	DRAWING REV	DESCRIPTION	DATE/REV(MO-DA)	APPROVE
	-	INITIAL RELEASE- ECP-K1000001	2010-09-23	TAL
	A	ECP K1103022-047	2013-10-17	TAL
	A-1	ECP K1903005	2020-XX-XX	CWH

I. APPLICABLE STANDARDS/SPECIFICATIONS:
ASME Y14.100
ASME Y14.24-1999
ASME Y14.5M-1994

2. IDENTIFICATION OF THE SUGGESTED SOURCE(S) OF SUPPLY
HEREON IS NOT TO BE CONSTRUED AS A GUARANTEE OF
PRESENT OR CONTINUED AVAILABILITY AS A SOURCE OF
SUPPLY FOR THE ITEM(S)


3. OVERALL LENGTH OF HOSE ASSEMBLY IS MEASURED FROM THE END OF THE STRAIGHT FITTING OR CENTERLINE OF THE FITTING SEAT. OVERALL LENGTH OF SEAL-LOK STYLE HOSE ASSEMBLIES ARE MEASURED TO THE SEALING SURFACE OF THE STRAIGHT FITTING OR TO THE CENTERLINE OF THE ELBOW FITTING.

4. DISPLACEMENT ANGLE: SPECIFIED ONLY IF (2) ELBOW FITTINGS ARE USED. START WITH 1ST FITTING AS FAR END, MEASURE ANGLE CLOCKWISE FROM 1ST FITTING TO 2ND FITTING TO DETERMINE THE DISPLACEMENT ANGLE.

5. CAP PLUGS TO BE PLACED ON ASSEMBLY ENDS.

-1J943-12-12

-722TC

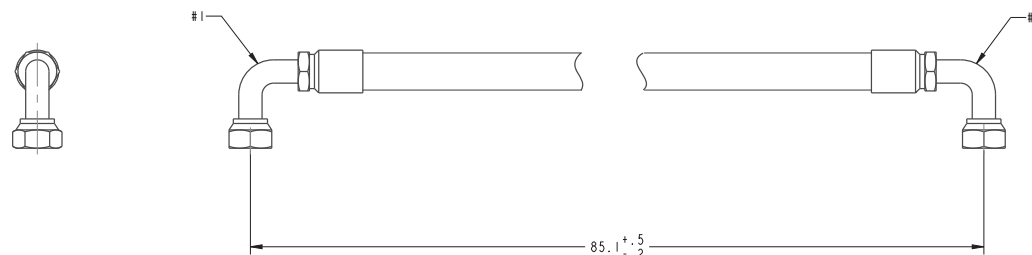

THIS DRAWING WAS GENERATED FROM A SOLID MODEL
AND IS CAD MAINTAINED. CHANGES SHALL BE
INCORPORATED BY THE DESIGN ACTIVITY.

PART NO. 11E421420

VENDOR ITEM CONTROL DRAWING


PWC			DO NOT SCALE DRAWING		CONTRACT NUMBER W52H0910P0057	DESIGN ACTIVITY US ARMY	
			UNLESS OTHERWISE SPECIFIED DIMENSIONS ARE IN INCHES		CONTRACTOR	ARMAMENT RESEARCH, DEVELOPMENT AND ENGINEERING CENTER ROCK ISLAND, ILLINOIS 61296-7300	
MECHANICAL PROPERTIES			TOLERANCES ON ANGLES ± 2 PLACE DECIMALS 3 PLACE DECIMALS ±		ADVANCED CAD/CAM SERVICE		
YP			THIRD ANGLE PROJECTION 		DRAWN BY JOHN D	DATE/ENTRY-ROOM 2016-5-28	
TS					CHECKER ENGINEER	G. SLAGER	
BL2					ENGINEER	QUALITY ENGINEER	
RA							
BH	11E421400	FRS			DRAWING APPROVAL DALE HOLLAND	SIZE D	CAGE CODE 59678
RI	NEXT ASSY	USED ON	MATL ENGR	MODELED BY SERN F	DESIGN APPROVAL THOMAS J FTTIS	DWG NO. 11E421420	
APPLICATION			SCALE 0.500 UNIT WT. 0.838 SHEET 1 OF 1				

DISTRIBUTION STATEMENT A:
APPROVED FOR PUBLIC RELEASE:
DISTRIBUTION IS UNLIMITED

REVISIONS				
MODEL REV	DRAWING REV	DESCRIPTION	DATE/YEAR-MO-DA	APPROVE
	-	INITIAL RELEASE-ECF-K1000001	2010-09-23	TAL
	A	ECF K1103022-048	2013-10-17	TAL

ASME Y14.100
ASME Y14.24-1999
ASME Y14.5M-1994

- DISTRIBUTION STATEMENT A:
APPROVED FOR PUBLIC RELEASE:
DISTRIBUTION IS UNLIMITED

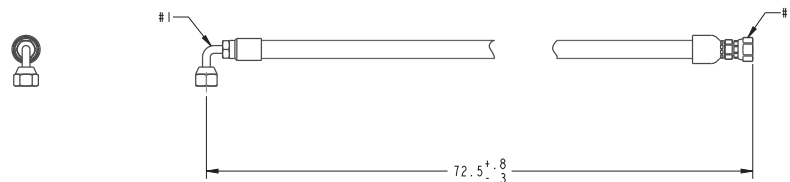

THIS DRAWING WAS GENERATED FROM A SOLID MODEL
AND IS CAD MAINTAINED. CHANGES SHALL BE
INCORPORATED BY THE DESIGN ACTIVITY.

PART NO. 11E421421

PWC			DO NOT SCALE DRAWING		CONTRACT NUMBER W52H0910P0057		DESIGN ACTIVITY US ARMY	
			UNLESS OTHERWISE SPECIFIED DIMENSIONS ARE IN INCHES		CONTRACTOR ADVANCED CAD/CAM SERVICE		ARMAMENT RESEARCH, DEVELOPMENT AND ENGINEERING CENTER ROCK ISLAND, ILLINOIS 61206-7300	
MECHANICAL PROPERTIES			TOLERANCES ON ANGLES ± 2 PLACE DECIMALS ± 3 PLACE DECIMALS ±		DRAWN BY JOHN D		DATE/ENTRY-ROOM/DA 2010-05-28	
YP			THIRD ANGLE PROJECTION 		CHECKER G. SLAGER		1 1/4" HOSE ASSY	
TS					ENGINEER QUALITY ENGINEER		90° SHT F ORFS SWIV	
BL2							ST SHT F ORFS SWIV	
RA								
BH	11E421400		FRS		DRAWING APPROVAL DALE HOLLAND		SIZE D	CAGE CODE 59678
GH	NEXT ASSY		USED ON	MATL ENGR	MODELED BY	DESIGN APPROVAL THOMAS LETTIS	DWG NO. 11E421421	
APPLICATION				FRED F		SCALE 0.500		
						UNIT WT. 1.809		
						SHEET 1 OF 1		

NOTES:

1. APPLICABLE STANDARDS/SPECIFICATIONS:

ASME Y14.100
ASME Y14.24-1999
ASME Y14.5M-1994




2. IDENTIFICATION OF THE SUGGESTED SOURCE(S) OF SUPPLY
HEREON IS NOT TO BE CONSTRUED AS A GUARANTEE OF
PRESENT OR CONTINUED AVAILABILITY AS A SOURCE OF
SUPPLY FOR THE ITEM(S).

SUGGESTED SOURCE(S) OF SUPPLY

PART NO.	VENDOR		VENDOR PART NO.	ITEM IDENTIFICATION
	ADDRESS	CAGE CODE		
11E421422	PARKER HANNIFIN CORPORATION TUBE FITTINGS DIVISION COLUMBUS, OHIO 43228 PH 614-279-7070	05779	WPF310QEBM2KS16 WITH 941626	HYDRAULIC FILTER ASSEMBLY WITH EXTRA LABEL, 1" PORTS, 10 MICRON

ITEM NAME	DESCRIPTION
TYPE	HIGH PRESSURE FILTER
PORTS	1" NOM PORTS STEEL
MEDIA	10 MICRON
SEALS	NITRILE
INDICATOR	VISUAL AUTOMATIC RESET
BYPASS	50 PSID
PORT SPECS	SAE -16 PORTS
OPTION 1	WITH BYPASS
OPTION 2	EXTRA FILTER LABEL- PROVIDE EXTRA STICKER ON BOWL, EXISTING METALIC TAG NOT VISIBLE IN INSTALLATION (180° FROM METAL TAG)
DESIGN SAFETY FACTOR	3 : 1
OPERATING TEMPERATURE	-15°F TO 250°F
MATERIALS	HEAD-SG IRON, BOWL- STEEL, INDICATOR- STAINLESS STEEL W/PLASTIC CONNECTIONS


REVISIONS				
MODEL REV	DRAW REV	DESCRIPTION	DATE(YEAR-MO-DA)	APPROVED
	-	INITIAL RELEASE-ECP-K10a0001-NDR 247	2010-09-23	TAL

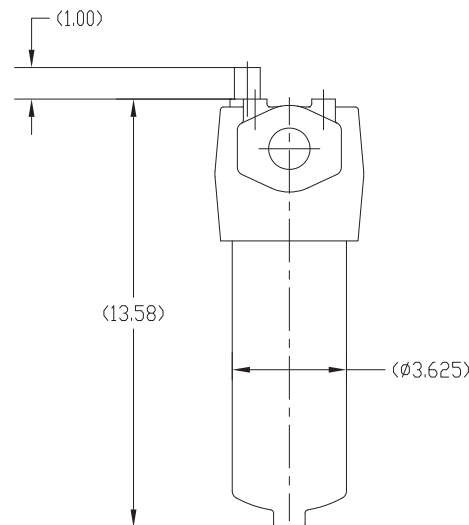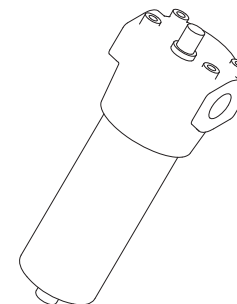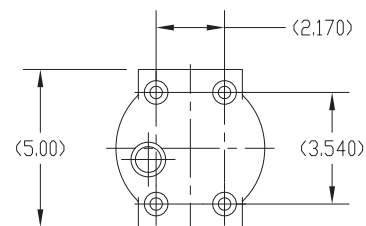

THIS DRAWING WAS GENERATED FROM A SOLID MODEL
AND IS CAD MAINTAINED. CHANGES SHALL BE
INCORPORATED BY THE DESIGN ACTIVITY.

VENDOR ITEM CONTROL DRAWING

PART NO. 11E421422

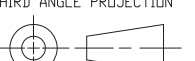PMIC				DO NOT SCALE DRAWING		CONTRACT NUMBER		W52H0910P0057		US ARMY ARMAMENT RESEARCH, DEVELOPMENT AND ENGINEERING CENTER ROCK ISLAND, ILLINOIS 61299-7300							
				UNLESS OTHERWISE SPECIFIED DIMENSIONS ARE IN INCHES TOLERANCE ON ANGLES ± ° 2 PLACE DECIMALS ± 3 PLACE DECIMALS ±		CONTRACTOR		ADVANCED CAD/CAM SERVICE									
MECHANICAL PROPERTIES						DRAWN BY		JOHN D		DATE(YEAR-MO-DA)		FILTER ASSEMBLY, HYDRAULIC OIL, 10 MICRON					
YP						CHECKER		ENGINEER		2010-5-26							
TS								G. SLAGER									
EL2						ENGINEER		QUALITY_ENGINEER									
RA																	
BH		11E421400		FRS		THIRD ANGLE PROJECTION 		DRAWING APPROVAL		DALE HOLLAND		SIZE	CAGE CODE	DWG NO.			
RH		NEXT ASSY		USED ON				DESIGN APPROVAL		THOMAS LETTIS		C	59678	11E421422			
		APPLICATION				MATL ENGR		MODELED BY				SCALE	0.333	UNIT WT.	0.000	SHEET	1 OF 1
								ERIC M									

DISTRIBUTION STATEMENT A:
APPROVED FOR PUBLIC RELEASE:
DISTRIBUTION IS UNLIMITED



NOTES:

1. APPLICABLE STANDARDS/SPECIFICATIONS:
 - A. ASME Y14.100-2017
 - B. ASME Y14.5-2009
2. IDENTIFICATION OF THE SUGGESTED SOURCES OF SUPPLY HEREON IS NOT TO BE CONSTRUED AS A GUARANTEE OF PRESENT OR CONTINUED AVAILABILITY AS A SOURCE OF SUPPLY FOR THE ITEM(S).

SPECIFICATIONS	
TYPE	COVER PLATE
MATERIAL	STEEL
FINISH	ZINC-NICKEL PLATED

SUGGESTED SOURCE(S) OF SUPPLY			
PART NO.	VENDOR		VENDOR PART NO.
	ADDRESS	CAGE CODE	
11E421424	PARKER-HANNIFIN CORPORATION 3885 GATEWAY BLVD COLUMBUS, OH 43228 PHONE: 614-279-7070	30780	CP-1A

REVISIONS			
REVISION	DESCRIPTION	DATE(YEAR-MO-DA)	APPROVED
X0	ECP K1803005	2019-XX-XX	CWH

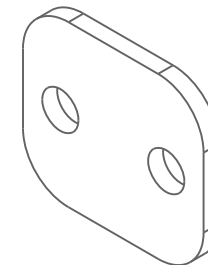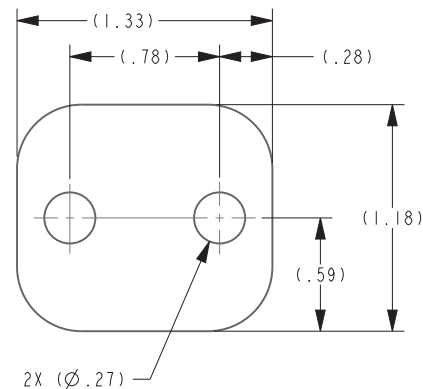

ISO VIEW



THIS DRAWING WAS GENERATED FROM A SOLID MODEL
AND IS CAD MAINTAINED. CHANGES SHALL BE
INCORPORATED BY THE DESIGN ACTIVITY.

VENDOR ITEM CONTROL DRAWING

PART NO. 11E421424

PMIC		DO NOT SCALE DRAWING		CONTRACT NUMBER		DESIGN ACTIVITY	
		UNLESS OTHERWISE SPECIFIED DIMENSIONS ARE IN INCHES		CONTRACTOR		US ARMY ARMAMENT RESEARCH, DEVELOPMENT AND ENGINEERING CENTER ROCK ISLAND, ILLINOIS 61299-5000	
MECHANICAL PROPERTIES		TOLERANCE ON ANGLES ± ° 2 PLACE DECIMALS ± 3 PLACE DECIMALS ±		DRAWN BY N. FOXEN	DATE(YEAR-MO-DA) 2019-02-14	PLATE, MOUNTING	
YP		THIRD ANGLE PROJECTION		CHECKER J. MILLER	ENGINEER N. FOXEN		
TS				ENGINEER	QUALITY ENGINEER		
EL2				DRAWING APPROVAL V. VONDERA		SIZE C	DAI 59678
RA		11E421400	FRS	DESIGN APPROVAL C. HANEY		DWG NO. 11E421424	
BH		NEXT ASSY	USED ON			SCALE 2/1	UNIT WT. 0.047
RH		APPLICATION				SHEET 1 OF 1	

DISTRIBUTION STATEMENT A.
APPROVED FOR PUBLIC RELEASE;
DISTRIBUTION IS UNLIMITED.

SUGGESTED SOURCE(S) OF SUPPLY


PART NO.	VENDOR		VENDOR PART NO.	ITEM IDENTIFICATION
	ADDRESS	CAGE CODE		
11E421430	PARKER HANNIFIN CORPORATION TUBE FITTINGS DIVISION COLUMBUS, OHIO 43228 PH 614-279-7070	1KP05	20 50LO-S	S50LO-S STRAIGHT THREAD BRANCH TEE, STEEL

REVISIONS


MODEL REV	DRAW REV	DESCRIPTION	DATE(YEAR-MO-DA)	APPROVED
	-	INITIAL RELEASE-ECP-K1000001	2010-09-23	TAL
	A	ECP K1103022-049	2013-10-17	TAL

NOTES:

- APPLICABLE STANDARDS/SPECIFICATIONS:
ASME Y14.100
ASME Y14.24-1999
ASME Y14.5M-1994
- IDENTIFICATION OF THE SUGGESTED SOURCE(S) OF SUPPLY
HEREON IS NOT TO BE CONSTRUED AS A GUARANTEE OF
PRESENT OR CONTINUED AVAILABILITY AS A SOURCE OF
SUPPLY FOR THE ITEM(S).

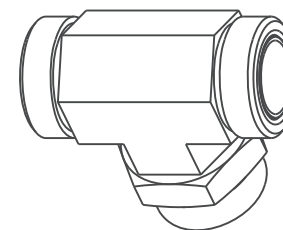

ITEM NAME	DESCRIPTION
TYPE	TUBE TO STRAIGHT THREAD BRANCH TEE ENDS A & B 1-11/16-12 ORFS BRANCH 1-5/8-12 STOR
MATERIAL	STEEL
FINISH	ZINC PLATED
SEAL	SEAL-LOK, OR O-LOK
STANDARD 1	SAE J514
STANDARD 2	SAE 070120

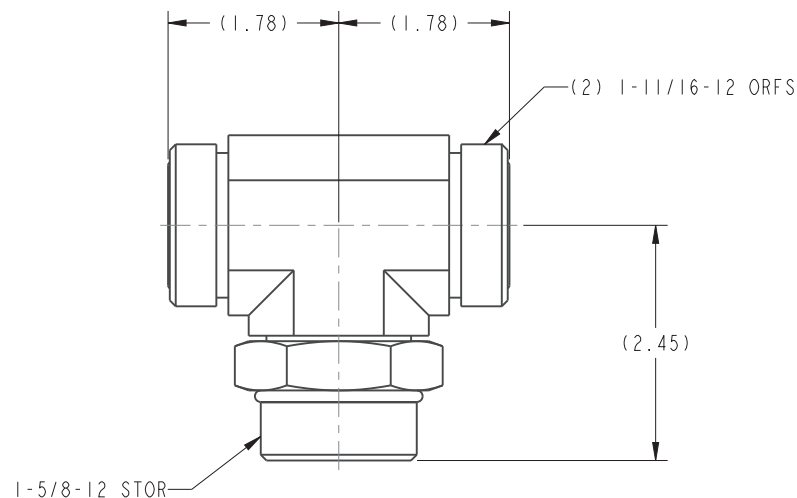

THIS DRAWING WAS GENERATED FROM A SOLID MODEL
AND IS CAD MAINTAINED. CHANGES SHALL BE
INCORPORATED BY THE DESIGN ACTIVITY.

VENDOR ITEM CONTROL DRAWING

PART NO. 11E421430

PMIC		DO NOT SCALE DRAWING		CONTRACT NUMBER W52H0910P0057	DESIGN ACTIVITY US ARMY ARMAMENT RESEARCH, DEVELOPMENT AND ENGINEERING CENTER ROCK ISLAND, ILLINOIS 61299-7300
MECHANICAL PROPERTIES		UNLESS OTHERWISE SPECIFIED DIMENSIONS ARE IN INCHES		CONTRACTOR ADVANCED CAD/CAM SERVICE	BRANCH TEE, STRAIGHT THREAD
TOLERANCE ON ANGLES ± ° 2 PLACE DECIMALS ± 3 PLACE DECIMALS ±		THIRD ANGLE PROJECTION		DRAWN BY JOHN D	
DATE(YEAR-MO-DA) 2010-5-24		CHECKER ENGINEER G. SLAGER		ENGINEER QUALITY ENGINEER	
DRAWING APPROVAL DALE HOLLAND		DESIGN APPROVAL THOMAS LETTIS		SCALE 1.000	
MATERIAL ERIC M		APPLICATION		CAGE CODE 59678	
NEXT ASSY USED ON		UNIT WT. 0.135		SHEET 1 OF 1	

DISTRIBUTION STATEMENT A:
APPROVED FOR PUBLIC RELEASE:
DISTRIBUTION IS UNLIMITED

NOTES:

1. APPLICABLE STANDARDS/SPECIFICATIONS:

ASME Y14.100
ASME Y14.24-1999
ASME Y14.5M-1994




2. IDENTIFICATION OF THE SUGGESTED SOURCE(S) OF SUPPLY
HEREON IS NOT TO BE CONSTRUED AS A GUARANTEE OF
PRESENT OR CONTINUED AVAILABILITY AS A SOURCE OF
SUPPLY FOR THE ITEM(S).

SUGGESTED SOURCE(S) OF SUPPLY

PART NO.	VENDOR		VENDOR PART NO.	ITEM IDENTIFICATION
	ADDRESS	CAGE CODE		
11E421431	PARKER HANNIFIN CORPORATION TUBE FITTINGS DIVISION COLUMBUS, OHIO 43228 PH 614-279-7070	1KP05	20 F50HAD-S	STRAIGHT THREAD UNION, 1-5/8-12 STOR

ITEM NAME	DESCRIPTION
TYPE	STRAIGHT THREAD UNION, WITH 1-5/8-12 STOR THRD
MATERIAL	STEEL
FINISH	ZINC PLATED
SEAL	SEAL-LOK OR O-LOK
STANDARD 1	SAE J518
STANDARD 2	SAE 070120

REVISIONS				
MODEL REV	DRAW REV	DESCRIPTION	DATE(YEAR-MO-DA)	APPROVED
	-	INITIAL RELEASE-ECP-K10g0001-NDR 249	2010-09-23	TAL

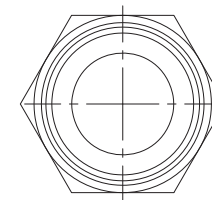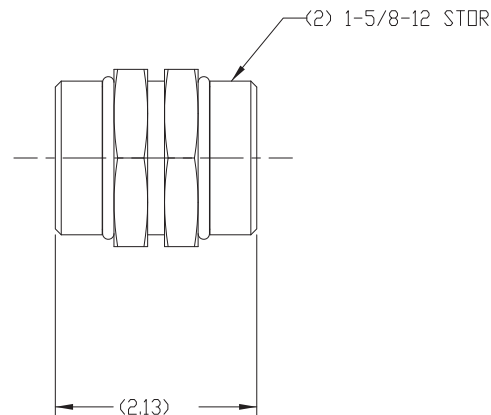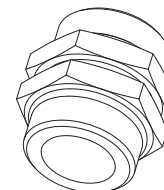

THIS DRAWING WAS GENERATED FROM A SOLID MODEL
AND IS CAD MAINTAINED. CHANGES SHALL BE
INCORPORATED BY THE DESIGN ACTIVITY.

PART NO. 11E421431

VENDOR ITEM CONTROL DRAWING

PMIC		DO NOT SCALE DRAWING		CONTRACT NUMBER	W52H0910P0057	US ARMY ARMAMENT RESEARCH, DEVELOPMENT AND ENGINEERING CENTER ROCK ISLAND, ILLINOIS 61299-7300	
MECHANICAL PROPERTIES		UNLESS OTHERWISE SPECIFIED DIMENSIONS ARE IN INCHES TOLERANCE ON ANGLES ± ° 2 PLACE DECIMALS ± 3 PLACE DECIMALS ±		CONTRACTOR	ADVANCED CAD/CAM SREVICE	UNION, STR BOSS STRAIGHT THREAD	
				DRAWN BY	JOHN D		
				CHECKER	ENGINEER G. SLAGER		
				ENGINEER	QUALITY ENGINEER		
YP		THIRD ANGLE PROJECTION 		DRAWING APPROVAL DALE HOLLAND		SIZE	C
TS				DESIGN APPROVAL THOMAS LETTIS		CAGE CODE	59678
EL2						DWG NO.	11E421431
RA						SCALE	1.000
BH		11E421400	FRS	MATL ENGR	MODELED BY ERIC M	UNIT WT.	0.057
RH		NEXT ASSY	USED ON			SHEET	1 OF 1
		APPLICATION					

DISTRIBUTION STATEMENT A:
APPROVED FOR PUBLIC RELEASE:
DISTRIBUTION IS UNLIMITED

NOTES:

1. APPLICABLE STANDARDS/SPECIFICATIONS:

ASME Y14.100
ASME Y14.24-1999
ASME Y14.5M-1994

2. IDENTIFICATION OF THE SUGGESTED SOURCE(S) OF SUPPLY
HEREON IS NOT TO BE CONSTRUED AS A GUARANTEE OF
PRESENT OR CONTINUED AVAILABILITY AS A SOURCE OF
SUPPLY FOR THE ITEM(S).

REVISIONS				
MODEL REV	DRAW REV	DESCRIPTION	DATE(YEAR-MO-DA)	APPROVED
	-	INITIAL RELEASE-ECP-K10o0001-NDR 250	2010-09-23	TAL
-1		ECP K19O3005	2020-XX-XX	CWH

SUGGESTED SOURCE(S) OF SUPPLY				
PART NO.	VENDOR		VENDOR PART NO.	ITEM IDENTIFICATION
	ADDRESS	CAGE CODE		
11E421432	PARKER HANNIFIN CORPORATION TUBE FITTINGS DIVISION COLUMBUS, OHIO 43228 PH 614-279-7070	1KP05	20-12 TRLON-S	REDUCING FITTING, ORFS, SWIVEL, 1 5/8-12 ORFS TO 1 3/16-12 ORFS

ITEM NAME	DESCRIPTION
TYPE	ORFS REDUCING FITTING, SWIVEL, 1 5/8-12 ORFS TO 1 3/16-12 ORFS
MATERIAL	STEEL
FINISH	ZINC PLATED
SEAL	SEAL-LOK OR O-LOK
STANDARD 1	SAE J518 J1453
STANDARD 2	SAE 070120 520123

1-1/4" (-20) FEMALE ORFS
TO 3/4" (-12) MALE ORFS

~~1 5/8-12 ORFS~~
1-1/4" (-20) FEMALE SWIVEL ORFS
(1-11/16-12 UNF THREADS)


~~1 3/16-12 ORFS~~
3/4" (-12) MALE ORFS
(1-3/16-12 UNF THREADS)

THIS DRAWING WAS GENERATED FROM A SOLID MODEL
AND IS CAD MAINTAINED. CHANGES SHALL BE
INCORPORATED BY THE DESIGN ACTIVITY.

VENDOR ITEM CONTROL DRAWING

PART NO. 11E421432

DISTRIBUTION STATEMENT A:
APPROVED FOR PUBLIC RELEASE:
DISTRIBUTION IS UNLIMITED

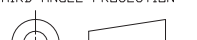PMIC				DO NOT SCALE DRAWING		CONTRACT NUMBER		W52H0910P0057		US ARMY ARMAMENT RESEARCH, DEVELOPMENT AND ENGINEERING CENTER ROCK ISLAND, ILLINOIS 61299-7300					
MECHANICAL PROPERTIES				UNLESS OTHERWISE SPECIFIED DIMENSIONS ARE IN INCHES TOLERANCE ON ANGLES ± ° 2 PLACE DECIMALS ± 3 PLACE DECIMALS ±		CONTRACTOR		ADVANCED CAD/CAM SERVICE		FITTING, REDUCING, ORFS SWIVEL					
						DRAWN BY	JOHN D	DATE(YEAR-MO-DA)	2010-5-24						
						CHECKER		ENGINEER	G. SLAGER						
						ENGINEER		QUALITY ENGINEER							
YP				THIRD ANGLE PROJECTION		DRAWING APPROVAL		DALE HOLLAND		SIZE	CAGE CODE	DWG NO.			
TS						DALE HOLLAND				C	59678	11E421432			
EL2						MODELED BY		ERIC M		DESIGN APPROVAL					
RA		11E421400	FRS			MTRL ENGR				THOMAS LETTIS					
BH		NEXT ASSY	USED ON												
RH		APPLICATION								SCALE	1.000	UNIT WT.	0.043	SHEET	1 OF 1

NOTES:

1. APPLICABLE STANDARDS/SPECIFICATIONS:

ASME Y14.100
ASME Y14.24-1999
ASME Y14.5M-1994



2. IDENTIFICATION OF THE SUGGESTED SOURCE(S) OF SUPPLY
HEREON IS NOT TO BE CONSTRUED AS A GUARANTEE OF
PRESENT OR CONTINUED AVAILABILITY AS A SOURCE OF
SUPPLY FOR THE ITEM(S).

REVISIONS				
MODEL REV	DRAW REV	DESCRIPTION	DATE(YEAR-MO-DA)	APPROVED
	-	INITIAL RELEASE-ECP-K10o0001-NDR 252	2010-09-23	TAL

SUGGESTED SOURCE(S) OF SUPPLY				
PART NO.	VENDOR		VENDOR PART NO.	ITEM IDENTIFICATION
	ADDRESS	CAGE CODE		
11E421434	PARKER HANNIFIN CORPORATION TUBE FITTINGS DIVISION COLUMBUS, OHIO 43228 PH 614-279-7070	1KP05	545NKK-00	REDUCING FITTING, DRFS, SWIVEL, 1-3/16-12 DRFS TO 13/16-16 DRFS

12-8-TRLON-S-ZJ

ITEM NAME	DESCRIPTION
TYPE	DRFS REDUCING FITTING, 1-3/16-12 DRFS TO 13/16-16 DRFS
MATERIAL	STEEL
FINISH	ZINC PLATED
SEAL	SEAL-LOK OR O-LOK
STANDARD 1	SAE J518
STANDARD 2	SAE 070120

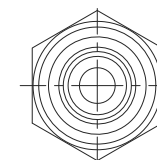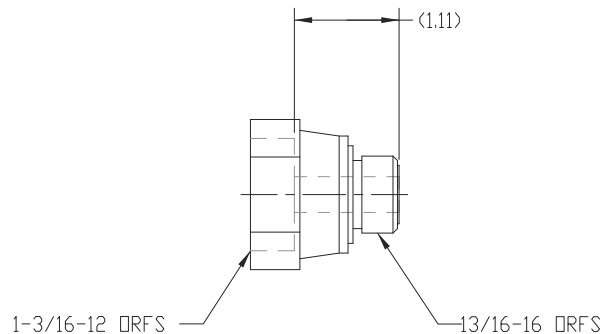

THIS DRAWING WAS GENERATED FROM A SOLID MODEL
AND IS CAD MAINTAINED. CHANGES SHALL BE
INCORPORATED BY THE DESIGN ACTIVITY.

PART NO. 11E421434

VENDOR ITEM CONTROL DRAWING

PMIC		DO NOT SCALE DRAWING		CONTRACT NUMBER W52H0910P0057		US ARMY ARMAMENT RESEARCH, DEVELOPMENT AND ENGINEERING CENTER ROCK ISLAND, ILLINOIS 61299-7300			
MECHANICAL PROPERTIES		UNLESS OTHERWISE SPECIFIED DIMENSIONS ARE IN INCHES TOLERANCE ON ANGLES ± ° 2 PLACE DECIMALS ± 3 PLACE DECIMALS ±		CONTRACTOR ADVANCED CAD/CAM SERVICE		FITTING, DRFS REDUCING SWIVEL			
				DRAWN BY JOHN D					
				CHECKER ENGINEER G. SLAGER					
				ENGINEER QUALITY ENGINEER					
YP		THIRD ANGLE PROJECTION 		DRAWING APPROVAL DALE HOLLAND		SIZE C	CAGE CODE 59678		
TS				DESIGN APPROVAL THOMAS LETTIS		DWG NO. 11E421434			
EL2						SCALE 1.000	UNIT WT. 0.337		
RA						SHEET 1 OF 1			
BH	11E421400	FRS	MATL ENGR	MODELED BY ERIC M					
RH	NEXT ASSY USED ON		APPLICATION						

DISTRIBUTION STATEMENT A:
APPROVED FOR PUBLIC RELEASE:
DISTRIBUTION IS UNLIMITED

NOTES:

1. APPLICABLE STANDARDS/SPECIFICATIONS:


ASME Y14.100
ASME Y14.24-1999
ASME Y14.5M-1994

2. IDENTIFICATION OF THE SUGGESTED SOURCE(S) OF SUPPLY
HEREON IS NOT TO BE CONSTRUED AS A GUARANTEE OF
PRESENT OR CONTINUED AVAILABILITY AS A SOURCE OF
SUPPLY FOR THE ITEM(S).

REVISIONS				
MODEL REV	DRAW REV	DESCRIPTION	DATE(YEAR-MO-DA)	APPROVED
	-	INITIAL RELEASE-ECP-K10o0001-NDR 253	2010-09-23	TAL

SUGGESTED SOURCE(S) OF SUPPLY				
PART NO.	VENDOR		VENDOR PART NO.	ITEM IDENTIFICATION
	ADDRESS	CAGE CODE		
11E421435	PARKER HANNIFIN CORPORATION TUBE FITTINGS DIVISION COLUMBUS, OHIO 43228 PH 614-279-7070	1KP05	16 WLD-WLNL-S	FITTING, DRFS BULKHEAD UNION, 1-7/16-12 DRFS

ITEM NAME	DESCRIPTION
TYPE	DRFS BULKHEAD UNION, 1-7/16-12 DRFS
MATERIAL	STEEL
FINISH	ZINC PLATED
SEAL	SEAL-LOK OR O-LOK
STANDARD 1	SAE J518
STANDARD 2	SAE 070120

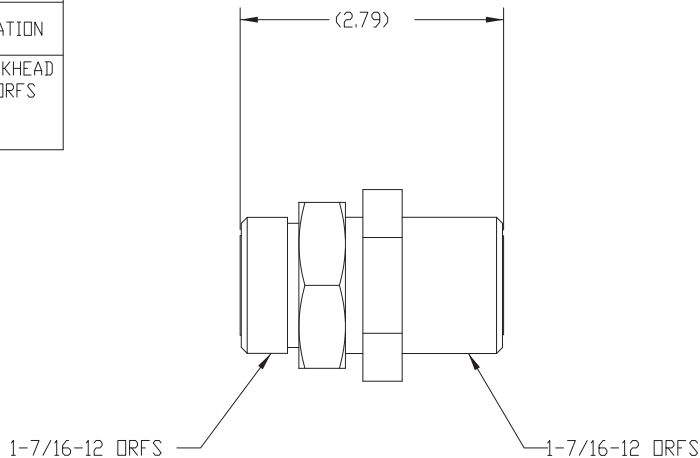

THIS DRAWING WAS GENERATED FROM A SOLID MODEL
AND IS CAD MAINTAINED. CHANGES SHALL BE
INCORPORATED BY THE DESIGN ACTIVITY.

VENDOR ITEM CONTROL DRAWING

PART NO. 11E421435

DISTRIBUTION STATEMENT A:
APPROVED FOR PUBLIC RELEASE:
DISTRIBUTION IS UNLIMITED

PMIC				DO NOT SCALE DRAWING		CONTRACT NUMBER W52H0910P0057		US ARMY ARMAMENT RESEARCH, DEVELOPMENT AND ENGINEERING CENTER ROCK ISLAND, ILLINOIS 61299-7300			
MECHANICAL PROPERTIES				UNLESS OTHERWISE SPECIFIED DIMENSIONS ARE IN INCHES TOLERANCE ON ANGLES ± ° 2 PLACE DECIMALS ± 3 PLACE DECIMALS ±		CONTRACTOR ADVANCED CAD/CA SERVICE		FITTING, DRFS BULKHEAD UNION			
						DRAWN BY JOHN D					
						CHECKER ENGINEER G. SLAGER					
						ENGINEER QUALITY ENGINEER					
YP				THIRD ANGLE PROJECTION 		DRAWING APPROVAL DALE HOLLAND		SIZE C	CAGE CODE 59678		
TS						DESIGN APPROVAL THOMAS LETTIS		DWG NO. 11E421435			
EL2											
RA											
BH		11E421400	FRS	MTRL ENGR		MODELED BY ERIC M		SCALE 1.000			
RH		NEXT ASSY	USED ON								
APPLICATION								UNIT WT. 0.115	SHEET 1 OF 1		

NOTES:

1. APPLICABLE STANDARDS/SPECIFICATIONS:

ASME Y14.100
ASME Y14.24-1999
ASME Y14.5M-1994

2. IDENTIFICATION OF THE SUGGESTED SOURCE(S) OF SUPPLY
HEREON IS NOT TO BE CONSTRUED AS A GUARANTEE OF
PRESENT OR CONTINUED AVAILABILITY AS A SOURCE OF
SUPPLY FOR THE ITEM(S).

REVISIONS				
MODEL REV	DRAW REV	DESCRIPTION	DATE(YEAR-MO-DA)	APPROVED
	-	INITIAL RELEASE-ECP-K100001-NDR 254	2010-09-23	TAL
-1		ECP K19O3005	2020-XX-XX	CWH




SUGGESTED SOURCE(S) OF SUPPLY				
PART NO.	VENDOR		VENDOR PART NO.	ITEM IDENTIFICATION
	ADDRESS	CAGE CODE		
11E421436	PARKER HANNIFIN CORPORATION TUBE FITTINGS DIVISION COLUMBUS, OHIO 43228 PH 614-279-7070	1KP05	16 F65LB-S 16 F65OL-S	FITTING, REDUCING 1-5/16-12 STOR TO 1-5/16-12 ORFS

ITEM NAME	DESCRIPTION
TYPE	FITTING, REDUCING, FROM 1-5/16-12 STOR TO 1-5/16-12 ORFS
MATERIAL	STEEL
FINISH	ZINC PLATED
SEAL	SEAL-LOK OR O-LOK
STANDARD 1	SAE J518 J1453
STANDARD 2	SAE 070120 520181

1" (-16) SAE-ORB (STOR) TO
1" (-16) FEMALE SWIVEL ORFS

1" (-16) FEMALE SWIVEL ORFS
(1-7/16-12 UNF THREADS)

1" (-16) SAE-ORB (STOR)
(1-5/16-12 UNF THREADS)

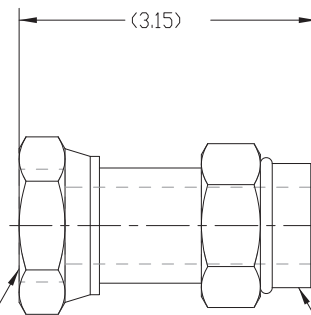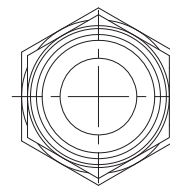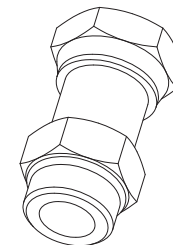

THIS DRAWING WAS GENERATED FROM A SOLID MODEL
AND IS CAD MAINTAINED. CHANGES SHALL BE
INCORPORATED BY THE DESIGN ACTIVITY.

VENDOR ITEM CONTROL DRAWING

PART NO. 11E421436

DISTRIBUTION STATEMENT A:
APPROVED FOR PUBLIC RELEASE:
DISTRIBUTION IS UNLIMITED

PMIC		DO NOT SCALE DRAWING		CONTRACT NUMBER W52H0910P0057		US ARMY ARMAMENT RESEARCH, DEVELOPMENT AND ENGINEERING CENTER ROCK ISLAND, ILLINOIS 61299-7300	
MECHANICAL PROPERTIES		UNLESS OTHERWISE SPECIFIED DIMENSIONS ARE IN INCHES TOLERANCE ON ANGLES ± ° 2 PLACE DECIMALS ± 3 PLACE DECIMALS ±		CONTRACTOR ADVANCED CAD/CAM SERVICE		FITTING, REDUCING, ORFS TO STOR	
YP		THIRD ANGLE PROJECTION		DRAWN BY JOHN D	DATE(YEAR-MO-DA) 2010-5-24		
TS				CHECKER ENGINEER G. SLAGER	ENGINEER QUALITY ENGINEER		
EL2		11E421400	FRS	DRAWING APPROVAL DALE HOLLAND		SIZE C	CAGE CODE 59678
RA		NEXT ASSY	USED ON	DESIGN APPROVAL THOMAS LETTIS		DWG NO. 11E421436	
BH		APPLICATION				SCALE 1.000	UNIT WT. 0.057
RH						SHEET 1 OF 1	



NOTES:

1. APPLICABLE STANDARDS/SPECIFICATIONS:
ASME Y14.100
ASME Y14.24-1999
ASME Y14.5M-1994
2. IDENTIFICATION OF THE SUGGESTED SOURCE(S) OF SUPPLY
HEREON IS NOT TO BE CONSTRUED AS A GUARANTEE OF
PRESENT OR CONTINUED AVAILABILITY AS A SOURCE OF
SUPPLY FOR THE ITEM(S).

REVISIONS				
MODEL REV	DRAW REV	DESCRIPTION	DATE(YEAR-MO-DA)	APPROVED
	-	INITIAL RELEASE-ECP-K10o0001-NDR 255	2010-09-23	TAL

SUGGESTED SOURCE(S) OF SUPPLY				
PART NO.	VENDOR		VENDOR PART NO.	ITEM IDENTIFICATION
	ADDRESS	CAGE CODE		
11E421437	PARKER HANNIFIN CORPORATION TUBE FITTINGS DIVISION COLUMBUS, OHIO 43228 PH 614-279-7070	1KP05	HD-H8-63-T16	QUICK COUPLING POPPET VALVE, HEAVY DUTY, SERIES 60, MALE NIPPLE, 1-5/16-12 ORB PORT

ITEM NAME	DESCRIPTION
TYPE	QUICK COUPLING POPPET VALVE, HEAVY DUTY, BALL DISCONNECT, 1-5/16-12 ORB PORT
MATERIAL	STEEL
FINISH	
SEAL	NITRILE
STANDARD 1	SAE J518
STANDARD 2	SAE 070120

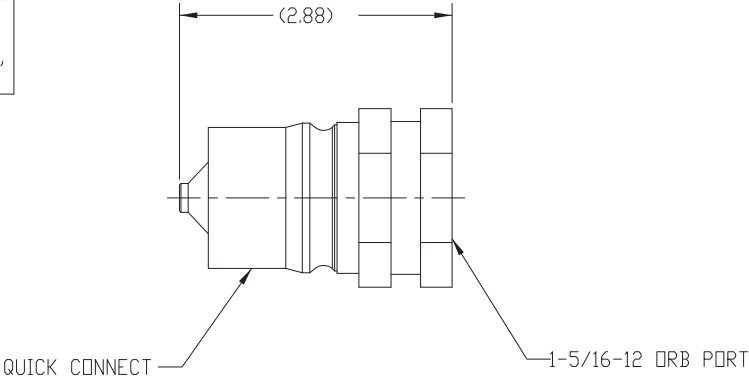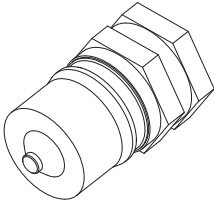


THIS DRAWING WAS GENERATED FROM A SOLID MODEL
AND IS CAD MAINTAINED. CHANGES SHALL BE
INCORPORATED BY THE DESIGN ACTIVITY.

VENDOR ITEM CONTROL DRAWING

PART NO. 11E421437

DISTRIBUTION STATEMENT A:
APPROVED FOR PUBLIC RELEASE:
DISTRIBUTION IS UNLIMITED

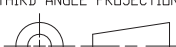PMIC				DO NOT SCALE DRAWING		CONTRACT NUMBER W52H0910P0057		US ARMY ARMAMENT RESEARCH, DEVELOPMENT AND ENGINEERING CENTER ROCK ISLAND, ILLINOIS 61299-7300					
MECHANICAL PROPERTIES				UNLESS OTHERWISE SPECIFIED DIMENSIONS ARE IN INCHES TOLERANCE ON ANGLES ± ° 2 PLACE DECIMALS ± 3 PLACE DECIMALS ±		CONTRACTOR ADVANCD CAD/CAM SERVICE		VALVE, POPPET, QUICK COUPLING					
						DRAWN BY JOHN D DATE(YEAR-MO-DA) 2010-5-24							
						CHECKER ENGINEER G. SLAGER							
						ENGINEER QUALITY_ENGINEER							
YP				THIRD ANGLE PROJECTION 		DRAWING APPROVAL DALE HOLLAND		SIZE C	CAGE CODE 59678	DWG NO. 11E421437			
TS						DESIGN APPROVAL THOMAS LETTIS		SCALE 1.000	UNIT WT. 1.266	SHEET 1 OF 1			
EL2													
RA													
BH		11E421400	FRS										
		NEXT ASSY	USED ON	MATL ENGR	MODELED BY ERIC M								
RH		APPLICATION											

NOTES:

1. APPLICABLE STANDARDS/SPECIFICATIONS:


ASME Y14.100
ASME Y14.24-1999
ASME Y14.5M-1994

2. IDENTIFICATION OF THE SUGGESTED SOURCE(S) OF SUPPLY
HEREON IS NOT TO BE CONSTRUED AS A GUARANTEE OF
PRESENT OR CONTINUED AVAILABILITY AS A SOURCE OF
SUPPLY FOR THE ITEM(S).

REVISIONS				
MODEL REV	DRAW REV	DESCRIPTION	DATE(YEAR-MO-DA)	APPROVED
	-	INITIAL RELEASE-ECP-K10g0001-NDR 256	2010-09-23	TAL

SUGGESTED SOURCE(S) OF SUPPLY				
PART NO.	VENDOR		VENDOR PART NO.	ITEM IDENTIFICATION
	ADDRESS	CAGE CODE		
11E421438	PARKER HANNIFIN CORPORATION TUBE FITTINGS DIVISION COLUMBUS, OHIO 43228 PH 614-279-7070	1KP05	12 WLO-WLNL-S	FITTING, DRFS BULKHEAD UNION, 1-3/16-12 DRFS

ITEM NAME	DESCRIPTION
TYPE	DRFS BULKHEAD UNION, 1-3/16-12 DRFS
MATERIAL	STEEL
FINISH	ZINC PLATED
SEAL	SEAL-LOK OR O-LOK
STANDARD 1	SAE J518
STANDARD 2	SAE 070120

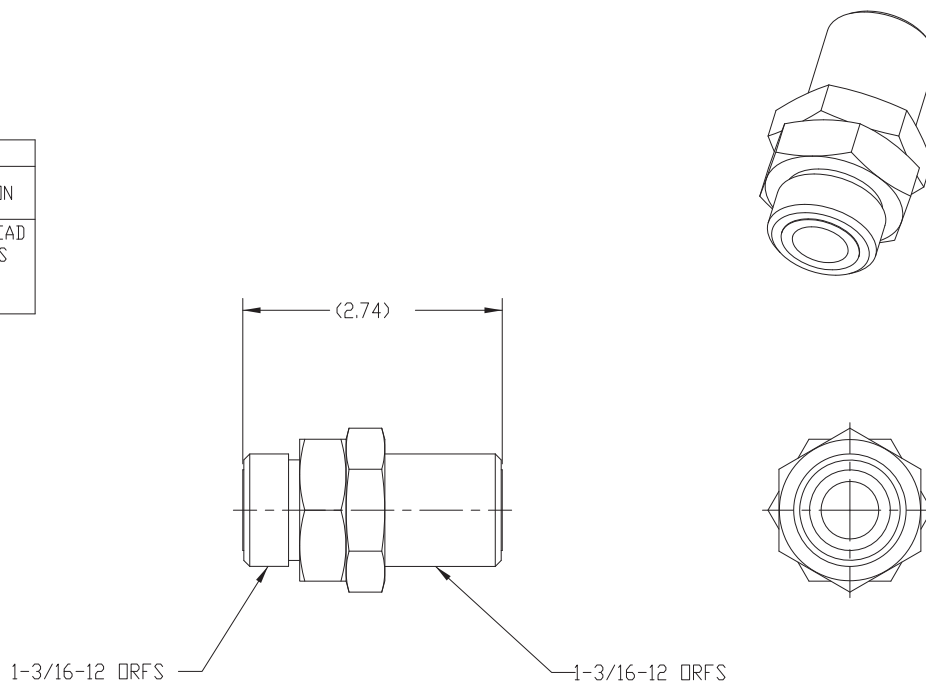

THIS DRAWING WAS GENERATED FROM A SOLID MODEL
AND IS CAD MAINTAINED. CHANGES SHALL BE
INCORPORATED BY THE DESIGN ACTIVITY.

VENDOR ITEM CONTROL DRAWING

PART NO. 11E421438

DISTRIBUTION STATEMENT A:
APPROVED FOR PUBLIC RELEASE:
DISTRIBUTION IS UNLIMITED

PMIC			DO NOT SCALE DRAWING	CONTRACT NUMBER	W52H0910P0057	US ARMY ARMAMENT RESEARCH, DEVELOPMENT AND ENGINEERING CENTER ROCK ISLAND, ILLINOIS 61299-7300		
			UNLESS OTHERWISE SPECIFIED DIMENSIONS ARE IN INCHES TOLERANCE ON ANGLES ± ° 2 PLACE DECIMALS ± 3 PLACE DECIMALS ±	CONTRACTOR	ADVANCED CAD/CAM SERVICE	FITTING, DRFS, BULKHEAD UNION		
MECHANICAL PROPERTIES				DRAWN BY	JOHN D	DATE(YEAR-MO-DA)	2010-5-24	
YP				CHECKER	ENGINEER G. SLAGER	ENGINEER	QUALITY ENGINEER	
TS				THIRD ANGLE PROJECTION				
EL2								
RA								
BH		11E421400	FRS		DRAWING APPROVAL	DALE HOLLAND	SIZE	C
RH		NEXT ASSY	USED ON		DESIGN APPROVAL	THOMAS LETTIS	CAGE CODE	59678
		APPLICATION		MATL ENGR	MODELED BY	ERIC M	DWG NO.	11E421438
							SCALE	1.000
							UNIT WT.	0.853
							SHEET	1 OF 1


NOTES:

1. APPLICABLE STANDARDS/SPECIFICATIONS:
ASME Y14.100
ASME Y14.24-1999
ASME Y14.5M-1994
2. IDENTIFICATION OF THE SUGGESTED SOURCE(S) OF SUPPLY
HEREON IS NOT TO BE CONSTRUED AS A GUARANTEE OF
PRESENT OR CONTINUED AVAILABILITY AS A SOURCE OF
SUPPLY FOR THE ITEM(S).

REVISIONS				
MODEL REV	DRAW REV	DESCRIPTION	DATE(YEAR-MO-DA)	APPROVED
	-	INITIAL RELEASE-ECP-K10g0001-NDR 257	2010-09-23	TAL

SUGGESTED SOURCE(S) OF SUPPLY				
PART NO.	VENDOR		VENDOR PART NO.	ITEM IDENTIFICATION
	ADDRESS	CAGE CODE		
11E421439	PARKER HANNIFIN CORPORATION TUBE FITTINGS DIVISION COLUMBUS, OHIO 43228 PH 614-279-7070	1KP05	SM-752-16FD	QUICK COUPLING POPPET VALVE, HEAVY DUTY, SM SERIES, MALE NIPPLE, FEMALE PORT

ITEM NAME	DESCRIPTION
TYPE	QUICK COUPLING POPPET VALVE, HEAVY DUTY, BALL DISCONNECT, 1-5/16-12 FEMALE PORT
MATERIAL	STEEL
FINISH	ZINC PLATED
SEAL	BUNA-N (NITRILE)
STANDARD 1	SAE J518
STANDARD 2	SAE 070120

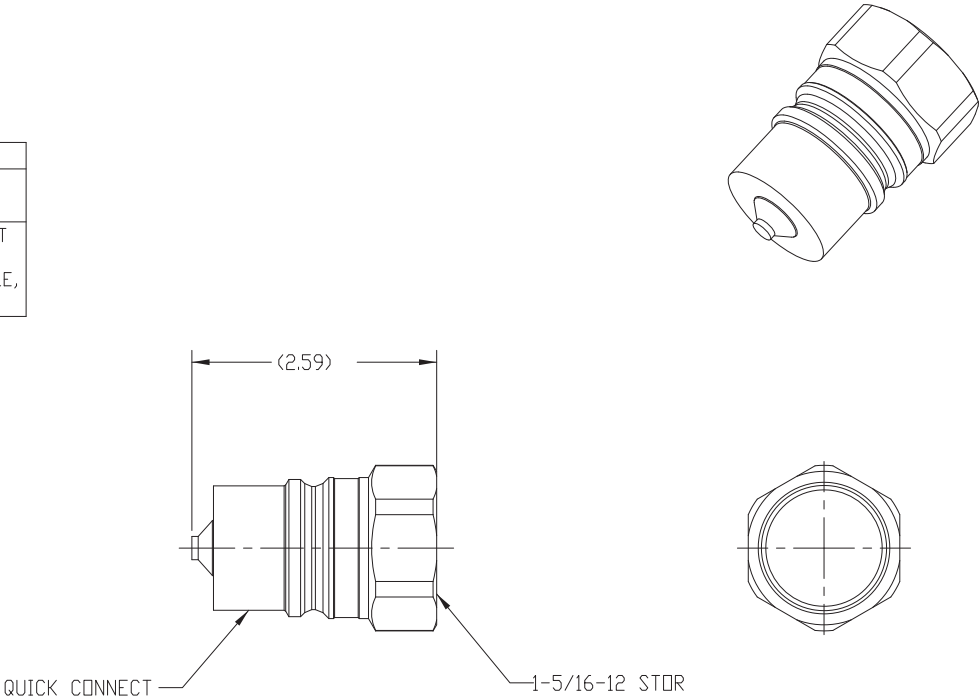

THIS DRAWING WAS GENERATED FROM A SOLID MODEL
AND IS CAD MAINTAINED. CHANGES SHALL BE
INCORPORATED BY THE DESIGN ACTIVITY.

VENDOR ITEM CONTROL DRAWING

PART NO. 11E421439

DISTRIBUTION STATEMENT A:
APPROVED FOR PUBLIC RELEASE:
DISTRIBUTION IS UNLIMITED

PMIC						DO NOT SCALE DRAWING		CONTRACT NUMBER		W52H0910P0057		US ARMY ARMAMENT RESEARCH, DEVELOPMENT AND ENGINEERING CENTER ROCK ISLAND, ILLINOIS 61299-7300					
						UNLESS OTHERWISE SPECIFIED DIMENSIONS ARE IN INCHES TOLERANCE ON ANGLES ± ° 2 PLACE DECIMALS ± 3 PLACE DECIMALS ±		CONTRACTOR		ADVANCED CAD/CAM SERVICE							
		MECHANICAL PROPERTIES						THIRD ANGLE PROJECTION		DRAWN BY		JOHN D		DATE(YEAR-MO-DA) 2010-5-24			
										CHECKER		ENGINEER		G. SLAGER			
						ENGINEER				QUALITY ENGINEER							
YP										DRAWING APPROVAL		SIZE		CAGE CODE		DWG NO.	
TS										DALE HOLLAND		C		59678		11E421439	
EL2										DESIGN APPROVAL							
RA										THOMAS LETTIS							
BH				11E421400		FRS											
				NEXT ASSY		USED ON		MATL ENGR		MODELED BY							
RH				APPLICATION						ERIC M				SCALE 1:000		UNIT WT. 0.926	
														SHEET 1 OF 1			




NOTES:

1. APPLICABLE STANDARDS/SPECIFICATIONS:
ASME Y14.100
ASME Y14.24-1999
ASME Y14.5M-1994
2. IDENTIFICATION OF THE SUGGESTED SOURCE(S) OF SUPPLY
HEREON IS NOT TO BE CONSTRUED AS A GUARANTEE OF
PRESENT OR CONTINUED AVAILABILITY AS A SOURCE OF
SUPPLY FOR THE ITEM(S).

REVISIONS				
MODEL REV	DRAW REV	DESCRIPTION	DATE(YEAR-MO-DA)	APPROVED
	-	INITIAL RELEASE-ECP-K10o0001-NDR 258	2010-09-23	TAL

SUGGESTED SOURCE(S) OF SUPPLY				
PART NO.	VENDOR		VENDOR PART NO.	ITEM IDENTIFICATION
	ADDRESS	CAGE CODE		
11E421440	PARKER HANNIFIN CORPORATION TUBE FITTINGS DIVISION COLUMBUS, OHIO 43228 PH 614-279-7070	1KP05	SM-751-16FD	POPPET VALVE, QUICK COUPLING, BALL DISCONNECT, 1-5/16-12 FEMALE PORT

ITEM NAME	DESCRIPTION
TYPE	QUICK DISCONNECT POPPET VALVE, 1-5/16-12 STOR PORT
MATERIAL	STEEL
FINISH	ZINC PLATED
SEAL	NITRILE
STANDARD 1	SAE J518
STANDARD 2	SAE 070120

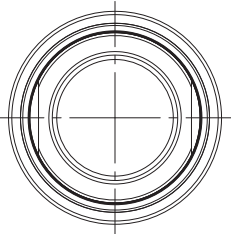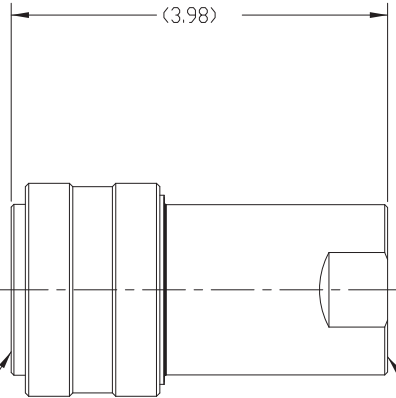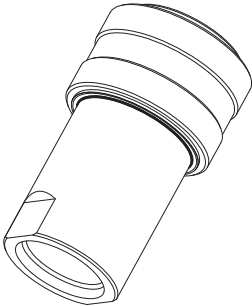



BALL DISCONNECT

1-5/16-12 STOR

THIS DRAWING WAS GENERATED FROM A SOLID MODEL
AND IS CAD MAINTAINED. CHANGES SHALL BE
INCORPORATED BY THE DESIGN ACTIVITY.

VENDOR ITEM CONTROL DRAWING

PART NO. 11E421440

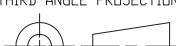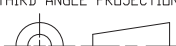PMIC				DO NOT SCALE DRAWING		CONTRACT NUMBER W52H0910P0057		US ARMY ARMAMENT RESEARCH, DEVELOPMENT AND ENGINEERING CENTER ROCK ISLAND, ILLINOIS 61299-7300				
MECHANICAL PROPERTIES				UNLESS OTHERWISE SPECIFIED DIMENSIONS ARE IN INCHES TOLERANCE ON ANGLES ± ° 2 PLACE DECIMALS ± 3 PLACE DECIMALS ±		CONTRACTOR ADVANCED CAD/CAM SERVICE		VALVE, POPPET, QUICK COUPLING				
YP				THIRD ANGLE PROJECTION 		CHECKER ENGINEER G. SLAGER		ENGINEER QUALITY ENGINEER				
TS												
EL2												
RA												
BH		11E421400	FRS			DRAWING APPROVAL DALE HOLLAND		SIZE	CAGE CODE	DWG NO.		
RH		NEXT ASSY	USED ON					C	59678	11E421440		
		APPLICATION		MATL ENGR		MODELED BY ERIC M		DESIGN APPROVAL THOMAS LETTIS		SCALE 1.000	UNIT WT. 0.257	SHEET 1 OF 1

DISTRIBUTION STATEMENT A:
APPROVED FOR PUBLIC RELEASE:
DISTRIBUTION IS UNLIMITED

NOTES:


1. APPLICABLE STANDARDS/SPECIFICATIONS:

ASME Y14.100
ASME Y14.24-1999
ASME Y14.5M-1994

2. IDENTIFICATION OF THE SUGGESTED SOURCE(S) OF SUPPLY
HEREON IS NOT TO BE CONSTRUED AS A GUARANTEE OF
PRESENT OR CONTINUED AVAILABILITY AS A SOURCE OF
SUPPLY FOR THE ITEM(S).


REVISIONS				
MODEL REV	DRAW REV	DESCRIPTION	DATE(YEAR-MO-DA)	APPROVED
	-	INITIAL RELEASE-ECP-K100001-NDR 260	2010-09-23	TAL
-1		ECP K1903005	2020-XX-XX	CWH

SUGGESTED SOURCE(S) OF SUPPLY				
PART NO.	VENDOR		VENDOR PART NO.	ITEM IDENTIFICATION
	ADDRESS	CAGE CODE		
11E421442	PARKER HANNIFIN CORPORATION TUBE FITTINGS DIVISION COLUMBUS, OHIO 43228 PH 614-279-7070	1KP05	6-4 TRLON-S	REDUCING FITTING, ORFS, SWIVEL, 11/16-18 ORFS TO 9/16-18 ORFS

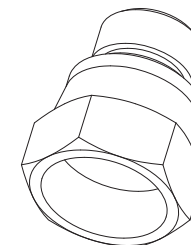


ITEM NAME	DESCRIPTION
TYPE	ORFS REDUCING FITTING, SWIVEL , 11/16-18 ORFS TO 9/16-18 ORFS
MATERIAL	STEEL
FINISH	ZINC PLATED
SEAL	SEAL-LOK OR O-LOK
STANDARD 1	SAE J518 J1453
STANDARD 2	SAE 070120 520123

3/8" (-6) FEMALE ORFS
TO 1/4" (-12) MALE ORFS

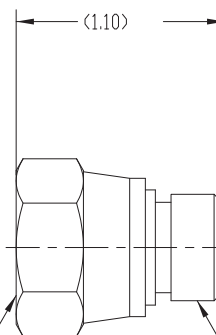

~~11-16-18 ORFS~~
3/8" (-6) FEMALE SWIVEL ORFS
(11/16-16 UNF THREADS)

~~9/16-18 ORFS~~
1/4" (-4) MALE ORFS
(9/16-18 UNF THREADS)

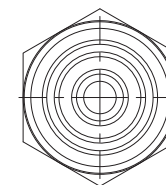


THIS DRAWING WAS GENERATED FROM A SOLID MODEL
AND IS CAD MAINTAINED. CHANGES SHALL BE
INCORPORATED BY THE DESIGN ACTIVITY.

VENDOR ITEM CONTROL DRAWING

PART NO. 11E421442

DISTRIBUTION STATEMENT A:
APPROVED FOR PUBLIC RELEASE:
DISTRIBUTION IS UNLIMITED

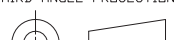PMIC				DO NOT SCALE DRAWING		CONTRACT NUMBER W52H0910P0057		US ARMY ARMAMENT RESEARCH, DEVELOPMENT AND ENGINEERING CENTER ROCK ISLAND, ILLINOIS 61299-7300			
MECHANICAL PROPERTIES				UNLESS OTHERWISE SPECIFIED DIMENSIONS ARE IN INCHES TOLERANCE ON ANGLES ± ° 2 PLACE DECIMALS ± 3 PLACE DECIMALS ±		CONTRACTOR ADVANCED CAD/CAM SERVICE		FITTING, REDUCING, ORFS SWIVEL			
						DRAWN BY JOHN D	DATE(YEAR-MO-DA) 2010-5-25				
						CHECKER	ENGINEER G. SLAGER				
						ENGINEER	QUALITY_ENGINEER				
YP				THIRD ANGLE PROJECTION		DRAWING APPROVAL DALE HOLLAND		SIZE C	CAGE CODE 59678	DWG NO. 11E421442	
TS											
EL2						MODELED BY ERRIC M					
RA		11E421400	FRS			DESIGN APPROVAL THOMAS LETTIS					
BH		NEXT ASSY	USED ON	MATL ENGR				SCALE 2:000		UNIT WT. 0.896	
RH		APPLICATION						SHEET 1 OF 1			

NOTES:

1. APPLICABLE STANDARDS/SPECIFICATIONS:




ASME Y14.100
ASME Y14.24-1999
ASME Y14.5M-1994

2. IDENTIFICATION OF THE SUGGESTED SOURCE(S) OF SUPPLY
HEREON IS NOT TO BE CONSTRUED AS A GUARANTEE OF
PRESENT OR CONTINUED AVAILABILITY AS A SOURCE OF
SUPPLY FOR THE ITEM(S).

REVISIONS				
MODEL REV	DRAW REV	DESCRIPTION	DATE(YEAR-MO-DA)	APPROVED
	-	INITIAL RELEASE-ECP-K1000001-NDR 261	2010-09-23	TAL

SUGGESTED SOURCE(S) OF SUPPLY				
PART NO.	VENDOR		VENDOR PART NO.	ITEM IDENTIFICATION
	ADDRESS	CAGE CODE		
11E421443	PARKER HANNIFIN CORPORATION HOSE PRODUCTS DIVISION WICKLIFF, OHIO 44092 PH 440-943-5700	1KP05	5151HK-20	FLANGE KIT, SAE CODE 61, (2) FLANGE HALVES, (4) HEX HEAD CAP SCREWS, (4) LOCK WASHERS, (1) O-RING

ITEM NAME	DESCRIPTION
TYPE	FLANGE KIT, SAE CODE 61 (2) FLANGE HALVES, (4) HEX HEAD CAP SCREWS, (4) LOCK WASHERS, AND (1) O-RING
MATERIAL	STEEL
FINISH	Zn W/ YELLOW CHROMATE OR Zn CHROMIUM 6 FREE
SEAL	NITRILE, 90 DUROMETER
STANDARD 1	SAE J518

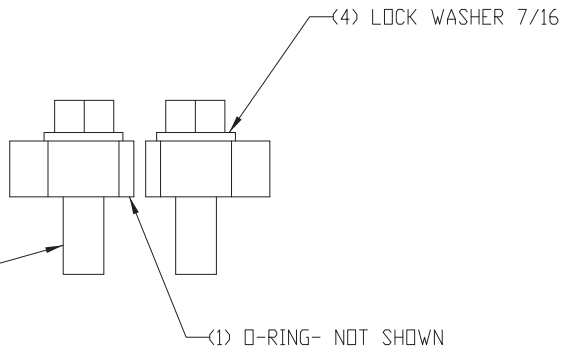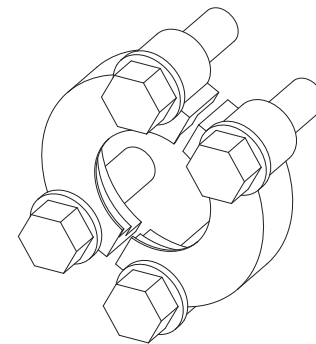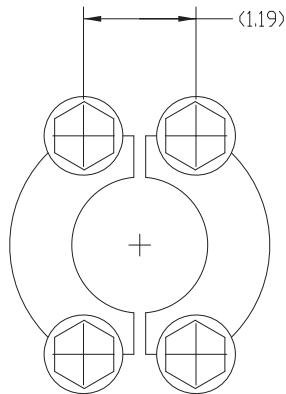


THIS DRAWING WAS GENERATED FROM A SOLID MODEL
AND IS CAD MAINTAINED. CHANGES SHALL BE
INCORPORATED BY THE DESIGN ACTIVITY.

VENDOR ITEM CONTROL DRAWING

PART NO. 11E421443

DISTRIBUTION STATEMENT A:
APPROVED FOR PUBLIC RELEASE:
DISTRIBUTION IS UNLIMITED

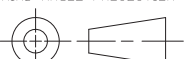
PMIC				DO NOT SCALE DRAWING		CONTRACT NUMBER W52H0910P0057		US ARMY ARMAMENT RESEARCH, DEVELOPMENT AND ENGINEERING CENTER ROCK ISLAND, ILLINOIS 61299-7300			
MECHANICAL PROPERTIES				UNLESS OTHERWISE SPECIFIED DIMENSIONS ARE IN INCHES TOLERANCE ON ANGLES ± ° 2 PLACE DECIMALS ± 3 PLACE DECIMALS ±		CONTRACTOR ADVANCED CAD/CAM SERVICE		SAE FLANGE KIT CODE 61			
				THIRD ANGLE PROJECTION 		DRAWN BY JOHN D DATE(YEAR-MO-DA) 2010-5-24					
						CHECKER ENGINEER G. SLAGER					
						ENGINEER QUALITY_ENGINEER					
YP				MATL ENGR MODELED BY ERIC M		DRAWING APPROVAL DALE HOLLAND		SIZE C	CAGE CODE 59678	DWG NO. 11E421443	
TS						DESIGN APPROVAL THOMAS LETTIS					
EL2		11E421400	FRS					SCALE 1.000	UNIT WT. 0.947	SHEET 1 OF 1	
RA		NEXT ASSY	USED ON			APPLICATION					
BH											
RH											

NOTES:

1. APPLICABLE STANDARDS/SPECIFICATIONS:
ASME Y14.24-1999
ASME Y14.100
ASME Y14.5M-1994
2. IDENTIFICATION OF THE SUGGESTED SOURCE(S) OF SUPPLY
HEREON IS NOT TO BE CONSTRUED AS A GUARANTEE OF
PRESENT OR CONTINUED AVAILABILITY AS A SOURCE
FOR THE ITEM DESCRIBED ON THIS DRAWING

REVISIONS				
MODEL REV	DRAW REV	DESCRIPTION	DATE(YEAR-MO-DA)	APPROVED
	-	INITIAL RELEASE-ECP-K10a0001-NDR 493	2010-09-23	TAL

SUGGESTED SOURCE(S) OF SUPPLY			
PART NO.	VENDOR		VENDOR PART NO.
	ADDRESS	CAGE CODE	
11E421453	NOTT COMPANY INC 1005 11TH ST ROCK ISLAND, IL 61201-4002 651-415-3400	3UZE1	20-16TRLON-S

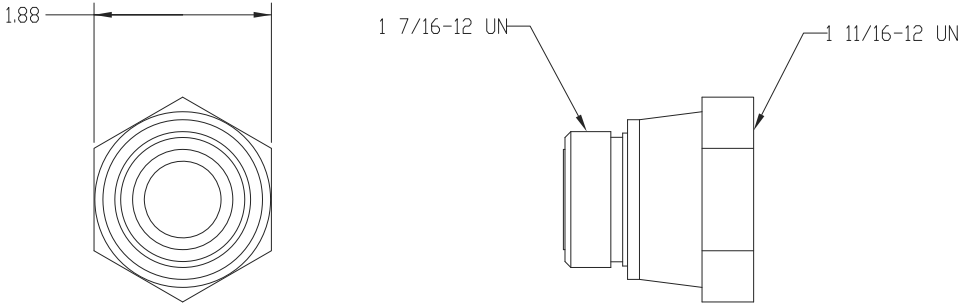

THIS DRAWING WAS GENERATED FROM A SOLID MODEL
AND IS CAD MAINTAINED. CHANGES SHALL BE
INCORPORATED BY THE DESIGN ACTIVITY.

VENDOR ITEM CONTROL DRAWING

PART NO. 11E421453

DISTRIBUTION STATEMENT A:
THIS IS APPROVED FOR PUBLIC RELEASE;
DISTRIBUTION IS UNLIMITED

PMIC				DO NOT SCALE DRAWING		CONTRACT NUMBER W52H0910P0057		US ARMY ARMAMENT RESEARCH, DEVELOPMENT AND ENGINEERING CENTER ROCK ISLAND, ILLINOIS 61299-7300				
				UNLESS OTHERWISE SPECIFIED DIMENSIONS ARE IN INCHES		CONTRACTOR ADVANCED CAD/CAM SERVICE						
MECHANICAL PROPERTIES				TOLERANCE ON ANGLES ± 1° 2 PLACE DECIMALS ± .03 3 PLACE DECIMALS ± .010		DRAWN BY E.MUMM		DATE(YEAR-MO-DA) 2010-06-01		REDUCER, STR TUBE		
YP				THIRD ANGLE PROJECTION 		CHECKER		ENGINEER G. SLAGER				
TS						ENGINEER		QUALITY_ENGINEER				
EL2						DRAWING APPROVAL		DALE HOLLAND				
RA		11E421400	FRS			DESIGN APPROVAL		THOMAS LETTIS		SIZE C	CAGE CODE 59678	DWG NO. 11E421453
BH		NEXT ASSY	USED ON	MATL ENGR	MODELED BY E.MUMM					SCALE 1.000	UNIT W.T.	SHEET 1 OF 1
RH		APPLICATION										

DRAWING SIZE C4

3

2

1

NOTES:


1. APPLICABLE STANDARDS/SPECIFICATIONS:
ASME Y14.24-1999
ASME Y14.100
ASME Y14.5M-1994

2. IDENTIFICATION OF THE SUGGESTED SOURCE(S) OF SUPPLY
HEREON IS NOT TO BE CONSTRUED AS A GUARANTEE OF
PRESENT OR CONTINUED AVAILABILITY AS A SOURCE
FOR THE ITEM DESCRIBED ON THIS DRAWING


SUGGESTED SOURCE(S) OF SUPPLY

PART NO.	VENDOR		VENDOR PART NO.
	ADDRESS	CAGE CODE	
11E421454	NOTT COMPANY INC 1005 11TH ST ROCK ISLAND, IL 61201-4002 651-415-3400	3UZE1	16HLD-S

1.50

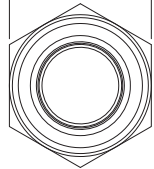

1 7/16-12 UN

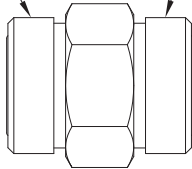

1 7/16-12 UN




THIS DRAWING WAS GENERATED FROM A SOLID MODEL
AND IS CAD MAINTAINED. CHANGES SHALL BE
INCORPORATED BY THE DESIGN ACTIVITY.

VENDOR ITEM CONTROL DRAWING

PART NO. 11E421454

DISTRIBUTION STATEMENT A:
THIS IS APPROVED FOR PUBLIC RELEASE:
DISTRIBUTION IS UNLIMITED

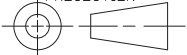
PMIC			DO NOT SCALE DRAWING	CONTRACT NUMBER W52H0910P0057	US ARMY ARMAMENT RESEARCH, DEVELOPMENT AND ENGINEERING CENTER ROCK ISLAND, ILLINOIS 61299-7300		
			UNLESS OTHERWISE SPECIFIED DIMENSIONS ARE IN INCHES	CONTRACTOR ADVANCED CAD/CAM SERVICE	UNION, STR TUBE TO TUBE		
			TOLERANCE ON ANGLES ± 1 °	DRAWN BY E.MUMM			DATE(YEAR-MO-DA) 2010-06-01
			2 PLACE DECIMALS ± .03	CHECKER			ENGINEER G. SLAGER
			3 PLACE DECIMALS ± .010	ENGINEER			QUALITY_ENGINEER
MECHANICAL PROPERTIES			THIRD ANGLE PROJECTION	DRAWING APPROVAL DALE HOLLAND	SIZE C CAGE CODE 59678 DWG NO. 11E421454		
YP				DESIGN APPROVAL THOMAS LETTIS	SCALE 1.000 UNIT WT. SHEET 1 OF 1		
TS							
EL2							
RA							
BH	11E421400	FRS					
RH	NEXT ASSY	USED ON	MATL ENGR	MODELED BY E.MUMM			
	APPLICATION						

FORMAT: C_TACDM_ENG_1.04

3

2

1

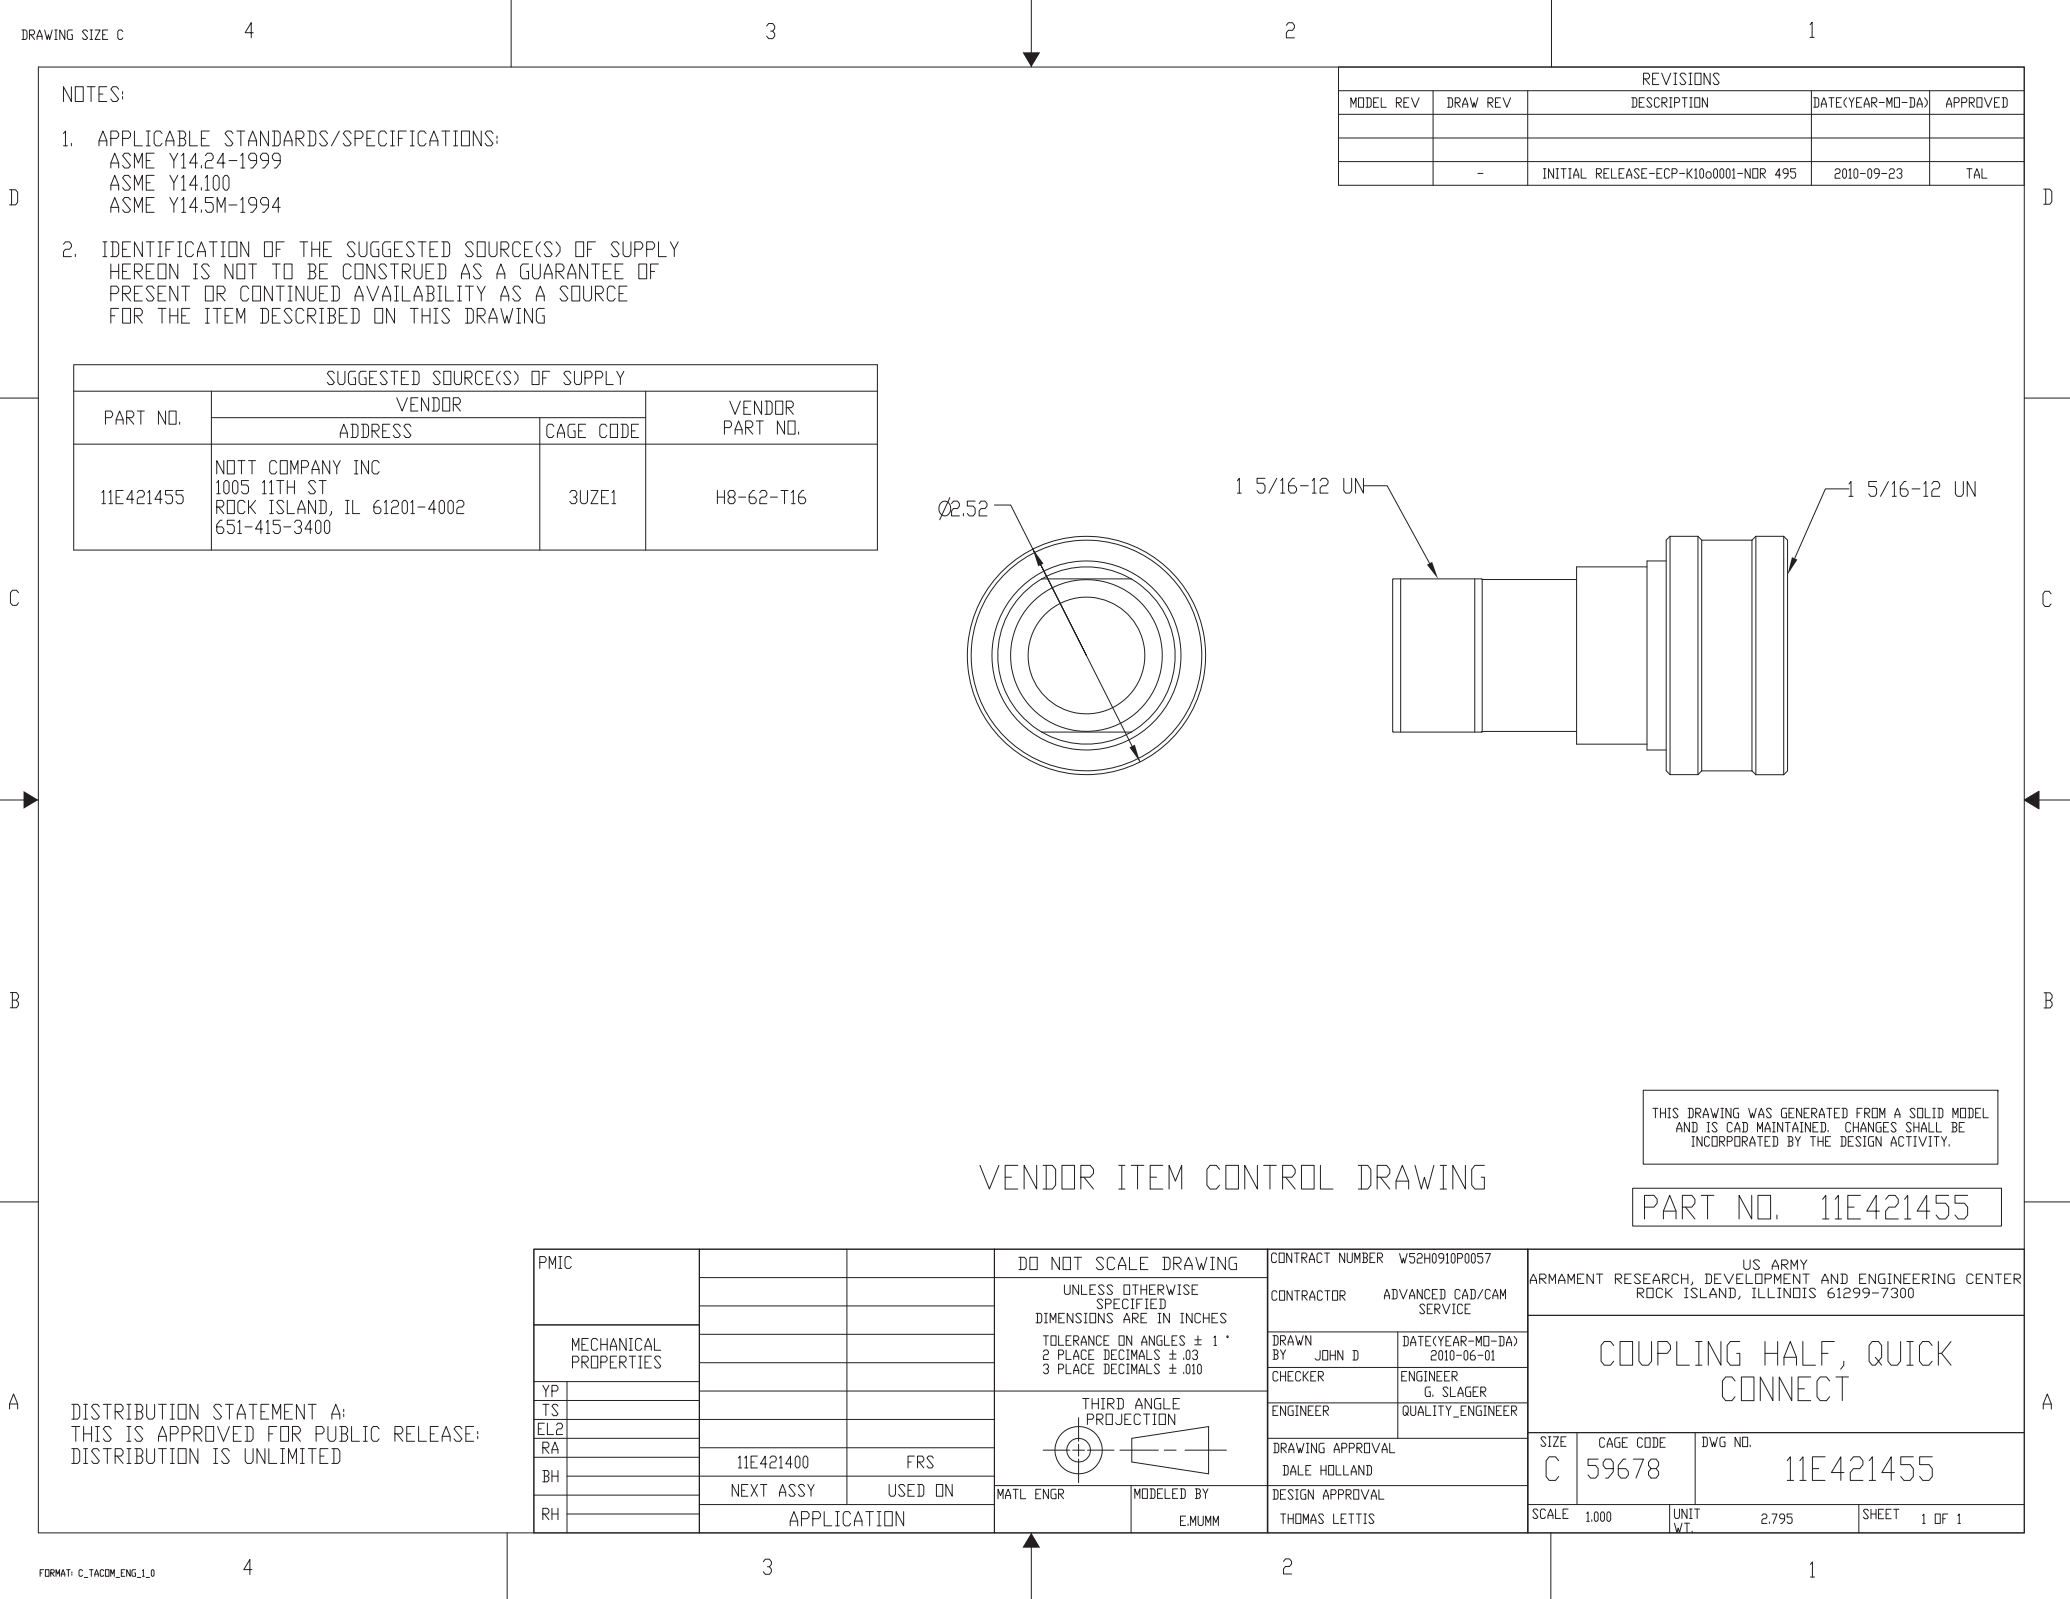


NOTES:

1. APPLICABLE STANDARDS/SPECIFICATIONS:
ASME Y14.24-1999
ASME Y14.100
ASME Y14.5M-1994
2. IDENTIFICATION OF THE SUGGESTED SOURCE(S) OF SUPPLY
HEREON IS NOT TO BE CONSTRUED AS A GUARANTEE OF
PRESENT OR CONTINUED AVAILABILITY AS A SOURCE
FOR THE ITEM DESCRIBED ON THIS DRAWING

REVISIONS				
MODEL REV	DRAW REV	DESCRIPTION	DATE(YEAR-MO-DA)	APPROVED
	-	INITIAL RELEASE-ECP-K1060001-NDR 496	2010-09-23	TAL

SUGGESTED SOURCE(S) OF SUPPLY			
PART NO.	VENDOR		VENDOR PART NO.
	ADDRESS	CAGE CODE	
11E421456	NOTT COMPANY INC 1005 11TH ST ROCK ISLAND, IL 61201-4002 651-415-3400	3UZE1	16F50LD-S

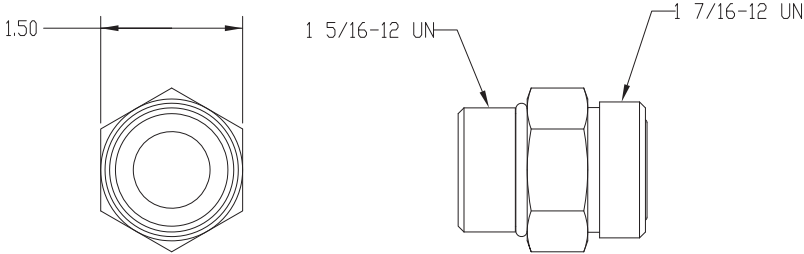

THIS DRAWING WAS GENERATED FROM A SOLID MODEL
AND IS CAD MAINTAINED. CHANGES SHALL BE
INCORPORATED BY THE DESIGN ACTIVITY.

VENDOR ITEM CONTROL DRAWING

PART NO. 11E421456

DISTRIBUTION STATEMENT A:
THIS IS APPROVED FOR PUBLIC RELEASE;
DISTRIBUTION IS UNLIMITED

PMIC				DO NOT SCALE DRAWING		CONTRACT NUMBER W52H0910P0057		US ARMY ARMAMENT RESEARCH, DEVELOPMENT AND ENGINEERING CENTER ROCK ISLAND, ILLINOIS 61299-7300			
MECHANICAL PROPERTIES				UNLESS OTHERWISE SPECIFIED DIMENSIONS ARE IN INCHES TOLERANCE ON ANGLES ± 1 ° 2 PLACE DECIMALS ± .03 3 PLACE DECIMALS ± .010		CONTRACTOR ADVANCED CAD/CAM SERVICE		ADAPTER, STR TUBE TO BOSS			
						DRAWN BY E.MUMM	DATE(YEAR-MO-DA) 2010-06-01				
						CHECKER	ENGINEER G. SLAGER				
						ENGINEER	QUALITY_ENGINEER				
YP				THIRD ANGLE PROJECTION 		DRAWING APPROVAL		SIZE	CAGE CODE	DWG NO.	
TS						DALE HOLLAND		C	59678	11E421456	
EL2						DESIGN APPROVAL					
RA						THOMAS LETTIS					
BH		11E421400	FRS	APPLICATION				SCALE	1.000	UNIT WT.	SHEET 1 OF 1
RH		NEXT ASSY	USED ON								
				MATL ENGR	MODELED BY E.MUMM						

NOTES:

1. APPLICABLE STANDARDS/SPECIFICATIONS:



ASME Y14.24-1999
ASME Y14.100
ASME Y14.5M-1994

2. IDENTIFICATION OF THE SUGGESTED SOURCE(S) OF SUPPLY

HEREON IS NOT TO BE CONSTRUED AS A GUARANTEE OF
PRESENT OR CONTINUED AVAILABILITY AS A SOURCE
FOR THE ITEM DESCRIBED ON THIS DRAWING

REVISIONS				
MODEL REV	DRAW REV	DESCRIPTION	DATE(YEAR-MO-DA)	APPROVED
	-	INITIAL RELEASE-ECP-K10a0001-NDR 497	2010-09-23	TAL

SUGGESTED SOURCE(S) OF SUPPLY			
PART NO.	VENDOR		VENDOR PART NO.
	ADDRESS	CAGE CODE	
11E421457	NOTT COMPANY INC 1005 11TH ST ROCK ISLAND, IL 61201-4002 651-415-3400	3UZE1	20F50LD-S

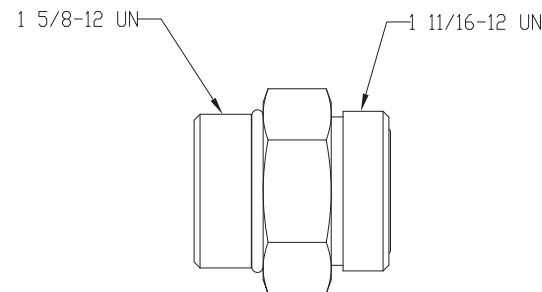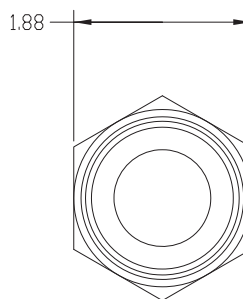





THIS DRAWING WAS GENERATED FROM A SOLID MODEL
AND IS CAD MAINTAINED. CHANGES SHALL BE
INCORPORATED BY THE DESIGN ACTIVITY.

VENDOR ITEM CONTROL DRAWING

PART NO. 11E421457

DISTRIBUTION STATEMENT A:
THIS IS APPROVED FOR PUBLIC RELEASE;
DISTRIBUTION IS UNLIMITED

PMIC				DO NOT SCALE DRAWING		CONTRACT NUMBER W52H0910P0057		US ARMY	
MECHANICAL PROPERTIES				UNLESS OTHERWISE SPECIFIED DIMENSIONS ARE IN INCHES TOLERANCE ON ANGLES $\pm 1^\circ$ 2 PLACE DECIMALS $\pm .03$ 3 PLACE DECIMALS $\pm .010$		CONTRACTOR ADVANCED CAD/CAM SERVICE		ARMAMENT RESEARCH, DEVELOPMENT AND ENGINEERING CENTER ROCK ISLAND, ILLINOIS 61299-5000	
						DRAWN BY E.MUMM	DATE(YEAR-MO-DA) 2010-06-01	ADAPTER, STR TUBE TO BOSS	
						CHECKER	ENGINEER G. SLAGER		
						ENGINEER	QUALITY_ENGINEER		
YP				THIRD ANGLE PROJECTION 		DRAWING APPROVAL DALE HOLLAND		SIZE C	CAGE CODE 59678
TS						DESIGN APPROVAL THOMAS LETTIS		DWG NO. 11E421457	
EL2								SCALE 1.000	UNIT WT.
RA								SHEET 1 OF 1	
BH		11E421400	FRS	APPLICATION					
RH		NEXT ASSY	USED ON						

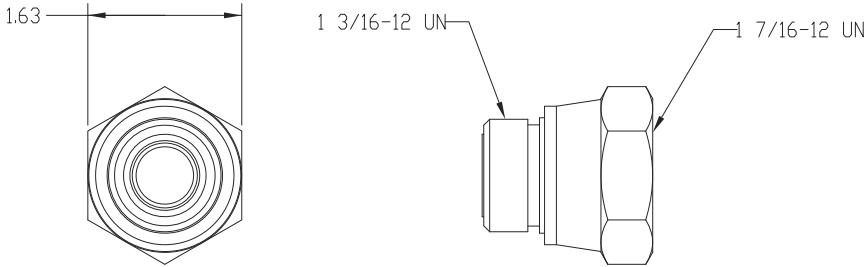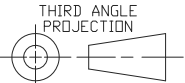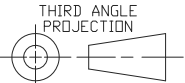
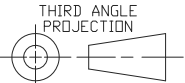
DRAWING SIZE C		4	3		2		1																																																																												
NOTES: 1. APPLICABLE STANDARDS/SPECIFICATIONS: ASME Y14.24-1999 ASME Y14.100 ASME Y14.5M-1994 2. IDENTIFICATION OF THE SUGGESTED SOURCE(S) OF SUPPLY HEREON IS NOT TO BE CONSTRUED AS A GUARANTEE OF PRESENT OR CONTINUED AVAILABILITY AS A SOURCE FOR THE ITEM DESCRIBED ON THIS DRAWING					REVISIONS																																																																														
					MODEL REV	DRAW REV	DESCRIPTION	DATE(YEAR-MO-DA)	APPROVED																																																																										
						-	INITIAL RELEASE-ECP-K10a0001-NDR 499	2010-09-23	TAL																																																																										
<table><tr><th colspan="4">SUGGESTED SOURCE(S) OF SUPPLY</th></tr><tr><th rowspan="2">PART NO.</th><th colspan="2">VENDOR</th><th rowspan="2">VENDOR PART NO.</th></tr><tr><th>ADDRESS</th><th>CAGE CODE</th></tr><tr><td>11E421459</td><td>NOTT COMPANY INC 1005 11TH ST ROCK ISLAND, IL 61201-4002 651-415-3400</td><td>3UZE1</td><td>16-12TRLON-S</td></tr></table>					SUGGESTED SOURCE(S) OF SUPPLY				PART NO.	VENDOR		VENDOR PART NO.	ADDRESS	CAGE CODE	11E421459	NOTT COMPANY INC 1005 11TH ST ROCK ISLAND, IL 61201-4002 651-415-3400	3UZE1	16-12TRLON-S																																																																	
SUGGESTED SOURCE(S) OF SUPPLY																																																																																			
PART NO.	VENDOR		VENDOR PART NO.																																																																																
	ADDRESS	CAGE CODE																																																																																	
11E421459	NOTT COMPANY INC 1005 11TH ST ROCK ISLAND, IL 61201-4002 651-415-3400	3UZE1	16-12TRLON-S																																																																																
DISTRIBUTION STATEMENT A: THIS IS APPROVED FOR PUBLIC RELEASE; DISTRIBUTION IS UNLIMITED					THIS DRAWING WAS GENERATED FROM A SOLID MODEL AND IS CAD MAINTAINED. CHANGES SHALL BE INCORPORATED BY THE DESIGN ACTIVITY.																																																																														
					PART NO. 11E421459																																																																														
<table><tr><td>PMIC</td><td></td><td></td><td colspan="2">DO NOT SCALE DRAWING</td><td colspan="2">CONTRACT NUMBER W52H0910P0057</td><td colspan="2">US ARMY</td></tr><tr><td></td><td></td><td></td><td colspan="2">UNLESS OTHERWISE SPECIFIED DIMENSIONS ARE IN INCHES</td><td colspan="2">CONTRACTOR ADVANCED CAD/CAM SERVICE</td><td colspan="2">ARMAMENT RESEARCH, DEVELOPMENT AND ENGINEERING CENTER ROCK ISLAND, ILLINOIS 61299-7300</td></tr><tr><td></td><td>MECHANICAL PROPERTIES</td><td></td><td colspan="2">TOLERANCE ON ANGLES ± 1 ° 2 PLACE DECIMALS ± .03 3 PLACE DECIMALS ± .010</td><td colspan="2">DRAWN BY E.MUMM DATE(YEAR-MO-DA) 2010-06-01</td><td colspan="2" rowspan="2">REDUCER, STR TUBE</td></tr><tr><td>YP</td><td></td><td></td><td colspan="2">THIRD ANGLE PROJECTION</td><td colspan="2">CHECKER ENGINEER G. SLAGER</td></tr><tr><td>TS</td><td></td><td></td><td colspan="2" rowspan="2"></td><td colspan="2">ENGINEER QUALITY_ENGINEER</td><td colspan="2" rowspan="2">SIZE C CAGE CODE 59678 DWG NO. 11E421459</td></tr><tr><td>EL2</td><td></td><td></td><td colspan="2">DRAWING APPROVAL DALE HOLLAND</td></tr><tr><td>RA</td><td></td><td>11E421400 FRS</td><td colspan="2">MATERIAL ENGR</td><td colspan="2">DESIGN APPROVAL THOMAS LETTIS</td><td colspan="2">SCALE 1.000 UNIT WT.</td></tr><tr><td>BH</td><td></td><td>NEXT ASSY USED ON</td><td colspan="2">MODELED BY E.MUMM</td><td colspan="2"></td><td colspan="2">SHEET 1 OF 1</td></tr><tr><td>RH</td><td></td><td colspan="2">APPLICATION</td><td colspan="2"></td><td colspan="2"></td><td></td></tr></table>					PMIC			DO NOT SCALE DRAWING		CONTRACT NUMBER W52H0910P0057		US ARMY					UNLESS OTHERWISE SPECIFIED DIMENSIONS ARE IN INCHES		CONTRACTOR ADVANCED CAD/CAM SERVICE		ARMAMENT RESEARCH, DEVELOPMENT AND ENGINEERING CENTER ROCK ISLAND, ILLINOIS 61299-7300			MECHANICAL PROPERTIES		TOLERANCE ON ANGLES ± 1 ° 2 PLACE DECIMALS ± .03 3 PLACE DECIMALS ± .010		DRAWN BY E.MUMM DATE(YEAR-MO-DA) 2010-06-01		REDUCER, STR TUBE		YP			THIRD ANGLE PROJECTION		CHECKER ENGINEER G. SLAGER		TS					ENGINEER QUALITY_ENGINEER		SIZE C CAGE CODE 59678 DWG NO. 11E421459		EL2			DRAWING APPROVAL DALE HOLLAND		RA		11E421400 FRS	MATERIAL ENGR		DESIGN APPROVAL THOMAS LETTIS		SCALE 1.000 UNIT WT.		BH		NEXT ASSY USED ON	MODELED BY E.MUMM				SHEET 1 OF 1		RH		APPLICATION										
PMIC			DO NOT SCALE DRAWING		CONTRACT NUMBER W52H0910P0057		US ARMY																																																																												
			UNLESS OTHERWISE SPECIFIED DIMENSIONS ARE IN INCHES		CONTRACTOR ADVANCED CAD/CAM SERVICE		ARMAMENT RESEARCH, DEVELOPMENT AND ENGINEERING CENTER ROCK ISLAND, ILLINOIS 61299-7300																																																																												
	MECHANICAL PROPERTIES		TOLERANCE ON ANGLES ± 1 ° 2 PLACE DECIMALS ± .03 3 PLACE DECIMALS ± .010		DRAWN BY E.MUMM DATE(YEAR-MO-DA) 2010-06-01		REDUCER, STR TUBE																																																																												
YP			THIRD ANGLE PROJECTION		CHECKER ENGINEER G. SLAGER																																																																														
TS					ENGINEER QUALITY_ENGINEER		SIZE C CAGE CODE 59678 DWG NO. 11E421459																																																																												
EL2					DRAWING APPROVAL DALE HOLLAND																																																																														
RA		11E421400 FRS	MATERIAL ENGR		DESIGN APPROVAL THOMAS LETTIS		SCALE 1.000 UNIT WT.																																																																												
BH		NEXT ASSY USED ON	MODELED BY E.MUMM				SHEET 1 OF 1																																																																												
RH		APPLICATION																																																																																	
FORMAT: C_TACOM_ENG_1.0		4	3		2		1																																																																												

NOTES:

1. APPLICABLE STANDARDS/SPECIFICATIONS:
ASME Y14.24-1999
ASME Y14.100
ASME Y14.5M-1994
2. IDENTIFICATION OF THE SUGGESTED SOURCE(S) OF SUPPLY
HEREON IS NOT TO BE CONSTRUED AS A GUARANTEE OF
PRESENT OR CONTINUED AVAILABILITY AS A SOURCE
FOR THE ITEM DESCRIBED ON THIS DRAWING

REVISIONS				
MODEL REV	DRAW REV	DESCRIPTION	DATE(YEAR-MO-DA)	APPROVED
	-	INITIAL RELEASE-ECP-K10o0001-NDR 500	2010-09-23	TAL

SUGGESTED SOURCE(S) OF SUPPLY			
PART NO.	VENDOR		VENDOR PART NO.
	ADDRESS	CAGE CODE	
11E421460	NOTT COMPANY INC 1005 11TH ST ROCK ISLAND, IL 61201-4002 651-415-3400	3UZE1	8WLD-WLNL-S

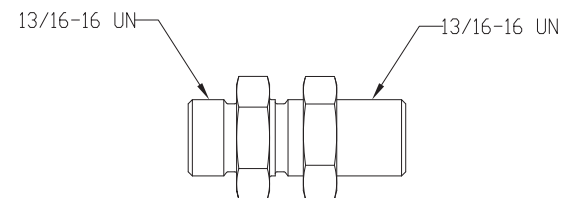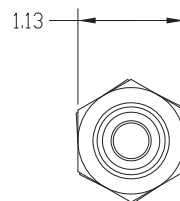

THIS DRAWING WAS GENERATED FROM A SOLID MODEL
AND IS CAD MAINTAINED. CHANGES SHALL BE
INCORPORATED BY THE DESIGN ACTIVITY.

VENDOR ITEM CONTROL DRAWING

PART NO. 11E421460

DISTRIBUTION STATEMENT A:
THIS IS APPROVED FOR PUBLIC RELEASE;
DISTRIBUTION IS UNLIMITED



PMIC				DO NOT SCALE DRAWING		CONTRACT NUMBER W52H0910P0057		US ARMY ARMAMENT RESEARCH, DEVELOPMENT AND ENGINEERING CENTER ROCK ISLAND, ILLINOIS 61299-7300		
MECHANICAL PROPERTIES				UNLESS OTHERWISE SPECIFIED DIMENSIONS ARE IN INCHES TOLERANCE ON ANGLES $\pm 1^\circ$ 2 PLACE DECIMALS $\pm .03$ 3 PLACE DECIMALS $\pm .010$		CONTRACTOR ADVANCED CAD/CAM SERVICE		UNION, BULKHEAD, STR TUBE TO TUBE		
						DRAWN BY E.MUMM	DATE(YEAR-MO-DA) 2010-06-01			
						CHECKER	ENGINEER G. SLAGER			
						ENGINEER	QUALITY_ENGINEER			
YP				THIRD ANGLE PROJECTION 		DRAWING APPROVAL DALE HOLLAND		SIZE C	CAGE CODE 59678	DWG NO. 11E421460
TS						DESIGN APPROVAL THOMAS LETTIS		SCALE 1.000	UNIT WT.	SHEET 1 OF 1
EL2										
RA										
BH		11E421400	FRS							
RH		NEXT ASSY	USED ON							
		APPLICATION								

NOTES:

1. APPLICABLE STANDARDS/SPECIFICATIONS:
ASME Y14.24-1999
ASME Y14.100
ASME Y14.5M-1994
2. IDENTIFICATION OF THE SUGGESTED SOURCE(S) OF SUPPLY
HEREON IS NOT TO BE CONSTRUED AS A GUARANTEE OF
PRESENT OR CONTINUED AVAILABILITY AS A SOURCE
FOR THE ITEM DESCRIBED ON THIS DRAWING

REVISIONS				
MODEL REV	DRAW REV	DESCRIPTION	DATE(YEAR-MO-DA)	APPROVED
	-	INITIAL RELEASE-ECP-K10o0001-NDR 501	2010-09-23	TAL

SUGGESTED SOURCE(S) OF SUPPLY			
PART NO.	VENDOR		VENDOR PART NO.
	ADDRESS	CAGE CODE	
11E421461	NOTT COMPANY INC 1005 11TH ST ROCK ISLAND, IL 61201-4002 651-415-3400	3UZE1	8-4TRLON-S

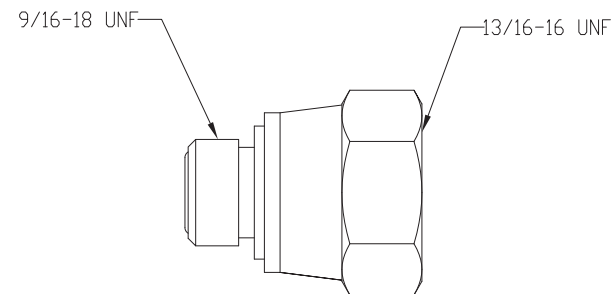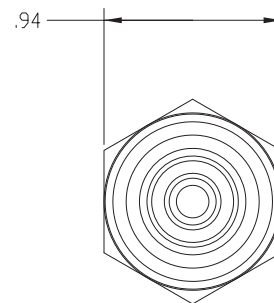

THIS DRAWING WAS GENERATED FROM A SOLID MODEL
AND IS CAD MAINTAINED. CHANGES SHALL BE
INCORPORATED BY THE DESIGN ACTIVITY.

VENDOR ITEM CONTROL DRAWING

PART NO. 11E421461

DISTRIBUTION STATEMENT A:
THIS IS APPROVED FOR PUBLIC RELEASE:
DISTRIBUTION IS UNLIMITED



PMIC				DO NOT SCALE DRAWING		CONTRACT NUMBER W52H0910P0057		US ARMY ARMAMENT RESEARCH, DEVELOPMENT AND ENGINEERING CENTER ROCK ISLAND, ILLINOIS 61299-7300	
MECHANICAL PROPERTIES				UNLESS OTHERWISE SPECIFIED DIMENSIONS ARE IN INCHES TOLERANCE ON ANGLES $\pm 1^\circ$ 2 PLACE DECIMALS $\pm .03$ 3 PLACE DECIMALS $\pm .010$		CONTRACTOR ADVANCED CAD/CAM SERVICE		REDUCER, STR TUBE	
						DRAWN BY E.MUMM	DATE(YEAR-MO-DA) 2010-06-01		
						CHECKER	ENGINEER G. SLAGER		
						ENGINEER	QUALITY_ENGINEER		
YP				THIRD ANGLE PROJECTION 		DRAWING APPROVAL		SIZE	CAGE CODE
TS						DALE HOLLAND		C	59678
EL2						DESIGN APPROVAL		DWG NO.	
RA						THOMAS LETTIS		11E421461	
BH		11E421400	FRS	APPLICATION				SCALE	UNIT
RH		NEXT ASSY	USED ON					1:000	WT.
				MATL ENGR	MODELED BY			SHEET 1 OF 1	
					E.MUMM				

NOTES:

1. APPLICABLE STANDARDS/SPECIFICATIONS:
ASME Y14.24-1999
ASME Y14.100
ASME Y14.5M-1994
2. IDENTIFICATION OF THE SUGGESTED SOURCE(S) OF SUPPLY
HEREON IS NOT TO BE CONSTRUED AS A GUARANTEE OF
PRESENT OR CONTINUED AVAILABILITY AS A SOURCE
FOR THE ITEM DESCRIBED ON THIS DRAWING

REVISIONS				
MODEL REV	DRAW REV	DESCRIPTION	DATE(YEAR-MO-DA)	APPROVED
	-	INITIAL RELEASE-ECP-K10a0001-NDR 502	2010-09-23	TAL

SUGGESTED SOURCE(S) OF SUPPLY			
PART NO.	VENDOR		VENDOR PART NO.
	ADDRESS	CAGE CODE	
11E421462	NOTT COMPANY INC 1005 11TH ST ROCK ISLAND, IL 61201-4002 651-415-3400	3UZE1	8F65L0-S

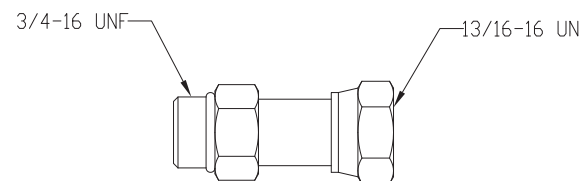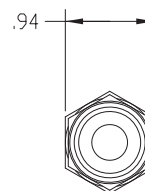

THIS DRAWING WAS GENERATED FROM A SOLID MODEL
AND IS CAD MAINTAINED. CHANGES SHALL BE
INCORPORATED BY THE DESIGN ACTIVITY.

VENDOR ITEM CONTROL DRAWING

PART NO. 11E421462

DISTRIBUTION STATEMENT A:
THIS IS APPROVED FOR PUBLIC RELEASE;
DISTRIBUTION IS UNLIMITED

PMIC				DO NOT SCALE DRAWING		CONTRACT NUMBER W52H0910P0057		US ARMY ARMAMENT RESEARCH, DEVELOPMENT AND ENGINEERING CENTER ROCK ISLAND, ILLINOIS 61299-7300	
MECHANICAL PROPERTIES				UNLESS OTHERWISE SPECIFIED DIMENSIONS ARE IN INCHES TOLERANCE ON ANGLES $\pm 1^\circ$ 2 PLACE DECIMALS $\pm .03$ 3 PLACE DECIMALS $\pm .010$		CONTRACTOR ADVANCED CAD/CAM SERVICE		ADAPTER, STR, PIPE TO HOSE	
						DRAWN BY JOHN D	DATE(YEAR-MO-DA) 2010-06-01		
						CHECKER	ENGINEER G. SLAGER		
						ENGINEER	QUALITY ENGINEER		
YP				THIRD ANGLE PROJECTION 		DRAWING APPROVAL DALE HOLLAND		SIZE C	CAGE CODE 59678
TS						DESIGN APPROVAL THOMAS LETTIS		DWG NO. 11E421462	
EL2								SCALE 1.000	UNIT WT.
RA								SHEET 1 OF 1	
BH		11E421400	FRS	APPLICATION					
RH		NEXT ASSY	USED ON						
				MATL ENGR	MODELED BY E.MUMM				


NOTES:

1. APPLICABLE STANDARDS/SPECIFICATIONS:
ASME Y14.24-1999
ASME Y14.100
ASME Y14.5M-1994
2. IDENTIFICATION OF THE SUGGESTED SOURCE(S) OF SUPPLY
HEREON IS NOT TO BE CONSTRUED AS A GUARANTEE OF
PRESENT OR CONTINUED AVAILABILITY AS A SOURCE
FOR THE ITEM DESCRIBED ON THIS DRAWING


SUGGESTED SOURCE(S) OF SUPPLY			
PART NO.	VENDOR		VENDOR PART NO.
	ADDRESS	CAGE CODE	
11E421463	NOTT COMPANY INC 1005 11TH ST ROCK ISLAND, IL 61201-4002 651-415-3400	3UZE1	H3-62-T8

REVISIONS				
MODEL REV	DRAW REV	DESCRIPTION	DATE(YEAR-MO-DA)	APPROVED
	-	INITIAL RELEASE-ECP-K10a0001-NDR 503	2010-09-23	TAL

Ø1.38

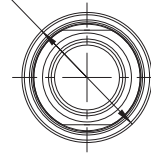

3/4-16 UN

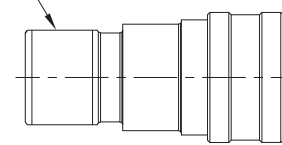


3/4-16 UN

THIS DRAWING WAS GENERATED FROM A SOLID MODEL
AND IS CAD MAINTAINED. CHANGES SHALL BE
INCORPORATED BY THE DESIGN ACTIVITY.

VENDOR ITEM CONTROL DRAWING

PART NO. 11E421463

DISTRIBUTION STATEMENT A:
THIS IS APPROVED FOR PUBLIC RELEASE:
DISTRIBUTION IS UNLIMITED


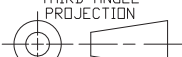
PMIC				DO NOT SCALE DRAWING		CONTRACT NUMBER W52H0910P0057		US ARMY ARMAMENT RESEARCH, DEVELOPMENT AND ENGINEERING CENTER ROCK ISLAND, ILLINOIS 61299-7300			
MECHANICAL PROPERTIES				UNLESS OTHERWISE SPECIFIED DIMENSIONS ARE IN INCHES TOLERANCE ON ANGLES ± 1° 2 PLACE DECIMALS ± .03 3 PLACE DECIMALS ± .010		CONTRACTOR ADVANCED CAD/CAM SERVICE		COUPLING HALF, QUICK CONNECT			
						DRAWN BY JOHN D DATE(YEAR-MO-DA) 2010-06-01					
						CHECKER ENGINEER G. SLAGER					
						ENGINEER QUALITY_ENGINEER					
YP				THIRD ANGLE PROJECTION 		DRAWING APPROVAL DALE HOLLAND		SIZE C	CAGE CODE 59678	DWG NO. 11E421463	
TS						DESIGN APPROVAL THOMAS LETTIS					
EL2								SCALE 1.000	UNIT 0.000	SHEET 1 OF 1	
RA											
BH		11E421400	FRS	APPLICATION							
		NEXT ASSY	USED ON								
RH				MATL ENGR	MODELED BY E.MUMM						

NOTES:

1. APPLICABLE STANDARDS/SPECIFICATIONS:
ASME Y14.24-1999
ASME Y14.100
ASME Y14.5M-1994
2. IDENTIFICATION OF THE SUGGESTED SOURCE(S) OF SUPPLY
HEREON IS NOT TO BE CONSTRUED AS A GUARANTEE OF
PRESENT OR CONTINUED AVAILABILITY AS A SOURCE
FOR THE ITEM DESCRIBED ON THIS DRAWING

SUGGESTED SOURCE(S) OF SUPPLY			
PART NO.	VENDOR		VENDOR PART NO.
	ADDRESS	CAGE CODE	
11E421464	NOTT COMPANY INC 1005 11TH ST ROCK ISLAND, IL 61201-4002 651-415-3400	3UZE1	H3-63-T8

REVISIONS				
MODEL REV	DRAW REV	DESCRIPTION	DATE(YEAR-MO-DA)	APPROVED
	-	INITIAL RELEASE-ECP-K10g0001-NDR 504	2010-09-23	TAL

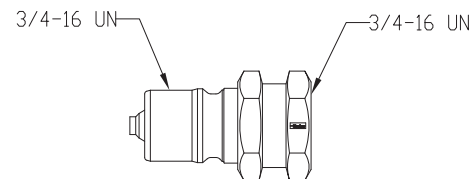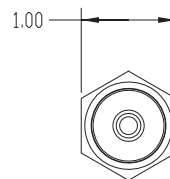

THIS DRAWING WAS GENERATED FROM A SOLID MODEL
AND IS CAD MAINTAINED. CHANGES SHALL BE
INCORPORATED BY THE DESIGN ACTIVITY.

VENDOR ITEM CONTROL DRAWING

PART NO. 11E421464

DISTRIBUTION STATEMENT A:
THIS IS APPROVED FOR PUBLIC RELEASE;
DISTRIBUTION IS UNLIMITED

PMIC				DO NOT SCALE DRAWING		CONTRACT NUMBER W52H0910P0057		US ARMY ARMAMENT RESEARCH, DEVELOPMENT AND ENGINEERING CENTER ROCK ISLAND, ILLINOIS 61299-7300			
MECHANICAL PROPERTIES				UNLESS OTHERWISE SPECIFIED DIMENSIONS ARE IN INCHES TOLERANCE ON ANGLES ± 1 ° 2 PLACE DECIMALS ± .03 3 PLACE DECIMALS ± .010		CONTRACTOR ADVANCED CAD/CAM SERVICE		NIPPLE, MALE STR BOSS			
						DRAWN BY E.MUMM	DATE(YEAR-MO-DA) 2010-06-01				
						CHECKER	ENGINEER G. SLAGER				
						ENGINEER	QUALITY_ENGINEER				
YP				THIRD ANGLE PROJECTION 		DRAWING APPROVAL DALE HOLLAND		SIZE C	CAGE CODE 59678	DWG NO. 11E421464	
TS						DESIGN APPROVAL THOMAS LETTIS					
EL2								SCALE 1.000		UNIT	SHEET 1 OF 1
RA											
BH		11E421400	FRS								
RH		NEXT ASSY	USED ON								
		APPLICATION		MATL ENGR		MODELED BY E.MUMM					

NOTES:

1. APPLICABLE STANDARDS/SPECIFICATIONS:

ASME Y14.24-1999
ASME Y14.100
ASME Y14.5M-1994


2. IDENTIFICATION OF THE SUGGESTED SOURCE(S) OF SUPPLY
HEREON IS NOT TO BE CONSTRUED AS A GUARANTEE OF
PRESENT OR CONTINUED AVAILABILITY AS A SOURCE
FOR THE ITEM DESCRIBED ON THIS DRAWING

REVISIONS				
MODEL REV	DRAW REV	DESCRIPTION	DATE(YEAR-MO-DA)	APPROVED
	-	INITIAL RELEASE-ECP-K10a0001-NOR 506	2010-09-23	TAL


-1 ERR K19O3005 2019-XX-XX CWH

SUGGESTED SOURCE(S) OF SUPPLY			
PART NO.	VENDOR		VENDOR PART NO.
	ADDRESS	CAGE CODE	
11E421470	DELUX TANK MFG CO. 1908 E LEXINGTON HUTCHINSON, KS. 67501 PH 816-380-2372	8L740 3GGA7	220365

IFH GROUP, INC.
3300 E ROCK FALLS RD
ROCK FALLS, IL 61071-1308

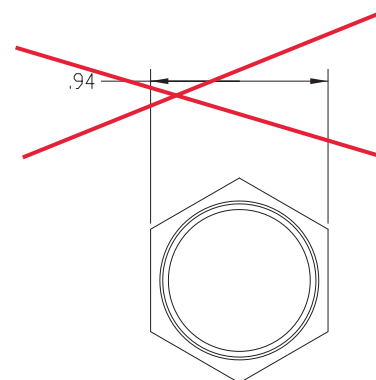

1/2" NPT

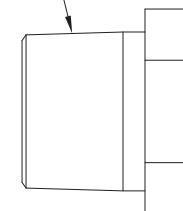

ITEM NAME TYPE	DESCRIPTION 1/2" NPT MAGNETIC PIPE PLUG
MATERIAL HEAD	STAINLESS STEEL EXTERNAL SQUARE OR HEX

THIS DRAWING WAS GENERATED FROM A SOLID MODEL
AND IS CAD MAINTAINED. CHANGES SHALL BE
INCORPORATED BY THE DESIGN ACTIVITY.

VENDOR ITEM CONTROL DRAWING

PART NO. 11E421470

PMIC				DO NOT SCALE DRAWING		CONTRACT NUMBER W52H0910P0057		US ARMY	
MECHANICAL PROPERTIES				UNLESS OTHERWISE SPECIFIED DIMENSIONS ARE IN INCHES TOLERANCE ON ANGLES $\pm 1^\circ$ 2 PLACE DECIMALS $\pm .03$ 3 PLACE DECIMALS $\pm .010$		CONTRACTOR ADVANCED CAD/CAM SERVICE		ARMAMENT RESEARCH, DEVELOPMENT AND ENGINEERING CENTER ROCK ISLAND, ILLINOIS 61299-7300	
						DRAWN BY JOHN D	DATE(YEAR-MO-DA) 2011-02-08		
						CHECKER	ENGINEER G SLAGER		
						ENGINEER	QUALITY ENGINEER		
YP				THIRD ANGLE PROJECTION 		DRAWING APPROVAL		SIZE	CAGE CODE
TS						DALE HOLLAND		C	59678
EL2						DESIGN APPROVAL		DWG NO.	
RA						THOMAS LETTIS		11E421470	
BH		11E421400	FRS	APPLICATION				SCALE	UNIT
RH		NEXT ASSY	USED ON					2.000	0.000
				MATL ENGR	MODELED BY			SHEET 1 OF 1	
					ERIC M				

DISTRIBUTION STATEMENT A:
THIS IS APPROVED FOR PUBLIC RELEASE;
DISTRIBUTION IS UNLIMITED

NOTES:

1. APPLICABLE STANDARDS/SPECIFICATIONS
ASME Y14.100-2017
ASME Y14.5-2009
2. IDENTIFICATION OF THE SUGGESTED SOURCE(S) OF SUPPLY
HEREON IS NOT TO BE CONSTRUED AS A GUARANTEE OF
PRESENT OR CONTINUED AVAILABILITY AS A SOURCE OF
SUPPLY FOR THE ITEM(S).

REVISIONS


REVISION	DESCRIPTION	DATE(YEAR-MM-DA)	APPROVED
X0	ECP K1803005	2019-MM-DD	CWH

SPECIFICATIONS

TYPE	PISTON PUMP, HYDRAULIC, VARIABLE VOLUME
DISPLACEMENT / REVOLUTION	33 CUBIC INCHES
PUMP DELIVERY AT 1200 RPM	10.4 GPM (AT 300 PSI)
INPUT POWER, MAXIMUM	27.2 kW (36.5 hp)
MAX OPERATING SPEED	3,000 RPM
PRESSURE RANGE	250 - 3,600 PSI
SHAFT CONNECTION	13-T SPLINE

SUGGESTED SOURCE(S) OF SUPPLY

PART NO.	VENDOR		VENDOR PART NO.
	ADDRESS	CAGE CODE	
11E421903	PARKER-HANNIFIN CORPORATION DBA HYDRAULIC PUMP DIVISION 14249 INDUSTRIAL PKWY MARYSVILLE, OH 43040-9504 PH: (937) 644-3915	9F512	PVP3336BRA21

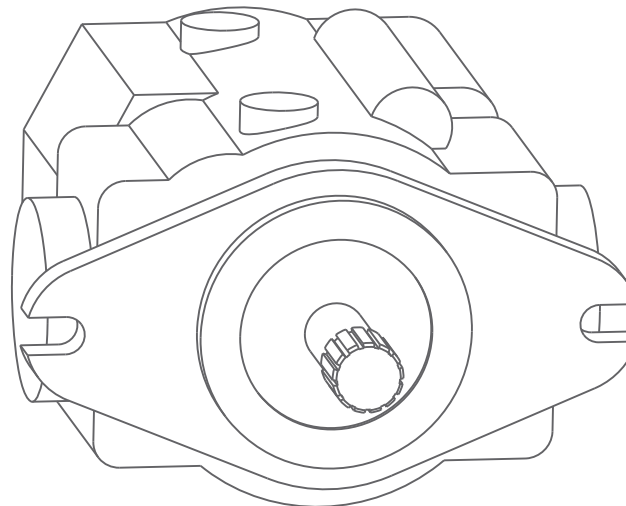

ISO VIEW

THIS DRAWING WAS GENERATED FROM A SOLID MODEL
AND IS CAD MAINTAINED. CHANGES SHALL BE
INCORPORATED BY THE DESIGN ACTIVITY.

VENDOR ITEM CONTROL DRAWING

PART NO. 11E421903

PMIC		DO NOT SCALE DRAWING		CONTRACT NUMBER		DESIGN ACTIVITY	
		UNLESS OTHERWISE SPECIFIED DIMENSIONS ARE IN INCHES		CONTRACTOR		US ARMY COMBAT CAPABILITIES DEVELOPMENT COMMAND ARMAMENTS CENTER ROCK ISLAND, ILLINOIS 61299-7300	
MECHANICAL PROPERTIES		TOLERANCE ON ANGLES $\pm 1^\circ$ 2 PLACE DECIMALS $\pm .03$ 3 PLACE DECIMALS $\pm .010$		DRAWN BY K. ROESER	DATE(YEAR-MM-DA) 2019-03-07	PUMP, HYDRAULIC	
YP		THIRD ANGLE PROJECTION		CHECKER B. VERMULM	ENGINEER K. ROESER		
TS				ENGINEER	QUALITY ENGINEER		
EL2				DRAWING APPROVAL		SIZE C	DAI 59678
RA		11E421400	FRS	V. VONDERA (YEAR-MM-DD)		DWG NO.	11E421903
BH		NEXT ASSY	USED ON	DESIGN APPROVAL		SCALE	2/1
RH		APPLICATION		C. HANEY (YEAR-MM-DD)		UNIT WT.	
		MATL ENGR		MODELED BY K. ROESER		SHEET	1 OF 1

DISTRIBUTION STATEMENT A.
APPROVED FOR PUBLIC RELEASE;
DISTRIBUTION IS UNLIMITED.

NOTES:

1. APPLICABLE STANDARDS/SPECIFICATIONS
ASME Y14.100-2017
ASME Y14.5-2009
2. IDENTIFICATION OF THE SUGGESTED SOURCE(S) OF SUPPLY
HEREON IS NOT TO BE CONSTRUED AS A GUARANTEE OF
PRESENT OR CONTINUED AVAILABILITY AS A SOURCE OF
SUPPLY FOR THE ITEM(S).

REVISIONS


REVISION	DESCRIPTION	DATE(YEAR-MO-DA)	APPROVED
X0	ECP K1803005	2019-MM-DD	CWH

SPECIFICATIONS

TYPE	HOSE ASSEMBLY, FEMALE 37° SWIVEL TO MALE STRAIGHT THREAD
HOSE LENGTH (L)	30 FEET
HOSE OUTER DIAMETER	1.20" NOMINAL
HOSE INNER DIAMETER	0.75" NOMINAL
HOSE MAXIMUM WORKING PRESSURE	4,000 PSI
MALE CONNECTION TYPE	SAE STRAIGHT THREAD WITH O-RING, CRIMPED
MALE THREAD SIZE	1-1/16"X12
FEMALE CONNECTION TYPE	JIC 37° SWIVEL, CRIMPED
FEMALE THREAD SIZE	1-1/16"X12

SUGGESTED SOURCE(S) OF SUPPLY

PART NO.	VENDOR		VENDOR PART NO.
	ADDRESS	CAGE CODE	
11E421924	PARKER-HANNIFIN CORPORATION 220 ROBERTS CUT OFF RD FORT WORTH, TX 76114-3605	98441	F7720605121212360
	NOTT COMPANY DIV FLUID POWER 1005 11TH ST MILAN, IL 61264-2244 PH: (651) 415-3501	3UZE1	F7720605121212360

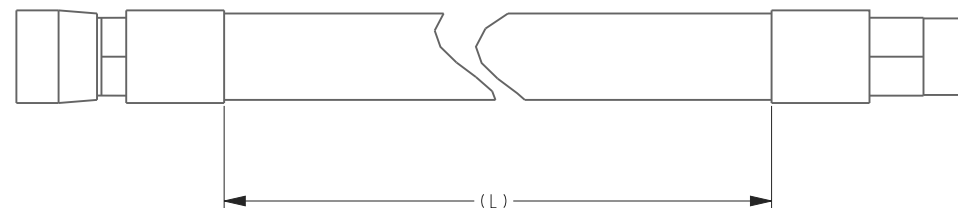

THIS DRAWING WAS GENERATED FROM A SOLID MODEL
AND IS CAD MAINTAINED. CHANGES SHALL BE
INCORPORATED BY THE DESIGN ACTIVITY.

VENDOR ITEM CONTROL DRAWING

PART NO. 11E421924

PMIC		DO NOT SCALE DRAWING		CONTRACT NUMBER		DESIGN ACTIVITY	
		UNLESS OTHERWISE SPECIFIED DIMENSIONS ARE IN INCHES		CONTRACTOR		US ARMY COMBAT CAPABILITIES DEVELOPMENT COMMAND ARMAMENTS CENTER ROCK ISLAND, ILLINOIS 61299-7300	
MECHANICAL PROPERTIES		TOLERANCE ON ANGLES $\pm 1^\circ$ 2 PLACE DECIMALS $\pm .03$ 3 PLACE DECIMALS $\pm .010$		DRAWN BY K. ROESER	DATE(YEAR-MO-DA) 2019-03-14	HOSE, FEMALE 37° SWIVEL, MALE STRAIGHT THREAD	
YP		THIRD ANGLE PROJECTION		CHECKER B. VERMULM	ENGINEER K. ROESER		
TS				ENGINEER	QUALITY ENGINEER		
EL2				DRAWING APPROVAL V. VONDERA (YEAR-MM-DD)		SIZE C	DAI 59678
RA		11E421400	FRS	DESIGN APPROVAL C. HANEY (YEAR-MM-DD)		DWG NO.	11E421924
BH		NEXT ASSY	USED ON			SCALE	3/4
RH		APPLICATION		MATL ENGR	MODELED BY K. ROESER	UNIT WT.	SHEET 1 OF 1

DISTRIBUTION STATEMENT A.
APPROVED FOR PUBLIC RELEASE;
DISTRIBUTION IS UNLIMITED.

NOTES:

1. APPLICABLE STANDARDS/SPECIFICATIONS
ASME Y14.100-2017
ASME Y14.5-2009
2. IDENTIFICATION OF THE SUGGESTED SOURCE(S) OF SUPPLY
HEREON IS NOT TO BE CONSTRUED AS A GUARANTEE OF
PRESENT OR CONTINUED AVAILABILITY AS A SOURCE OF
SUPPLY FOR THE ITEM(S).

REVISIONS


REVISION	DESCRIPTION	DATE(YEAR-MM-DA)	APPROVED
X0	ECP K1803005	2019-MM-DD	CWH

SPECIFICATIONS

TYPE	HOSE ASSEMBLY, FEMALE 37° SWIVEL TO MALE STRAIGHT THREAD
HOSE LENGTH (L)	30 FEET
HOSE OUTER DIAMETER	1.20" NOMINAL
HOSE INNER DIAMETER	0.75" NOMINAL
HOSE MAXIMUM WORKING PRESSURE	4,000 PSI
FEMALE CONNECTION TYPE	JIC 37° SWIVEL, CRIMPED
FEMALE THREAD SIZE	1-1/16"X12

SUGGESTED SOURCE(S) OF SUPPLY

PART NO.	VENDOR		VENDOR PART NO.
	ADDRESS	CAGE CODE	
11E421925	PARKER-HANNIFIN CORPORATION 220 ROBERTS CUT OFF RD FORT WORTH, TX 76114-3605	98441	F7720606121212360
	NOTT COMPANY DIV FLUID POWER 1005 11TH ST MILAN, IL 61264-2244 PH: (651) 415-3501	3UZE1	F7720606121212360

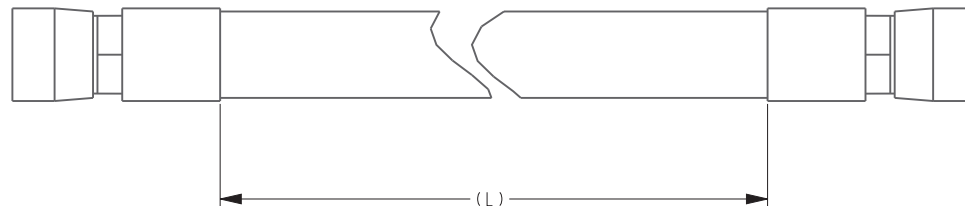

THIS DRAWING WAS GENERATED FROM A SOLID MODEL
AND IS CAD MAINTAINED. CHANGES SHALL BE
INCORPORATED BY THE DESIGN ACTIVITY.

VENDOR ITEM CONTROL DRAWING

PART NO. 11E421925

PMIC		DO NOT SCALE DRAWING		CONTRACT NUMBER		DESIGN ACTIVITY	
		UNLESS OTHERWISE SPECIFIED DIMENSIONS ARE IN INCHES		CONTRACTOR		US ARMY COMBAT CAPABILITIES DEVELOPMENT COMMAND ARMAMENTS CENTER ROCK ISLAND, ILLINOIS 61299-7300	
MECHANICAL PROPERTIES		TOLERANCE ON ANGLES $\pm 1^\circ$ 2 PLACE DECIMALS $\pm .03$ 3 PLACE DECIMALS $\pm .010$		DRAWN BY K. ROESER	DATE(YEAR-MM-DA) 2019-03-07	HOSE, FEMALE TO FEMALE, 37° SWIVEL ENDS	
YP		THIRD ANGLE PROJECTION		CHECKER B. VERMULM	ENGINEER K. ROESER		
TS				ENGINEER	QUALITY ENGINEER		
EL2				DRAWING APPROVAL V. VONDERA (YEAR-MM-DD)		SIZE C	DAI 59678
RA		11E421400	FRS	DESIGN APPROVAL C. HANEY (YEAR-MM-DD)		DWG NO. 11E421925	
BH		NEXT ASSY	USED ON			SCALE 3/4	UNIT WT.
RH		APPLICATION				SHEET 1 OF 1	

DISTRIBUTION STATEMENT A.
APPROVED FOR PUBLIC RELEASE;
DISTRIBUTION IS UNLIMITED.