


DRAWING: \\A\pos Group\ Vance AFBI\Light_Simulation\Asbuilt_DWG\BUDG 542\56_VA06SEE-143.dwg
PLOT BY: treynolds

D


C

B


A

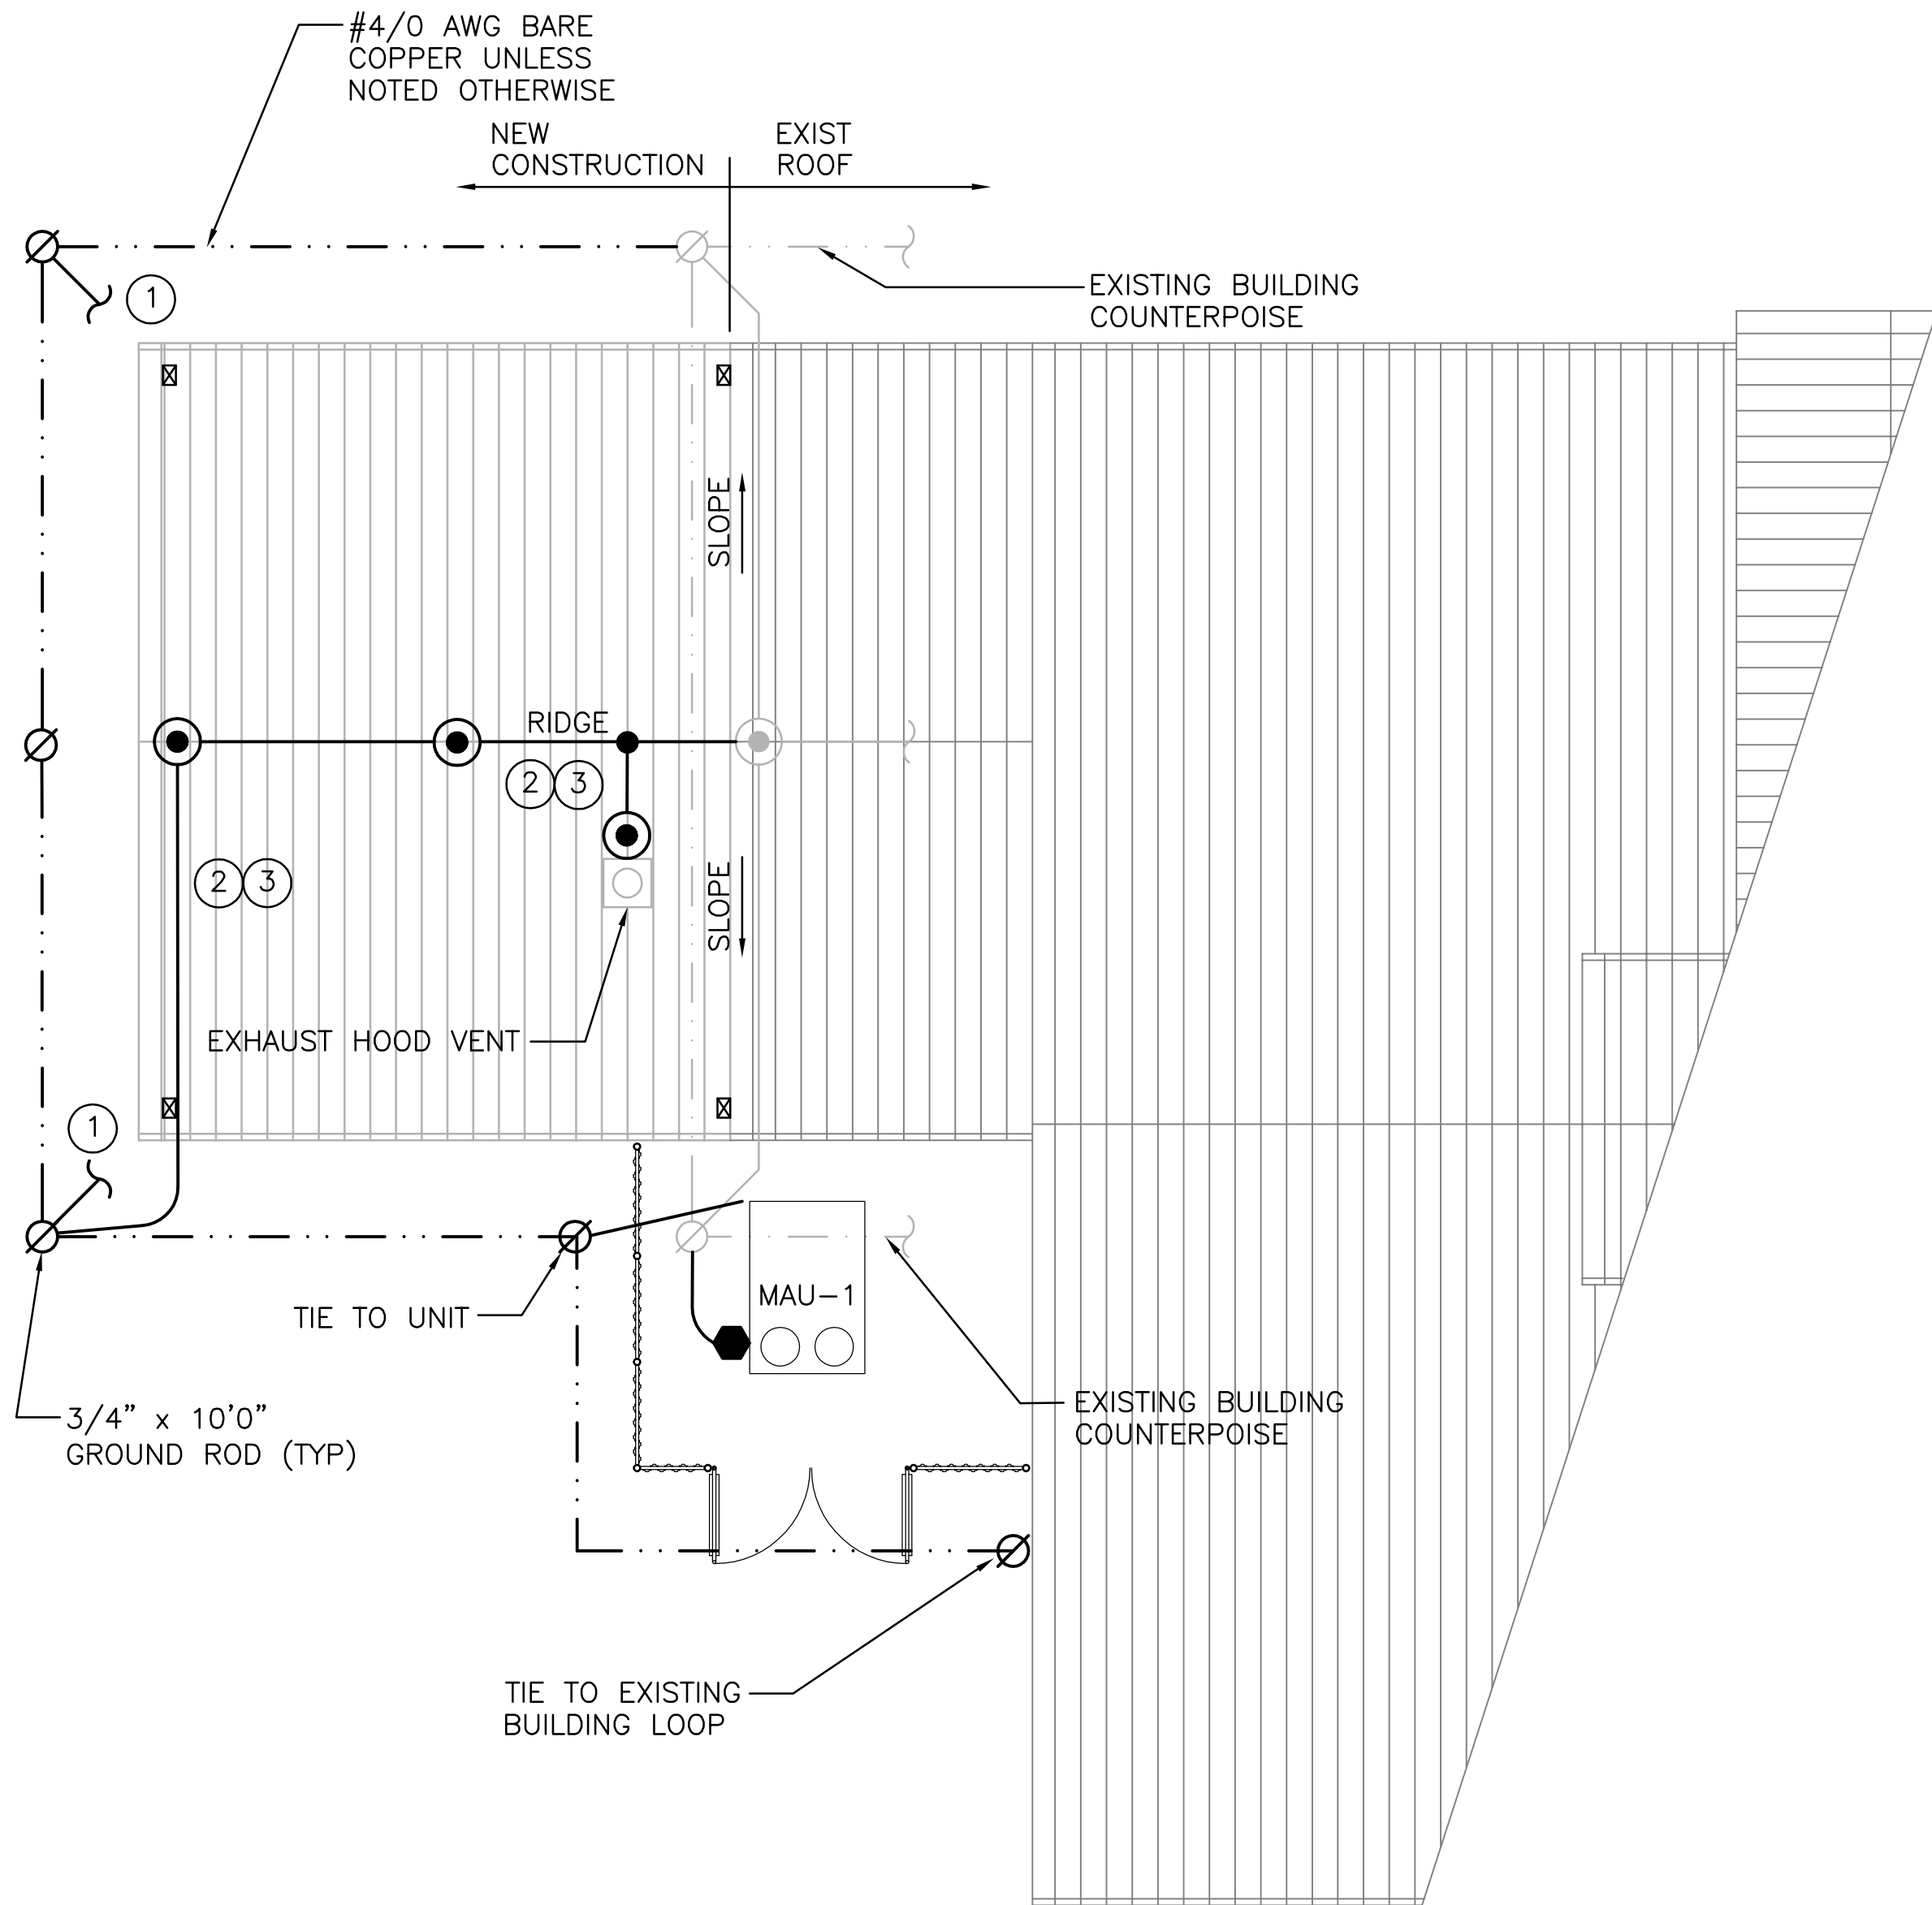

LIGHTNING PROTECTION AND GROUNDING PLAN
SCALE: 1/8"=1'-0"

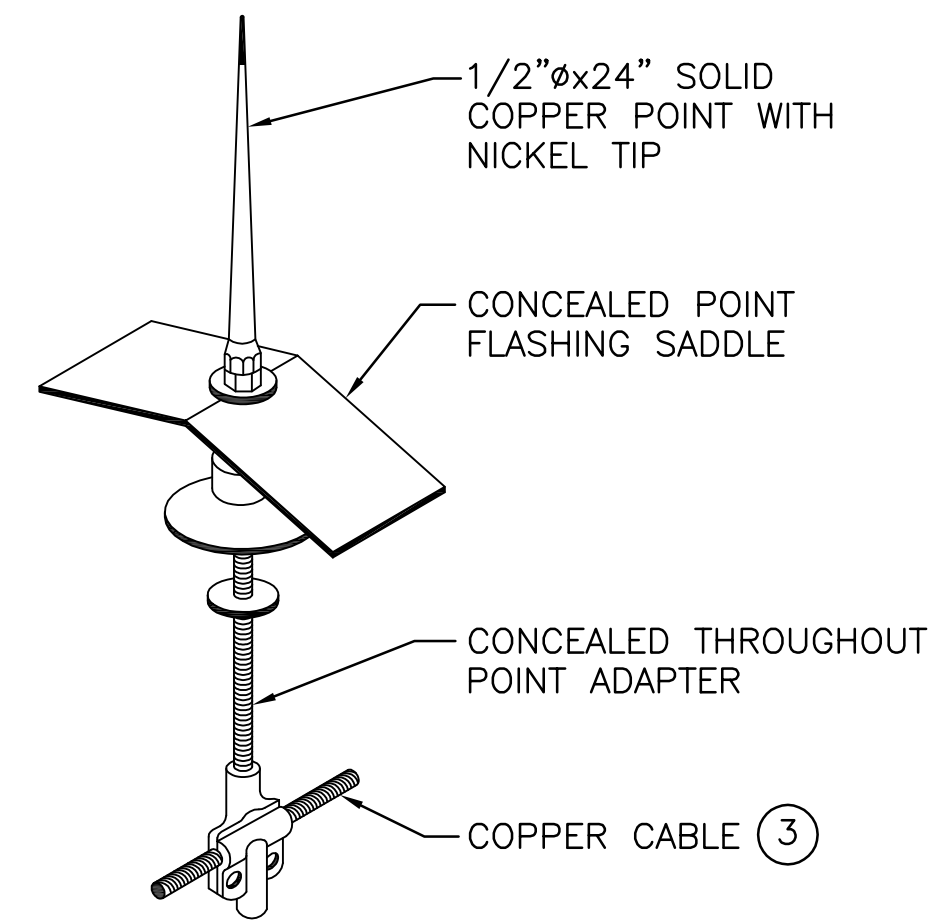

1 AIR TERMINAL DETAIL
E-143 E-143 SCALE: NTS

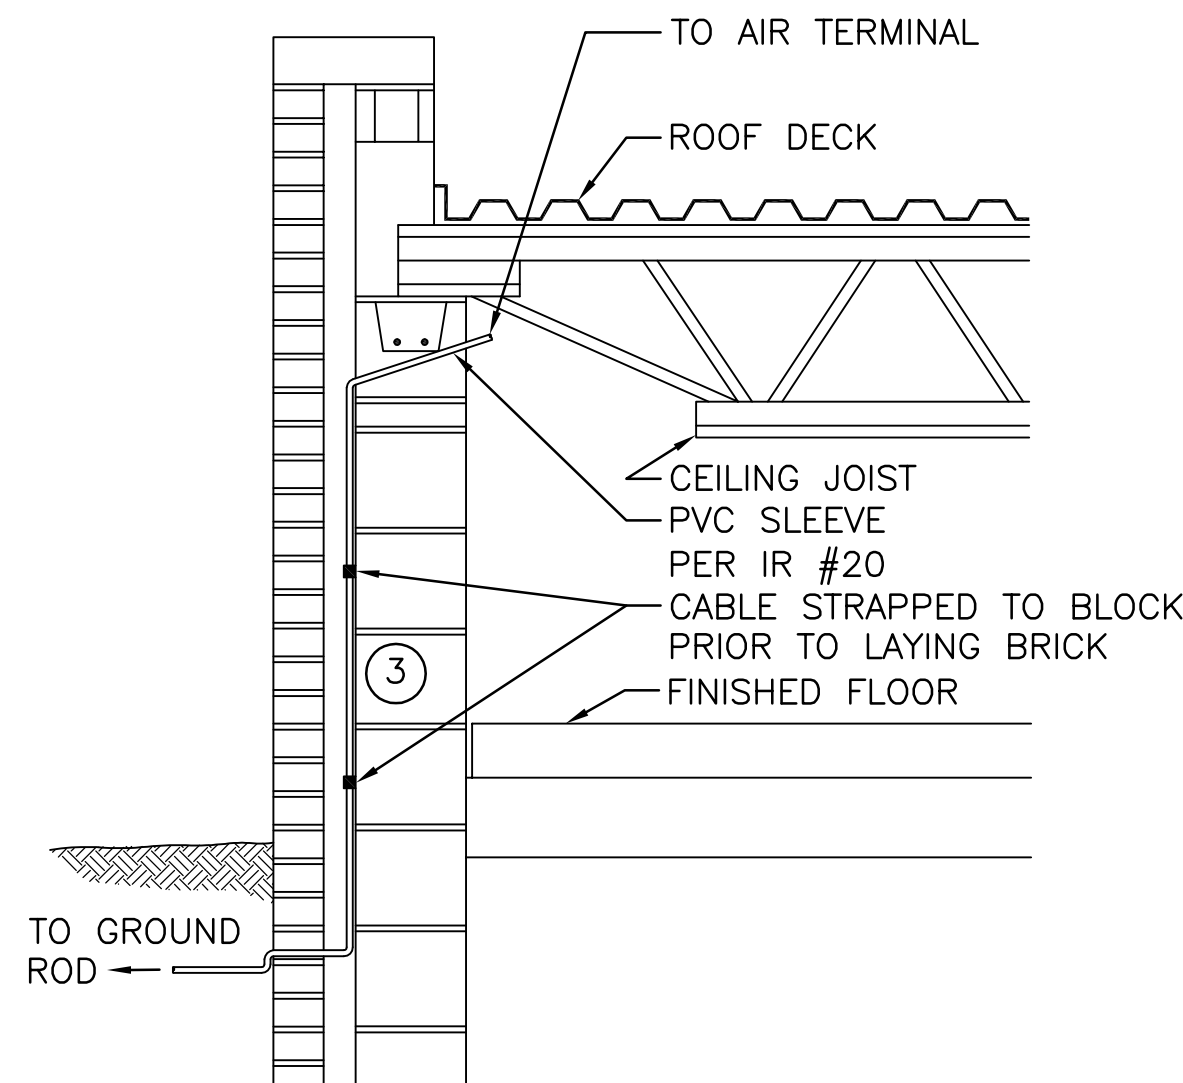


2 CABLE RUN DETAIL
E-143 E-143 SCALE: NTS

GENERAL NOTES:

- FOR LEGEND, ABBREVIATIONS, AND GENERAL NOTES SEE SHEET G060.
- EXERCISE CARE NOT TO DAMAGE EXISTING GROUND COUNTERPOISE WHEN EXCAVATING FOUNDATIONS AND EQUIPMENT PADS.

KEYED NOTES:

- BOND BUILDING COUNTERPOISE TO BUILDING STEEL AND CONCRETE ENCASED ELECTRODE (REBAR) WITH #4/0 BARE COPPER CABLE.
- RUN LIGHTNING PROTECTION DOWN CONDUCTOR CONCEALED BEHIND ROOFING OR BUILDING FACADE. SEE DETAIL 2, THIS SHEET.
- ALL LIGHTNING PROTECTION CABLE SHALL BE 187LB PER 1000FT COPPER CABLE MINIMUM.

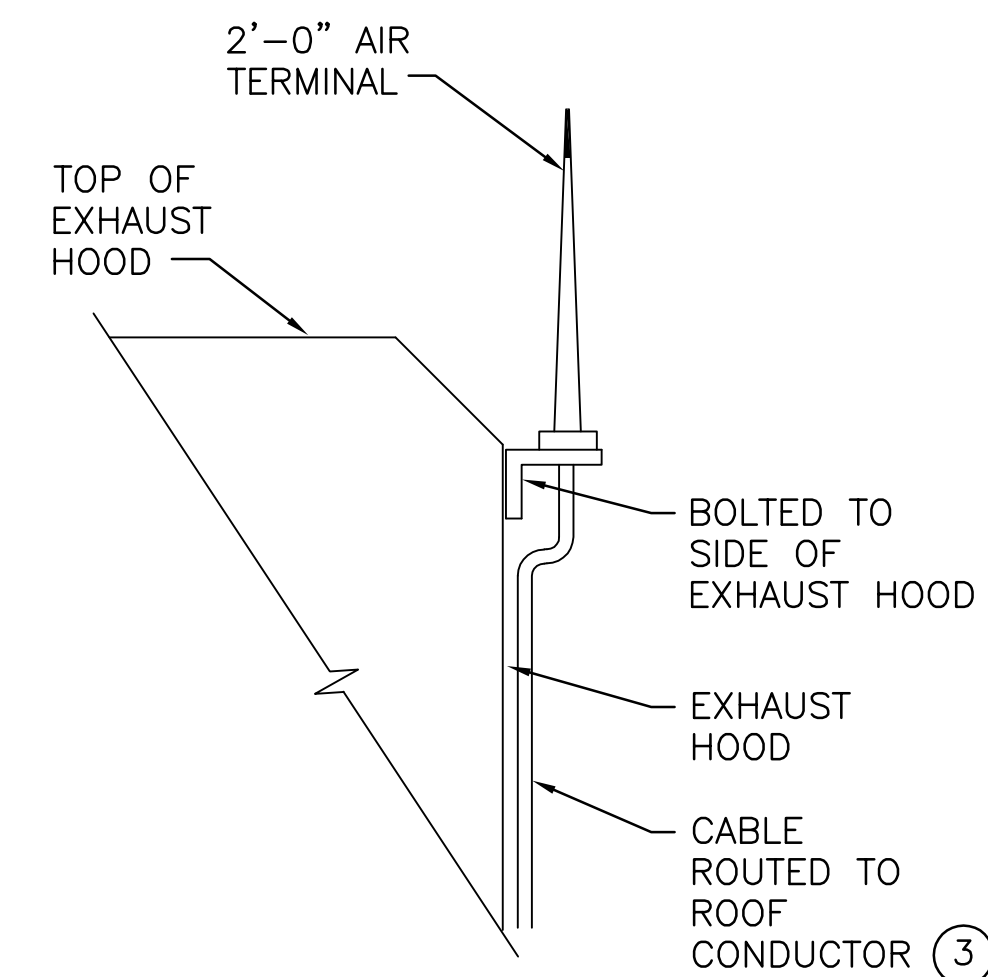

3 EXHAUST HOOD AIR TERMINAL
E-143 E-143 SCALE: NTS



SCALE: 1/8" = 1'-0"

RECORD DRAWING

																																																																																																																																																																																																																																																																																																																																																																																																																																																																																																																																																																																																																																																																																																																																																																																																																																																																																																																																																																																																																																																																																																																																																																																																																																																																																																																																																																																																																					</
--	--	----