



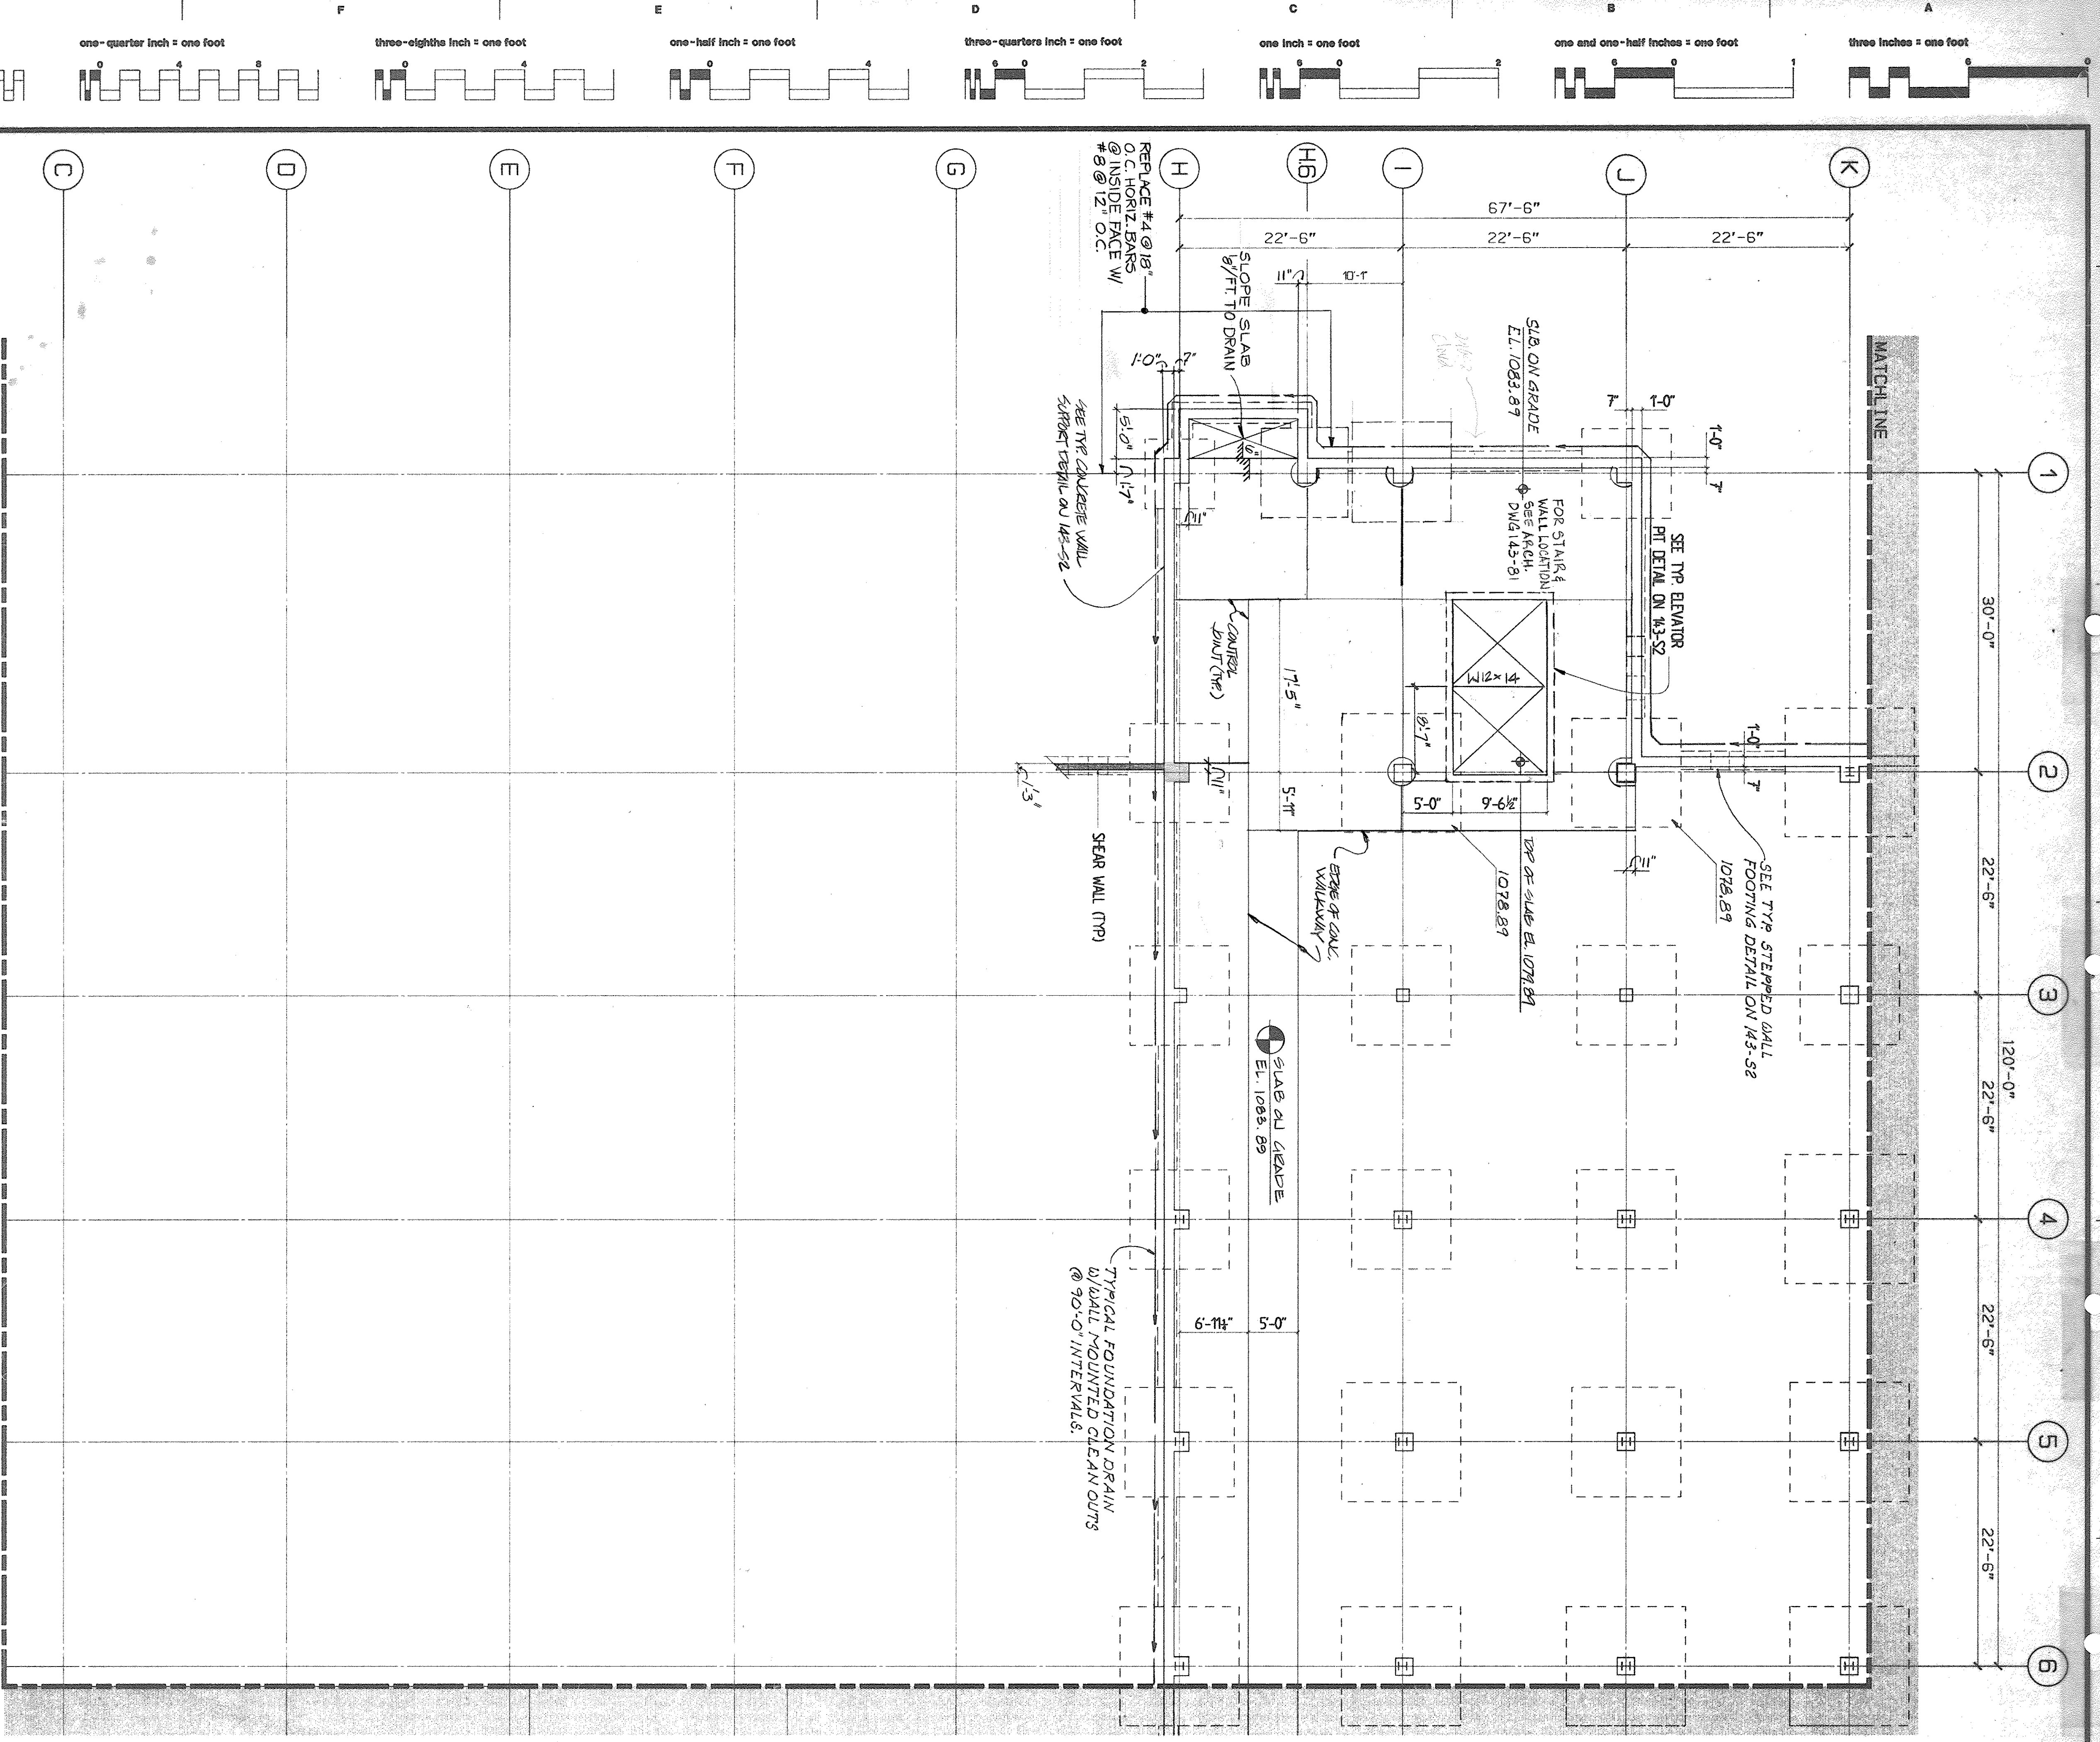

- NOTES:
1. TOP OF FOOTING ELEVATION 1082.89 TYPICAL UNLESS OTHERWISE NOTED.
 2. CRAWL SPACE IS TYPICALLY GRAVEL FILL 6" THICK. TOP OF GRAVEL ELEVATION 1083.89 TYPICAL UNLESS OTHERWISE NOTED.
 3. 5" SLAB ON GRADE OF REGULAR AGGREGATE CONCRETE. SEE TYPICAL DETAILS ON 143-51.
 4. SEE NOTE 4 ON 143-53.

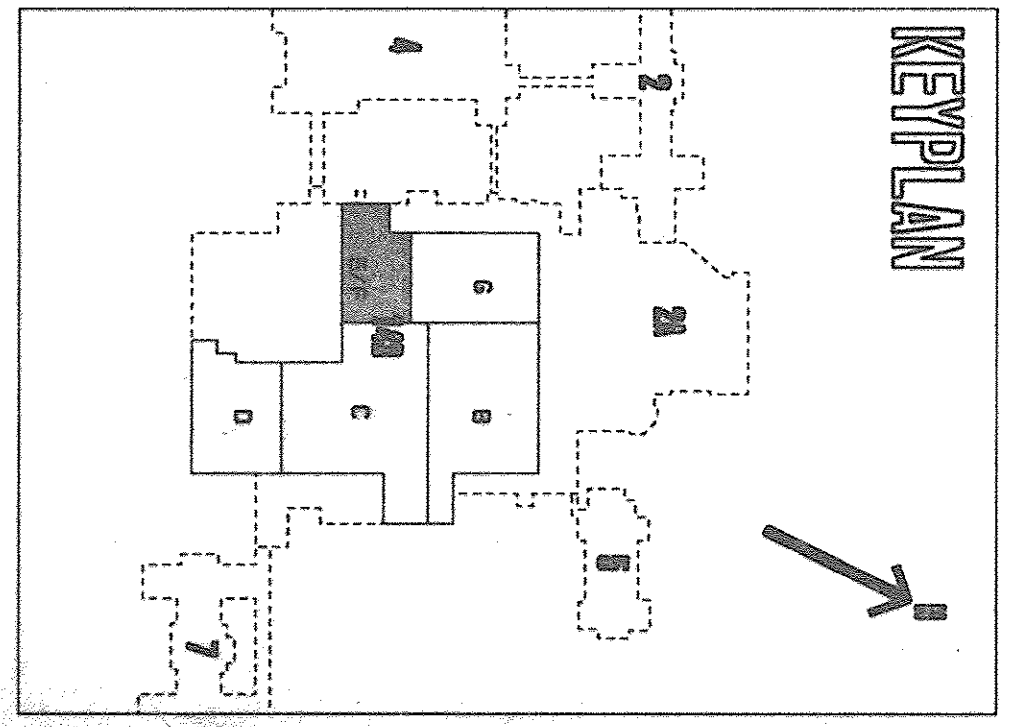

one-eighth inch = one foot

one-quarter inch = one foot

three-eighths inch = one foot

one-half inch = one foot

three-quarters inch = one foot

one inch = one foot

one and one-half inches = one foot

three inches = one foot

RECORD DRAWINGS

DATE: 11-11-88

BY: [Signature]

PROFESSIONAL SEAL OF VIRGINIA

D. ORING MYERS

No. 10131

WKR-TAG

ARCHITECTURE ENGINEERING PLANNING

A Licensed Professional Engineer, State of Virginia

Drawing Title

SUB-BASEMENT LEVEL

FOUNDATION PLAN ZONE E/F

Approved Project Director

APPROVED AREA PROJECT MANAGER

[Signature]

Project Title

OUTPATIENT/CLINICAL/NURSING

UNIT ADDITION AND ALTERATIONS

Building Number

143

Checked

KWC

Drawn

HS

Location

YAMC SALEM, VIRGINIA

Date

JAN 22 1988

Project No.

658-050

DRAWING NO.

143-56

Drawn by

HS

Veterans Administration