



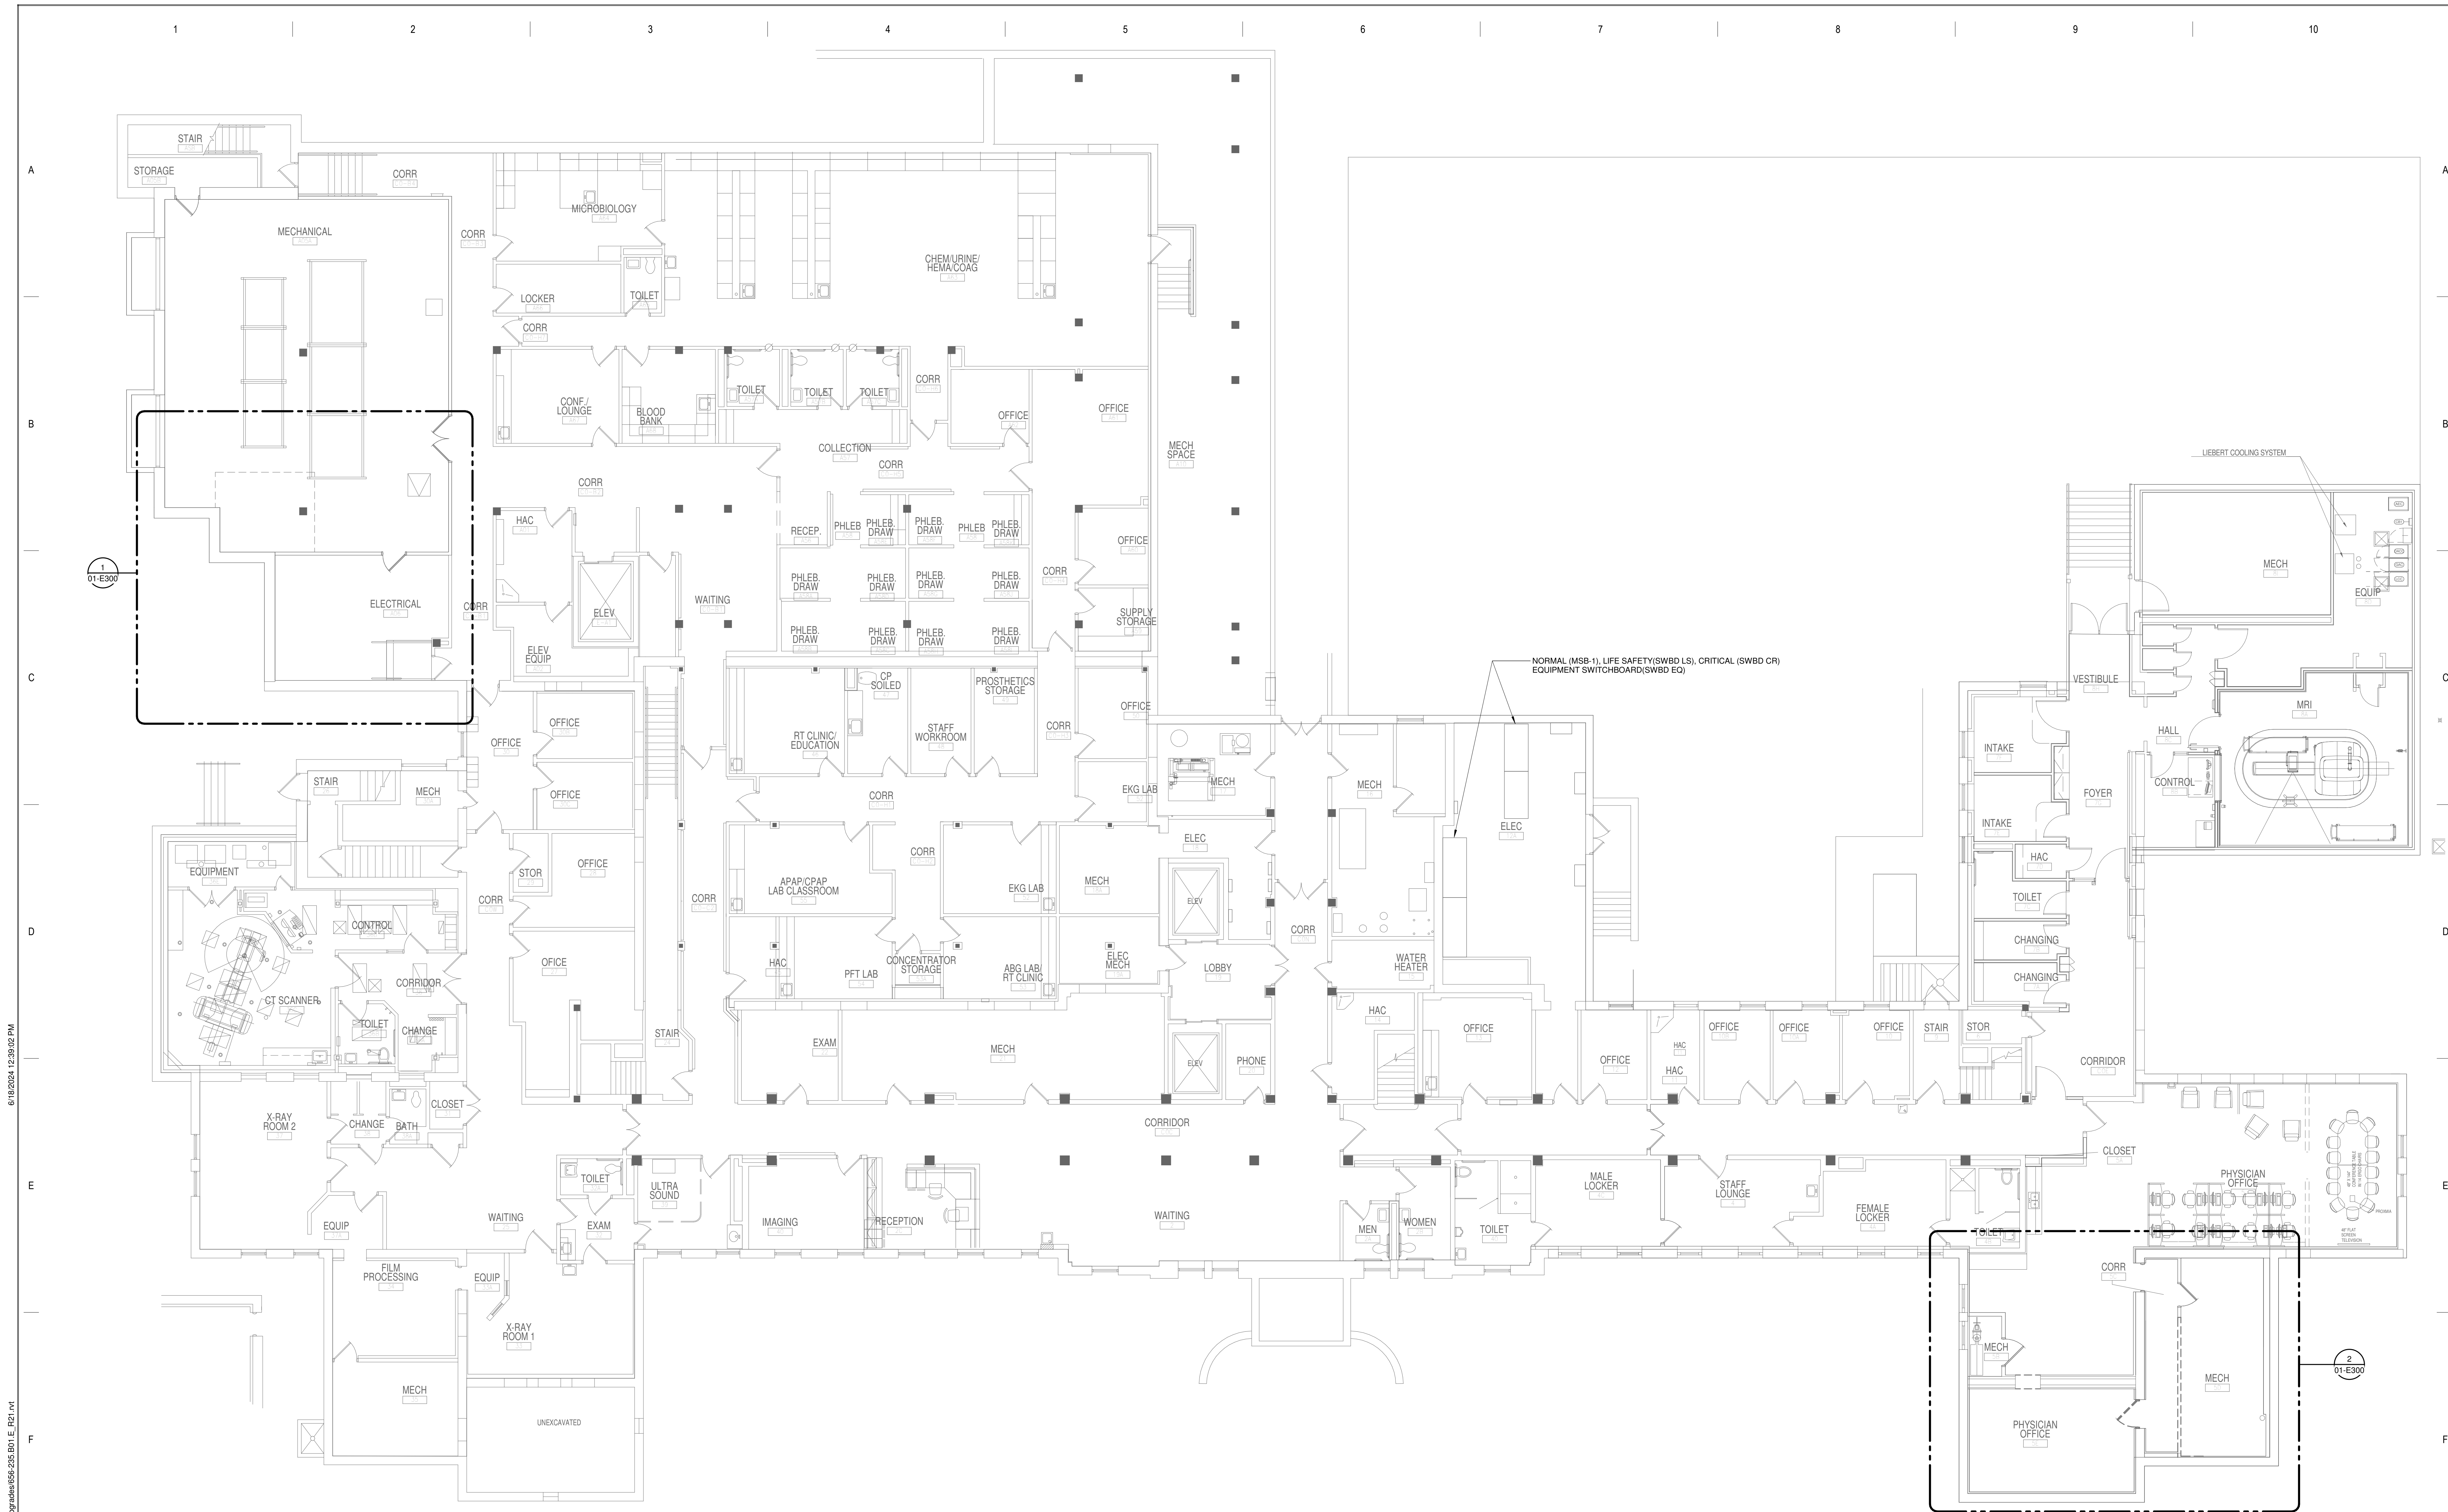


1 BASEMENT DEMOLITION - ELECTRICAL
1/8" = 1'-0"

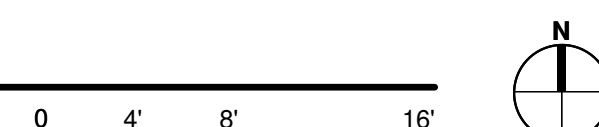

No	RECORD DOCUMENTS REVISION	06/21/ DATE

ARCHITECT/ENGINEER OF RECORD

13605 1st Ave. N. #100 Plymouth, MN 55441
P 763.412.4000 | F 763.412.4090 | ae-mn.com
Anderson Engineering of Minnesota, LLC | Proj # 16305

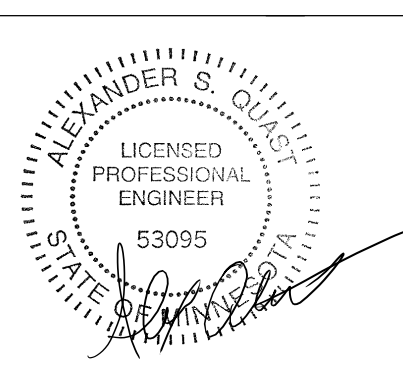


DRAWING TITLE

**BASEMENT DEMOLITION -
ELECTRICAL**

RECORD DOCUMENTS



6/18/2024 12:39:05 PM
BIM 360://21102.001 - VA St. Cloud EHM Infrastructure Upgrades-656-235 B01 E_R21.rvt

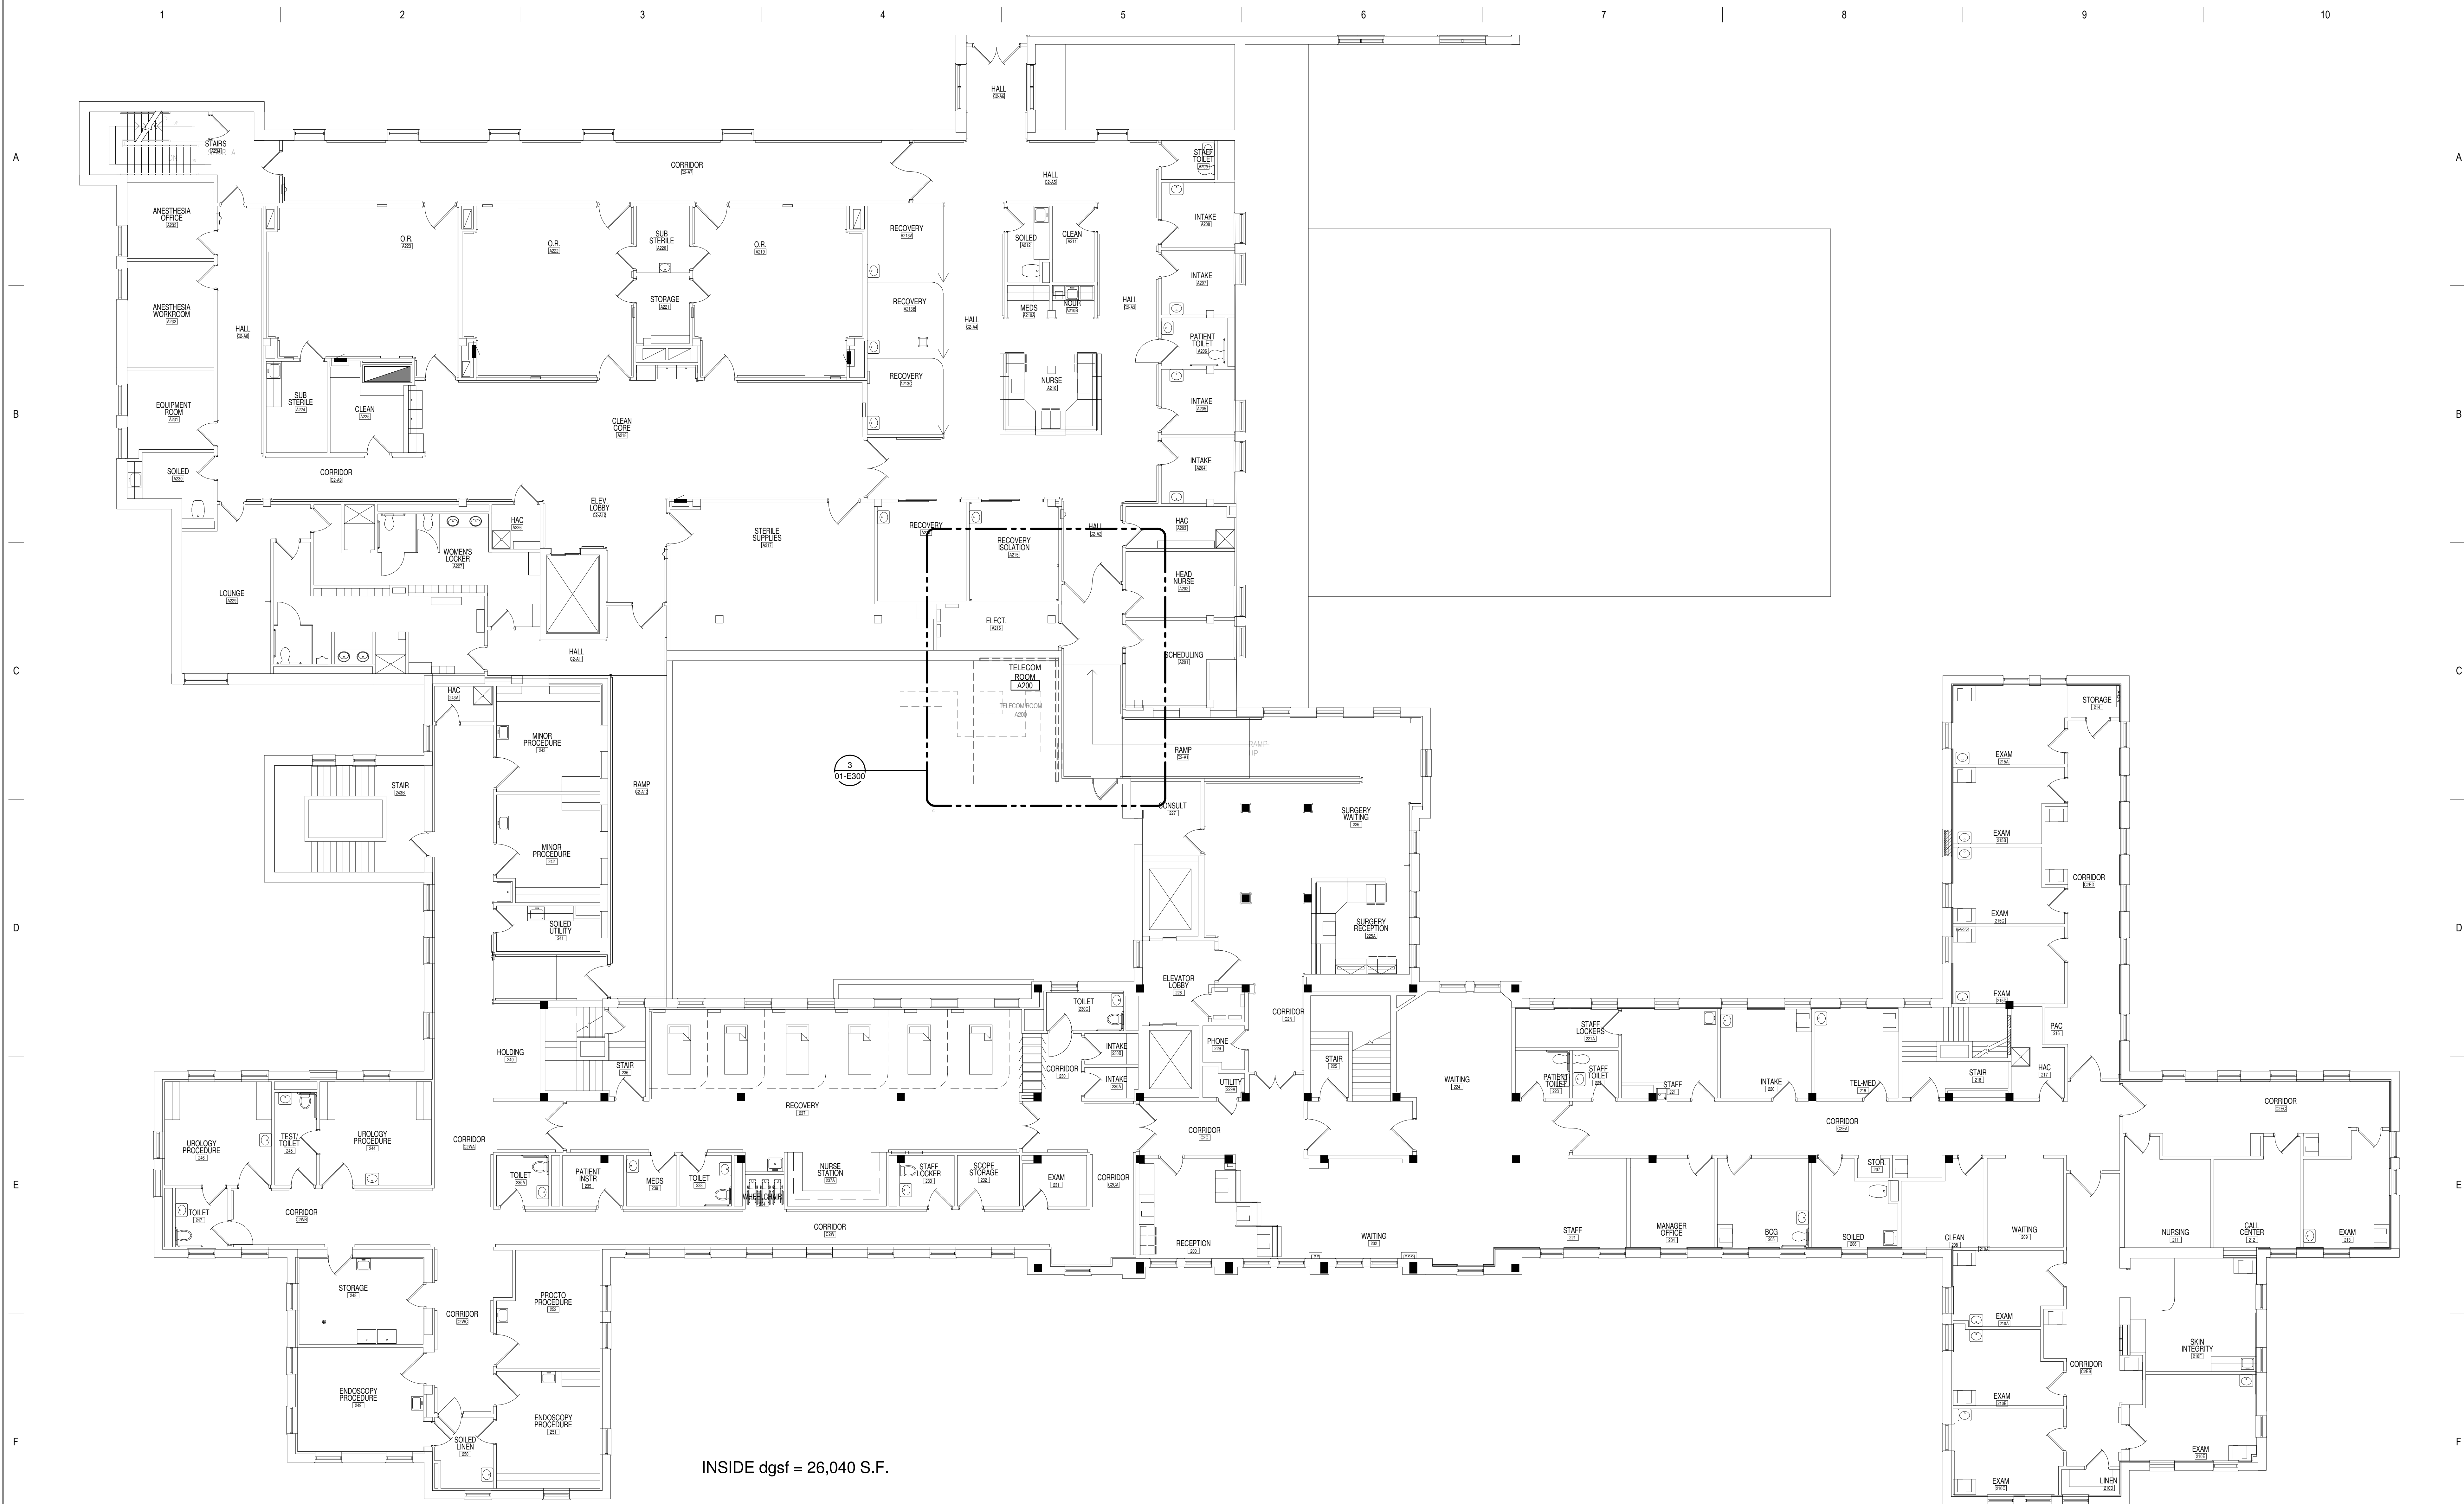

1 SECOND FLOOR DEMOLITION - ELECTRICAL
1/8" = 1'-0"

RECORD DOCUMENTS	REVISION	DATE
1		06/21/24

CONSULTANT

AST SES SPECIALIZED ENGINEERING SOLUTIONS

10360 Ellipse Circle
Omaha, NE 68134


Phone: 402.991.5520
www.specializedeng.com

ARCHITECT/ENGINEER OF RECORD

ANDERSON

13605 1st Ave. N. #100 Plymouth, MN 55441
P 763.412.4000 | F 763.412.4090 | ae-mn.com
Anderson Engineering of Minnesota, LLC | Proj # 16305

-RECORD DOCUMENT-
June 21, 2024
This Record Document has been prepared based on Designer of Record drawings with Contractor provided markings through the construction phase of the project at the direction of the VA. While the construction information is believed to be reliable, Architect/Engineer cannot assure its accuracy, and is not responsible for the accuracy of this Record Document. Those relying on this Record Document are advised to independently verify its accuracy before applying it for any purpose.

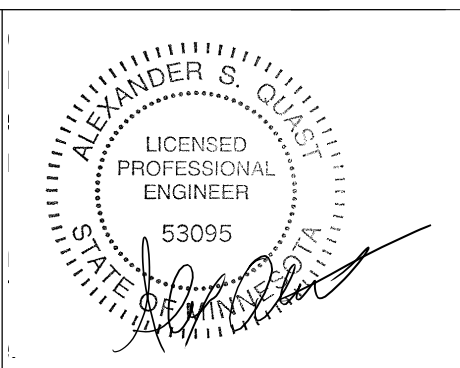


DRAWING TITLE
SECOND FLOOR DEMOLITION - ELECTRICAL

PROJECT FILE EHRM INFRASTRUCTURE UPGRADES	DATE 03/30/2022
BUILDING NO. 1	CHECKED BY Checker
LOCATION VA MEDICAL CENTER ST. CLOUD, MN 56303	DWG. OF FULLY SPRINKLERED


RECORD DOCUMENTS

VA

U.S. Department of Veterans Affairs
Veterans Health Administration
St. Cloud VA Health Care System

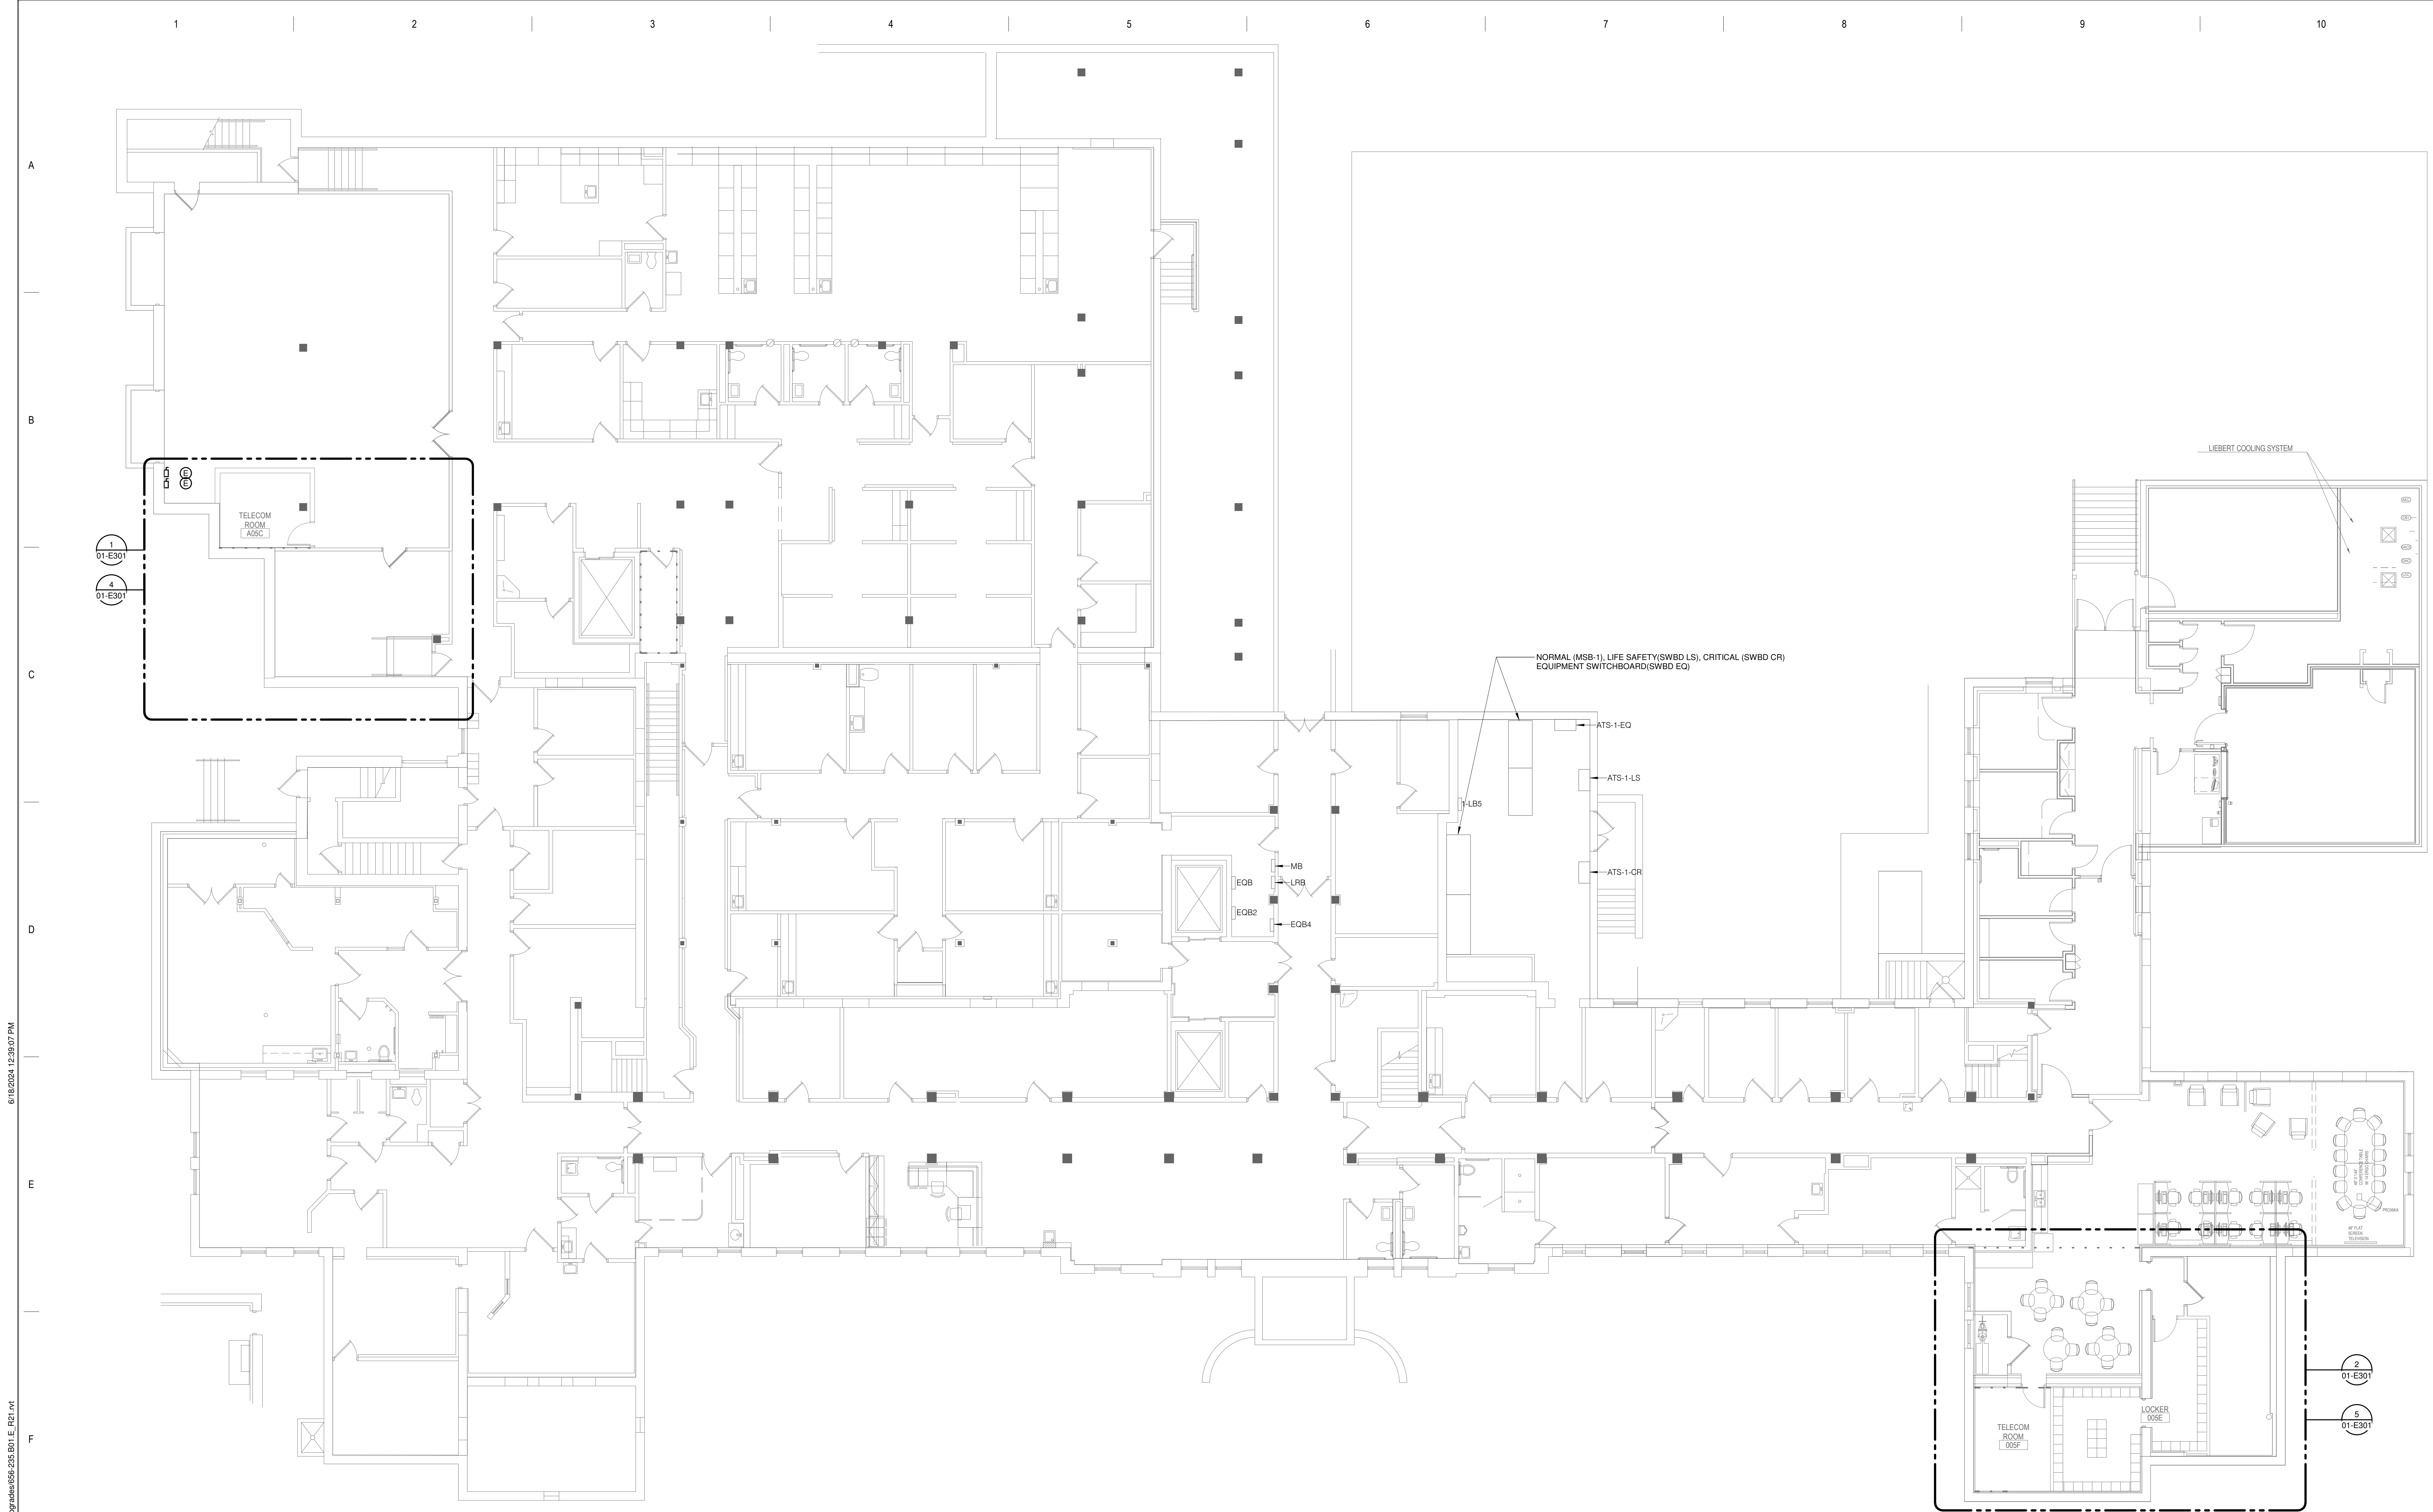

1 BASEMENT - ELECTRICAL
1/8" = 1'-0"

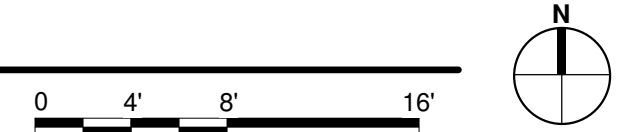

BIM 360://21102.001 - VA St Cloud EHRM Infrastructure Upgrades 656-235 B01 E_R21.rvt 6/18/2024 12:39:07 PM

RECORD DOCUMENTS		06/21/24
No.	REVISION	DATE

CONSULTANT



SPECIALIZED ENGINEERING SOLUTIONS

10360 Ellipse Circle
Omaha, NE 68134


Phone: 402.991.5530
www.specializedeng.com

ARCHITECT/ENGINEER OF RECORD

ANDERSON

13605 1st Ave. N. #100 Plymouth, MN 55441
P 763.412.4000 | F 763.412.4090 | ae-mn.com
Anderson Engineering of Minnesota, LLC | Proj # 16305

-RECORD DOCUMENT-
June 21, 2024
This Record Document has been prepared based on Designer of Record drawings with Contractor provided markups through the construction phase of the project at the direction of the VA. While the construction information is believed to be reliable, Architect/Engineer cannot assure its accuracy, and is not responsible for the accuracy of this Record Document. Those relying on this Record Document are advised to independently verify its accuracy before applying it for any purpose.

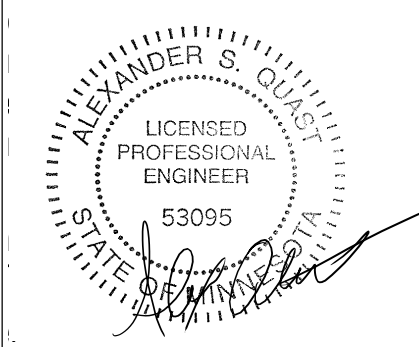

DRAWING TITLE
BASEMENT - ELECTRICAL

PROJECT FILE EHRM INFRASTRUCTURE UPGRADES	DATE 03/30/2022
PLOT SCALE	PROJECT NO. 656-21-235
BUILDING NO. 1	CHECKED BY TBD
LOCATION VA MEDICAL CENTER ST. CLOUD, MN 56303	DRAWN GJL
	DRAWING NO. 01-E200
	FULLY SPRINKLERED
	DWG. OF

RECORD DOCUMENTS



U.S. Department of Veterans Affairs
Veterans Health Administration
St. Cloud VA Health Care System

BIM 360/21102.001 - VA St Cloud EHRM Infrastructure Upgrades 656-235 B01 E_R2.rvt 6/18/2024 12:39:08 PM




KEYNOTES: **#**

1. PROVIDE ELECTRICAL CONNECTION TO CONDENSING UNIT, AS REQUIRED. COORDINATE FINAL LOCATION AND CONNECTION REQUIREMENTS WITH MECHANICAL.

1 FIRST FLOOR - ELECTRICAL

1/8" = 1'-0"

0 4' 8' 16'

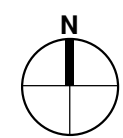

RECORD DOCUMENTS	REVISION	DATE
1		

CONSULTANT

AST SES SPECIALIZED ENGINEERING SOLUTIONS

10360 Ellison Circle
Omaha, NE 68134


Phone: 402.991.5520
www.specializedeng.com

ARCHITECT/ENGINEER OF RECORD

ANDERSON

13605 1st Ave. N. #100 Plymouth, MN 55441
P 763.412.4000 | F 763.412.4090 | ae-mn.com
Anderson Engineering of Minnesota, LLC | Proj # 16305


-RECORD DOCUMENT-
June 21, 2024
This Record Document has been prepared based on Designer of Record drawings with Contractor provided markings through the construction phase of the project at the direction of the VA. While the construction information is believed to be reliable, Architect/Engineer cannot assure its accuracy, and is not responsible for the accuracy of this Record Document. Those relying on this Record Document are advised to independently verify its accuracy before applying it for any purpose.

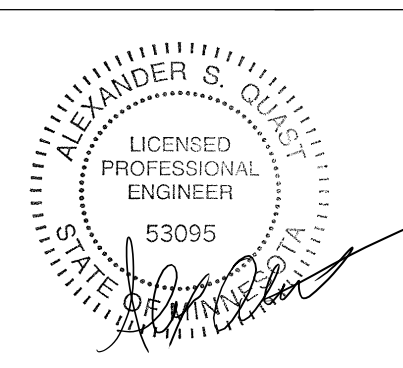


DRAWING TITLE
FIRST FLOOR - ELECTRICAL

PROJECT FILE EHRM INFRASTRUCTURE UPGRADES	DATE 03/30/2022
BUILDING NO. 1	PLOT SCALE 656-21-235
CHECKED BY TBD	DRAWN BY GJL
LOCATION VA MEDICAL CENTER ST. CLOUD, MN 56303	DRAWING NO. 01-E201
FULLY SPRINKLERED	DWG. OF

RECORD DOCUMENTS

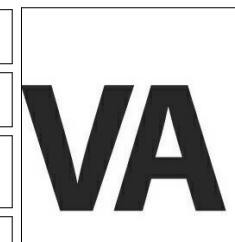


U.S. Department of Veterans Affairs
Veterans Health Administration
St. Cloud VA Health Care System

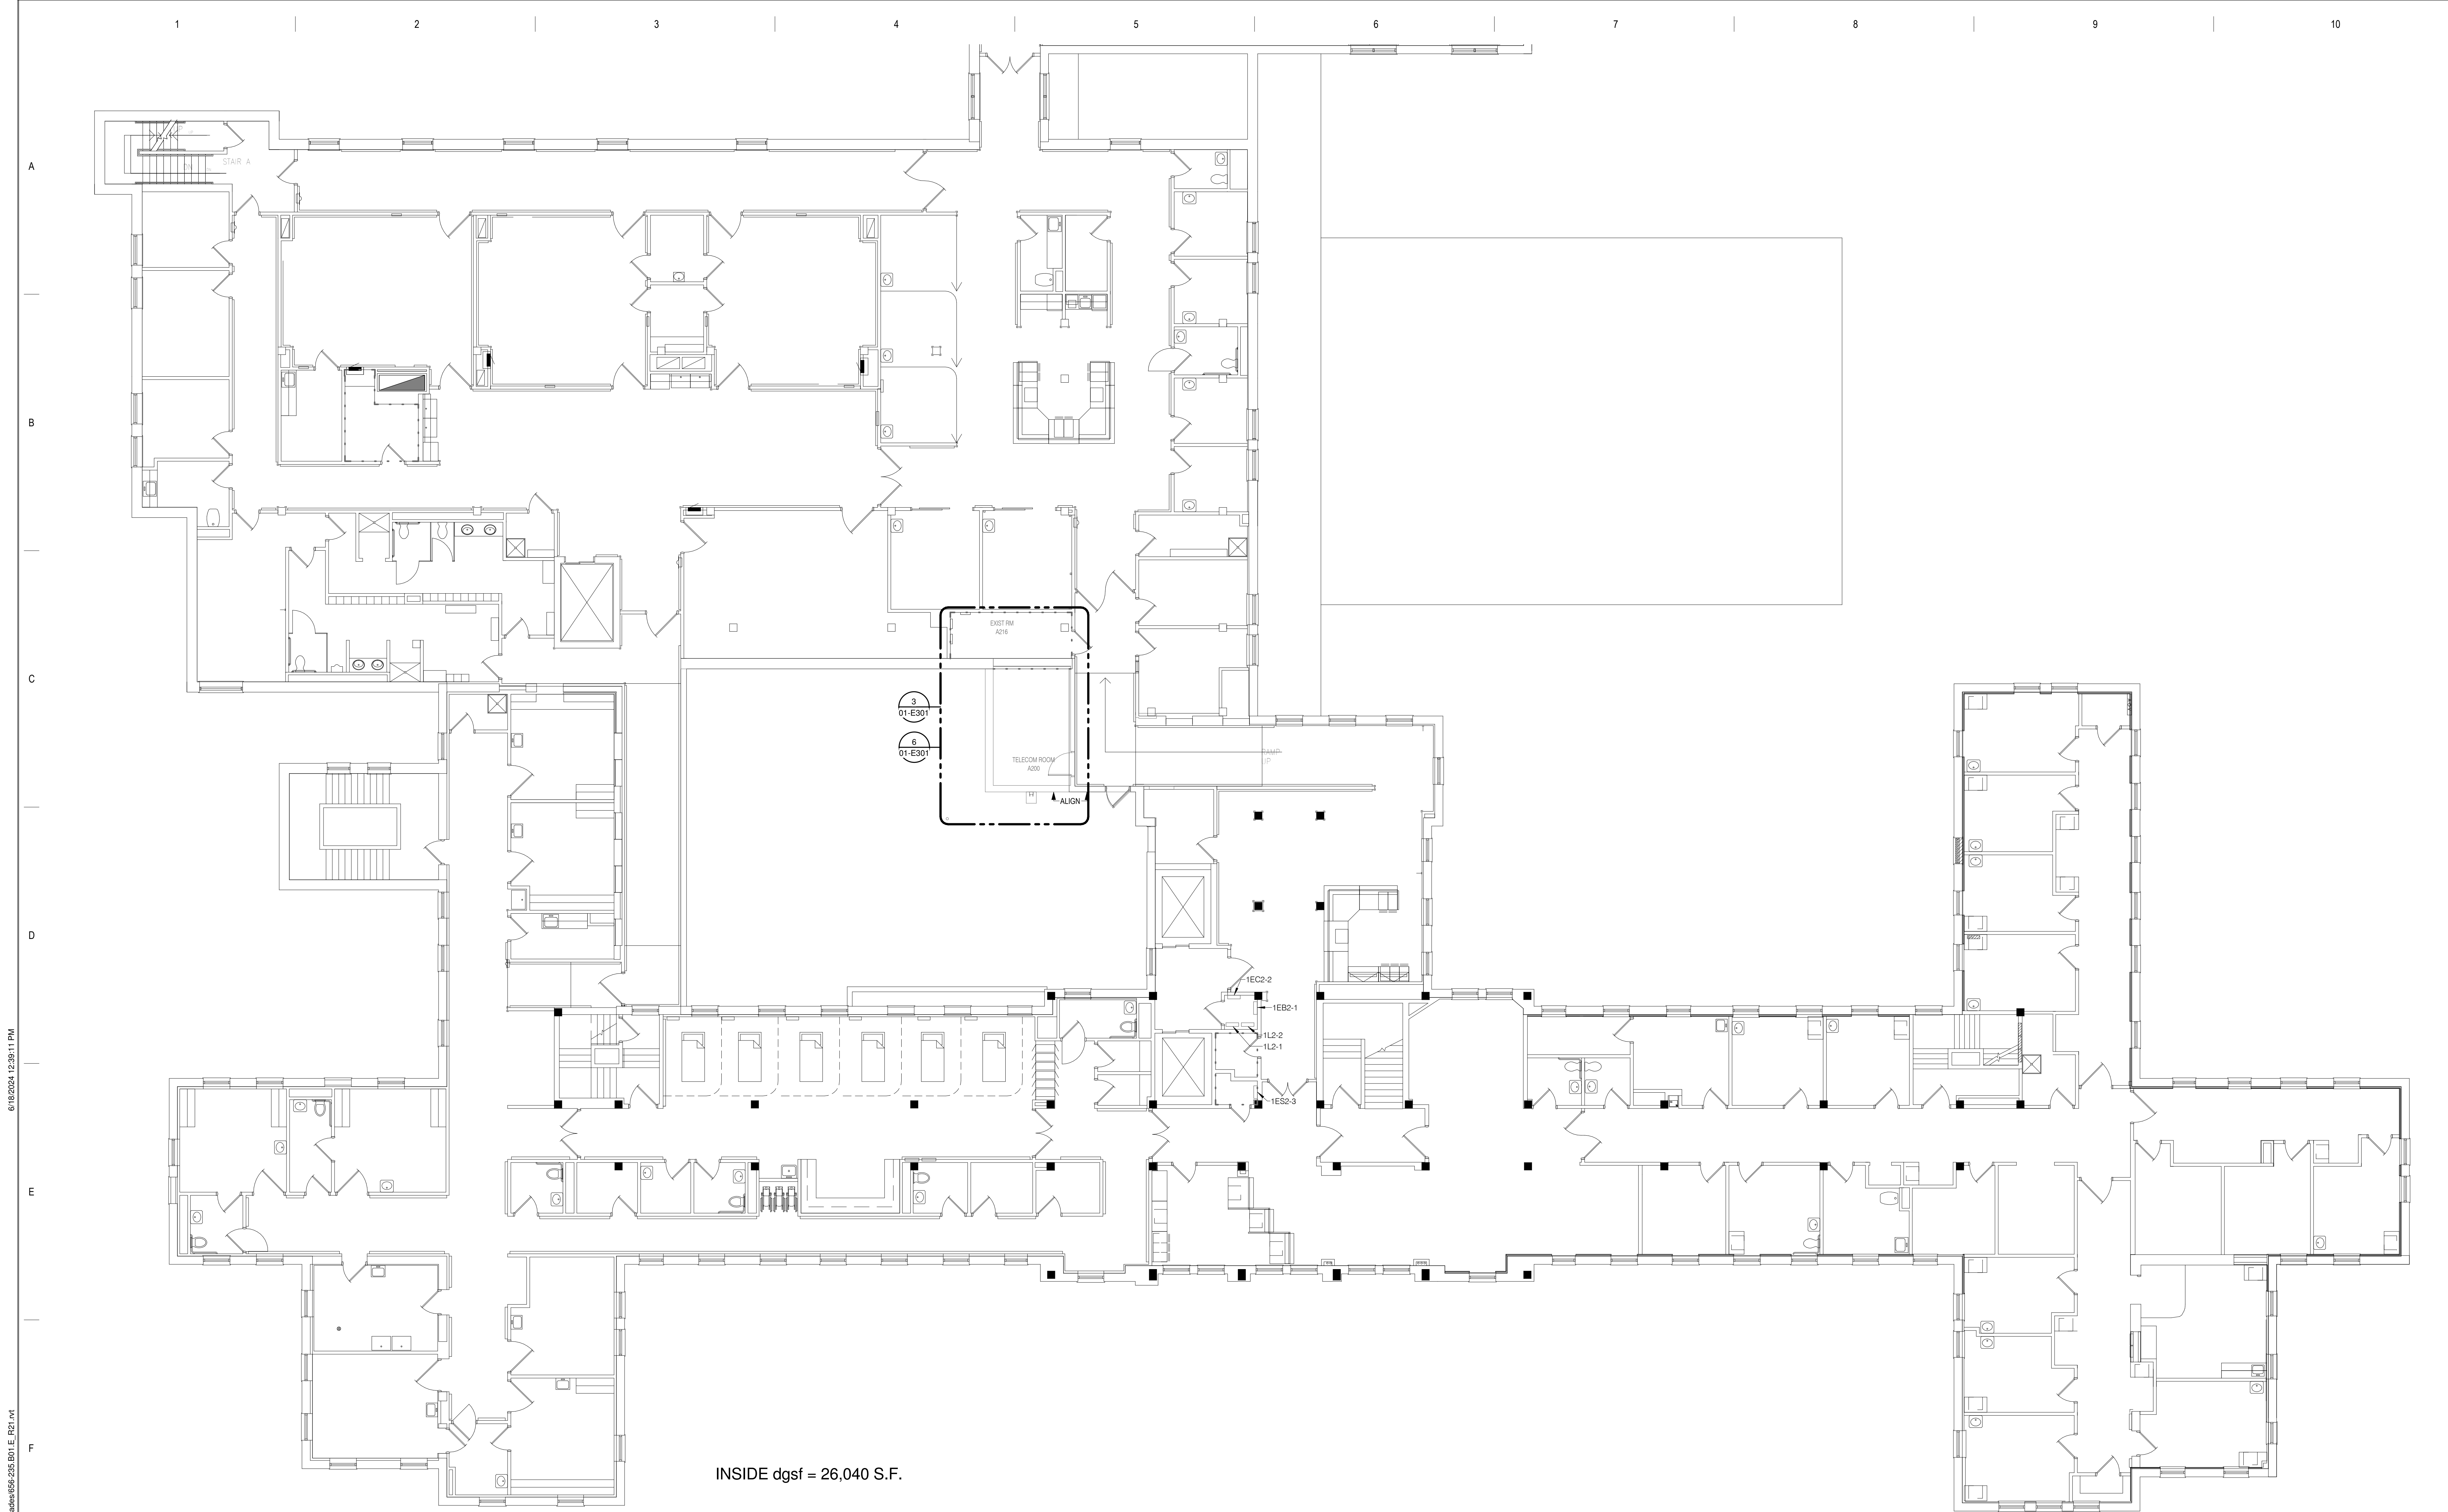

1 SECOND FLOOR - ELECTRICAL

1/8" = 1'-0"

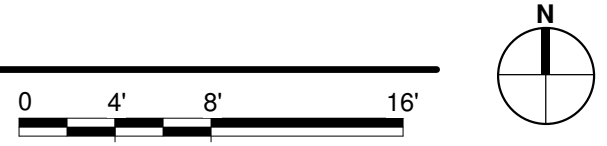

BIM 360://21102.001 - VA St Cloud EHRM Infrastructure Upgrades 656-235-B01.E_R21.rvt 6/18/2024 12:39:11 PM

RECORD DOCUMENTS		06/21/24
No.	REVISION	DATE

CONSULTANT



**SPECIALIZED
ENGINEERING
SOLUTIONS**

10360 Ellipse Circle
Omaha, NE 68134

Phone: 402.991.5520
www.specializedeng.com


ARCHITECT/ENGINEER OF RECORD



ANDERSON

13605 1st Ave. N. #100 Plymouth, MN 55441
P 763.412.4000 | F 763.412.4090 | ae-mn.com
Anderson Engineering of Minnesota, LLC | Proj # 16305

-RECORD DOCUMENT-
June 21, 2024
This Record Document has been prepared based on Designer of Record drawings with Contractor provided markups through the construction phase of the project at the direction of the VA. While the construction information is believed to be reliable, Architect/Engineer cannot assure its accuracy, and is not responsible for the accuracy of this Record Document. Those relying on this Record Document are advised to independently verify its accuracy before applying it for any purpose.

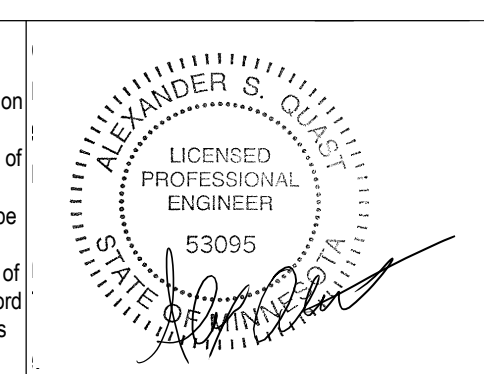

DRAWING TITLE
SECOND FLOOR - ELECTRICAL

PROJECT FILE EHRM INFRASTRUCTURE UPGRADES	DATE 03/30/2022
BUILDING No 1	PLOT SCALE
CHECKED BY TBD	RECORD NO. 656-21-235
DRAWN GJL	DRAWING NO. 01-E202
LOCATION VA MEDICAL CENTER ST. CLOUD, MN 56303	FULLY SPRINKLERED
DWG. OF	

RECORD DOCUMENTS



**U.S. Department
of Veterans Affairs**
Veterans Health
Administration
St. Cloud VA
Health Care System




KEYNOTES: (#)

1. PROVIDE ELECTRICAL CONNECTION TO CONDENSING UNIT, AS REQUIRED. COORDINATE FINAL LOCATION AND CONNECTION REQUIREMENTS WITH MECHANICAL.

1 ROOF - ELECTRICAL

1/8" = 1'-0"

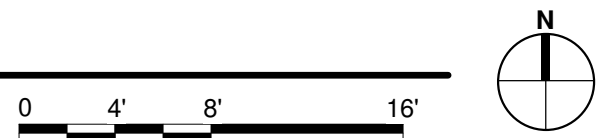

6/18/2024 12:39:13 PM
B:\360\2102\001 - VA St Cloud EHRM Infrastructure Upgrades\656-235 B01.E_R21.dwg

RECORD DOCUMENTS		06/21/24
No.	REVISION	DATE

CONSULTANT



**SPECIALIZED
ENGINEERING
SOLUTIONS**

10360 Ellipse Circle
Omaha, NE 68134


Phone: 402.991.5520
www.specializedeng.com

ARCHITECT/ENGINEER OF RECORD

ANDERSON

13605 1st Ave. N. #100 Plymouth, MN 55441
P 763.412.4000 | F 763.412.4090 | ae-mn.com
Anderson Engineering of Minnesota, LLC | Proj # 16305

-RECORD DOCUMENT-
June 21, 2024
This Record Document has been prepared based on Designer of Record drawings with Contractor provided markups through the construction phase of the project at the direction of the VA. While the construction information is believed to be reliable, Architect/Engineer cannot assure its accuracy, and is not responsible for the accuracy of this Record Document. Those relying on this Record Document are advised to independently verify its accuracy before applying it for any purpose.

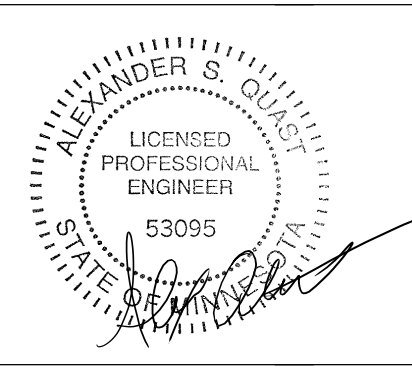

DRAWING TITLE
ROOF - ELECTRICAL


PROJECT FILE EHRM INFRASTRUCTURE UPGRADES		DATE 03/30/2022
BUILDING No. 1		PLOT SCALE
CHECKED BY TBD	DRAWN GJL	PROJECT NO. 656-21-235
LOCATION VA MEDICAL CENTER ST. CLOUD, MN 56303		DRAWING NO. 01-E204
FULLY SPRINKLERED		DWG. OF

RECORD DOCUMENTS




**U.S. Department
of Veterans Affairs**
Veterans Health
Administration
St. Cloud VA
Health Care System

6/18/2024 12:39:19 PM
B:\360\21\02\001 - VA St Cloud EHRM Infrastructure Upgrades\656-235-B01-E-R21.dwg

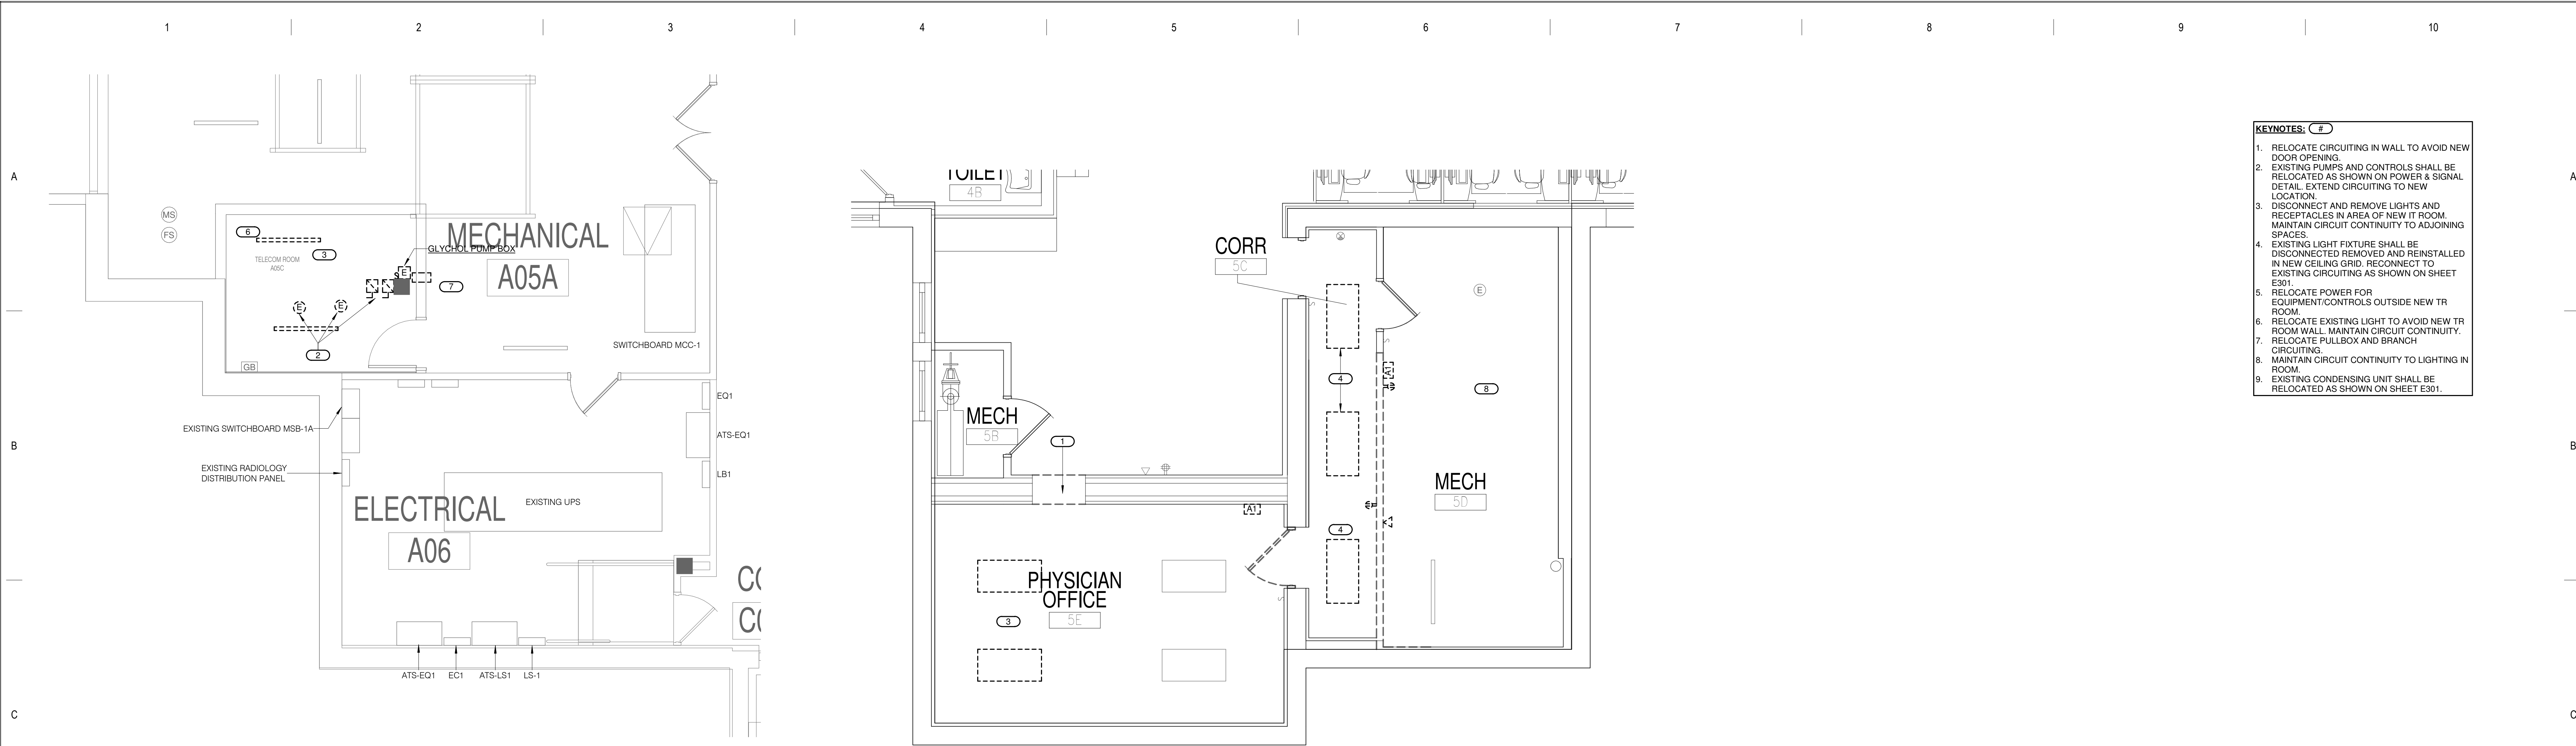

- KEYNOTES:**
1. RELOCATE CIRCUITING IN WALL TO AVOID NEW DOOR OPENING.
 2. EXISTING PUMPS AND CONTROLS SHALL BE RELOCATED AS SHOWN ON POWER & SIGNAL DETAIL. EXTEND CIRCUITING TO NEW LOCATION.
 3. DISCONNECT AND REMOVE LIGHTS AND RECEPTACLES IN AREA OF NEW IT ROOM. MAINTAIN CIRCUIT CONTINUITY TO ADJOINING SPACES.
 4. EXISTING LIGHT FIXTURE SHALL BE DISCONNECTED REMOVED AND REINSTALLED IN NEW CEILING GRID. RECONNECT TO EXISTING CIRCUITING AS SHOWN ON SHEET E301.
 5. RELOCATE POWER FOR EQUIPMENT/CONTROLS OUTSIDE NEW TR ROOM.
 6. RELOCATE EXISTING LIGHT TO AVOID NEW TR ROOM WALL. MAINTAIN CIRCUIT CONTINUITY.
 7. RELOCATE PULLBOX AND BRANCH CIRCUITING.
 8. MAINTAIN CIRCUIT CONTINUITY TO LIGHTING IN ROOM.
 9. EXISTING CONDENSING UNIT SHALL BE RELOCATED AS SHOWN ON SHEET E301.

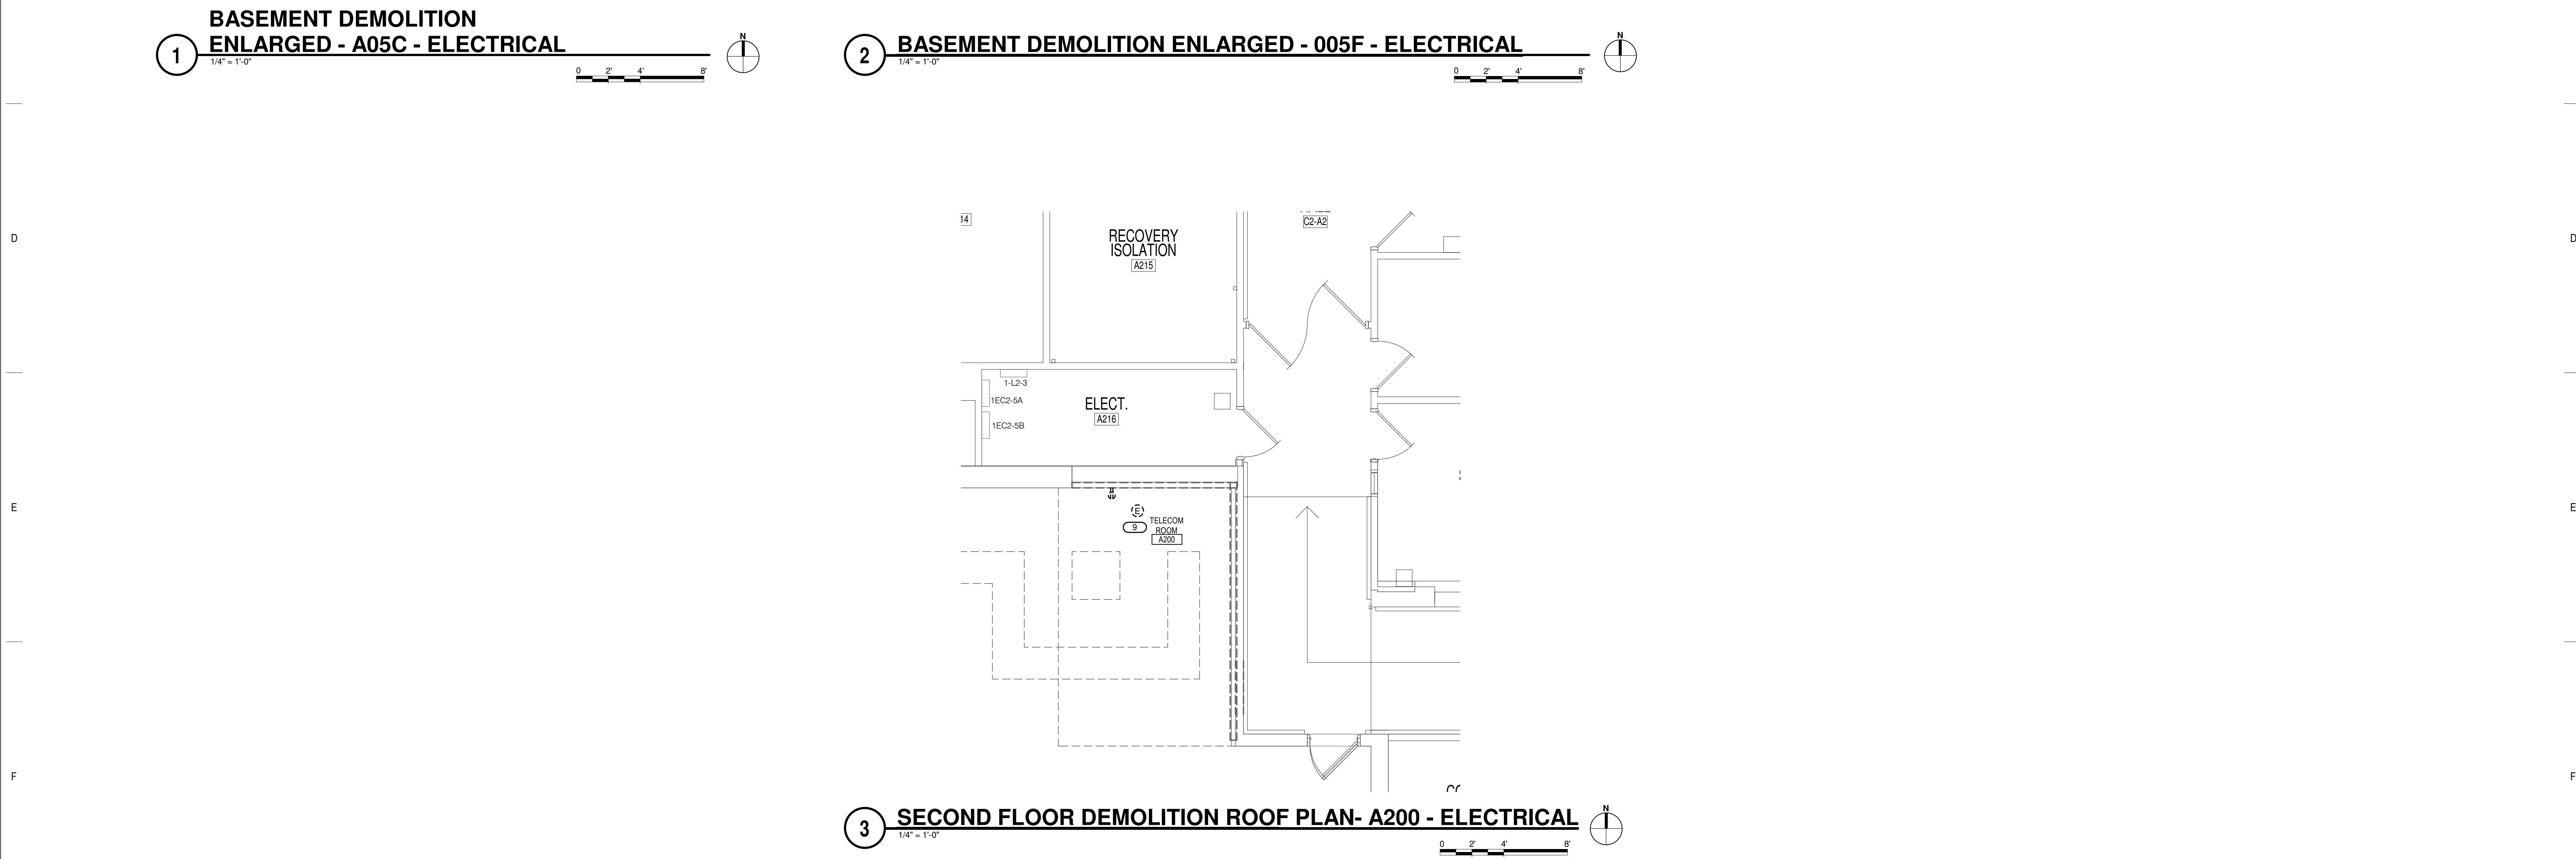

RECORD DOCUMENTS

PROJECT TITLE EHRM INFRASTRUCTURE UPGRADES	DATE 03/30/2022
BUILDING NO. 1	CHECKED BY TBD
DRAWN GJL	DRAWING NO. 01-E300
LOCATION VA MEDICAL CENTER ST. CLOUD, MN 56303	FULLY SPRINKLERED DWS OF

U.S. Department of Veterans Affairs
Veterans Health Administration
St. Cloud VA Health Care System

RECORD DOCUMENTS	06/21/24
REVISION	DATE
No	

CONSULTANT

AST SES SPECIALIZED ENGINEERING SOLUTIONS

10360 Ellipse Circle
Omaha, NE 68134


Phone: 402.991.5520
www.specializedeng.com

ARCHITECT/ENGINEER OF RECORD



ANDERSON

13605 1st Ave. N. #100 Plymouth, MN 55441
P 763.412.4000 | F 763.412.4090 | ae-mn.com
Anderson Engineering of Minnesota, LLC | Proj # 16305

-RECORD DOCUMENT-
June 21, 2024
This Record Document has been prepared based on Designer of Record drawings with Contractor provided markups through the construction phase of the project at the direction of the VA. While the construction information is believed to be reliable, Architect/Engineer cannot assure its accuracy, and is not responsible for the accuracy of this Record Document. Those relying on this Record Document are advised to independently verify its accuracy before applying it for any purpose.

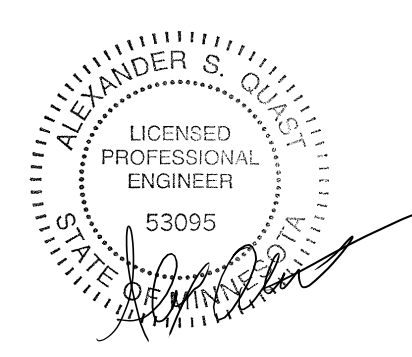

DRAWING TITLE
ELECTRICAL ENLARGED PLANS

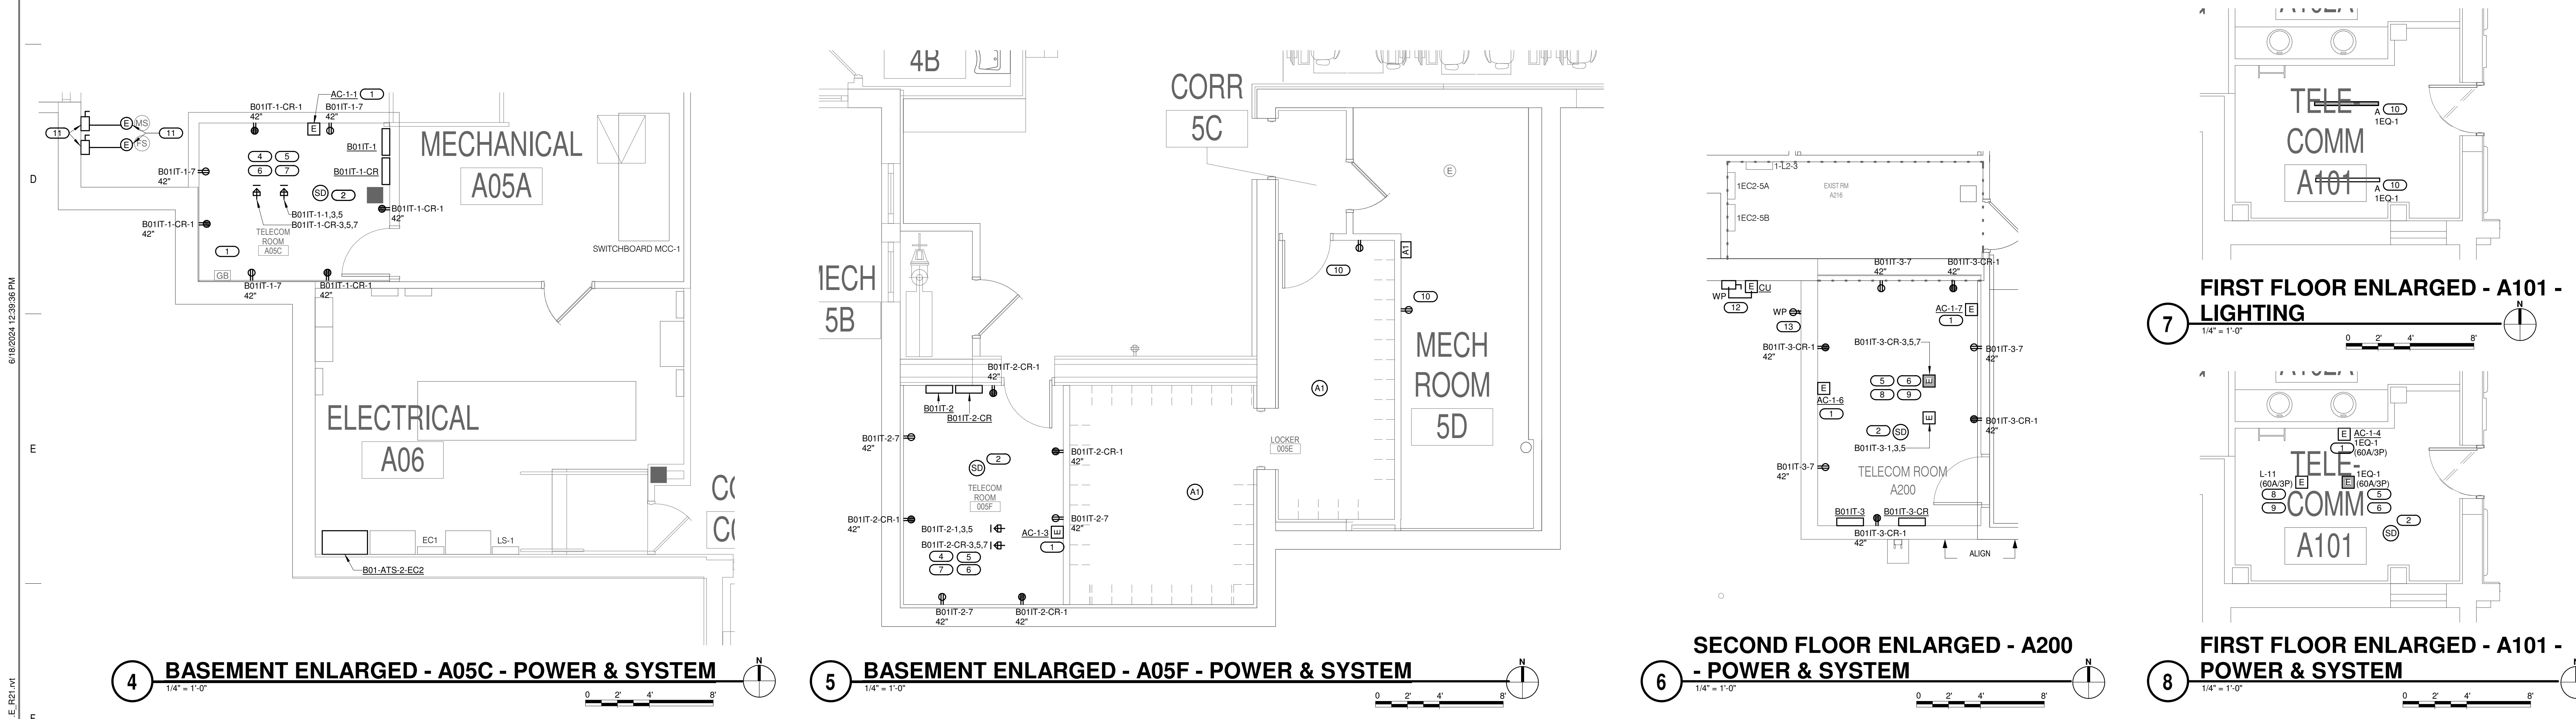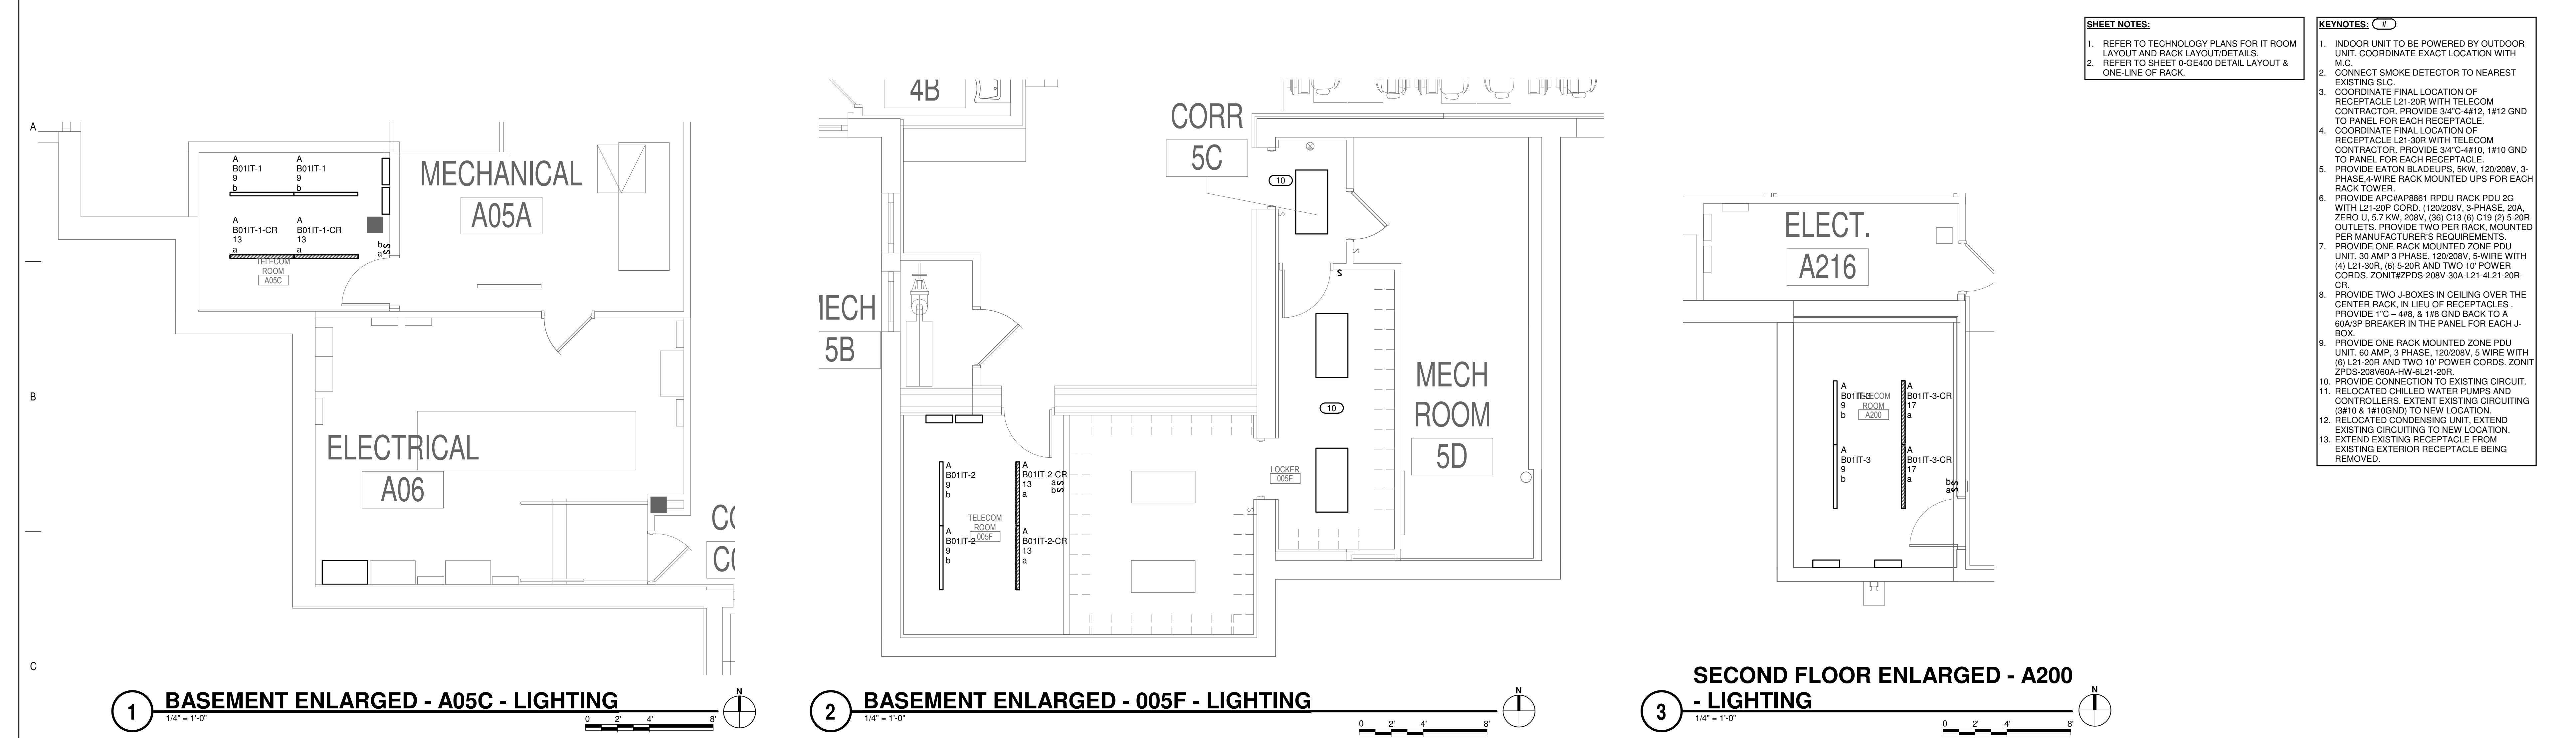

BIM 360://21102.001 - VA St Cloud EHRM Infrastructure Upgrades 656-235 B01.E_R21.rvt 6/18/2024 12:39:46 PM

6/18/2024 12:39:37 PM
BIM 360://2102.001 - VA St Cloud EHRM Infrastructure Upgrades-656-235-B01-E_R21.dwg

A

B

C

D

E

F

12345678910

MOUNTING: SURFACE
ENCLOSURE: NEMA PB 1
FED FROM: 150 A/3P @ 1EC2-5A
LOCATION: TELECOM ROOM A200

SOLID NEUTRAL
GROUND BUS

MAIN: 100 A MCB
VOLTS: 120/208 Wye
PHASE: 3
WIRE: 4
SCCR: 10 kA

NOTES: PROVIDE INTEGRAL ELECTRIC METER IN PANEL.

K E Y	CKT NO.	LOAD DESCRIPTION	OC PD AMPS	WIRE SIZE H N G	A	B	C	WIRE SIZE G N H	OC PD AMPS	LOAD DESCRIPTION	CKT NO.	K E Y		
1	TELECOM ROOM REC.	20 A	1	12	12	0.72	0			1	20 A	SPARE	2	
3	RACK CONNECTION	60 A	3	4						1	20 A	SPARE	4	
5										1	20 A	SPARE	6	
7										1	20 A	SPARE	8	
9	CU-1-6	15 A	2	12		12				1	20 A	SPARE	10	
11										1	20 A	SPARE	12	
13	CU-1-7	15 A	2	12		12	1	0			1	20 A	SPARE	14
15										1	20 A	SPARE	16	
17	LIGHTING	20 A	1	12	12			0.04	0		1	20 A	SPARE	18
19	CU-1-4	15 A	2	12		12	1	0			1	20 A	SPARE	20
21										1	20 A	SPARE	22	
23	SPARE	20 A	1					1	0		1	20 A	SPARE	24
25	SPARE	20 A	1				0	0			1	20 A	SPARE	26
27	SPARE	20 A	1				0	0			1	20 A	SPARE	28
29	SPARE	20 A	1				0	0			1	20 A	SPARE	30
Total Load:					7.72 kVA	8.00 kVA	6.04 kVA							
Total Amps:					66.48	68.81	50.37							

LOAD CLASSIFICATION

CONNECTED LOAD

DEMAND FACTOR

ESTIMATED DEMAND

TOTALS*

Lighting

0.044 kVA

100.00%

0.044 kVA

TOTAL CONNECTED LOAD:

21.76 kVA

Power

21 kVA

100.00%

21 kVA

TOTAL ESTIMATED DEMAND LOAD:

21.764 kVA

Receptacles

0.72 kVA

100.00%

0.72 kVA

TOTAL CONNECTED AMPS:

60.41 A

TOTAL ESTIMATED DEMAND AMPS:

60.4 A

*TOTAL DEMAND CALCS SUBTRACT ANY REDUNDANT LOAD AND THE SMALLER OF ANY NONCOINCIDENT HVAC LOADS. THIS CALC IS DONE AT EACH PANEL.

CIRCUIT KEY NOTES:

MOUNTING: SURFACE
ENCLOSURE: NEMA PB 1
FED FROM: 150 A/3P @ 1LB5
LOCATION:

SOLID NEUTRAL
GROUND BUS

MAIN: 100 A MCB
VOLTS: 120/208 Wye
PHASE: 3
WIRE: 4
SCCR: 10 kA

NOTES: PROVIDE INTEGRAL ELECTRIC METER IN PANEL.

K E Y	CKT NO.	LOAD DESCRIPTION	OC PD AMPS	WIRE SIZE H N G	A	B	C	WIRE SIZE G N H	OC PD AMPS	LOAD DESCRIPTION	CKT NO.	K E Y	
1	TELECOM ROOM REC.	20 A	1	12	12	0.72	0			1	20 A	SPARE	2
3	L21-30R RACK	30 A	3	10	10					1	20 A	SPARE	4
5										1	20 A	SPARE	6
7										1	20 A	SPARE	8
9	CU-1-1	15 A	2	12		12				1	20 A	SPARE	10
11										1	20 A	SPARE	12
13	LIGHTING	20 A	1	12	12	0.04	0			1	20 A	SPARE	14
15	SPARE	20 A	1							1	20 A	SPARE	16
17	SPARE	20 A	1							1	20 A	SPARE	18
19	SPARE	20 A	1			0	0			1	20 A	SPARE	20
21	SPARE	20 A	1							1	20 A	SPARE	22
23	SPARE	20 A	1				0	0		1	20 A	SPARE	24
25	SPARE	20 A	1				0	0		1	20 A	SPARE	26
27	SPARE	20 A	1				0	0		1	20 A	SPARE	28
29	SPARE	20 A	1				0	0		1	20 A	SPARE	30
Total Load:					3.76 kVA	4.00 kVA	4.00 kVA						
Total Amps:					31.37	33.64	33.64						

LOAD CLASSIFICATION

CONNECTED LOAD

DEMAND FACTOR

ESTIMATED DEMAND

TOTALS*

Lighting

0.044 kVA

100.00%

0.044 kVA

TOTAL CONNECTED LOAD:

11.76 kVA

Power

11 kVA

100.00%

11 kVA

TOTAL ESTIMATED DEMAND LOAD:

11.764 kVA

Receptacles

0.72 kVA

100.00%

0.72 kVA

TOTAL CONNECTED AMPS:

32.65 A

TOTAL ESTIMATED DEMAND AMPS:

32.7 A

*TOTAL DEMAND CALCS SUBTRACT ANY REDUNDANT LOAD AND THE SMALLER OF ANY NONCOINCIDENT HVAC LOADS. THIS CALC IS DONE AT EACH PANEL.

CIRCUIT KEY NOTES:

MOUNTING: SURFACE
ENCLOSURE: NEMA PB 1
FED FROM: 150 A/3P @ 1-LB5
LOCATION:

SOLID NEUTRAL
GROUND BUS

MAIN: 100 A MCB
VOLTS: 120/208 Wye
PHASE: 3
WIRE: 4
SCCR: 10 kA

NOTES: PROVIDE INTEGRAL ELECTRIC METER IN PANEL.

K E Y	CKT NO.	LOAD DESCRIPTION	OC PD AMPS	WIRE SIZE H N G	A	B	C	WIRE SIZE G N H	OC PD AMPS	LOAD DESCRIPTION	CKT NO.	K E Y	
1	TELECOM ROOM REC.	20 A	1	12	12	0.72	0			1	20 A	SPARE	2
3	L21-30R RACK	30 A	3	10	10					1	20 A	SPARE	4
5										1	20 A	SPARE	6
7										1	20 A	SPARE	8
9	CU-1-3	15 A	2	10		10				1	20 A	SPARE	10
11										1	20 A	SPARE	12
13	LIGHTING	20 A	1	12	12	0.04	0			1	20 A	SPARE	14
15	WP GFI REC.	20 A	1	12	12		0.18	0		1	20 A	SPARE	16
17	SPARE	20 A	1							1	20 A	SPARE	18
19	SPARE	20 A	1			0	0			1	20 A	SPARE	20
21	SPARE	20 A	1							1	20 A	SPARE	22
23	SPARE	20 A	1							1	20 A	SPARE	24
25	SPARE	20 A	1			0	0			1	20 A	SPARE	26
27	SPARE	20 A	1				0	0		1	20 A	SPARE	28
29	SPARE	20 A	1				0	0		1	20 A	SPARE	30
Total Load:					3.76 kVA	4.18 kVA	4.00 kVA						
Total Amps:					31.37	35.14	33.64						

LOAD CLASSIFICATION

CONNECTED LOAD

DEMAND FACTOR

ESTIMATED DEMAND

TOTALS*

Lighting

0.044 kVA

100.00%

0.044 kVA

TOTAL CONNECTED LOAD:

11.94 kVA

Power

11 kVA

100.00%

11 kVA

TOTAL ESTIMATED DEMAND LOAD:

11.944 kVA

Receptacles

0.9 kVA

100.00%

0.9 kVA

TOTAL CONNECTED AMPS:

33.15 A

TOTAL ESTIMATED DEMAND AMPS:

33.2 A

*TOTAL DEMAND CALCS SUBTRACT ANY REDUNDANT LOAD AND THE SMALLER OF ANY NONCOINCIDENT HVAC LOADS. THIS CALC IS DONE AT EACH PANEL.

CIRCUIT KEY NOTES:

CONSULTANT

AST SES SPECIALIZED
ENGINEERING
SOLUTIONS

10360 Ellison Circle
Omaha, NE 68134

Phone: 402.991.5520
www.specializedeng.com

	-RECORD DOCUMENT- June 21, 2024 This Record Document has been prepared based on the design information provided by the Designer of Record drawings with Contractor provided markups through the construction phase of the project at the direction of the VA. While the construction information is believed to be reliable, Architect/Engineer cannot assure its accuracy, and is not responsible for the accuracy of this Record Document. Those relying on this Record Document are advised to independently verify its accuracy before applying it for any purpose.
--	--

RECORD DOCUMENTS

BIM 360/12102.001 - VA St Cloud EHRM Infrastructure Upgrades 656-235.B01.M_R21.rvt 6/14/2024 8:45:16 AM

FIELD VERIFICATION NOTES


- THE HVAC CONTRACTOR SHOULD VISIT THE SITE **PRIOR TO BID** TO FIELD VERIFY ALL EXISTING CONDITIONS WHICH MAY AFFECT THEIR BID. THE FOLLOWING ITEMS SHALL BE VERIFIED:
 - EXACT PLACEMENT, SIZE, CAPACITY, MANUFACTURER, AND CONDITION OF ALL EXISTING HVAC EQUIPMENT WITHIN SCOPE OF WORK, WHETHER EXPLICITLY SHOWN OR NOT.
 - SIZE AND LOCATION OF ALL EXISTING DUCTWORK.
 - SIZE AND LOCATION OF ALL EXISTING GRILLES, REGISTERS AND DIFFUSERS.
 - SIZE AND LOCATION OF ALL EXISTING THERMOSTATIC CONTROL DEVICES.
 - SIZE AND LOCATION OF ALL EXISTING PLUMBING AND HYDRONIC PIPING.
- ALL REFERENCES ON THESE DRAWINGS TO EXISTING EQUIPMENT, DUCTWORK, DIFFUSERS, THERMOSTATS AND PIPING ARE FOR REFERENCE ONLY. IT IS THE RESPONSIBILITY OF THE CONTRACTOR TO VERIFY ALL THESE ITEMS PRIOR TO BID AND INCLUDE IN THEIR BID ANY AND ALL AMOUNTS REQUIRED TO ACCOMMODATE EXISTING CONDITIONS.
- NO ADDITIONAL COMPENSATION WILL BE MADE AFTER THE PROJECT HAS BEEN AWARDED FOR FAILURE TO VERIFY EXISTING CONDITIONS.
- ANY DISCREPANCIES WHICH MAY AFFECT THE CONTRACTORS BID SHALL BE BROUGHT TO THE ATTENTION OF THE ENGINEER AND ARCHITECT FOR DIRECTION.

KEYED NOTES 1/01-M100:


- CAREFULLY REMOVE EXISTING SNOW MELT MANIFOLD AND STORE FOR RE-INSTALLATION AS SHOWN ON 01/01-M200.
- EXISTING 4" GLYCOL CHILLED WATER
- EXISTING 4" FIRE SPRINKLER MAIN PIPING TO BE REROUTED.
- EXISTING AIR SEPARATOR TO BE RELOCATED.
- EXISTING SNOW MELT PIPING TO BE REROUTED.
- EXISTING 1" CONDENSATE DRAIN TO BE REROUTED.
- EXISTING EXPANSION TANK TO BE RELOCATED.
- EXISTING CHILLED WATER PUMPS TO BE RELOCATED.
- EXISTING PRESSURE SWITCHES TO BE RELOCATED.
- EXISTING CHEMICAL POT FEEDER TO BE RELOCATED.
- EXISTING 1" DOM WATER
- EXISTING 1" COND DRAIN
- EXISTING FIRE SPRINKLER
- EXISTING 1" EXPANSION LINE
- EXISTING 4" DOM WATER
- EXISTING 2-1/2" FIRE SPRINKLER LINE UP.
- EXISTING HWS & HWR BRANCH LINES.
- DISCONNECT COMPRESSED AIR PIPING. CAREFULLY REMOVE COMPRESSOR AND AIR DRYER, AND STORE FOR REINSTALLATION IN LOCATION SHOWN ON 1/01-M200.
- REFER TO SHEET PHOTOS FOR EXISTING CONDITIONS - FIELD COORDINATE DEMOLITION WORK AS REQUIRED.

KEYED NOTES 2/01-M100:

- DEMOLISH EXISTING FIN-TUBE RADIATION AND CABINET. DEMOLISH PIPING BACK TO MECHANICAL ROOM AND CAP IN PREPARATION FOR CONNECTION OF NEW CABINET UNIT HEATER.
- REMOVE SUPPLY AIR DIFFUSER AND BRANCH DUCT AS SHOWN.
- EXISTING SUPPLY DUCT MAIN TO REMAIN.
- EXISTING SPRINKLERS AND BRANCH PIPING IN THIS AREA TO REMAIN.
- EXISTING FIRE PROTECTION SPRINKLER HEADS AND PIPING TO BE RECONFIGURED.
- REFER TO SHEET 01-M200 FOR REMODEL WORK IN THIS AREA.
- EXISTING AIR HANDLING UNIT TO REMAIN.
- EXISTING DUCTWORK TO REMAIN.
- REMOVE DUCTWORK SHOWN AND PREPARE FOR REROUTING.

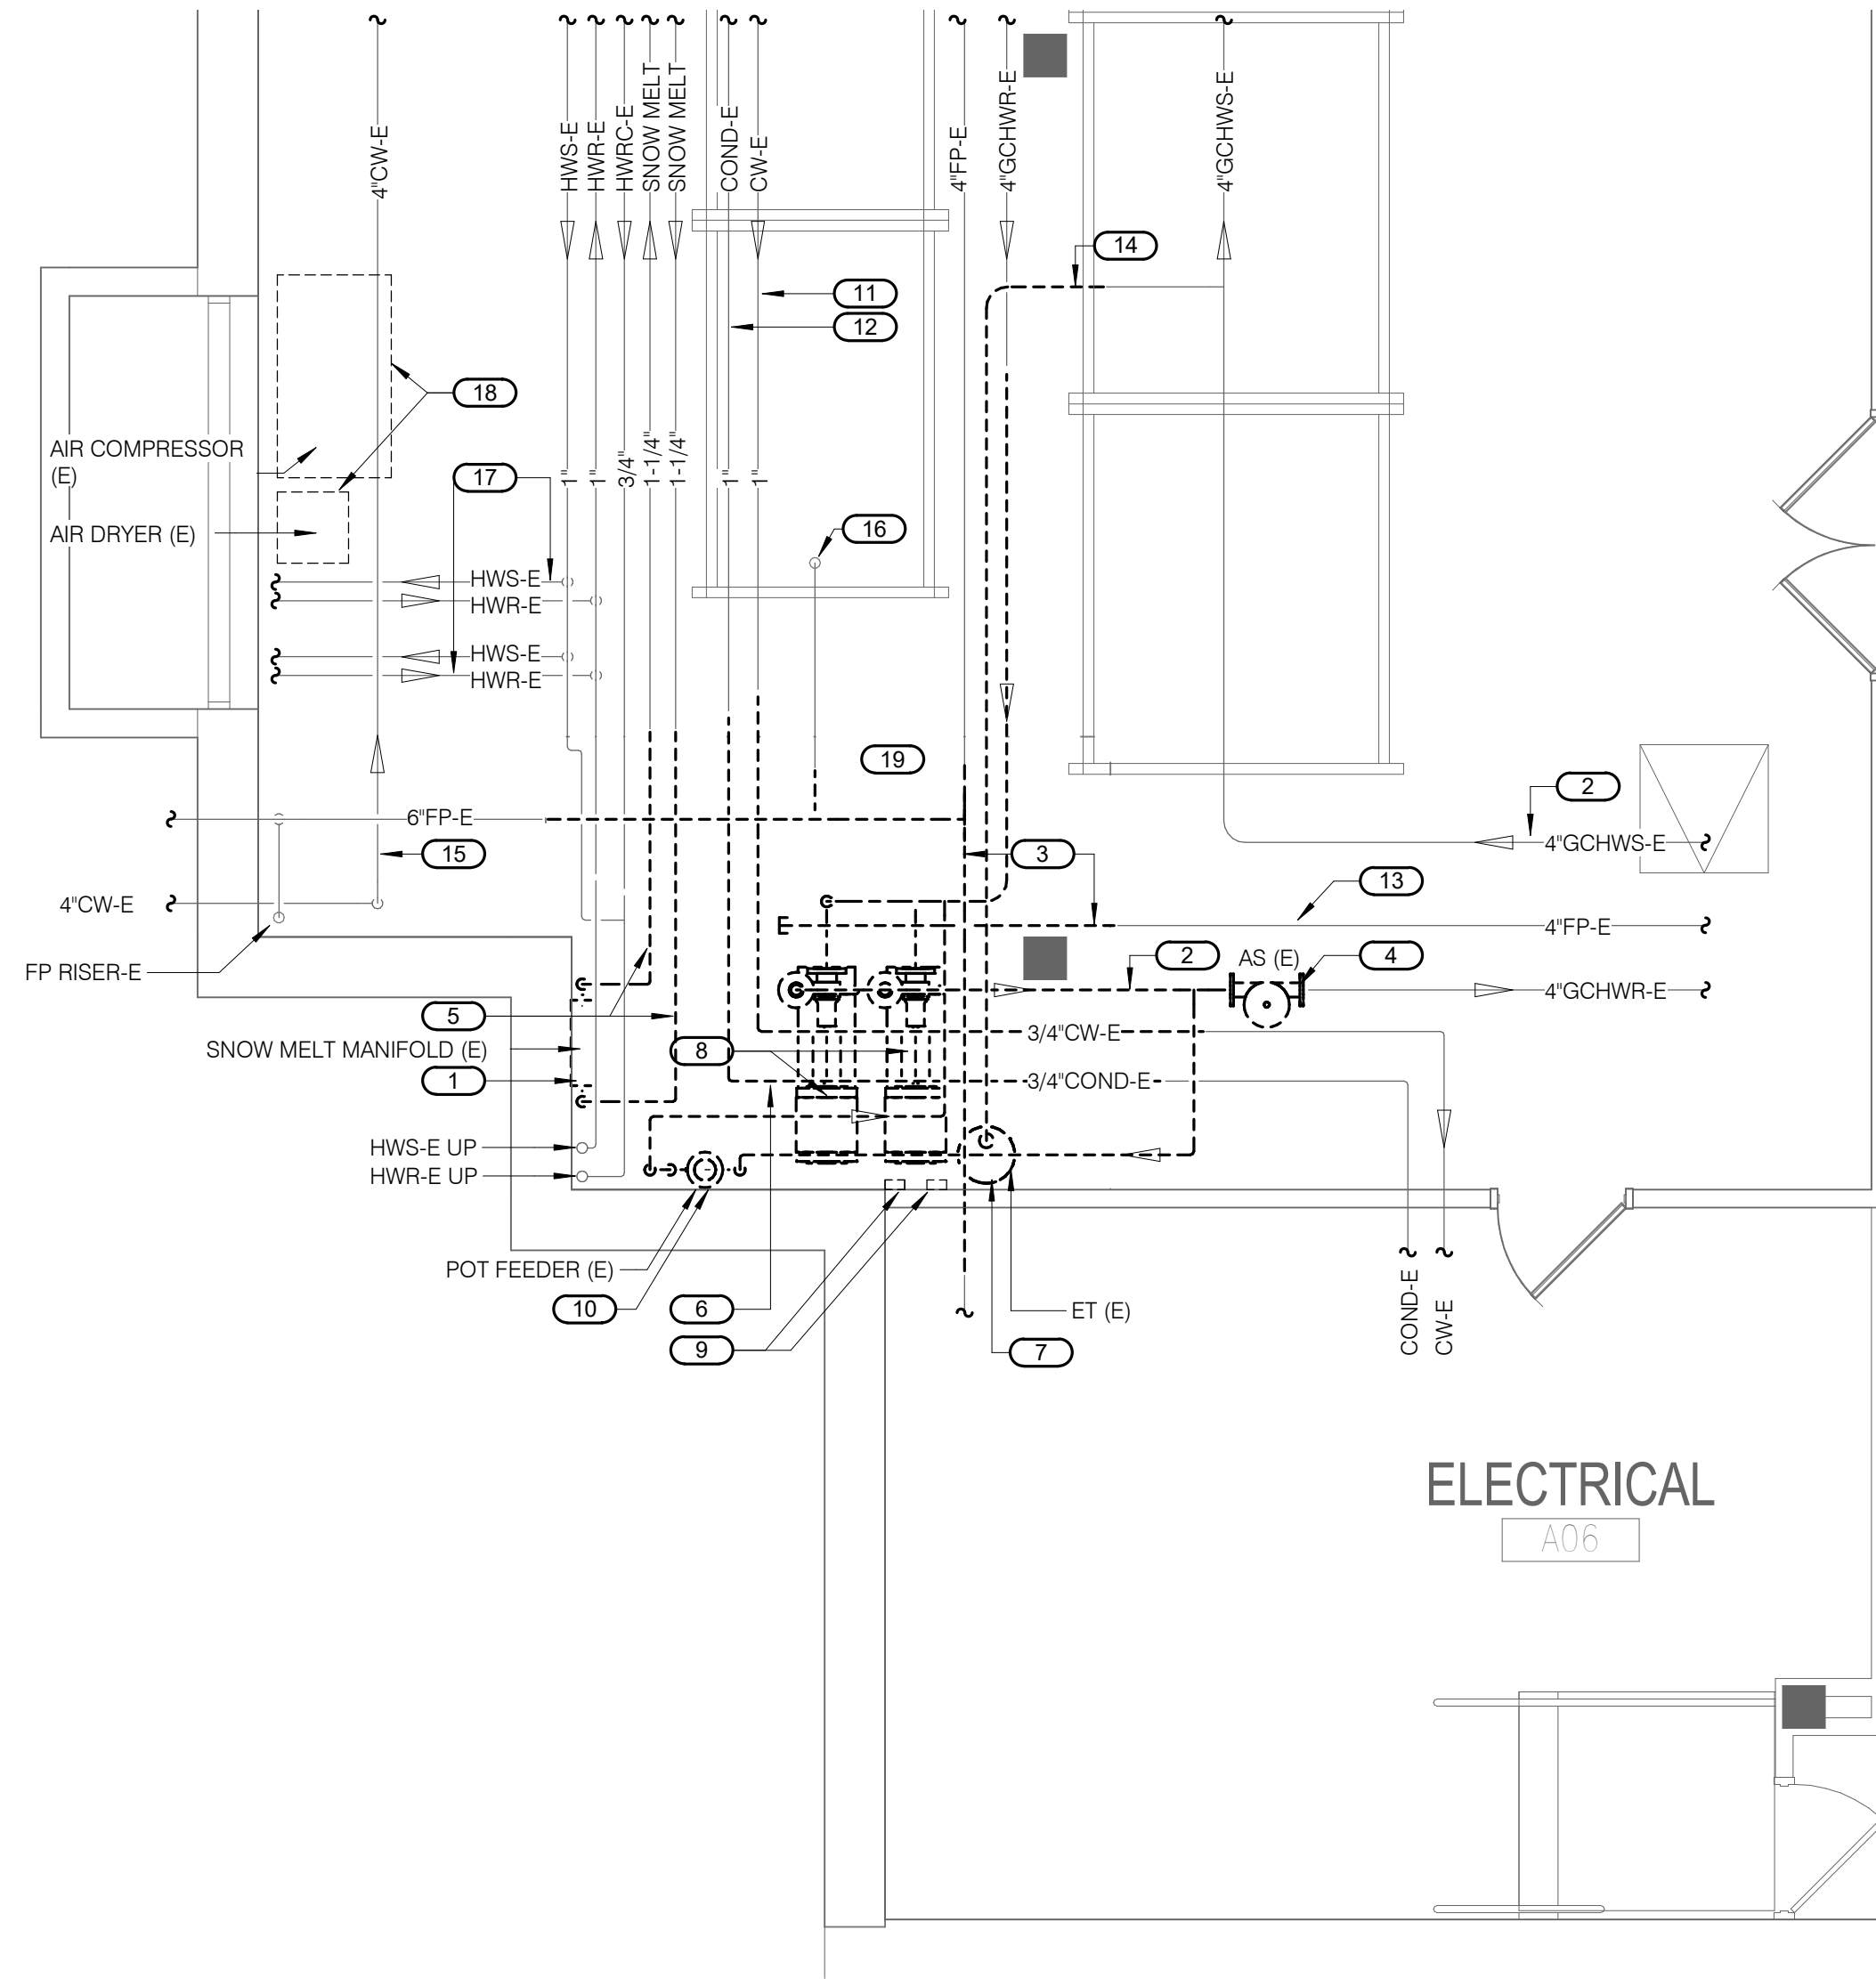


1 BASEMENT DEMOLITION - MECHANICAL - TELECOM A05C
1/4" = 1'-0"

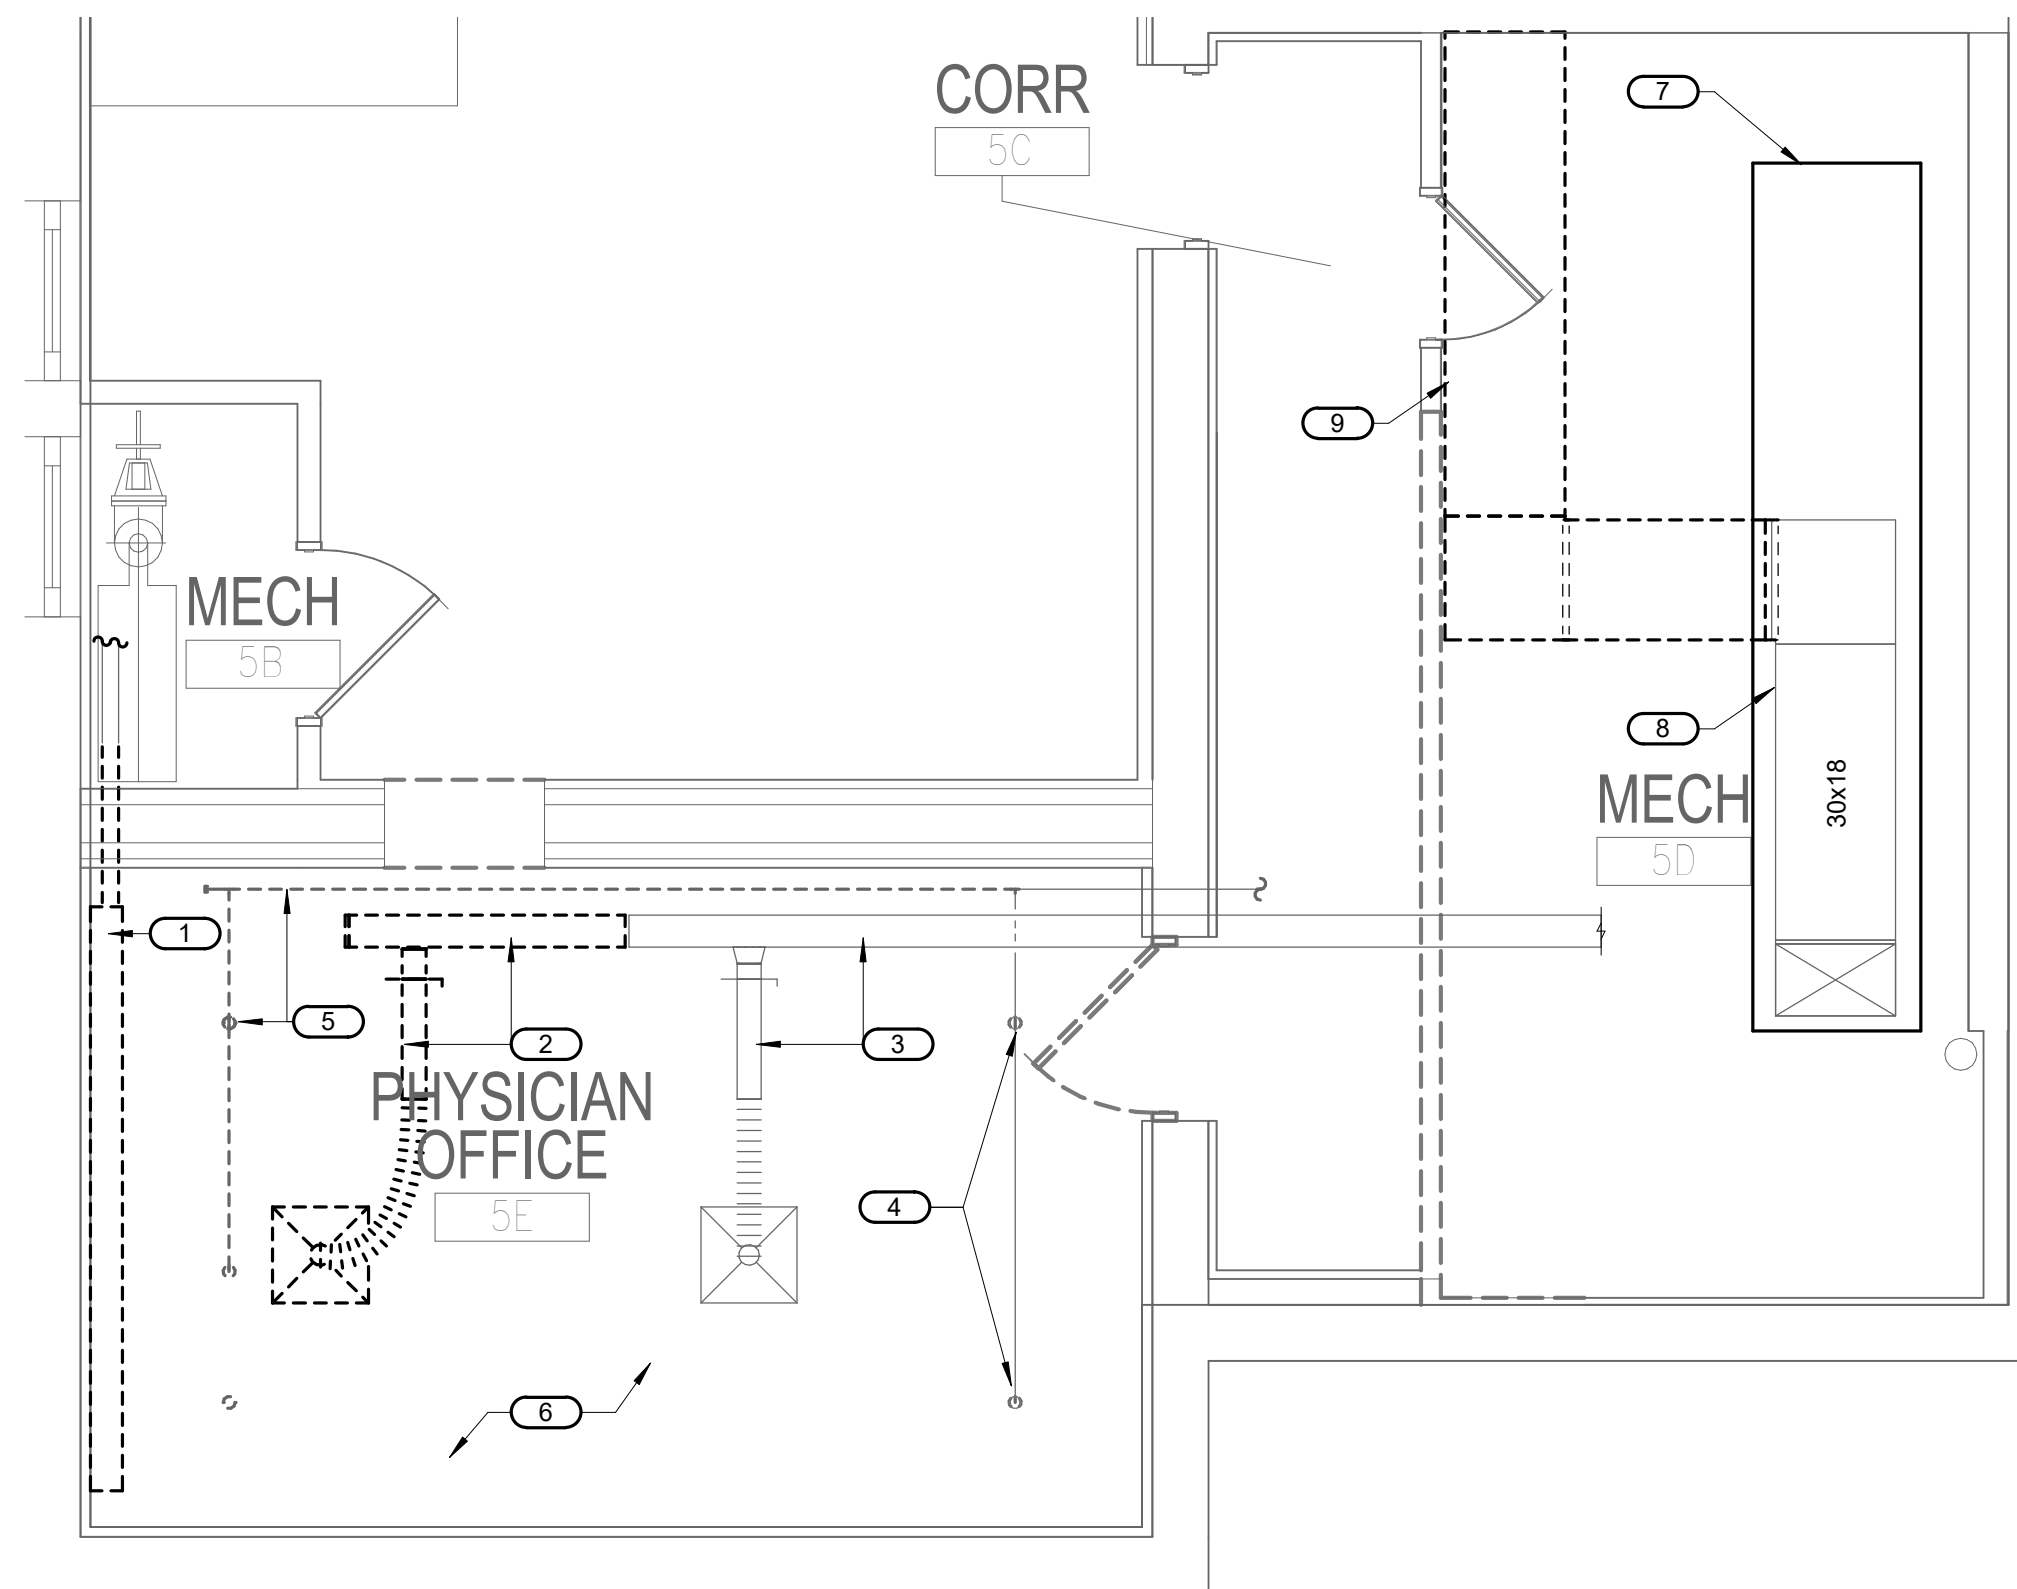

2 BASEMENT DEMOLITION - MECHANICAL - TELECOM 005F
1/4" = 1'-0"



SNOW MELT MANIFOLD

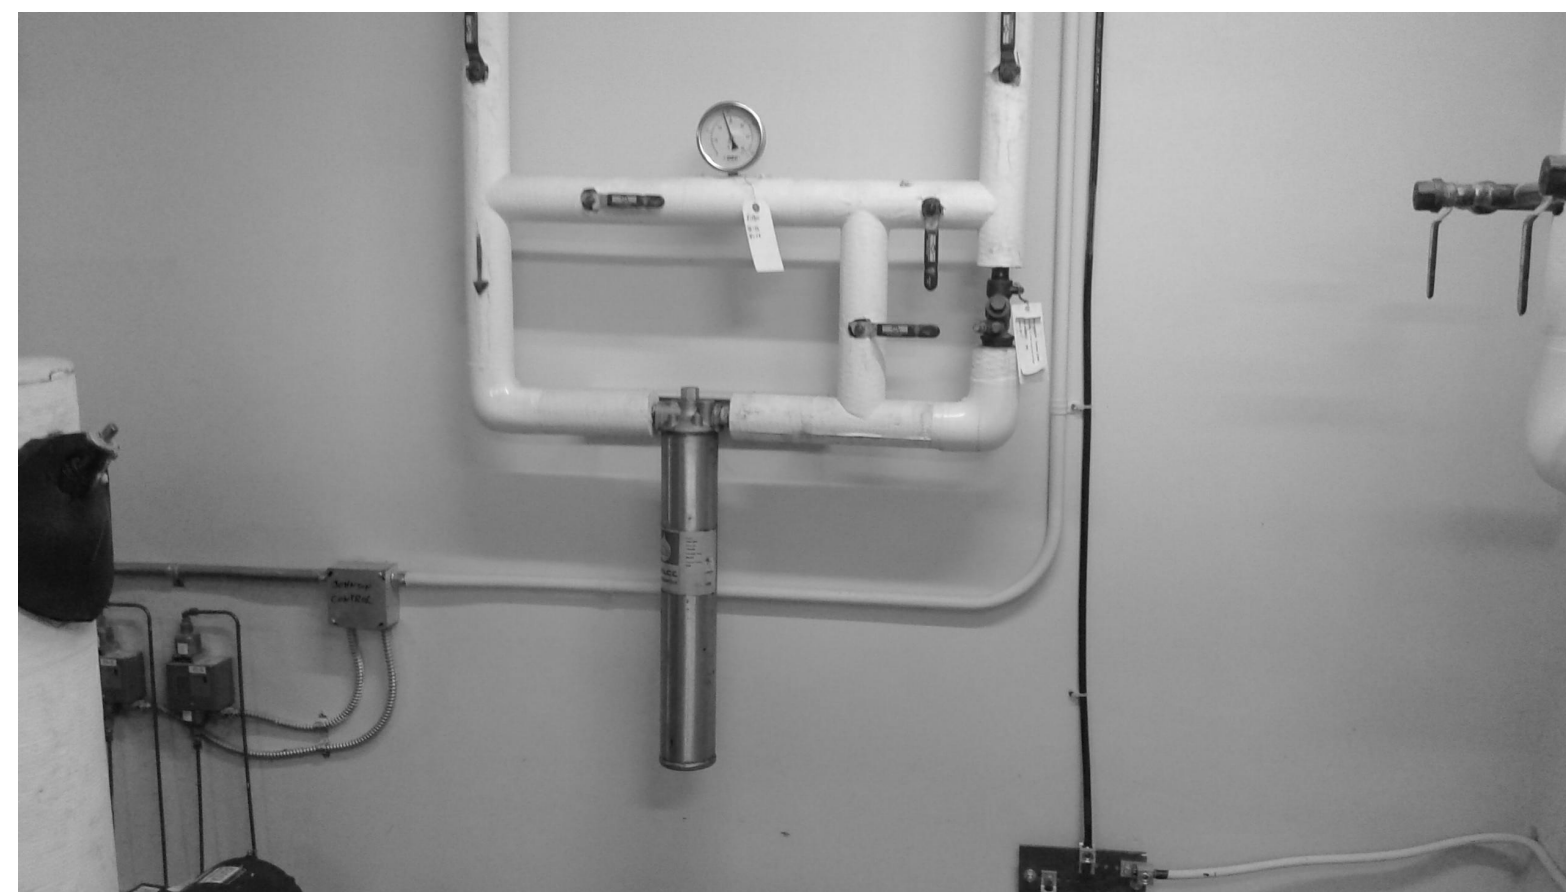


CHEMICAL FEED PIPING



GLYCOL CHILLED WATER PIPING
(LOOKING SOUTH)

3 A05C PHOTOS
1/8" = 1'-0"

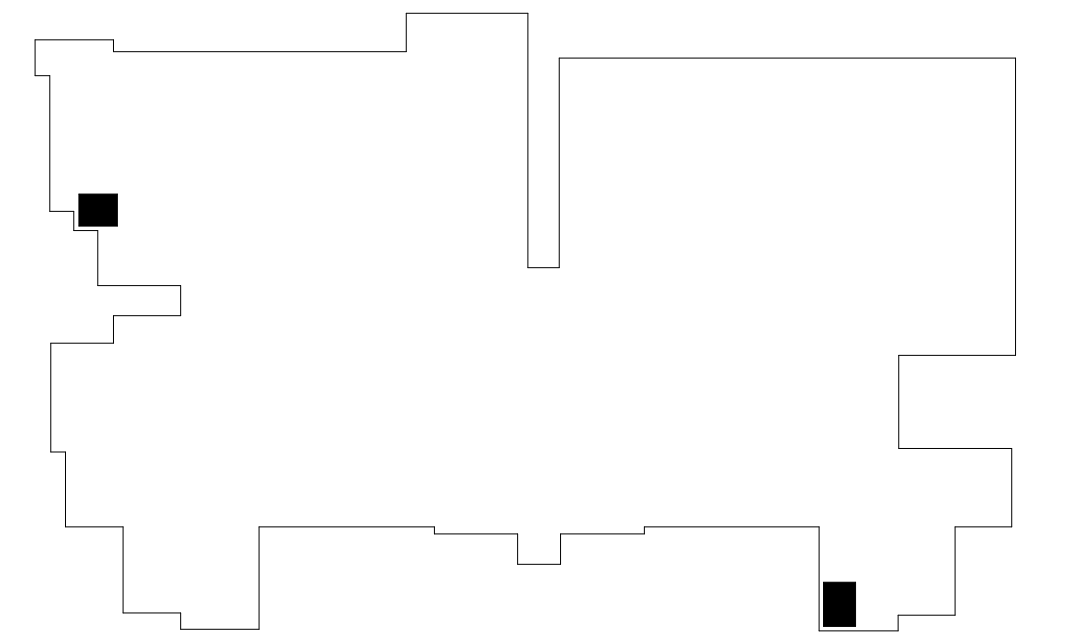


KEYPLAN - BASEMENT
NOT TO SCALE

RECORD DOCUMENTS	REVISION	DATE
No.		

CONSULTANT	
AST SES	
SPECIALIZED ENGINEERING SOLUTIONS	
10360 Ellipse Circle Omaha, NE 68134	Phone: 402.991.5520 www.specializedeng.com

ARCHITECT/ENGINEER OF RECORD	
ANDERSON	
13605 1st Ave. N. #100 Plymouth, MN 55441 P 763.412.4000 F 763.412.4090 ae-mn.com Anderson Engineering of Minnesota, LLC Proj # 16305	



-RECORD DOCUMENT- June 21, 2024 This Record Document has been prepared based on Designer of Record drawings with Contractor provided markups through the construction phase of the project at the direction of the VA. While the construction information is believed to be reliable, Architect/Engineer cannot assure its accuracy, and is not responsible for the accuracy of this Record Document. Those relying on this Record Document are advised to independently verify its accuracy before applying it for any purpose.	
--	--

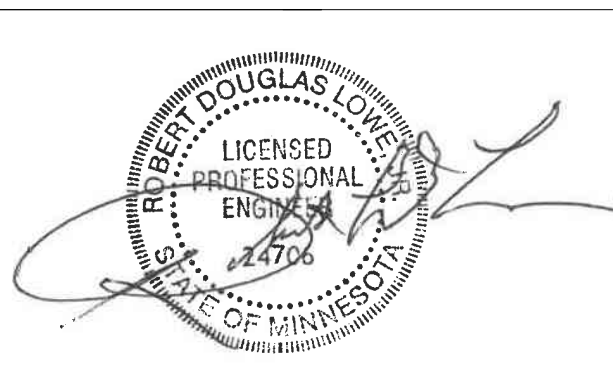

DRAWING TITLE	
BASEMENT DEMOLITION - MECHANICAL	

PROJECT TITLE	EHRM INFRASTRUCTURE UPGRADES
DATE	03/30/2022
PLOT SCALE	
PROJECT NO.	656-21-235
DRAWING NO.	01-M100
LOCATION	VA MEDICAL CENTER ST. CLOUD, MN 56303
FULLY SPRINKLERED	
DWG. OF	

RECORD DOCUMENTS

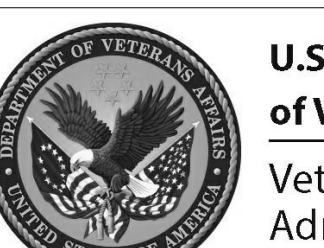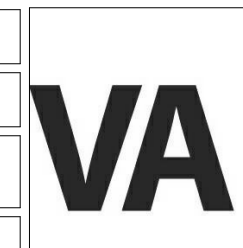

U.S. Department
of Veterans Affairs
Veterans Health
Administration
St. Cloud VA
Health Care System

1. THE HVAC CONTRACTOR SHOULD VISIT THE SITE **PRIOR TO BID** TO FIELD VERIFY ALL EXISTING CONDITIONS WHICH MAY AFFECT THEIR BID. THE FOLLOWING ITEMS SHALL BE VERIFIED:
 - A. EXACT PLACEMENT, SIZE, CAPACITY MANUFACTURER AND CONDITION OF ALL EXISTING HVAC EQUIPMENT WITHIN SCOPE OF WORK, WHETHER EXPLICITLY SHOWN OR NOT.
 - B. SIZE AND LOCATION OF ALL EXISTING DUCTWORK.
 - C. SIZE AND LOCATION OF ALL EXISTING GRILLES, REGISTERS AND DIFFUSERS.
 - D. SIZE AND LOCATION OF ALL EXISTING THERMOSTATIC CONTROL DEVICES.
 - E. SIZE AND LOCATION OF ALL EXISTING PLUMBING AND HYDRONIC PIPING.
2. ALL REFERENCES ON THESE DRAWINGS TO EXISTING EQUIPMENT, DUCTWORK, DIFFUSERS, THERMOSTATS AND PIPING ARE FOR REFERENCE ONLY. IT IS THE RESPONSIBILITY OF THE CONTRACTOR TO VERIFY ALL THESE ITEMS PRIOR TO BID AND INCLUDE IN THEIR BID ANY AND ALL AMOUNTS REQUIRED TO ACCOMMODATE EXISTING CONDITIONS.
3. NO ALLOWANCES WILL BE MADE AFTER THE PROJECT HAS BEEN AWARDED FOR FAILURE TO VERIFY EXISTING CONDITIONS.
4. ANY DISCREPANCIES WHICH MAY AFFECT THE CONTRACTORS BID SHALL BE BROUGHT TO THE ATTENTION OF THE ENGINEER AND ARCHITECT FOR DIRECTION.

1. EXISTING 4" DRAIN PIPE UP & DN TO REMAIN.
2. EXISTING 22X12 EXHAUST DUCT UP & DN TO REMAIN.
3. EXISTING 20X20 SUPPLY AIR DUCT UP & DN TO REMAIN.
4. EXISTING 14X8 RETURN DUCT UP & DN TO REMAIN.
5. EXISTING 8X8 RETURN AIR DUCT UP TO REMAIN.
6. EXISTING THERMOSTAT TO BE REMOVED.
7. EXISTING DIFFUSER AND ASSOCIATED DUCTWORK TO BE REMOVED. CAP DUCT WHERE SHOWN ON DRAWINGS.
8. EXISTING FIRE SPRINKLER HEAD TO REMAIN.
9. EXISTING RETURN AIR GRILLE TO BE REMOVED.
10. REFER TO SHEET 01-M201 FOR REMODEL WORK IN THIS AREA.



No	RECORD DOCUMENTS REVISION	06/21/24 DATE


AST  **SPECIALIZED
ENGINEERING
SOLUTIONS**

10360 Ellison Circle
Omaha, NE 68134

Phone: 402.991.5520
www.specializedeng.com

13605 1st Ave. N. #100 Plymouth, MN 55441
P 763.412.4000 | F 763.412.4090 | ae-mn.com
Anderson Engineering of Minnesota, LLC | Proj # 16305

This Record Document has been prepared based on Designer of Record drawings with Contractor provided markups through the construction phase of the project at the direction of the VA. While the construction information is believed to be reliable, Architect/Engineer cannot assure its accuracy, and is not responsible for the accuracy of this Record Document. Those relying on this Record Document are advised to independently verify its accuracy before applying it for any purpose.

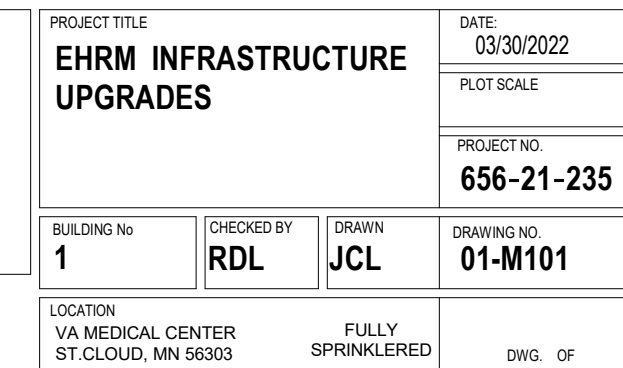

**U.S. Department
of Veterans Affairs**
Veterans Health
Administration
St. Cloud VA
Health Care System

6/14/2024 8:49:19 AM
BIM 360/21102.001 - VA St Cloud EHRM Infrastructure Upgrades-656-235-B01.M_R21.rvt


FIELD VERIFICATION NOTES

- THE HVAC CONTRACTOR SHOULD VISIT THE SITE **PRIOR TO BID** TO FIELD VERIFY ALL EXISTING CONDITIONS WHICH MAY AFFECT THEIR BID. THE FOLLOWING ITEMS SHALL BE VERIFIED:
 - EXACT PLACEMENT, SIZE, CAPACITY MANUFACTURER AND CONDITION OF ALL EXISTING HVAC EQUIPMENT WITHIN SCOPE OF WORK, WHETHER EXPLICITLY SHOWN OR NOT.
 - SIZE AND LOCATION OF ALL EXISTING DUCTWORK.
 - SIZE AND LOCATION OF ALL EXISTING GRILLES, REGISTERS AND DIFFUSERS.
 - SIZE AND LOCATION OF ALL EXISTING THERMOSTATIC CONTROL DEVICES.
 - SIZE AND LOCATION OF ALL EXISTING PLUMBING AND HYRNIC PIPING.
- ALL REFERENCES ON THESE DRAWINGS TO EXISTING EQUIPMENT, DUCTWORK, DIFFUSERS, THERMOSTATS AND PIPING ARE FOR REFERENCE ONLY. IT IS THE RESPONSIBILITY OF THE CONTRACTOR TO VERIFY ALL THESE ITEMS PRIOR TO BID AND INCLUDE IN THEIR BID ANY AND ALL AMOUNTS REQUIRED TO ACCOMMODATE EXISTING CONDITIONS.
- NO ALLOWANCES WILL BE MADE AFTER THE PROJECT HAS BEEN AWARDED FOR FAILURE TO VERIFY EXISTING CONDITIONS.
- ANY DISCREPANCIES WHICH MAY AFFECT THE CONTRACTORS BID SHALL BE BROUGHT TO THE ATTENTION OF THE ENGINEER AND ARCHITECT FOR DIRECTION.


KEYED NOTES 1/02-M102:

1

- EXISTING HEATCRAFT MODEL FC855M AIR COOLED CONDENSING UNIT AND ASSOCIATED REFRIGERANT PIPING TO BE RELOCATED. EVACUATE AND CAPTURE EXISTING REFRIGERANT, AND STORE FOR REINSTALLATION IN RELOCATED SYSTEMSEE SHEET 01-M202 FOR UNIT'S NEW LOCATION.

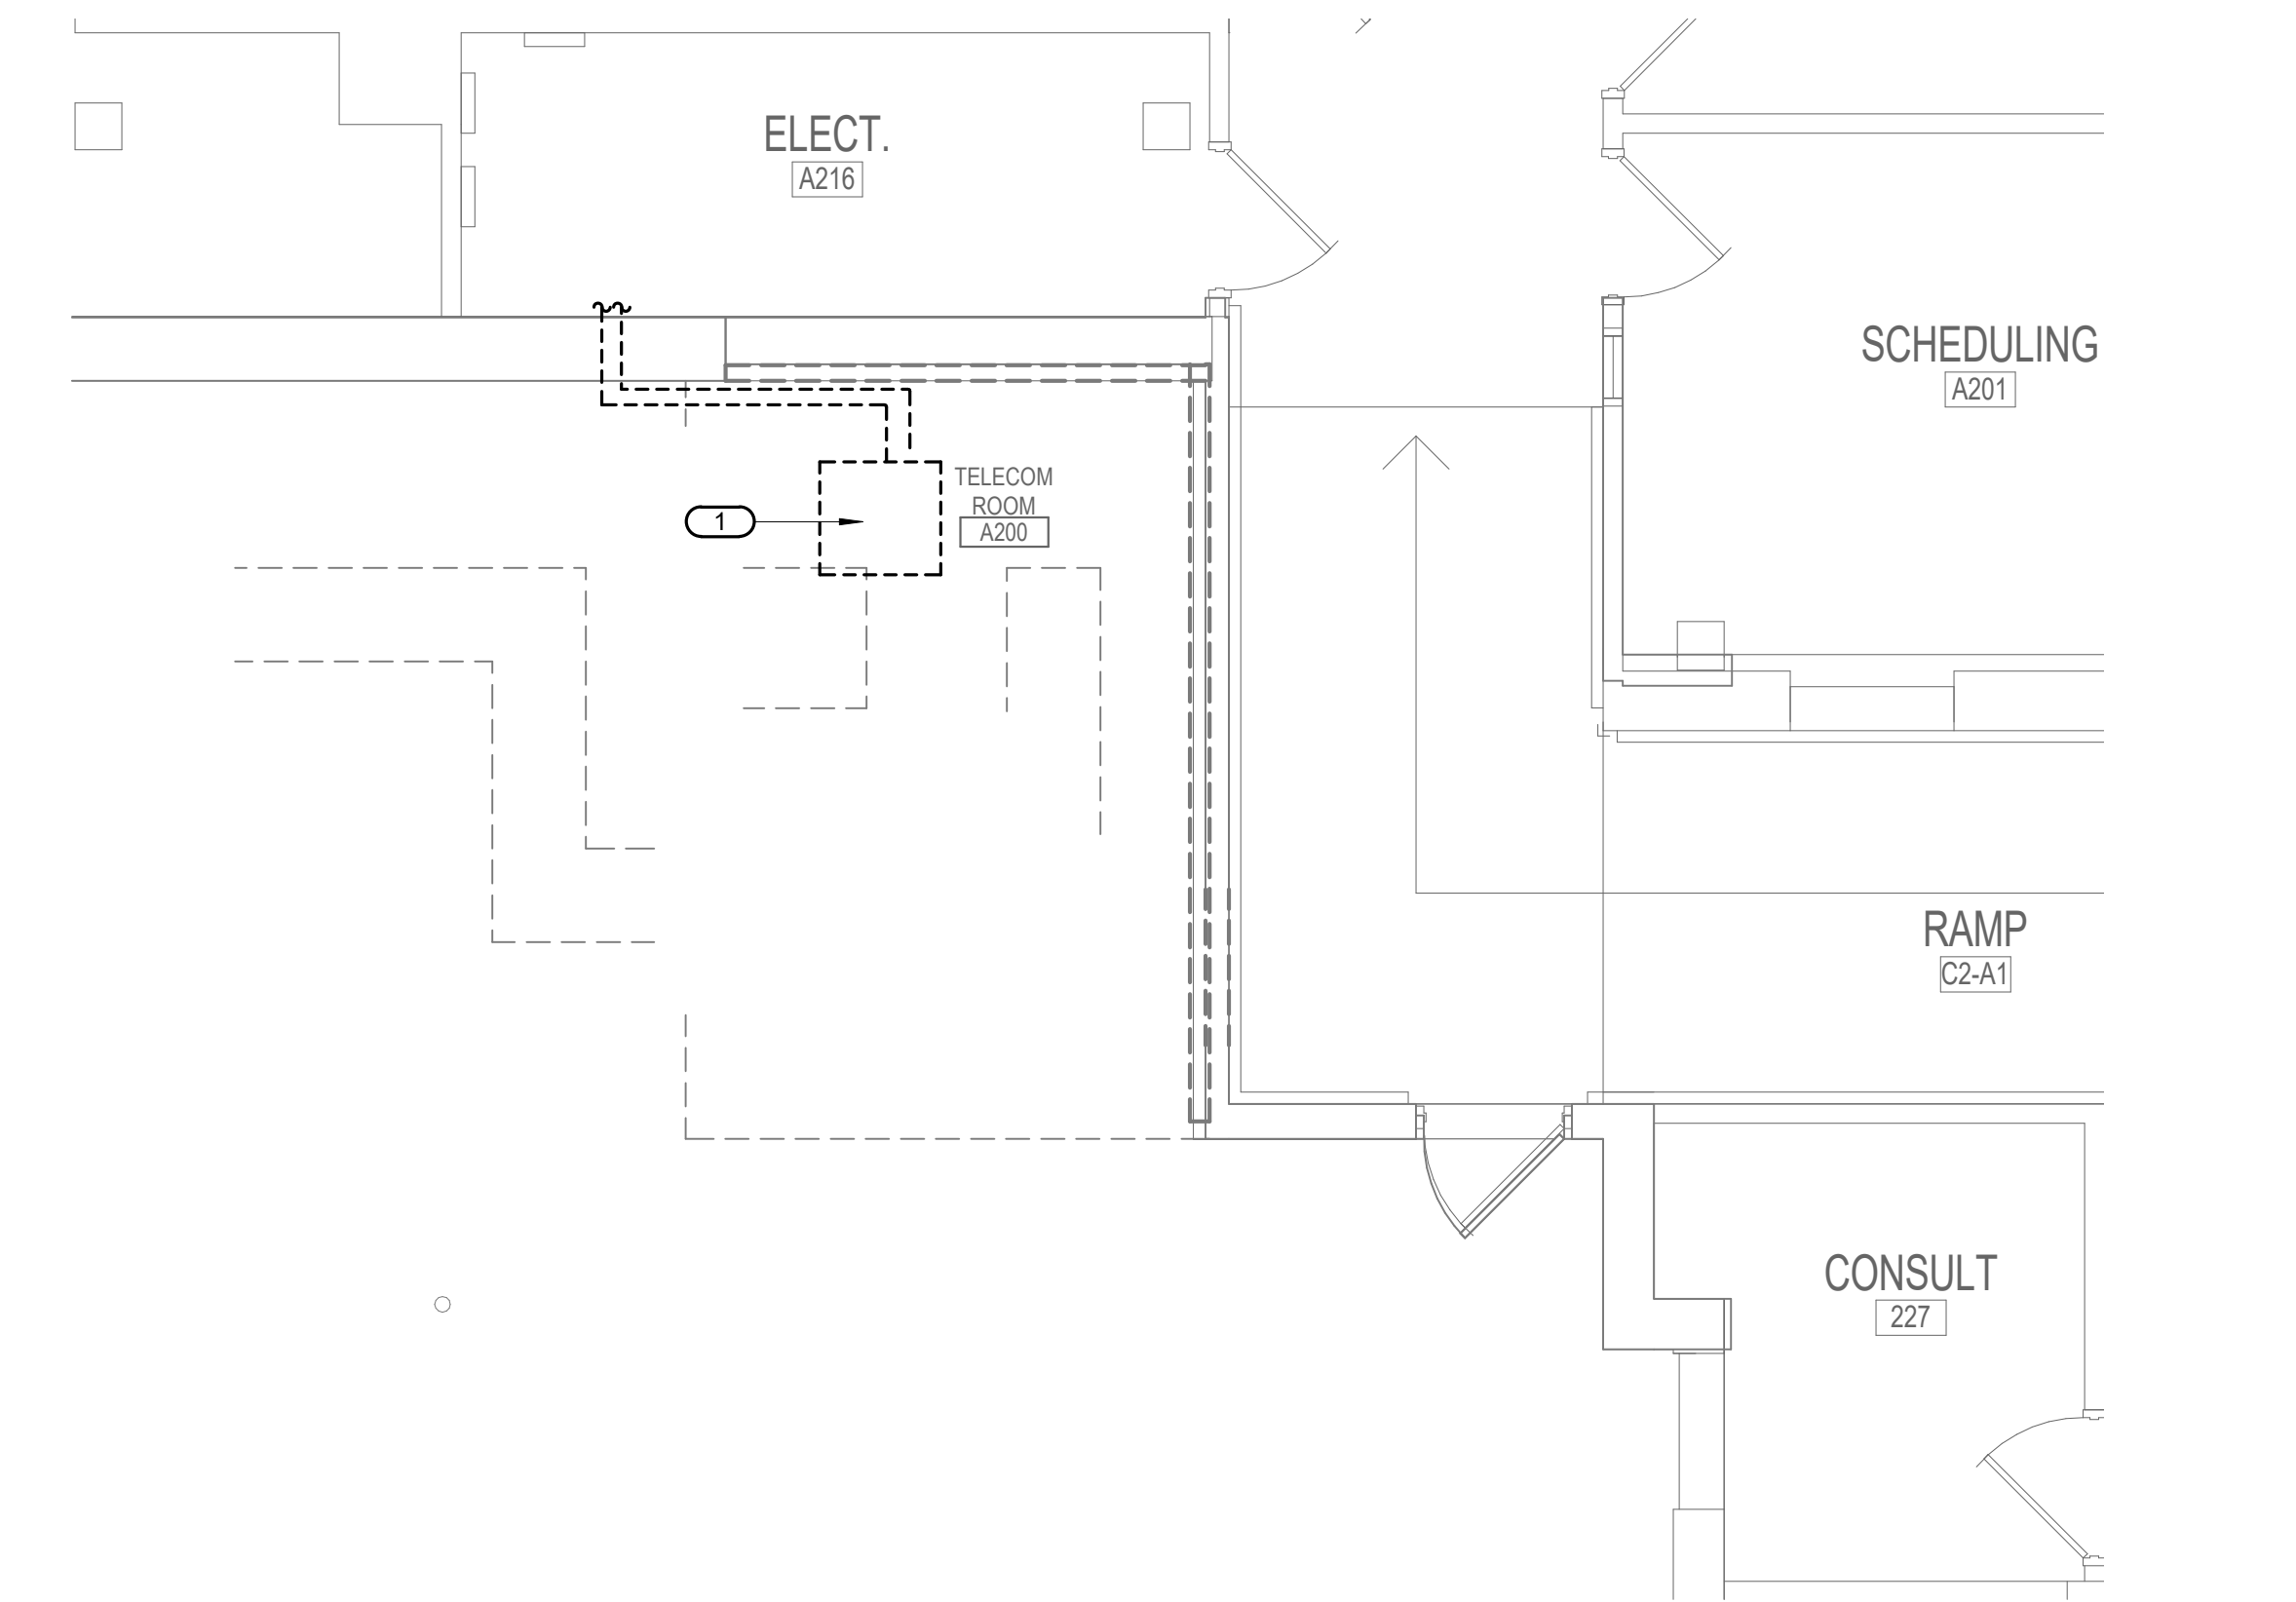

1 SECOND FLOOR DEMOLITION - MECHANICAL - TELECOM A200
1/4" = 1'-0"

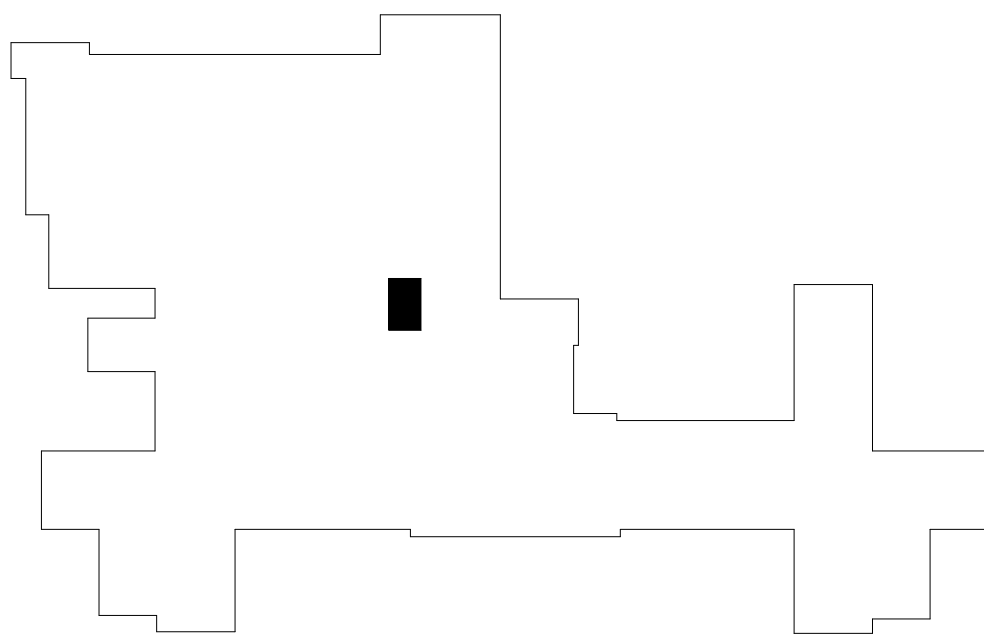

KEYPLAN - SECOND FLOOR
NOT TO SCALE

RECORD DOCUMENTS

RECORD DOCUMENTS	REVISION	DATE
1		06/21/24

CONSULTANT

AST SES SPECIALIZED ENGINEERING SOLUTIONS

10360 Ellipse Circle
Omaha, NE 68134


Phone: 402.991.5520
www.specializedeng.com

ARCHITECT/ENGINEER OF RECORD

ANDERSON

13605 1st Ave. N. #100 Plymouth, MN 55441
P 763.412.4000 | F 763.412.4090 | ae-mn.com
Anderson Engineering of Minnesota, LLC | Proj # 16305

-RECORD DOCUMENT-
June 21, 2024
This Record Document has been prepared based on Designer of Record drawings with Contractor provided markups through the construction phase of the project at the direction of the VA. While the construction information is believed to be reliable, Architect/Engineer cannot assure its accuracy, and is not responsible for the accuracy of this Record Document. Those relying on this Record Document are advised to independently verify its accuracy before applying it for any purpose.

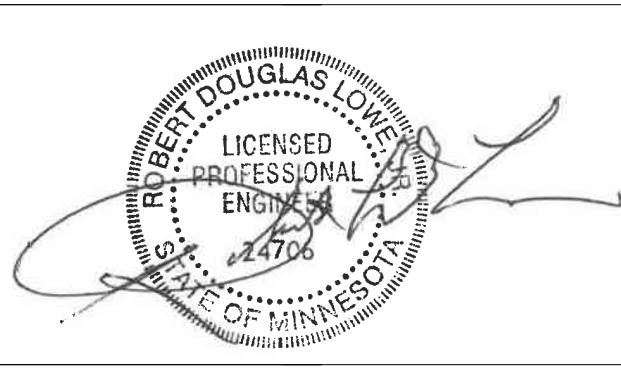

DRAWING TITLE

SECOND FLOOR DEMOLITION - MECHANICAL

PROJECT TITLE	DATE
EHRM INFRASTRUCTURE UPGRADES	03/30/2022
BUILDING NO.	PLOT SCALE
1	
CHECKED BY	DRAWN
RDL	JCL
DRAWING NO.	
01-M102	
LOCATION	FULLY
VA MEDICAL CENTER ST. CLOUD, MN 56303	SPRINKLERED
DWG. OF	

VA

U.S. Department of Veterans Affairs

Veterans Health Administration
St. Cloud VA Health Care System

FIELD VERIFICATION NOTES


- THE HVAC CONTRACTOR SHOULD VISIT THE SITE **PRIOR TO BID** TO FIELD VERIFY ALL EXISTING CONDITIONS WHICH MAY AFFECT THEIR BID. THE FOLLOWING ITEMS SHALL BE VERIFIED:
 - EXACT PLACEMENT, SIZE, CAPACITY MANUFACTURER AND CONDITION OF ALL EXISTING HVAC EQUIPMENT WITHIN SCOPE OF WORK, WHETHER EXPLICITLY SHOWN OR NOT.
 - SIZE AND LOCATION OF ALL EXISTING DUCTWORK.
 - SIZE AND LOCATION OF ALL EXISTING GRILLES, REGISTERS AND DIFFUSERS.
 - SIZE AND LOCATION OF ALL EXISTING THERMOSTATIC CONTROL DEVICES.
 - SIZE AND LOCATION OF ALL EXISTING PLUMBING AND HYRNIC PIPING.
- ALL REFERENCES ON THESE DRAWINGS TO EXISTING EQUIPMENT, DUCTWORK, DIFFUSERS, THERMOSTATS AND PIPING ARE FOR REFERENCE ONLY. IT IS THE RESPONSIBILITY OF THE CONTRACTOR TO VERIFY ALL THESE ITEMS PRIOR TO BID AND INCLUDE IN THEIR BID ANY AND ALL AMOUNTS REQUIRED TO ACCOMMODATE EXISTING CONDITIONS.
- NO ALLOWANCES WILL BE MADE AFTER THE PROJECT HAS BEEN AWARDED FOR FAILURE TO VERIFY EXISTING CONDITIONS.
- ANY DISCREPANCIES WHICH MAY AFFECT THE CONTRACTORS BID SHALL BE BROUGHT TO THE ATTENTION OF THE ENGINEER AND ARCHITECT FOR DIRECTION.

KEYED NOTES 1/01-M200:


- PAN EXISTING HEATING WATER PIPING TO REMAIN IN THIS AREA.
- PAN COOLING UNIT CONDENSATE PIPING IN THIS AREA.
- REINSTALL CHILLED WATER PUMPS IN NEW LOCATION AND CONNECT NEW PIPING.
- RELOCATED EXPANSION TANK
- RELOCATED POT FEEDER
- RELOCATED PRESSURE SWITCHES
- REINSTALL ORIGINAL AIR DRYER AND AIR COMPRESSOR IN NEW LOCATION. MODIFY AND RECONNECT COMPRESSED AIR PIPING AS REQUIRED.
- ROUTE CP-1 PIPING TO NEAREST JANITOR SINK.
- PROVIDE NEW THERMOSTAT. INTERFACE TO SERVE AC 1-1.
- REINSTALL EXISTING SNOW MELT MANIFOLD IN NEW LOCATION.
- ROUTE NEW REFRIGERANT PIPE UP TO NEW CU LOCATED ON GRADE. SEE SHEET 01-M201 FOR CONTINUATION.
- AIR SEPERATOR.
- ADD ADDITIONAL DRIP PAN PER RFI 106.1.

KEYED NOTES 2/01-M200:


- CAP DUCT IN THIS LOCATION
- NEW WALL MOUNTED DUCTLESS COOLING UNIT AC-1-2.
- ROUTE NEW REFRIGERANT PIPE UP TO NEW CU LOCATED IN ATTIC. SEE SHEET 01-M204 FOR CONTINUATION.
- NEW HYDRONIC CABINET UNIT HEATER CUH-1.
- CONNECT NEW 3/4" HWS & HWR TO EXISTING.
- NEW THERMOSTAT. INTERFACE TO SERVE BOTH AC-1-2 AND CUH-1.
- ROUTE NEW CONDENSATE PIPING FOR AC 1-2 TO NEAREST FLOOR DRAIN IN MECHANICAL ROOM 5D - FIELD COORDINATE EXACT ROUTING.
- PROVIDE CONDENSATE PAN FOR ALL CONDENSATE PIPING IN TELECOM ROOM.
- EXTEND FIRE SPRINKLER BRANCH LINES AND PROVIDE NEW SPRINKLER HEADS.
- PAN COOLING UNIT CONDENSATE PIPING IN THIS AREA.
- EXTEND FIRE SPRINKLER BRANCH LINE AND PROVIDE NEW FIRE SPRINKLER HEAD.
- RE-MOUNT AND RE-BALANCE EXISTING DIFFUSER.
- EXISTING AIR HANDLING UNIT.
- EXISTING DUCTWORK.
- NEW 30"x18" DUCT.
- RISE DUCT TO AVOID DOOR.

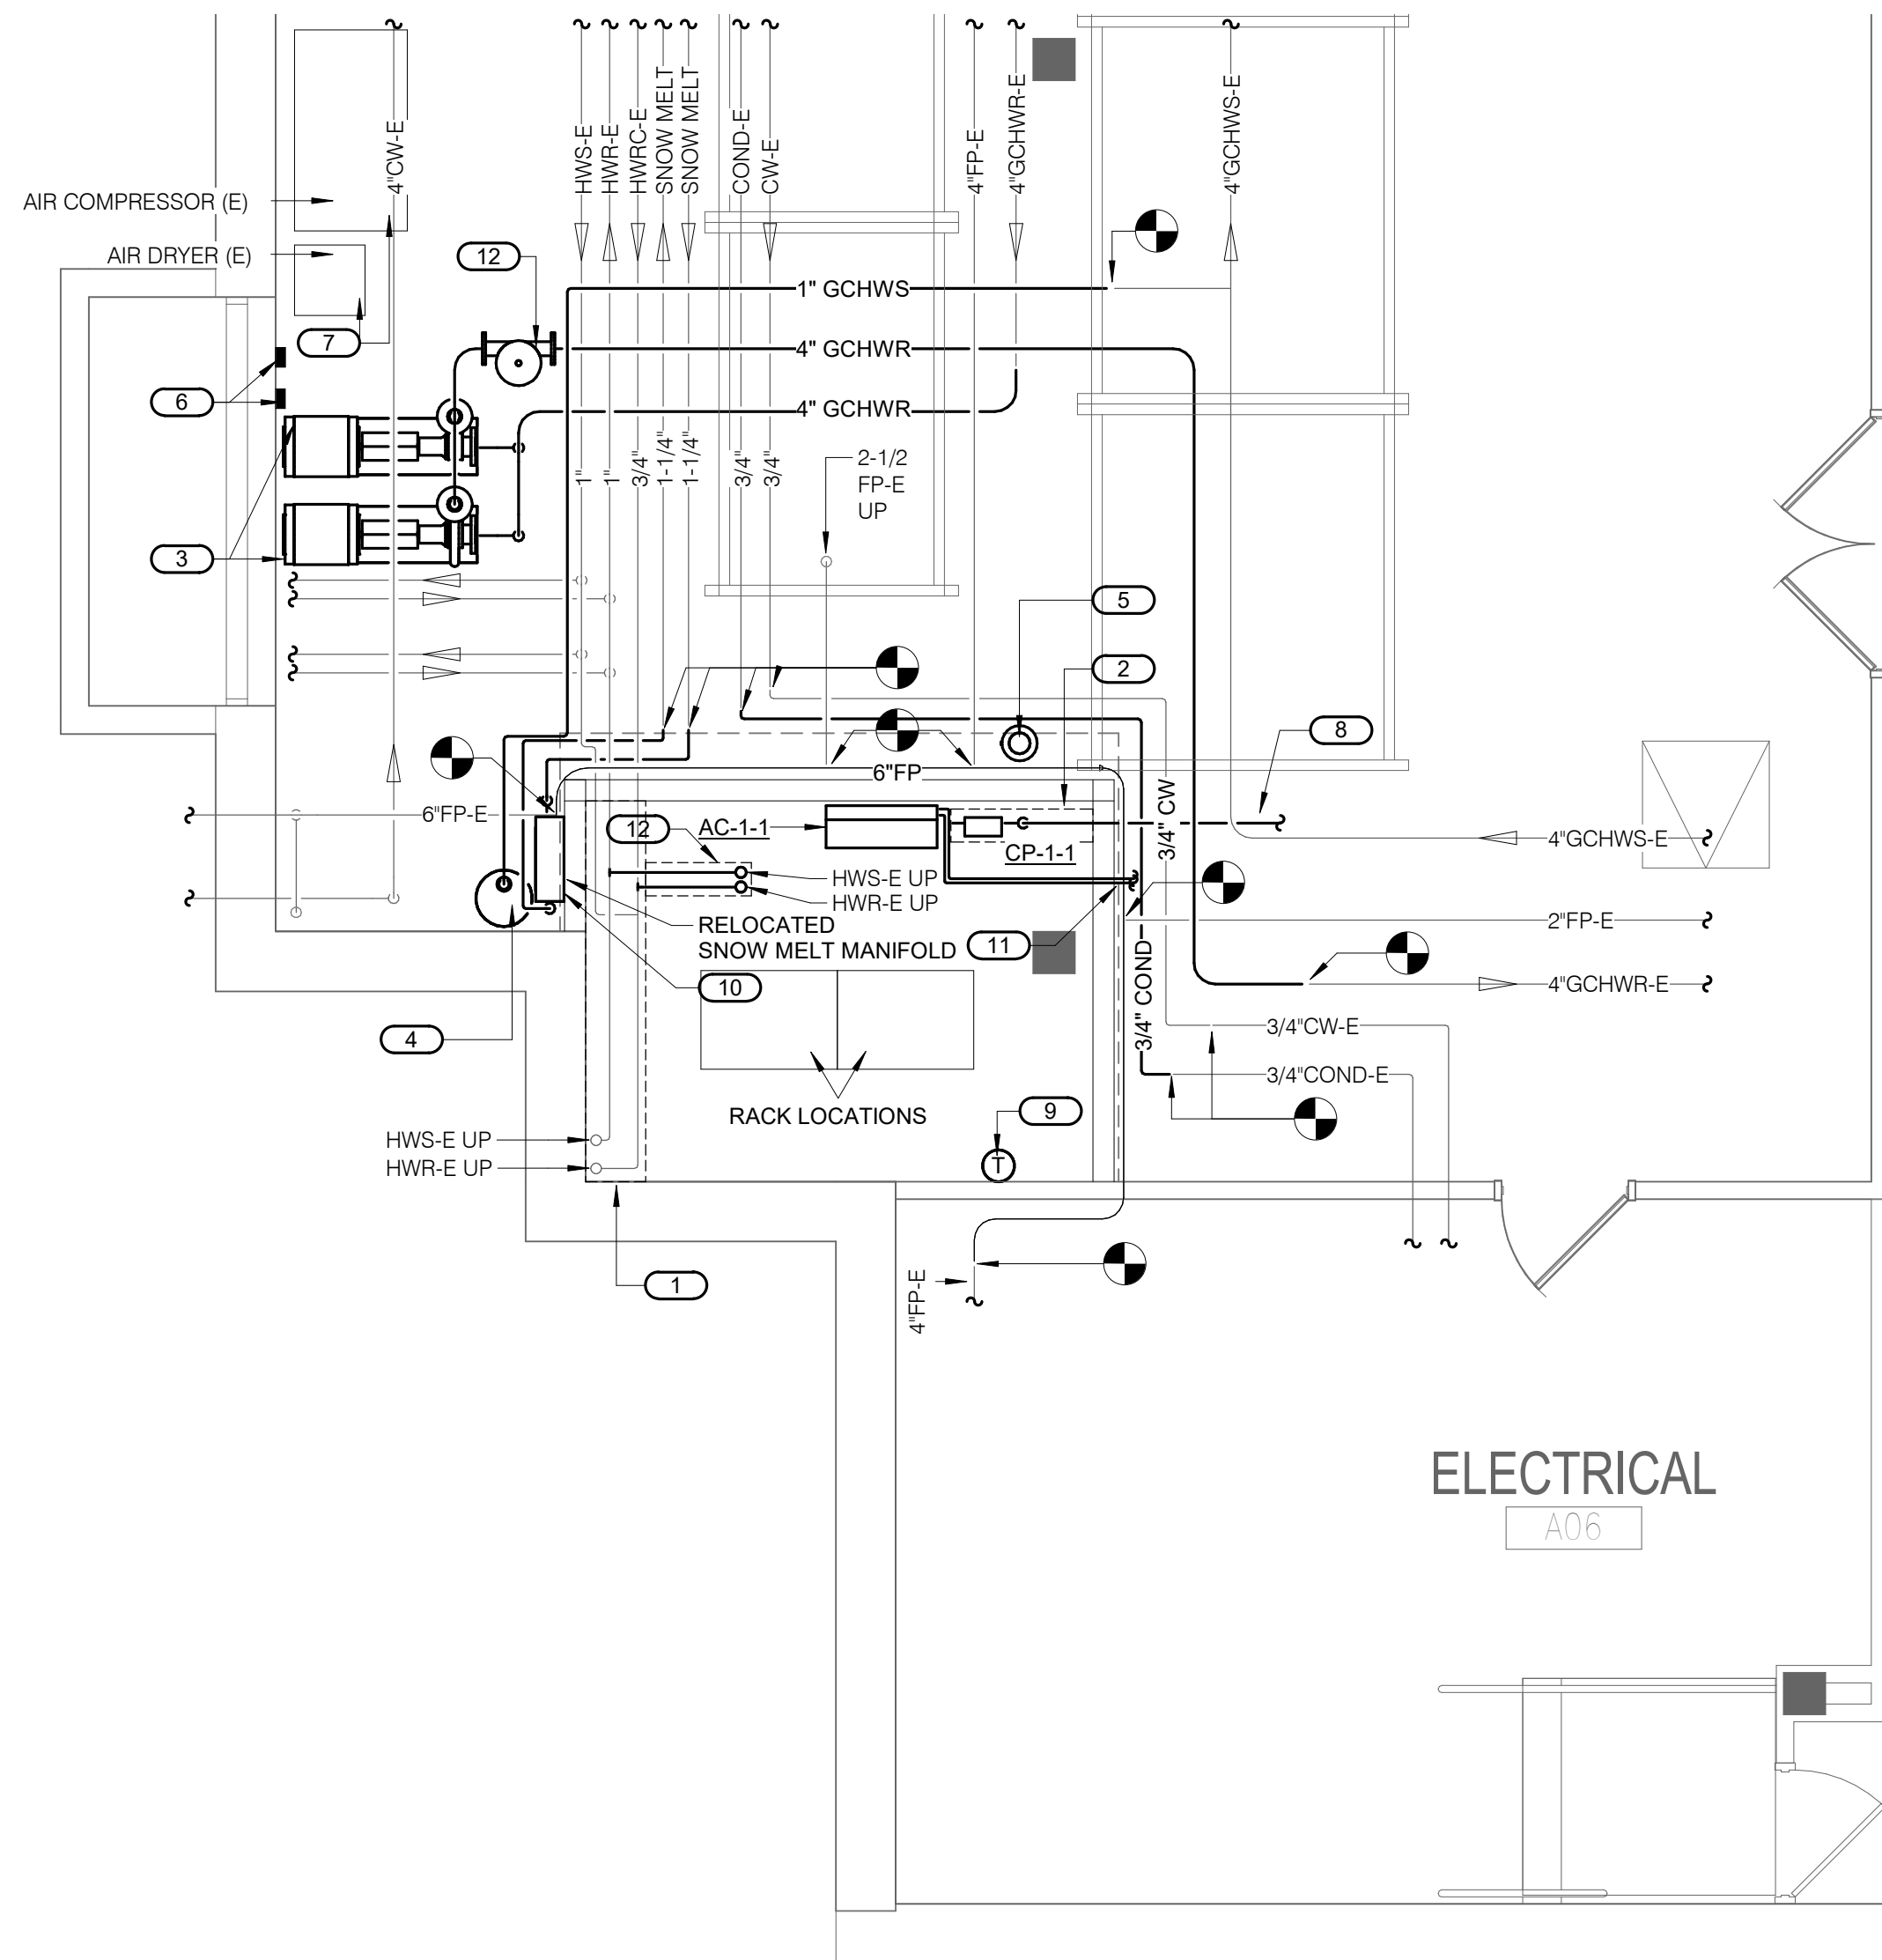

1 BASEMENT FLOOR - MECHANICAL - TELECOM A05C
1/4" = 1'-0"

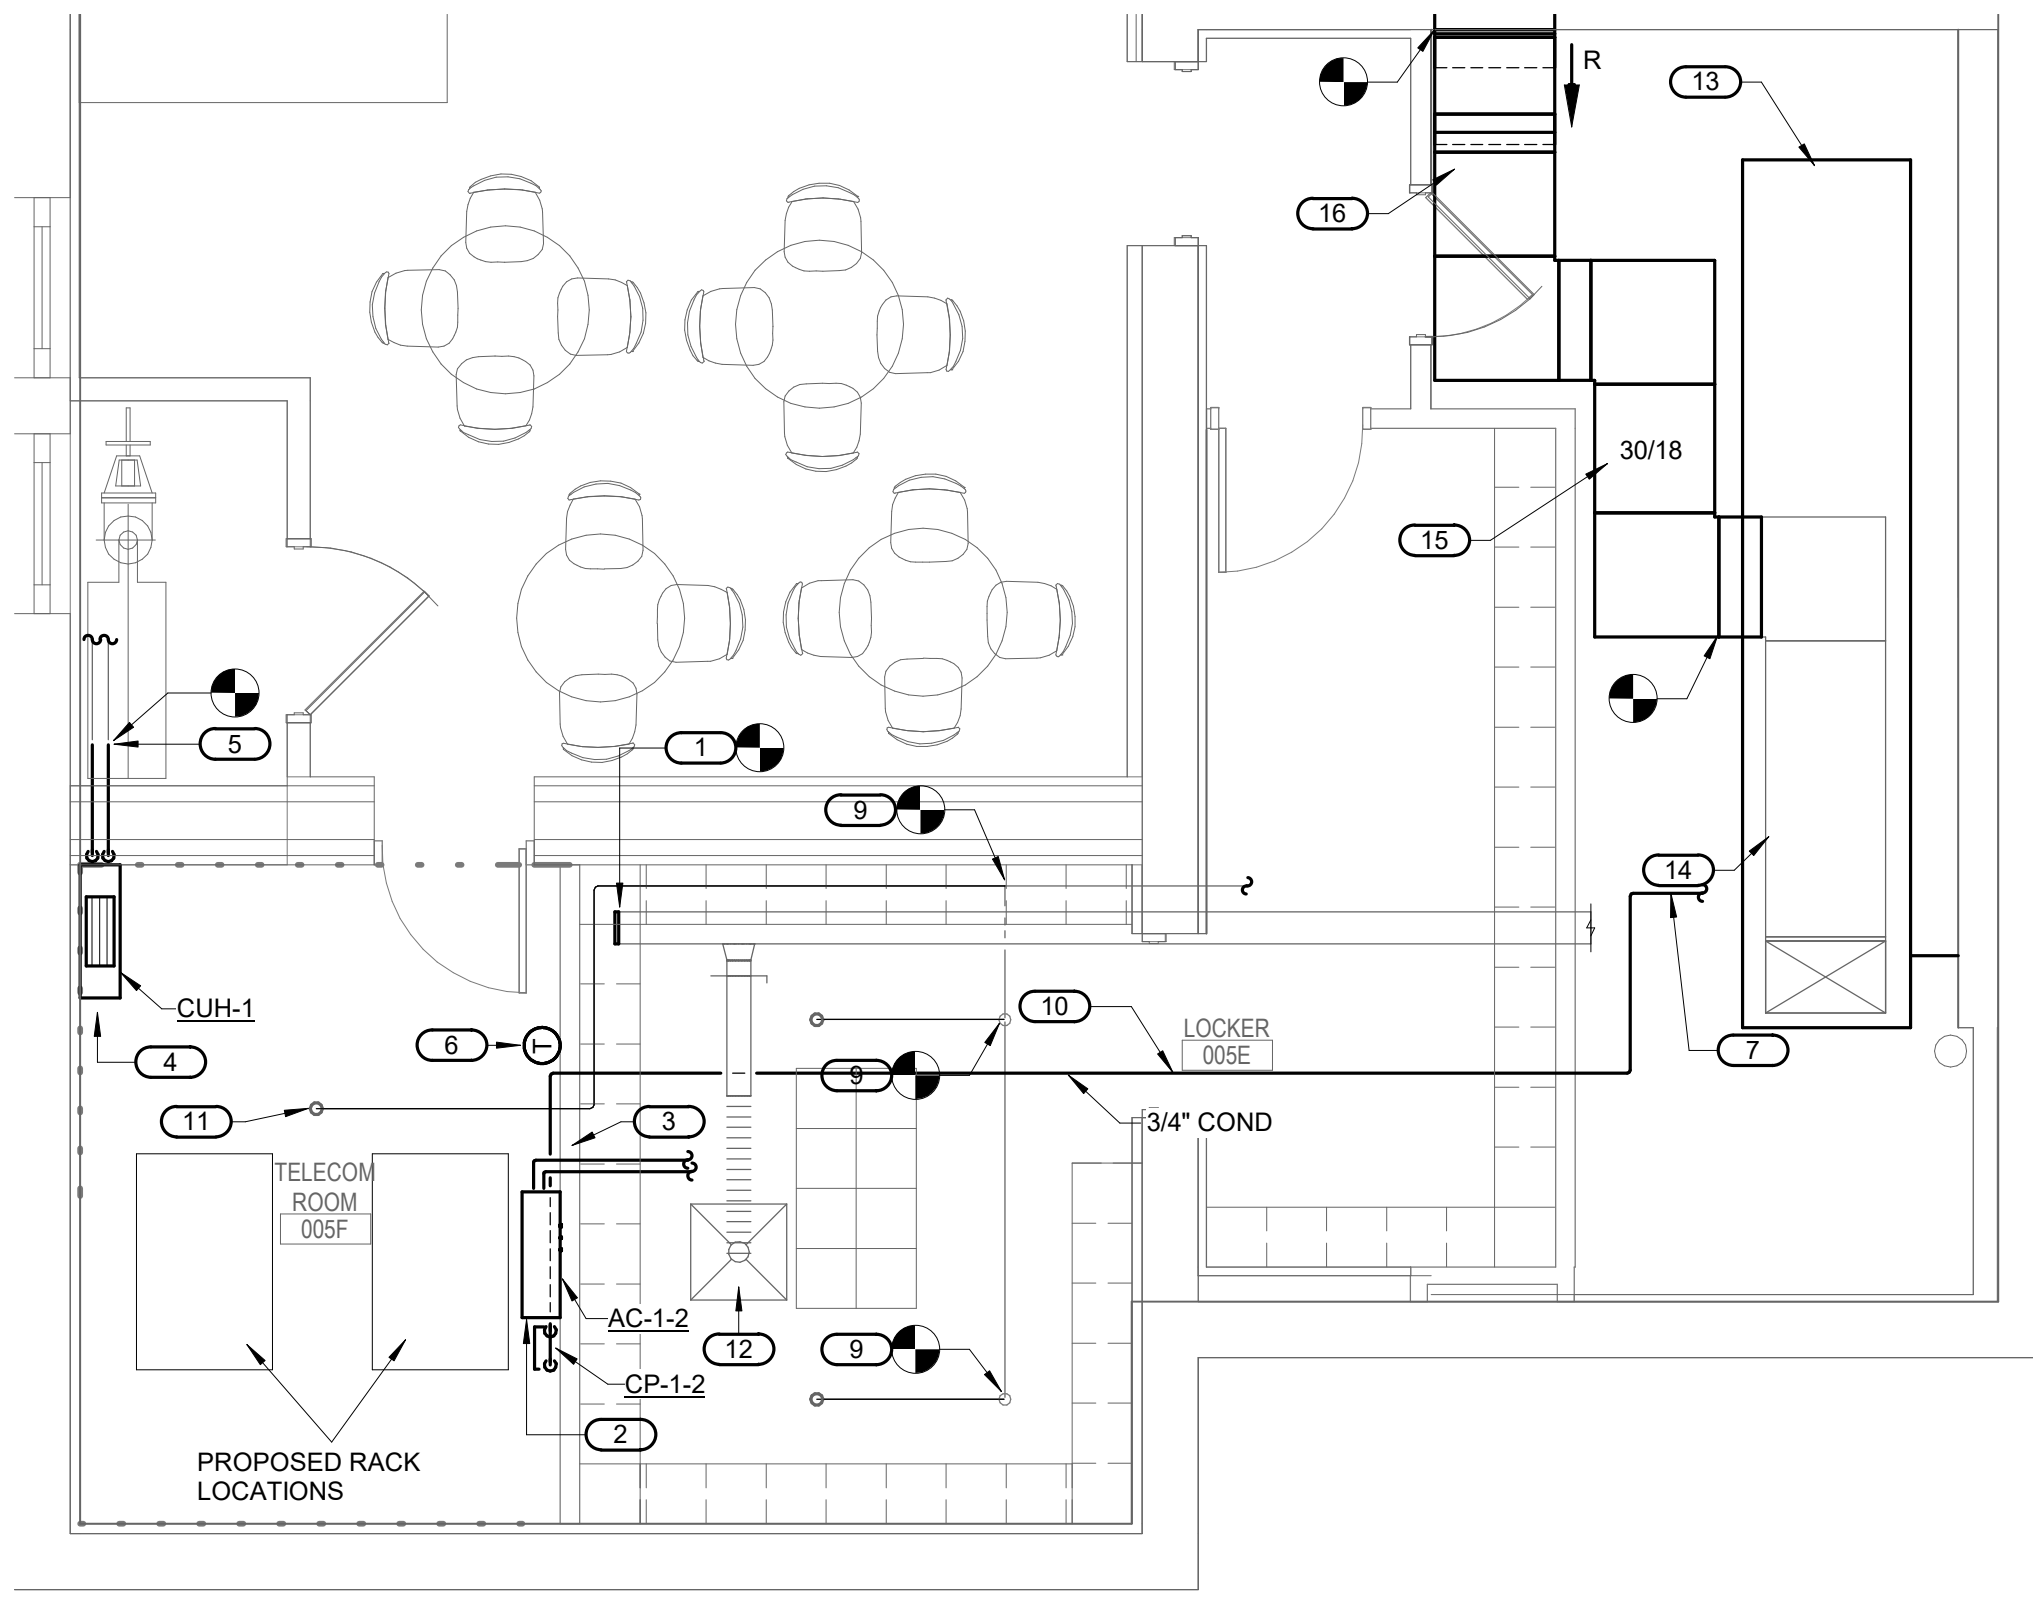

2 BASEMENT FLOOR - MECHANICAL - TELECOM 005F
1/4" = 1'-0"

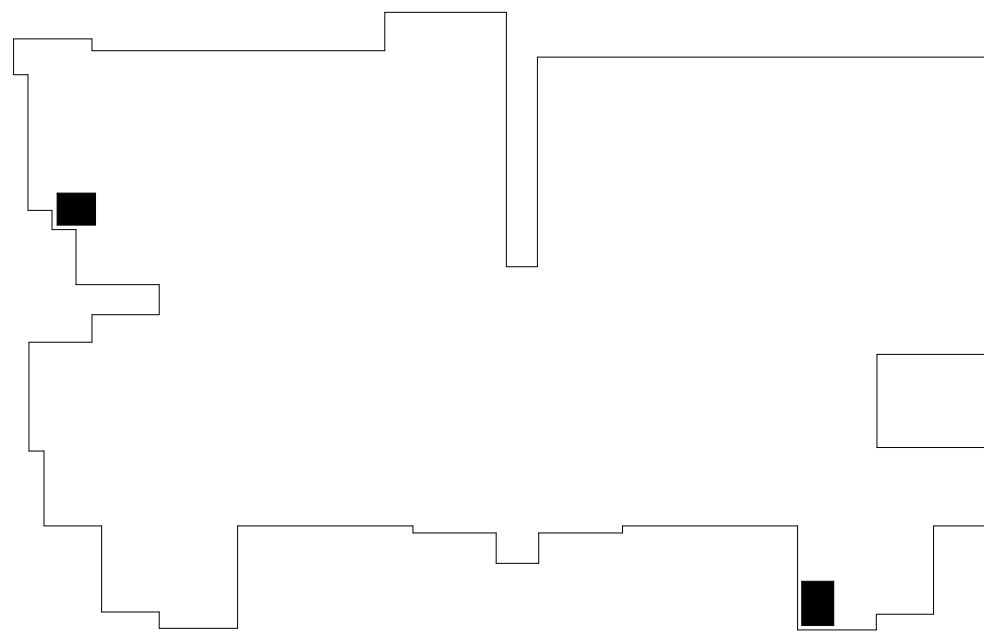

KEYPLAN - BASEMENT
NOT TO SCALE

BIM 360/21102.001 - VA St Cloud EHRM Infrastructure Upgrades-656-235-B01.M_R21.rvt 6/14/2024 8:49:24 AM

REVISION	DATE
RECORD DOCUMENTS	06/21/24
REVISION	DATE

CONSULTANT

SES SPECIALIZED ENGINEERING SOLUTIONS

10360 Ellipse Circle
Omaha, NE 68134


Phone: 402.991.5530
www.specializedeng.com

ARCHITECT/ENGINEER OF RECORD

ANDERSON

13605 1st Ave. N. #100 Plymouth, MN 55441
P 763.412.4000 | F 763.412.4090 | ae-mn.com
Anderson Engineering of Minnesota, LLC | Proj # 16305

-RECORD DOCUMENT-
June 21, 2024
This Record Document has been prepared based on Designer of Record drawings with Contractor provided markups through the construction phase of the project at the direction of the VA. While the construction information is believed to be reliable, Architect/Engineer cannot assure its accuracy, and is not responsible for the accuracy of this Record Document. Those relying on this Record Document are advised to independently verify its accuracy before applying it for any purpose.

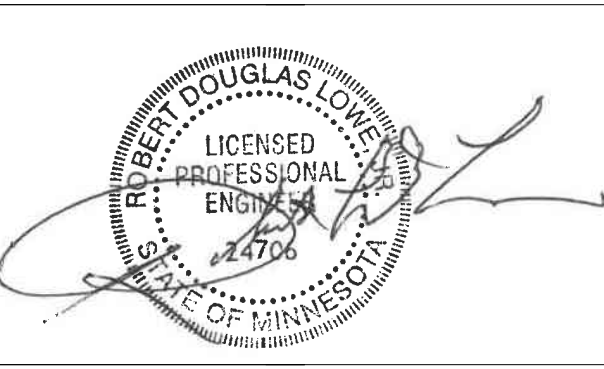

DRAWING TITLE
BASEMENT REMODEL - MECHANICAL

PROJECT TITLE	DATE
EHRM INFRASTRUCTURE UPGRADES	03/30/2022
BUILDING NO.	PLOT SCALE
1	
CHECKED BY	DRAWN
RDL	JCL
PROJECT NO.	DRAWING NO.
656-21-235	01-M200
LOCATION	FULLY SPRINKLERED
VA MEDICAL CENTER ST. CLOUD, MN 56303	DWG. OF

RECORD DOCUMENTS

VA

U.S. Department of Veterans Affairs
Veterans Health Administration
St. Cloud VA Health Care System

FIELD VERIFICATION NOTES


- THE HVAC CONTRACTOR SHALL VISIT THE SITE **PRIOR TO BID** TO FIELD VERIFY ALL EXISTING CONDITIONS WHICH MAY AFFECT THEIR BID. THE FOLLOWING ITEMS SHALL BE VERIFIED:
 - EXACT PLACEMENT, SIZE, CAPACITY MANUFACTURER AND CONDITION OF ALL EXISTING HVAC EQUIPMENT WITHIN SCOPE OF WORK, WHETHER EXPLICITLY SHOWN OR NOT.
 - SIZE AND LOCATION OF ALL EXISTING DUCTWORK.
 - SIZE AND LOCATION OF ALL EXISTING GRILLES, REGISTERS AND DIFFUSERS.
 - SIZE AND LOCATION OF ALL EXISTING THERMOSTATIC CONTROL DEVICES.
 - SIZE AND LOCATION OF ALL EXISTING PLUMBING AND HYDRONIC PIPING.
- ALL REFERENCES ON THESE DRAWINGS TO EXISTING EQUIPMENT, DUCTWORK, DIFFUSERS, THERMOSTATS AND PIPING ARE FOR REFERENCE ONLY. IT IS THE RESPONSIBILITY OF THE CONTRACTOR TO VERIFY ALL THESE ITEMS PRIOR TO BID AND INCLUDE IN THEIR BID ANY AND ALL AMOUNTS REQUIRED TO ACCOMMODATE EXISTING CONDITIONS.
- NO ALLOWANCES WILL BE MADE AFTER THE PROJECT HAS BEEN AWARDED FOR FAILURE TO VERIFY EXISTING CONDITIONS.
- ANY DISCREPANCIES WHICH MAY AFFECT THE CONTRACTORS BID SHALL BE BROUGHT TO THE ATTENTION OF THE ENGINEER AND ARCHITECT FOR DIRECTION.

KEYED NOTES 1/01-M201:


- ROUTE NEW REFRIGERANT PIPING FROM CONDENSING UNIT DOWN TO BASEMENT LEVEL CORRIDOR CO-B3 AND TO TELECOM A05C EVAPORATOR UNIT. APPROXIMATELY 70 FEET OF RUN.

KEYED NOTES 2/01-M201:


- NEW WALL-MOUNTED DUCTLESS AC UNIT AC-1-3.
- NOT USED
- ROUTE REFRIGERANT PIPING UP TO ROOF, APPROXIMATELY 45 FEET OF RUN. SEE SHEET 01-M204 FOR CONTINUATION.
- NEW THERMOSTAT.
- ROUTE NEW CONDENSATE PIPING FOR AC-1-3 TO MOP SINK IN HAC A106 APPROXIMATELY 50 FEET WEST. FIELD COORDINATE EXACT ROUTING.
- PROVIDE CONDENSATE PAN FOR ALL CONDENSATE PIPING IN TR ROOM.

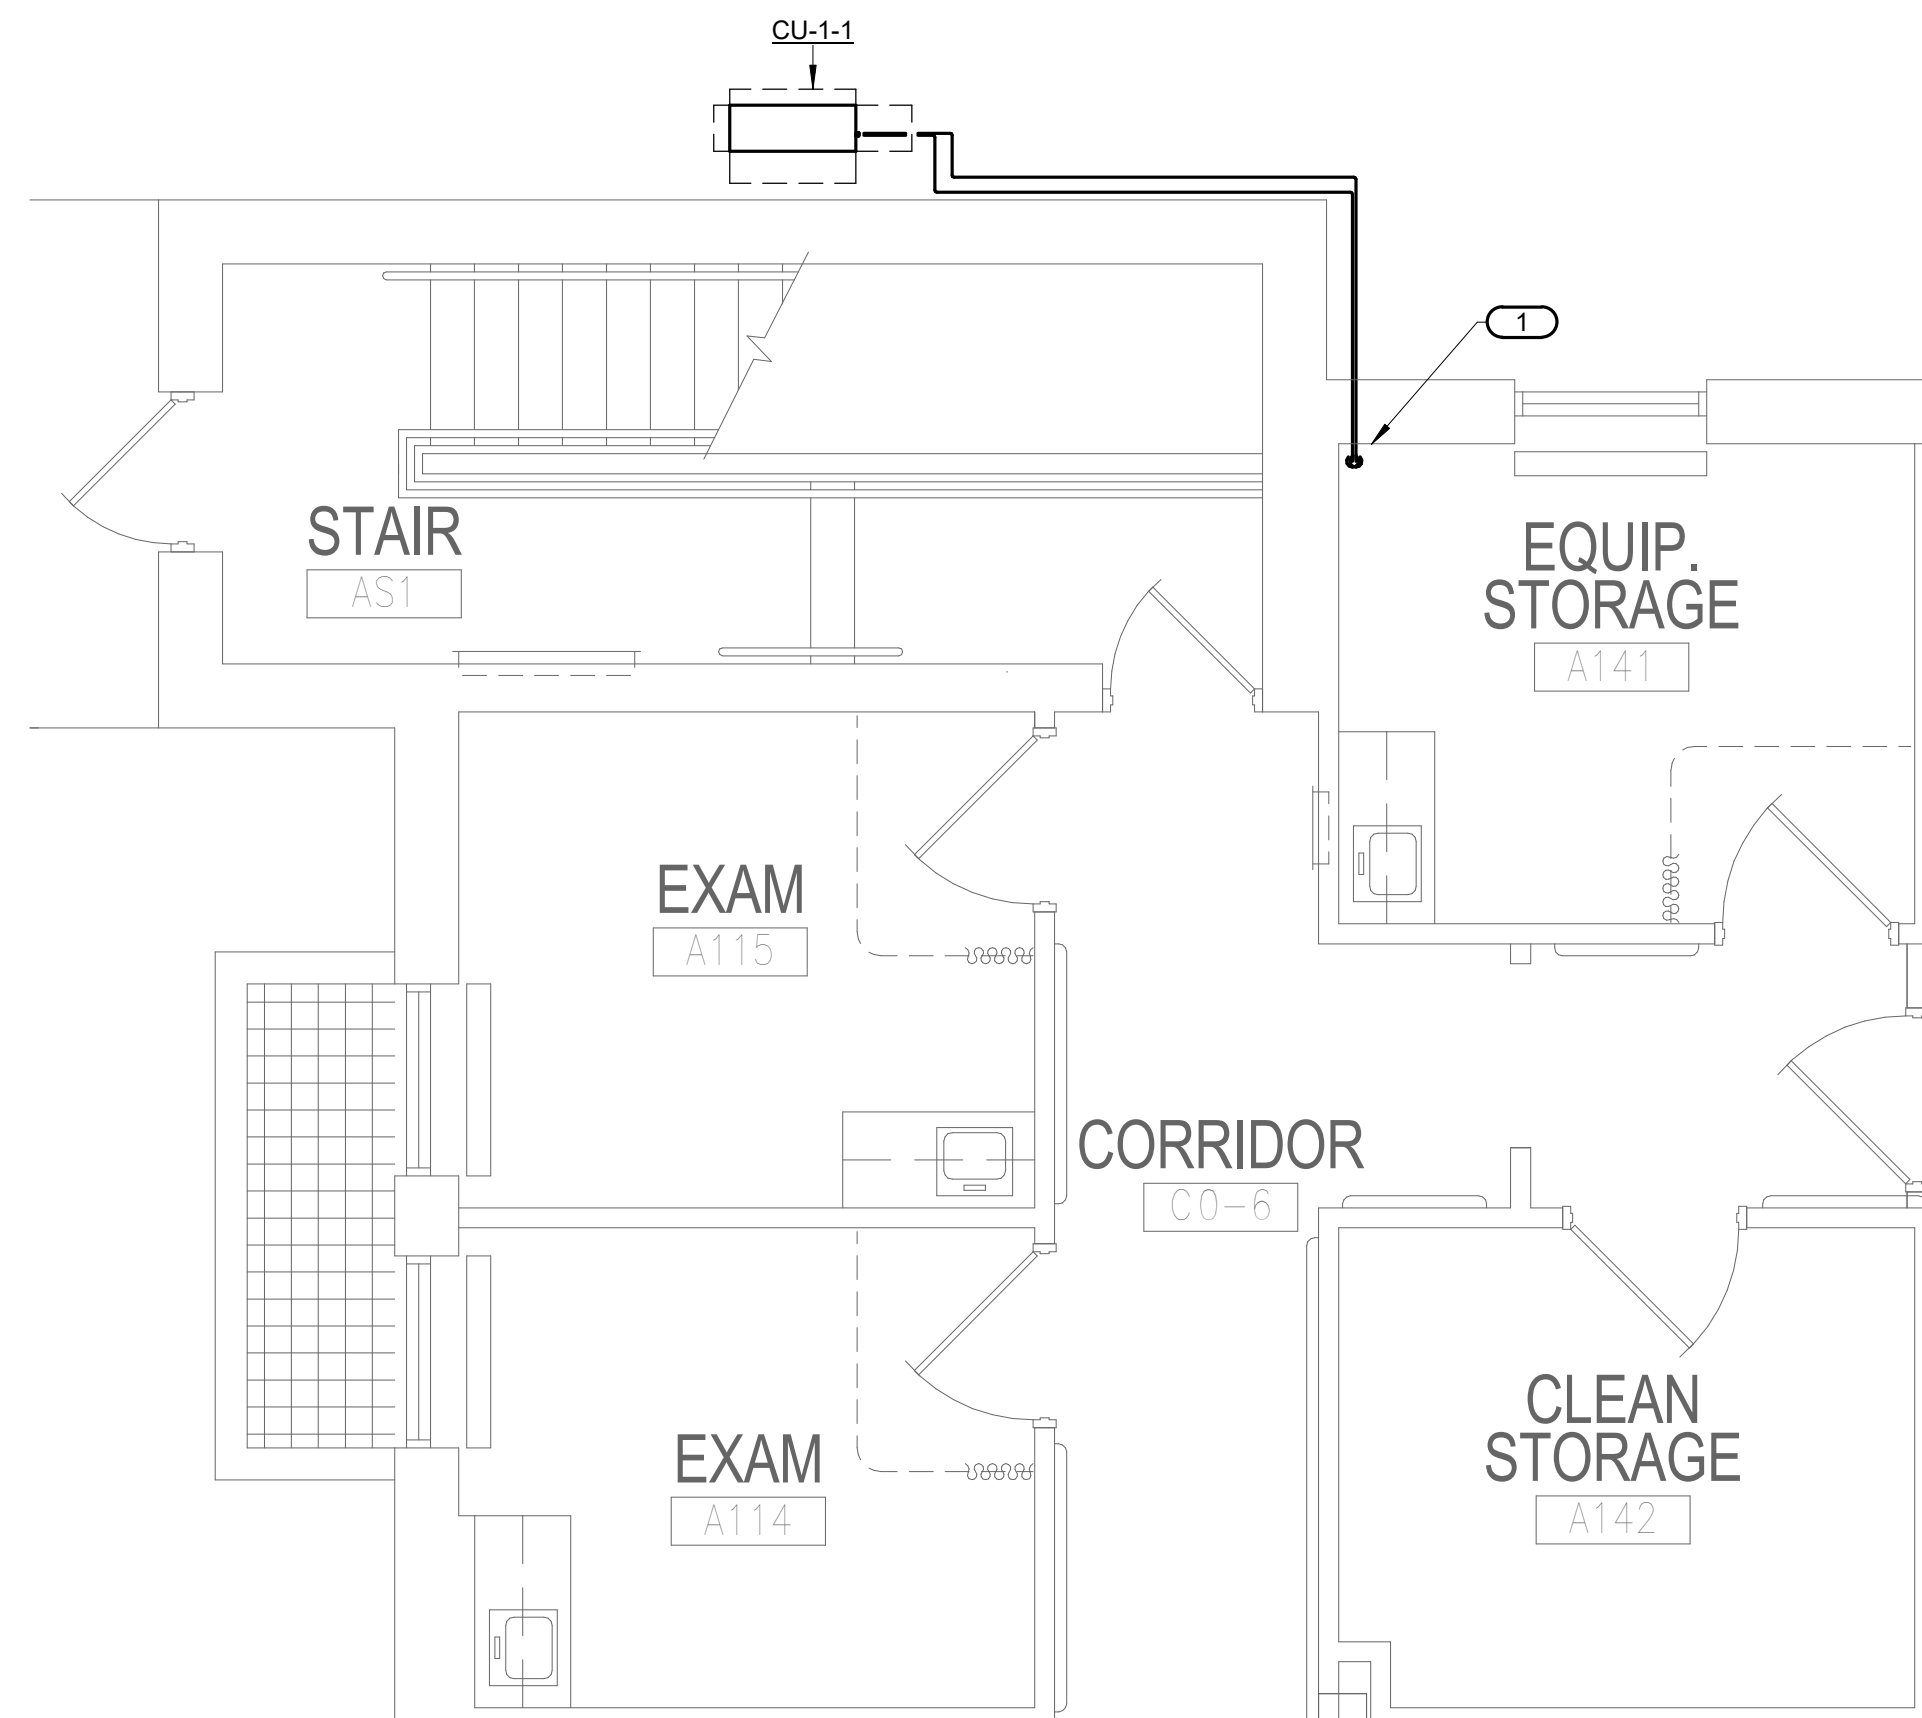

1 FIRST FLOOR - MECHANICAL - TELECOM A05C - CONDENSING UNITS
1/4" = 1'-0"

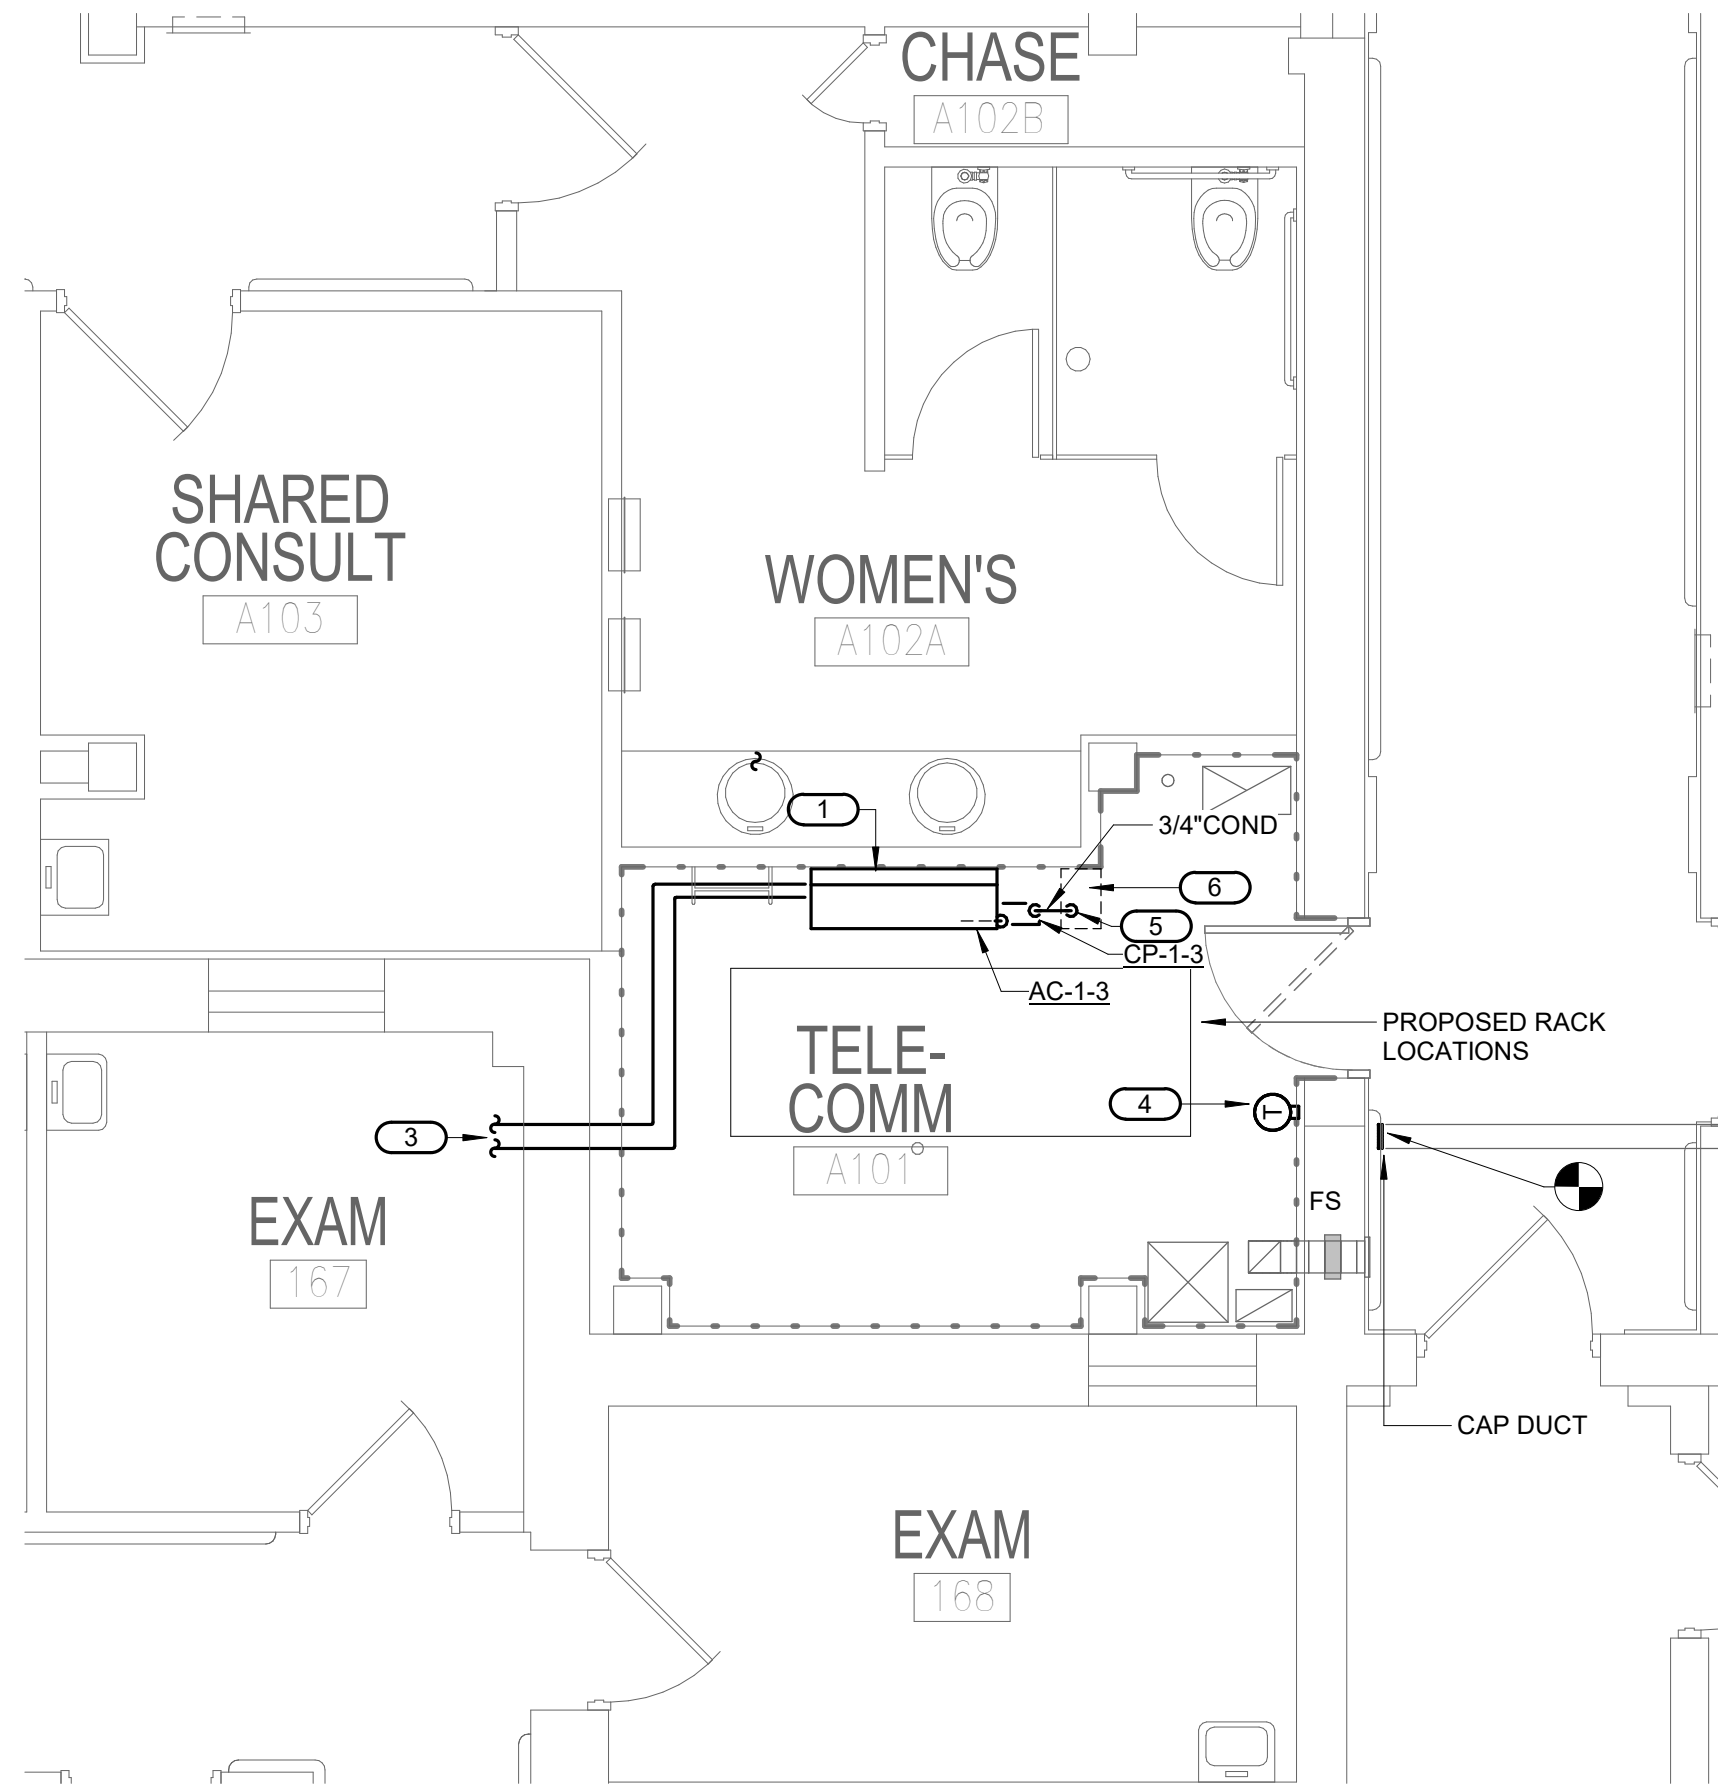

2 FIRST FLOOR - MECHANICAL - TELECOM A101
1/4" = 1'-0"

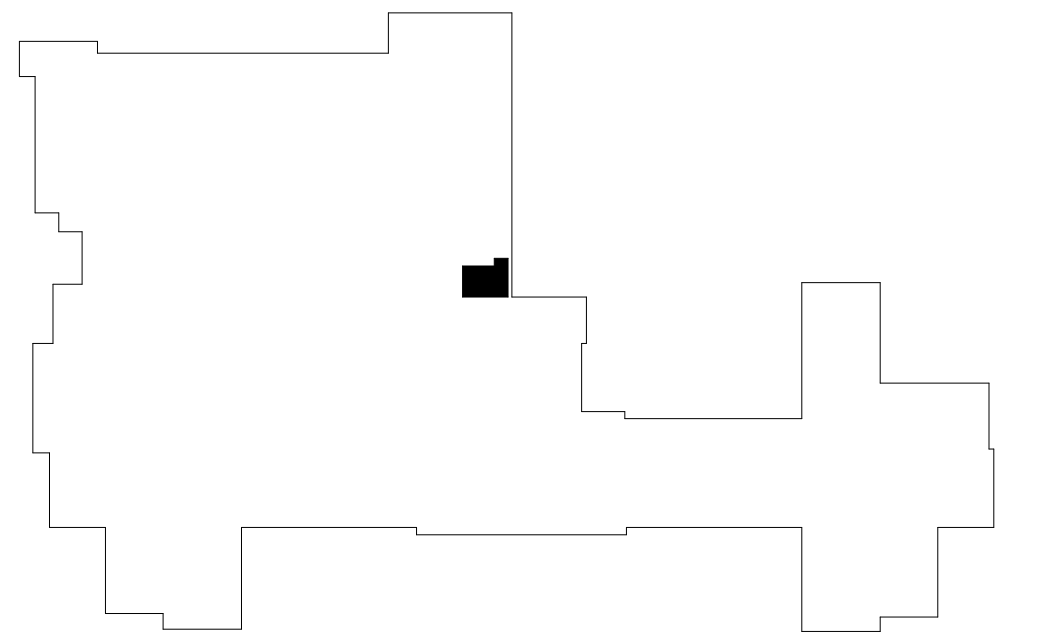

KEYPLAN - FIRST FLOOR
NOT TO SCALE

6/14/2024 8:48:27 AM
BIM 360/21102.001 - VA St Cloud EHRM Infrastructure Upgrades-656-235-B01.M_R21.rvt

RECORD DOCUMENTS		06/21/24
No.	REVISION	DATE

CONSULTANT

AST SES SPECIALIZED ENGINEERING SOLUTIONS

10360 Ellison Circle
Omaha, NE 68134


Phone: 402.991.5530
www.specializedeng.com

ARCHITECT/ENGINEER OF RECORD

ANDERSON

13605 1st Ave. N. #100 Plymouth, MN 55441
P 763.412.4000 | F 763.412.4090 | ae-mn.com
Anderson Engineering of Minnesota, LLC | Proj # 16305

-RECORD DOCUMENT-
June 21, 2024
This Record Document has been prepared based on Designer of Record drawings with Contractor provided markups through the construction phase of the project at the direction of the VA. While the construction information is believed to be reliable, Architect/Engineer cannot assure its accuracy, and is not responsible for the accuracy of this Record Document. Those relying on this Record Document are advised to independently verify its accuracy before applying it for any purpose.

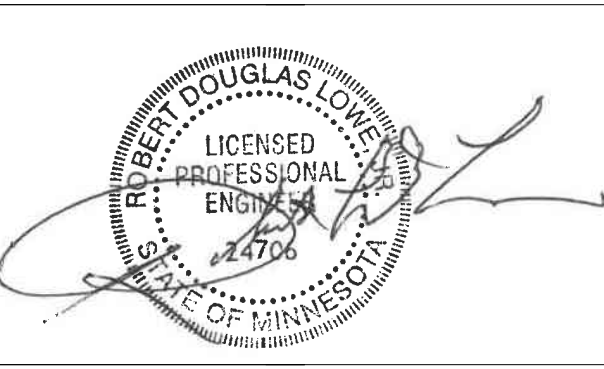

DRAWING TITLE

FIRST FLOOR REMODEL - MECHANICAL

PROJECT TITLE	DATE
EHRM INFRASTRUCTURE UPGRADES	03/30/2022
BUILDING No. 1	PLOT SCALE
CHECKED BY RDL	RECORD NO. 656-21-235
DRAWN JCL	DRAWING NO. 01-M201
LOCATION VA MEDICAL CENTER ST. CLOUD, MN 56303	FULLY SPRINKLERED
DWG. OF	

RECORD DOCUMENTS

VA

U.S. Department of Veterans Affairs
Veterans Health Administration
St. Cloud VA Health Care System


FIELD VERIFICATION NOTES

- THE HVAC CONTRACTOR SHOULD VISIT THE SITE **PRIOR TO BID** TO FIELD VERIFY ALL EXISTING CONDITIONS WHICH MAY AFFECT THEIR BID. THE FOLLOWING ITEMS SHALL BE VERIFIED:
 - EXACT PLACEMENT, SIZE, CAPACITY MANUFACTURER AND CONDITION OF ALL EXISTING HVAC EQUIPMENT WITHIN SCOPE OF WORK, WHETHER EXPLICITLY SHOWN OR NOT.
 - SIZE AND LOCATION OF ALL EXISTING DUCTWORK.
 - SIZE AND LOCATION OF ALL EXISTING GRILLES, REGISTERS AND DIFFUSERS.
 - SIZE AND LOCATION OF ALL EXISTING THERMOSTATIC CONTROL DEVICES.
 - SIZE AND LOCATION OF ALL EXISTING PLUMBING AND HYDRONIC PIPING.
- ALL REFERENCES ON THESE DRAWINGS TO EXISTING EQUIPMENT, DUCTWORK, DIFFUSERS, THERMOSTATS AND PIPING ARE FOR REFERENCE ONLY. IT IS THE RESPONSIBILITY OF THE CONTRACTOR TO VERIFY ALL THESE ITEMS PRIOR TO BID AND INCLUDE IN THEIR BID ANY AND ALL AMOUNTS REQUIRED TO ACCOMMODATE EXISTING CONDITIONS.
- NO ALLOWANCES WILL BE MADE AFTER THE PROJECT HAS BEEN AWARDED FOR FAILURE TO VERIFY EXISTING CONDITIONS.
- ANY DISCREPANCIES WHICH MAY AFFECT THE CONTRACTORS BID SHALL BE BROUGHT TO THE ATTENTION OF THE ENGINEER AND ARCHITECT FOR DIRECTION.

KEYED NOTES 1/01-M202:



1

- REINSTALL ORIGINAL ROOF MOUNTED AIR COOLED CONDENSING UNIT IN NEW LOCATION. RECHARGE SYSTEM WITH REFRIGERANT CAPTURED PRIOR TO REMOVAL. REFER TO DETAIL 301-GM400.
- NEW WALL-MOUNTED DUCTLESS COOLING UNIT AC-1-4
- ROUTE REFRIGERANT PIPING UP TO ROOF - SEE SHEET 01-M204 FOR CONTINUATION.
- NEW CABINET UNIT HEATER CUH-2.
- NEW 3/4" HWS/R PIPING. ROUTE PIPING APPROXIMATELY 75 FEET NORTH AND CONNECT TO EXISTING HWS AND HWR MAINS. PROVIDE BRANCH LINE ISOLATION VALVES AND BALANCING VALVES. FIELD VERIFY EXACT LOCATION.
- NEW THERMOSTAT. WIRE AS COMMON TO BOTH AC UNITS AND CUH-2.
- NEW FIRE PROTECTION SPRINKLER HEAD. EXTEND NEW BRANCH LINE OFF EXISTING MAIN. FIELD VERIFY EXACT LOCATION.
- ROUTE NEW CONDENSATE PIPING FOR AC-1-4 TO NEAREST FLOOR DRAIN. FIELD COORDINATE EXACT ROUTING.
- PROVIDE CONDENSATE PAN FOR ALL CONDENSATE PIPING WITHIN TELECOM ROOM A200.

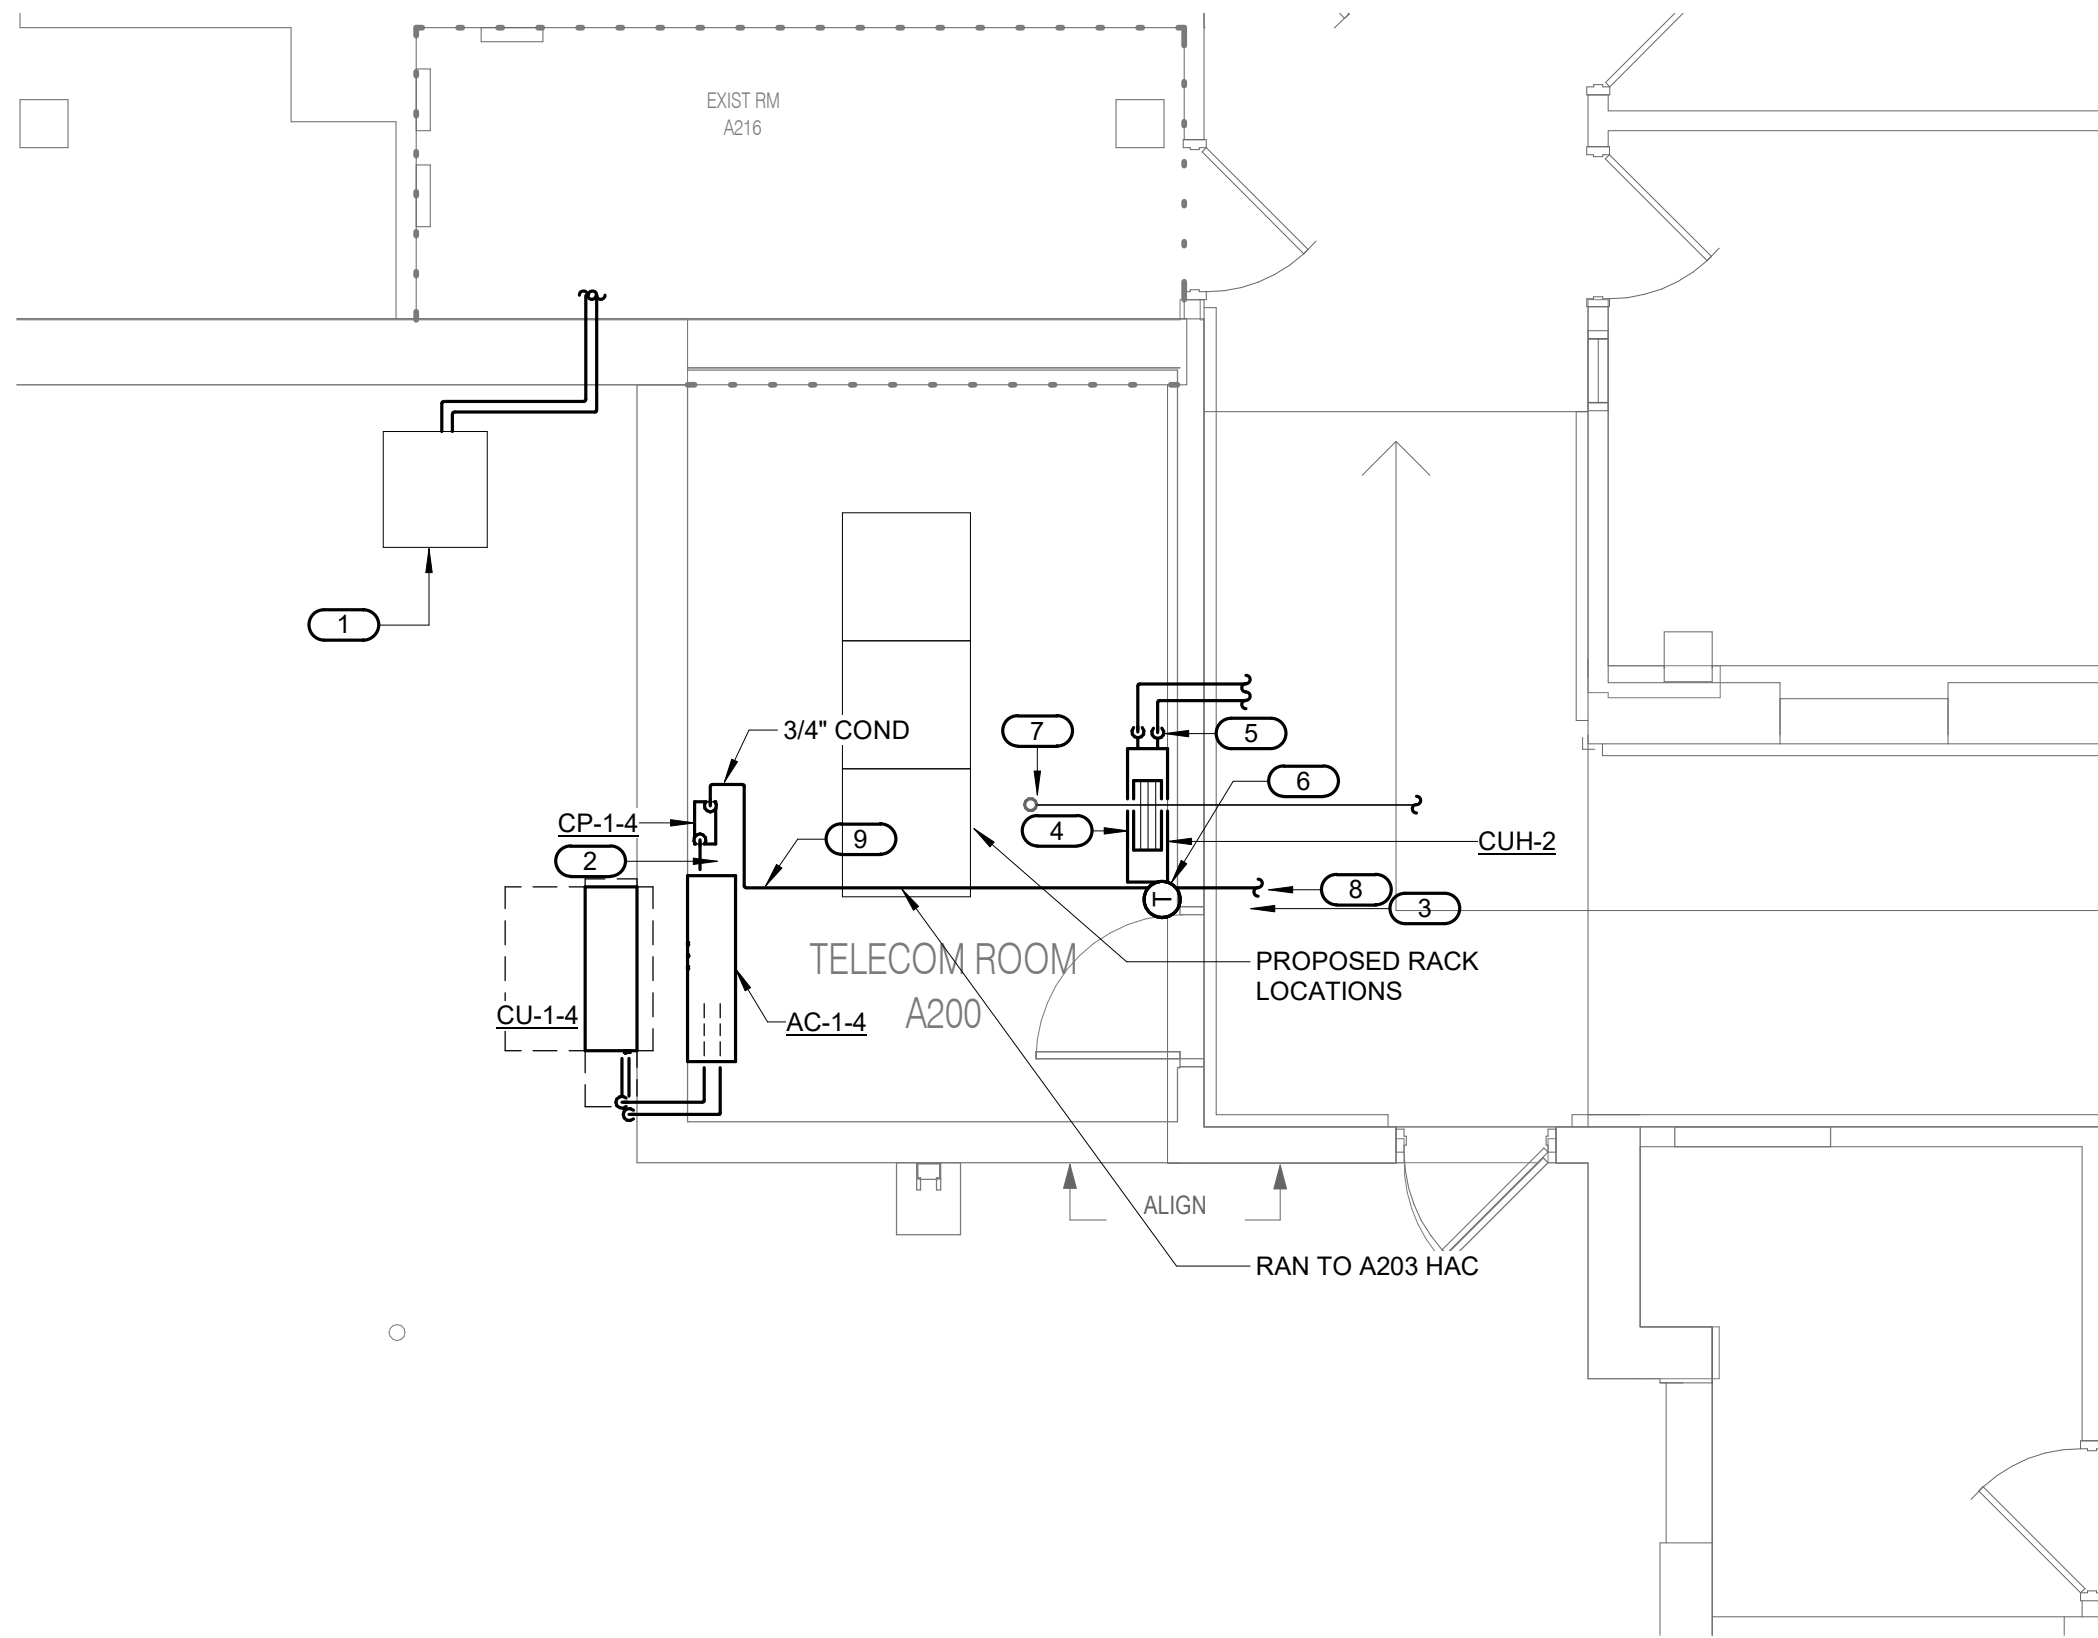

1 SECOND FLOOR - MECHANICAL - TELECOM A200

1/4" = 1'-0"

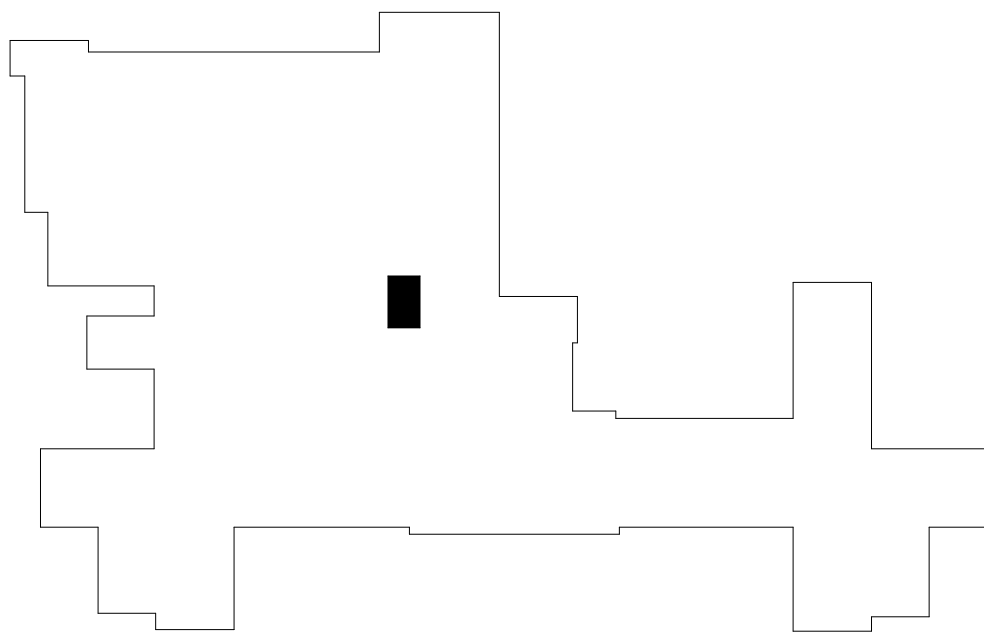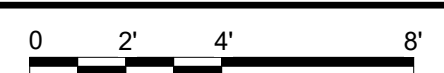

KEYPLAN - SECOND FLOOR
NOT TO SCALE

6/14/2024 8:49:29 AM
BIM 360/21102.001 - VA St Cloud EHRM Infrastructure Upgrades-656-235.B01.M_R21.rvt

RECORD DOCUMENTS		06/21/24
No.	REVISION	DATE

CONSULTANT



**SPECIALIZED
ENGINEERING
SOLUTIONS**

10360 Ellipse Circle
Omaha, NE 68134


Phone: 402.991.5520
www.specializedeng.com

ARCHITECT/ENGINEER OF RECORD

ANDERSON

13605 1st Ave. N. #100 Plymouth, MN 55441
P 763.412.4000 | F 763.412.4090 | ae-mn.com
Anderson Engineering of Minnesota, LLC | Proj # 16305

-RECORD DOCUMENT-
June 21, 2024
This Record Document has been prepared based on Designer of Record drawings with Contractor provided markups through the construction phase of the project at the direction of the VA. While the construction information is believed to be reliable, Architect/Engineer cannot assure its accuracy, and is not responsible for the accuracy of this Record Document. Those relying on this Record Document are advised to independently verify its accuracy before applying it for any purpose.

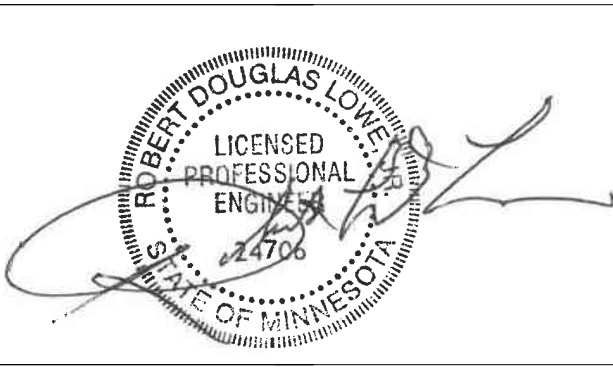

DRAWING TITLE


**SECOND FLOOR REMODEL -
MECHANICAL**

PROJECT TITLE	EHRM INFRASTRUCTURE UPGRADES	DATE	03/30/2022
BUILDING No.	1	CHECKED BY	RDL
LOCATION	VA MEDICAL CENTER ST. CLOUD, MN 56303	DRAWN	JCL
RECORD NO.	656-21-235	DRAWING NO.	01-M202
FULLY SPRINKLERED		DWG. OF	

RECORD DOCUMENTS



**U.S. Department
of Veterans Affairs**
Veterans Health
Administration
St. Cloud VA
Health Care System

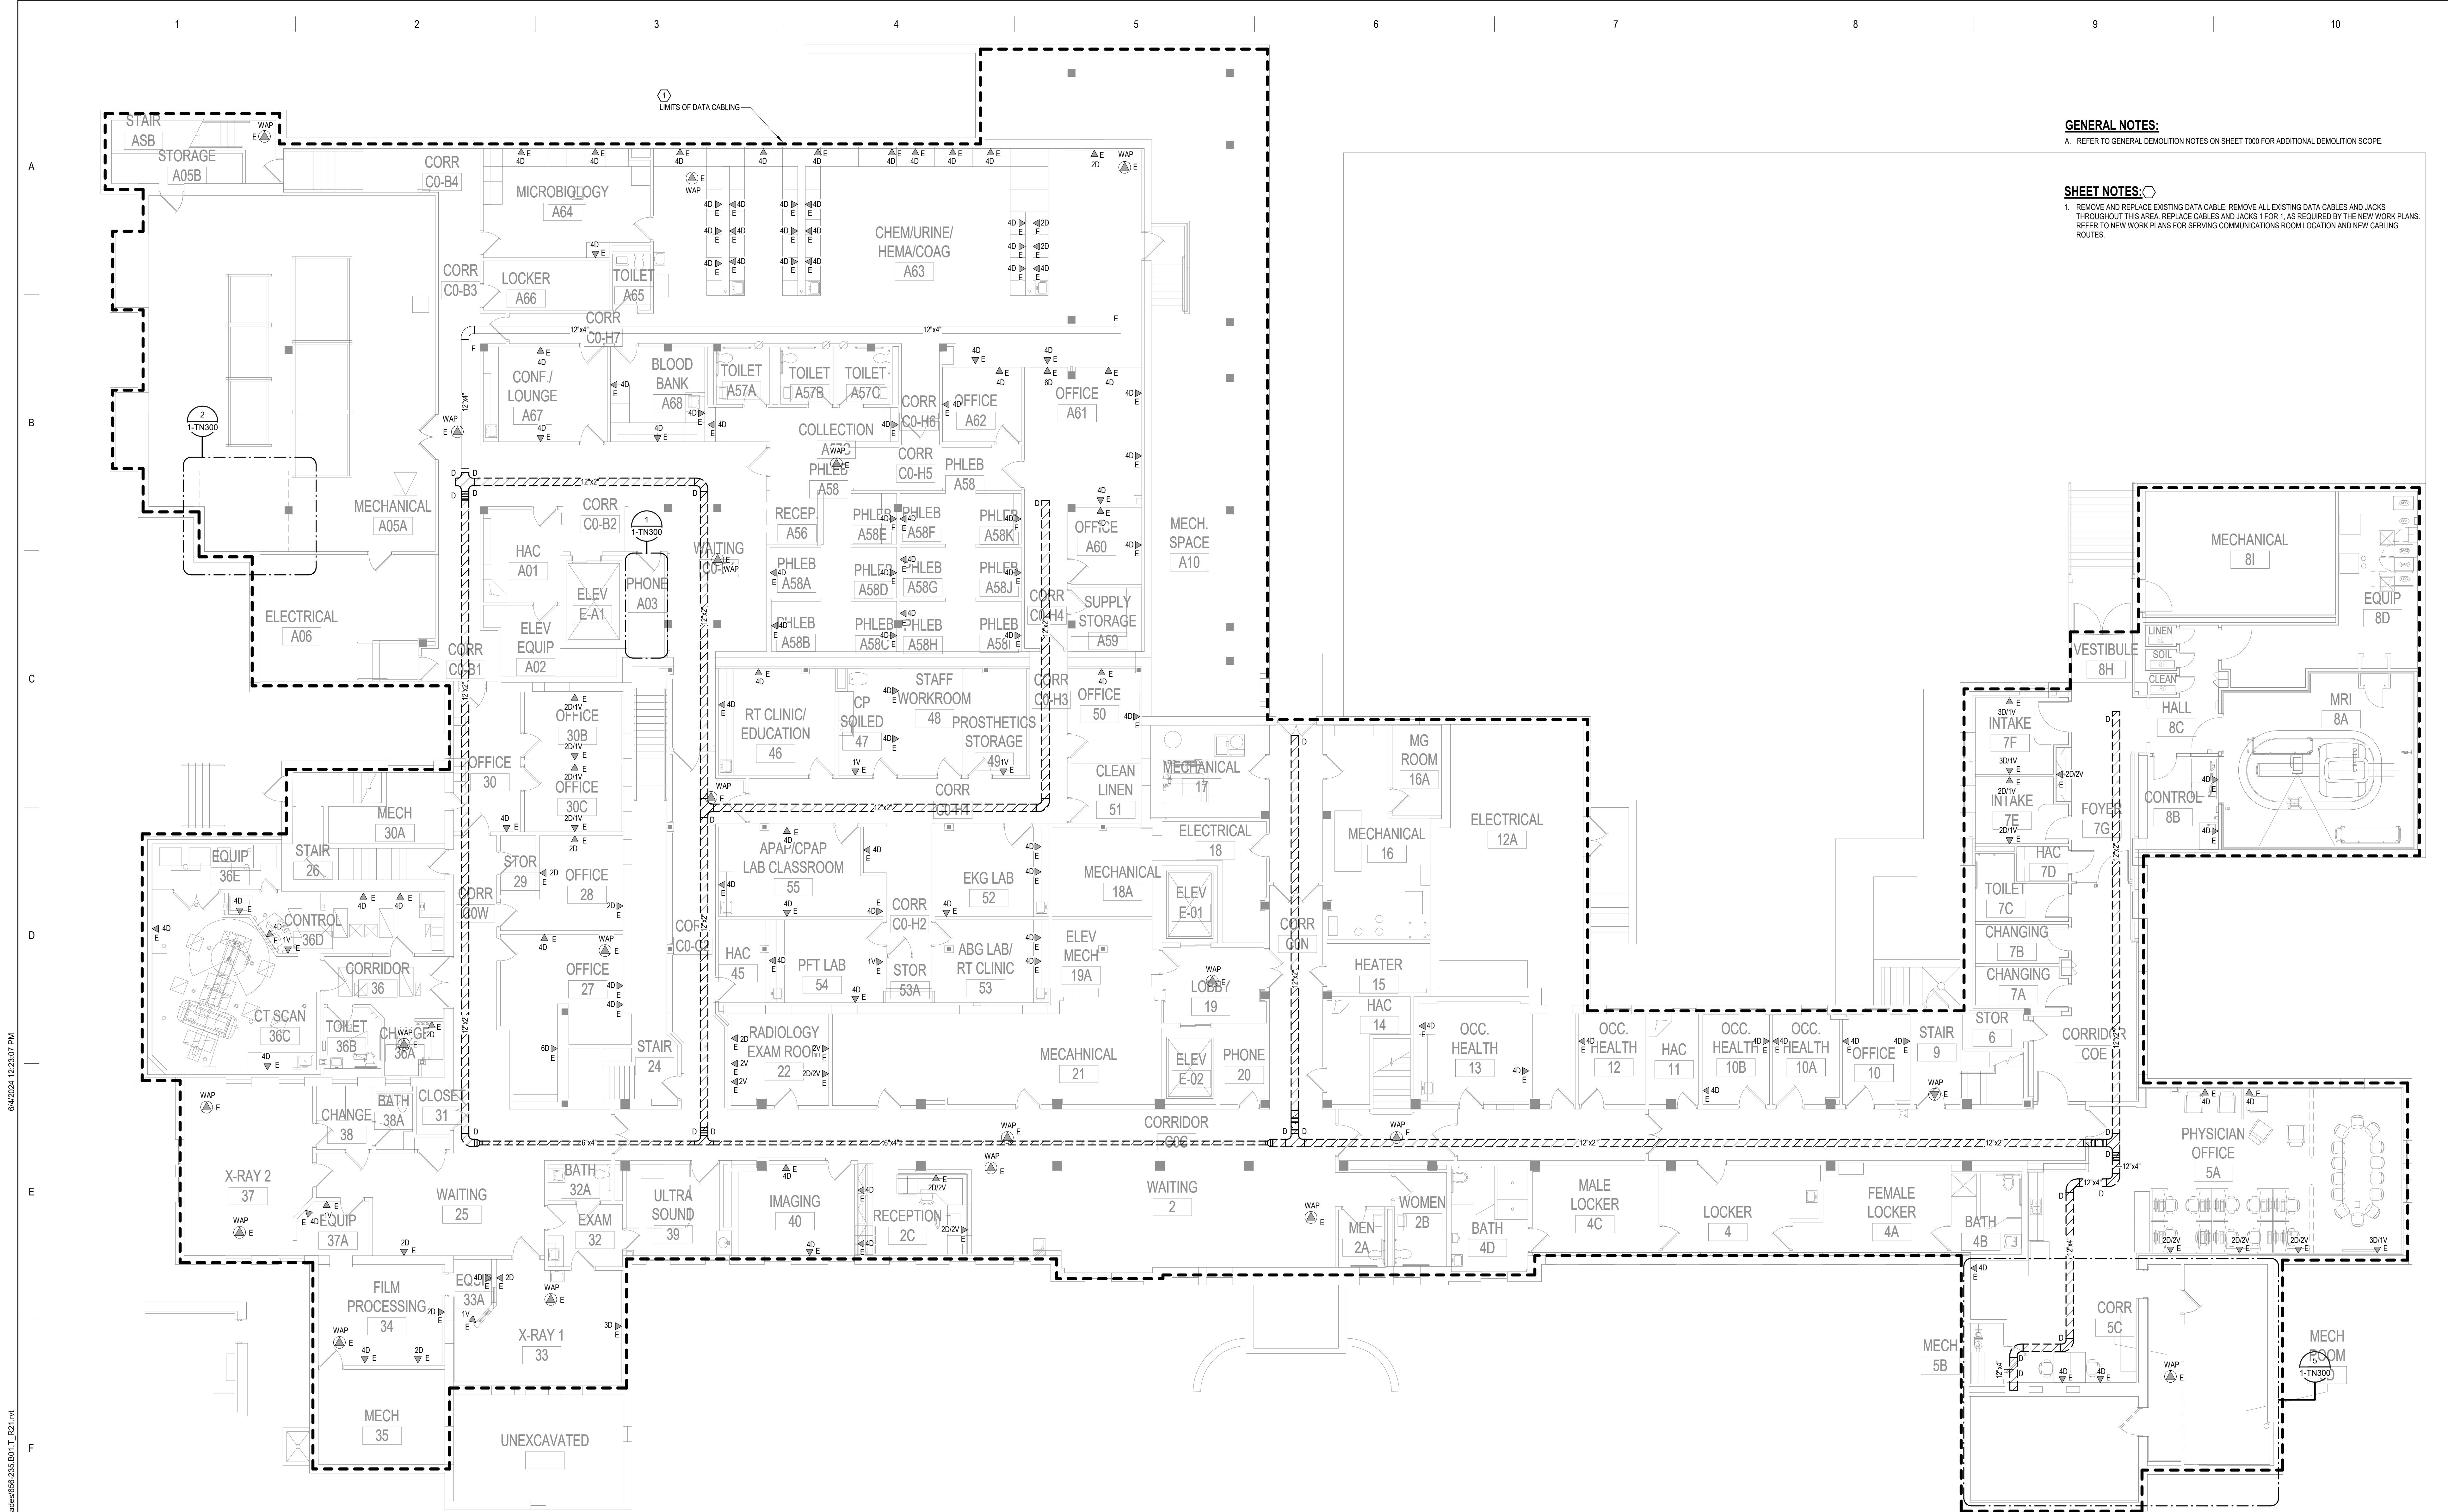

GENERAL NOTES:
A. REFER TO GENERAL DEMOLITION NOTES ON SHEET T000 FOR ADDITIONAL DEMOLITION SCOPE.

SHEET NOTES:
1. REMOVE AND REPLACE EXISTING DATA CABLE. REMOVE ALL EXISTING DATA CABLES AND JACKS THROUGHOUT THIS AREA. REPLACE CABLES AND JACKS 1 FOR 1, AS REQUIRED BY THE NEW WORK PLANS. REFER TO NEW WORK PLANS FOR SERVING COMMUNICATIONS ROOM LOCATION AND NEW CABLEING ROUTES.

1 BASEMENT FLOOR PLAN - TELECOM - DEMOLITION
1/8" = 1'-0"



BIM 360://21102.001 - VA St Cloud EHRM Infrastructure Upgrades/656-235 B01 T_R21.rvt
6/4/2024 12:23:07 PM

RECORD DOCUMENTS	
No.	REVISION
1	DATE

CONSULTANT

AST SES SPECIALIZED ENGINEERING SOLUTIONS

10360 Ellipse Circle
Omaha, NE 68134

Phone: 402.991.5520
www.specializedeng.com

ARCHITECT/ENGINEER OF RECORD

ANDERSON

13605 1st Ave. N. #100 Plymouth, MN 55441
P 763.412.4000 | F 763.412.4090 | ae-mn.com
Anderson Engineering of Minnesota, LLC | Proj # 16305

-RECORD DOCUMENT-
June 21, 2024
This Record Document has been prepared based on Designer of Record drawings with Contractor provided markups through the construction phase of the project at the direction of the VA. While the construction information is believed to be reliable, Architect/Engineer cannot assure its accuracy, and is not responsible for the accuracy of this Record Document. Those relying on this Record Document are advised to independently verify its accuracy before applying it for any purpose.

DRAWING TITLE
BASEMENT FLOOR PLAN -
TELECOM - DEMOLITION


PROJECT FILE EHRM INFRASTRUCTURE UPGRADES	DATE 03/30/2022
BUILDING No. 1	CHECKED BY KSB
DESIGNED BY SSK	DRAWN BY 1-TD100
LOCATION VA MEDICAL CENTER ST. CLOUD, MN 56303	FULLY SPRINKLERED

RECORD DOCUMENTS

VA

U.S. Department
of Veterans Affairs
Veterans Health
Administration
St. Cloud VA
Health Care System


6/4/2024 12:23:09 PM
BIM 360://21102.001 - VA St. Cloud EHRM Infrastructure Upgrades/656-235 B01.T_R21.rvt

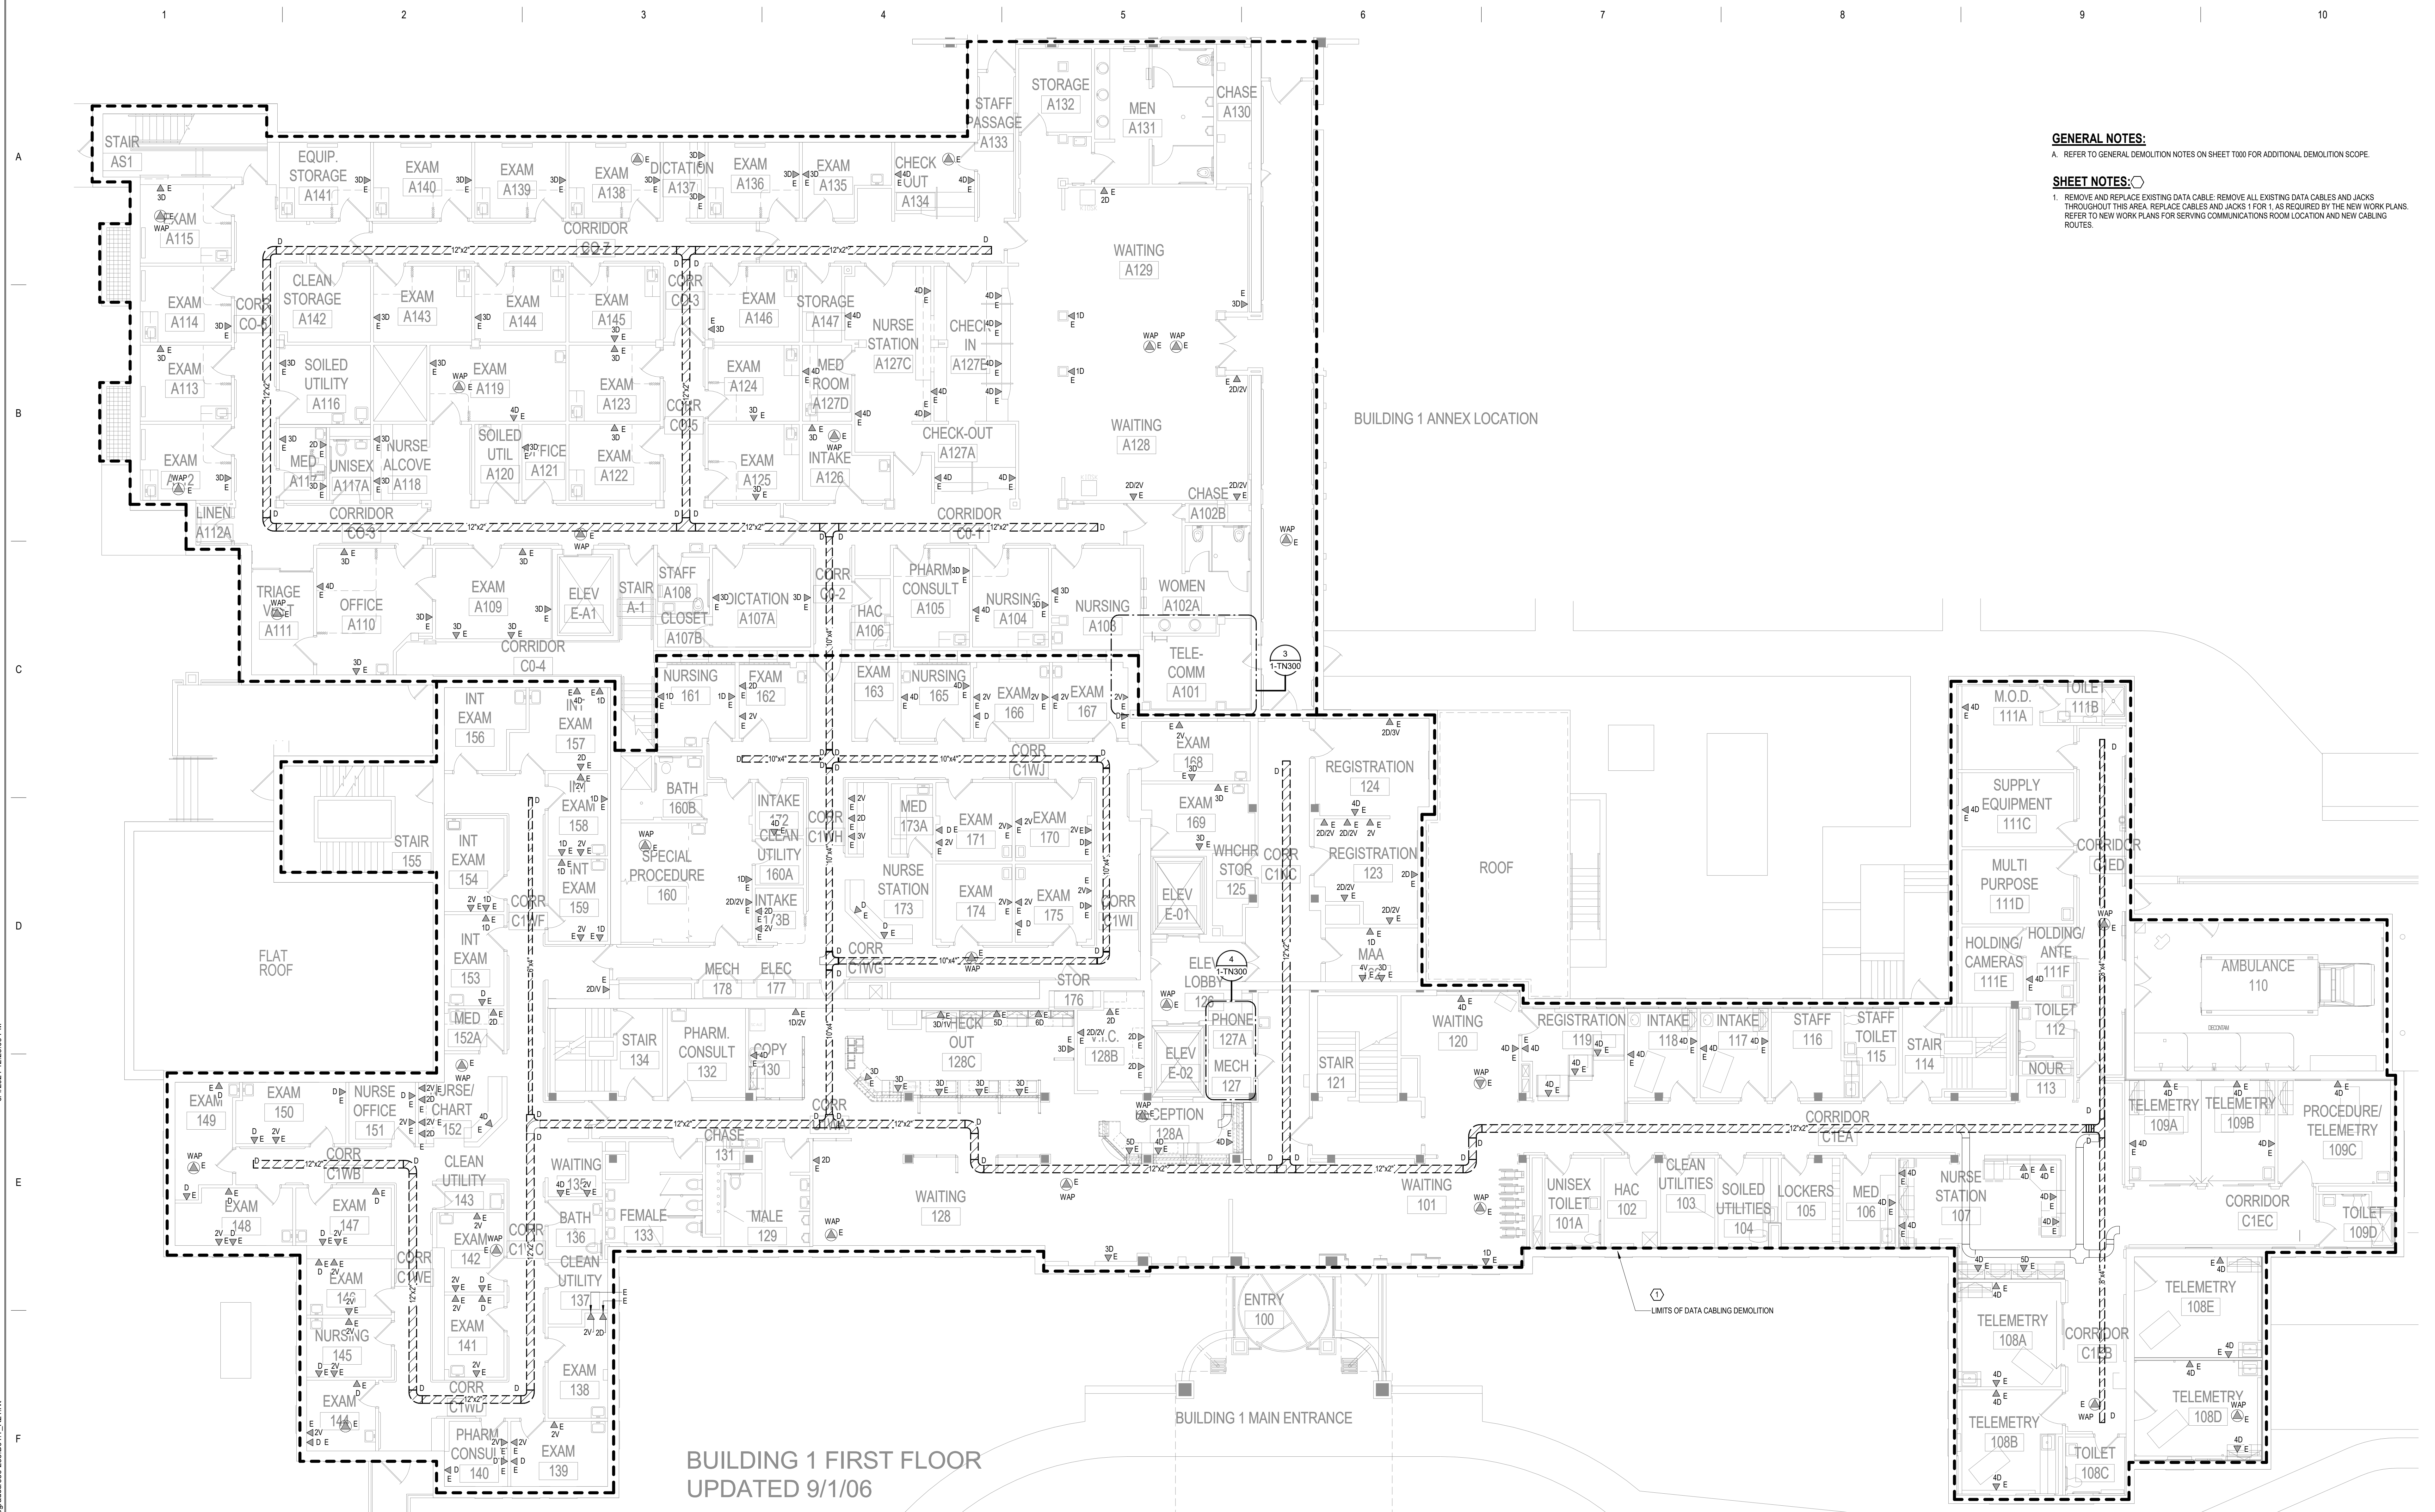

GENERAL NOTES:
A. REFER TO GENERAL DEMOLITION NOTES ON SHEET T000 FOR ADDITIONAL DEMOLITION SCOPE.

SHEET NOTES:
1. REMOVE AND REPLACE EXISTING DATA CABLE: REMOVE ALL EXISTING DATA CABLES AND JACKS THROUGHOUT THIS AREA. REPLACE CABLES AND JACKS 1 FOR 1, AS REQUIRED BY THE NEW WORK PLANS. REFER TO NEW WORK PLANS FOR SERVING COMMUNICATIONS ROOM LOCATION AND NEW CABLING ROUTES.

1 FIRST FLOOR PLAN - TELECOM - DEMOLITION
1/8" = 1'-0"

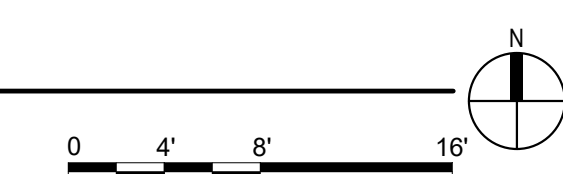

RECORD DOCUMENTS		CONSULTANT		ARCHITECT/ENGINEER OF RECORD		-RECORD DOCUMENT-		DRAWING TITLE		PROJECT FILE		DATE		U.S. Department of Veterans Affairs	
No		AST SES SPECIALIZED ENGINEERING SOLUTIONS		ANDERSON		June 21, 2024		FIRST FLOOR PLAN - TELECOM - DEMOLITION		EHRM INFRASTRUCTURE UPGRADES		03/30/2022		Veterans Health Administration	
REVISION		10360 Illinois Circle Omaha, NE 68134		13605 1st Ave. N. #100 Plymouth, MN 55441		This Record Document has been prepared based on Designer of Record drawings with Contractor provided markups through the construction phase of the project at the direction of the VA. While the construction information is believed to be reliable, Architect/Engineer cannot assure its accuracy, and is not responsible for the accuracy of this Record Document. Those relying on this Record Document are advised to independently verify its accuracy before applying it for any purpose.		BUILDING No 1		CHECKED BY KSB		DRAWN BY SSK		ST. Cloud VA	
DATE		06/21/24		P 763.412.4000 F 763.412.4090 ae-mn.com		Anderson Engineering of Minnesota, LLC Proj # 16305		1		656-21-235		1-TD110		Health Care System	
		www.specializedeng.com						LOCATION VA MEDICAL CENTER ST. CLOUD, MN 56303		FULLY SPRINKLERED		DWS OF			