

Design Revision 02

eProjects Work Order Number: 1788443

Building: Naval Station Norfolk, VA Waterfront

Project Title: FY25 / FY26 Maintenance Dredging @ Naval Station, Norfolk

Date: 13 August 2025

Design Revision Purpose

1. Corrections to Contract Documents in Responses to PPIs.
2. Revised Bid Schedule.
3. Additional Information on Existing Conditions @ Pier 11 North Tee.

Drawing Revisions

The following drawings are revised as of 8/13/2025, and accompany this Design Revision:

SHEET NO.		NAVFAC DRAWING NO.	SHEET TITLE
NO.	SHEET		
GENERAL			
2	V-002	12.919.176	DETAIL SHEET

Specification Revisions

The following specifications are revised as noted below on 8/13/2025:

DIVISION 01 – GENERAL REQUIREMENTS

01 14 00 – WORK RESTRICTIONS

1.2 SPECIAL SCHEDULING REQUIREMENTS: Part b., delete Paragraphs “Preferred Schedule” and “Alternative Scheule” and replace with the following Paragraph, “The following days are available to the Contractor for execution of the FY25 Maintenance Dredging project: Monday, October 13, 2025 thru Monday, December 15, 2025 and Monday, January 12, 2026 thru Monday, April 13, 2026. Any dredging during the time period from Tuesday, December 16, 2025 thru Sunday, January 11, 2026 is subject to Paragraph 1.2, Part e of this specification section.”

1.2 SPECIAL SCHEDULING REQUIREMENTS: Part e., delete, “15 Nov – 15 Jan” and replace with “16 Dec – 11 Jan”.

01 20 00 – PRICE AND PAYMENT PROCEDURES

1.8.1 PAYMENT: delete the following from this paragraph, “and disposal at an upland facility”

DIVISION 35 – WATERWAY AND MARINE CONSTRUCTION

35 20 23 – DREDGING

3.3.3 CHARGES FOR MATERIAL PLACEMENT: delete Paragraph in its entirety.

Bid Schedule

Delete Bid Scheule and replace with revised Bid Scheule that is provided at the end of this Design Revision.

Additional information


Additional information is included in this Design Revision including Post Demolition Survey Submittal from Pier 11 North Tee Demolition project and (2) Drawings Sheets from the Pier 11 North Tee Demolition project which shows the general locations, number, sizes, and diameters of piles to be cutoff in the Pier 11 North Tee area as denoted in Design Revision 01.

FILE NAME: \$(getvar, "dgnprefix")\$(getvar, "dgnname") LAYOUT NAME: \$(getvar, "CTAB") PLOTTED:\$(edtime, 0, DDDD) MONTH DD" YY" - HMMmm/pm) USER: \$(getvar, "LOGINNAME")

NAVAL STATION NORFOLK - FY25 - ESTIMATED DREDGING VOLUME							
DREDGE AREA ID	DREDGE AREA DESCRIPTION	DREDGE AREA (SY)	CONTRACT DEPTH (FT) (MLLW)	OVER DREDGE DEPTH (FT) (MLLW)	VOLUME CONTRACT DEPTH (CY)	VOLUME 2' OVER-DREDGE DEPTH (CY) (NO CONTOUR OD)	DREDGE AREA VOLUME TOTALS (CY)
1S	PIER 1 SOUTH	54,238	-46	-48	28,040	37,634	65,674
1SA	PIER 1 SOUTH APPROACH	20,698	-46	-48	14,220	14,047	28,267
1N	PIER 1 NORTH	34,001	-46	-48	18,084	22,997	41,081
2S	PIER 2 SOUTH	50,365	-41	-43	29,701	31,847	61,548
2N	PIER 2 NORTH	53,602	-41	-43	44,365	36,122	80,487
9S	PIER 9 SOUTH	24,820	-41	-43	12,763	15,101	27,864
9N	PIER 9 NORTH	24,868	-46	-48	16,672	16,119	32,791
9NA	PIER 9 NORTH APPROACH	7,728	-46	-48	5,508	5,209	10,717
10S	PIER 10 SOUTH	24,788	-46	-48	23,828	16,554	40,382
10SA	PIER 10 SOUTH APPROACH	8,396	-46	-48	1,466	4,339	5,805
11N	PIER 11 NORTH (PARTIAL BERTH)	54,682	-51	-53	15,018	25,730	40,748
11NT	PIER 11 NORTH TEE	1,003	-51	-53	2,600	472	3,072
BASE BID VOLUME TOTALS					212,265	226,171	438,436

NOTES:

- ESTIMATED VOLUMES SHOWN HEREIN INCLUDE ADDITIONAL SILTATION EXPECTED TO OCCUR FROM THE DATE OF THE CONDITION SURVEY TO THE EXPECTED DATE OF DREDGING FOR EACH SLIP.
- CONTRACT DEPTHS AND OVERDREDGE DEPTHS SHOWN HEREIN REFER TO NOAA MEAN LOWER LOW WATER DATUM (MLLW).

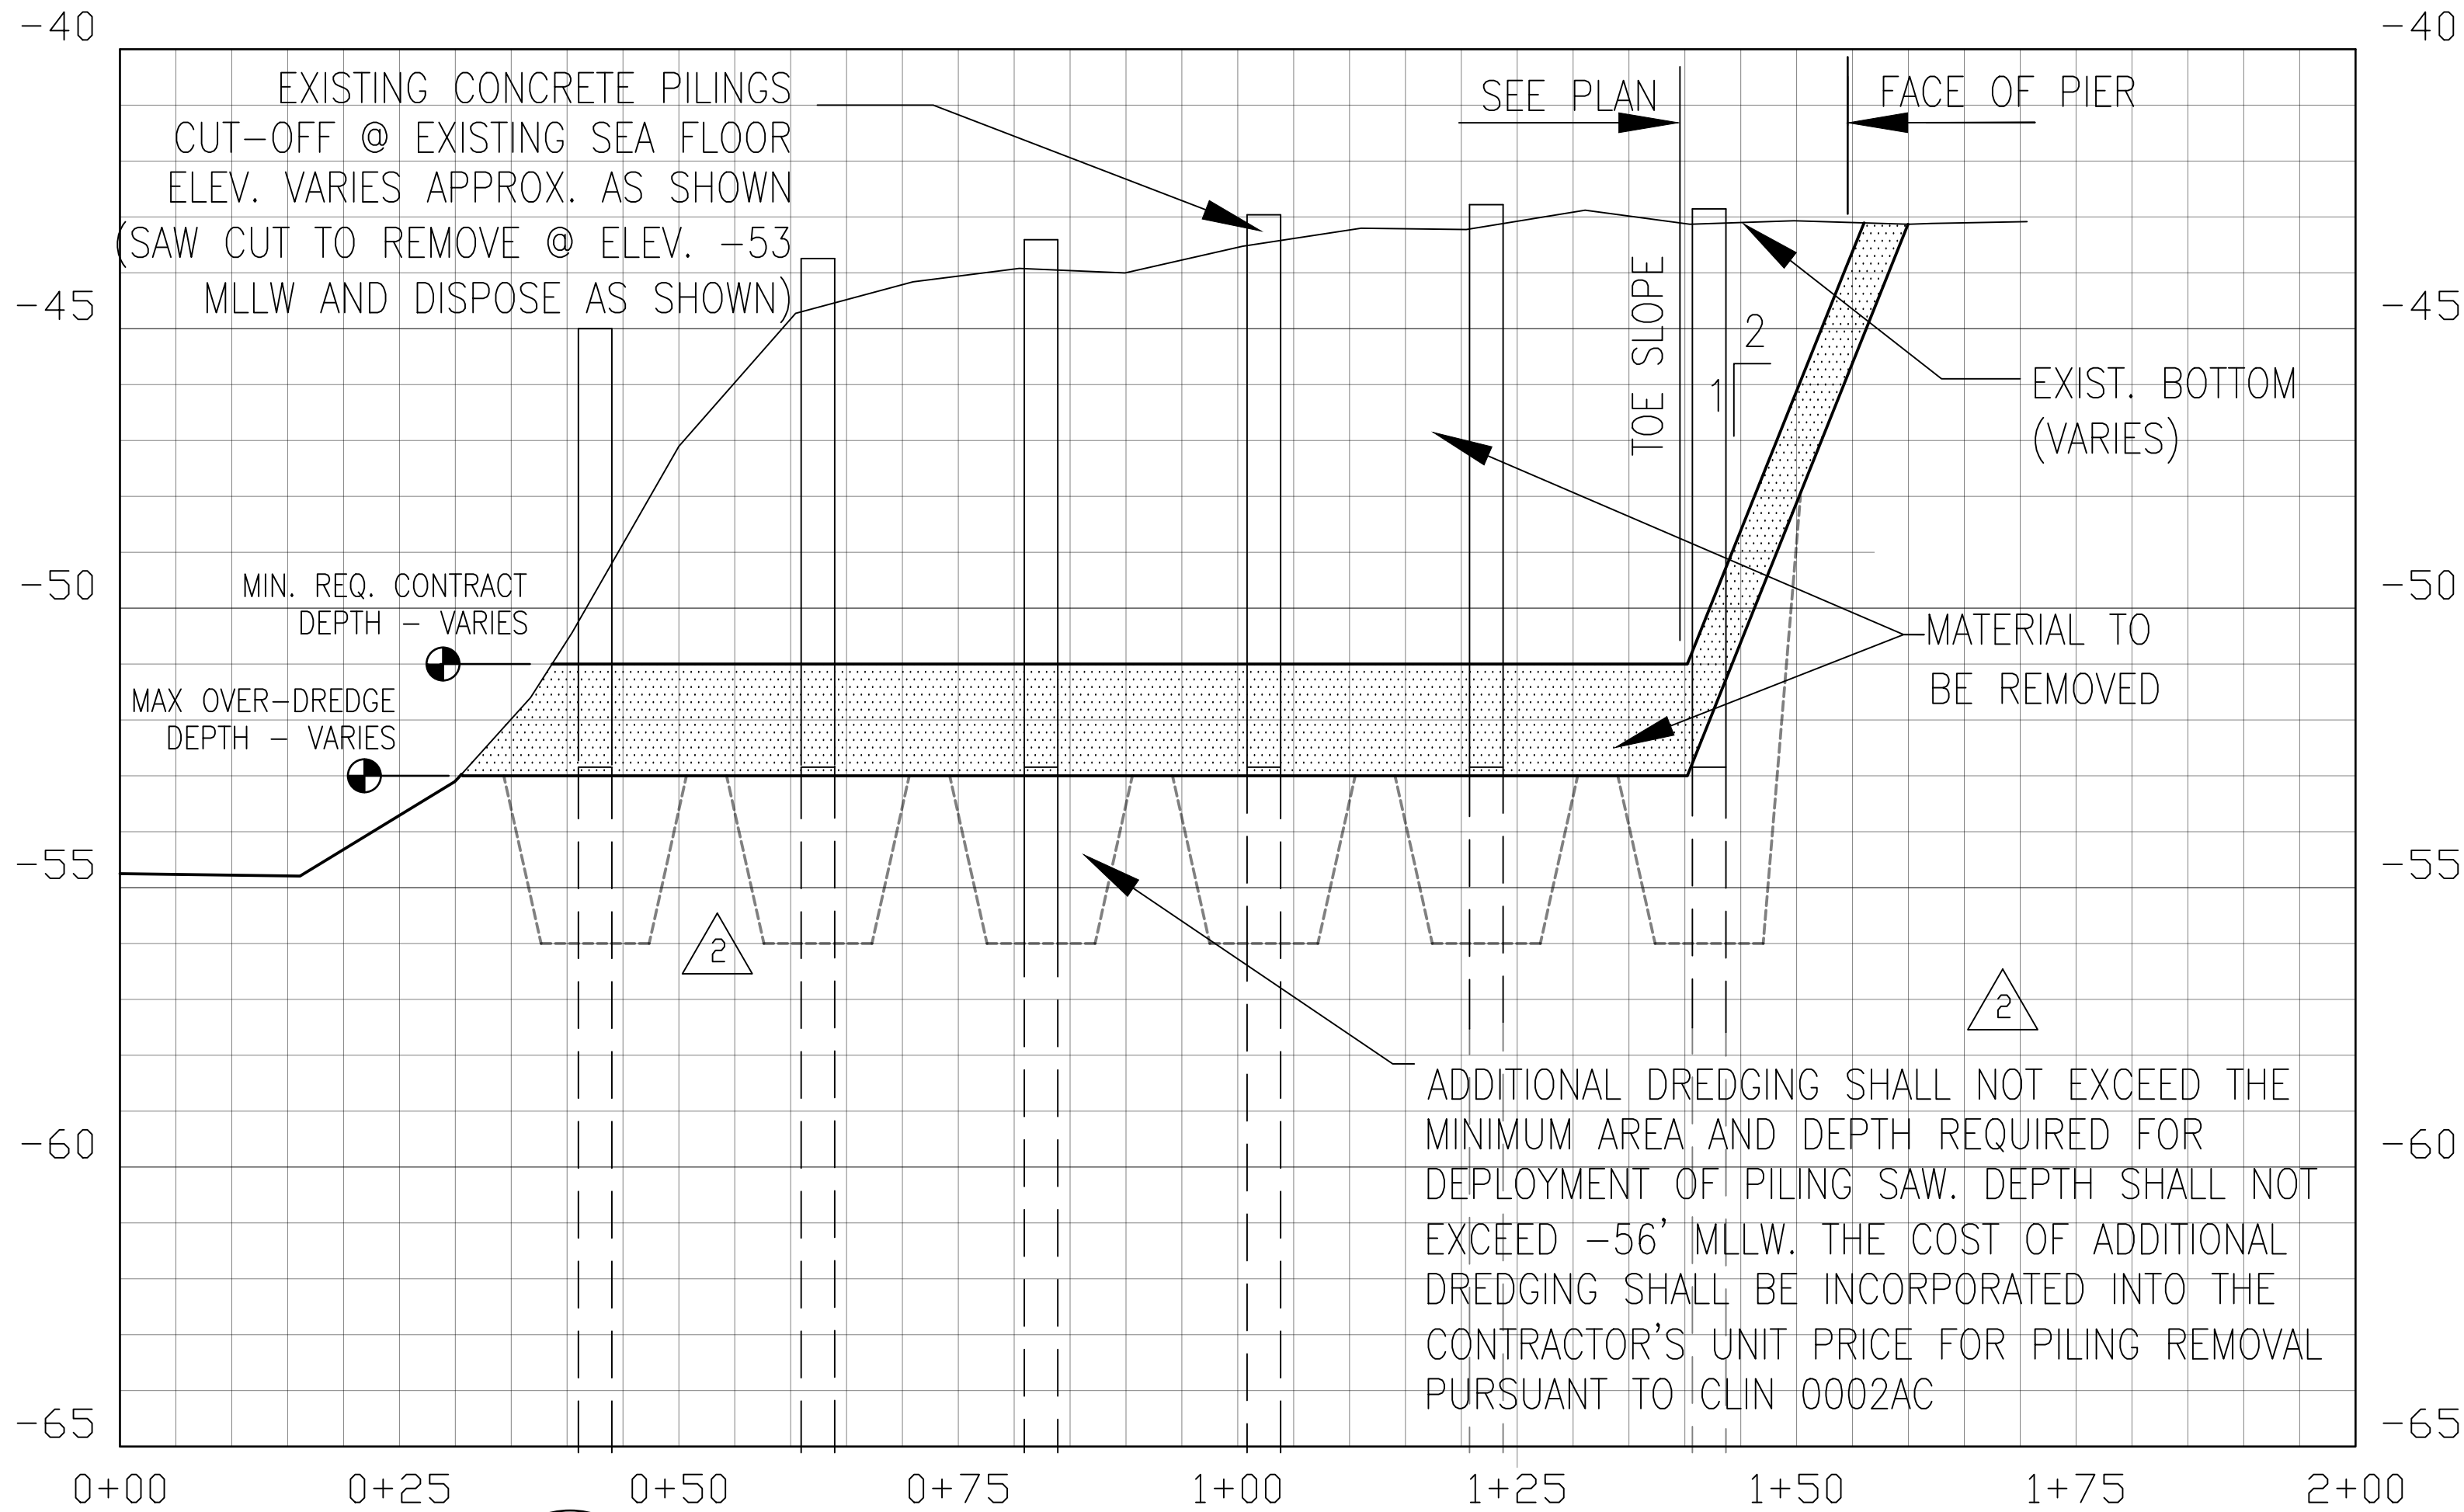


D
V-002

SECTION THROUGH DREDGING OF PIER 11 NORTH TEE FOOTPRINT

NOT TO SCALE


SYMBOLS LEGEND	
	PSB BUOY
	PSB FENCE
	HYDROID BARRIER NET
	CHANNEL DAYMARKER

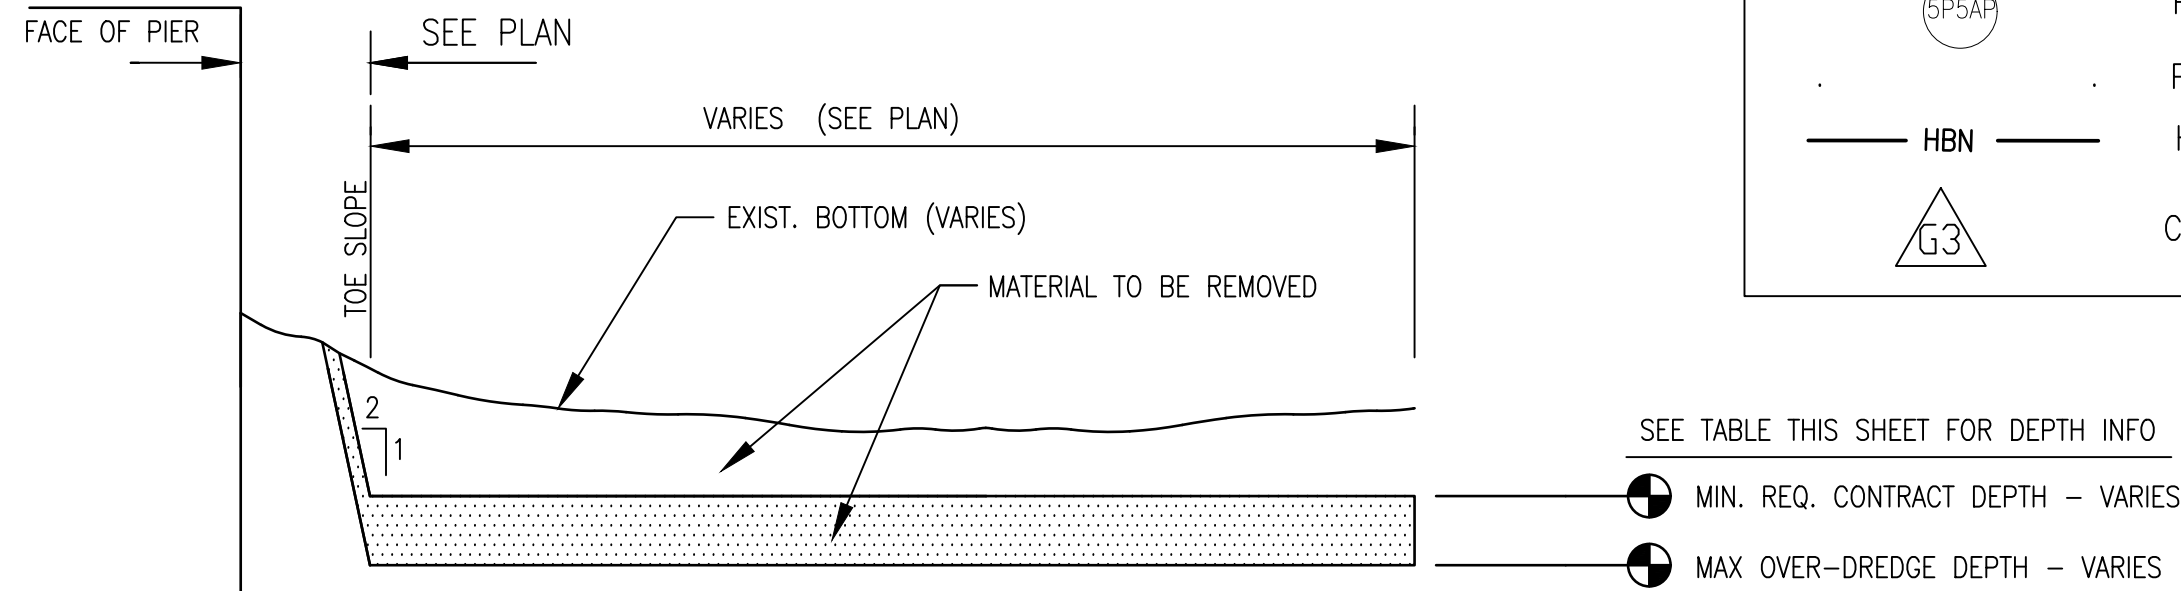

A
V-002

TYPICAL SECTION AT PIERS


NOT TO SCALE

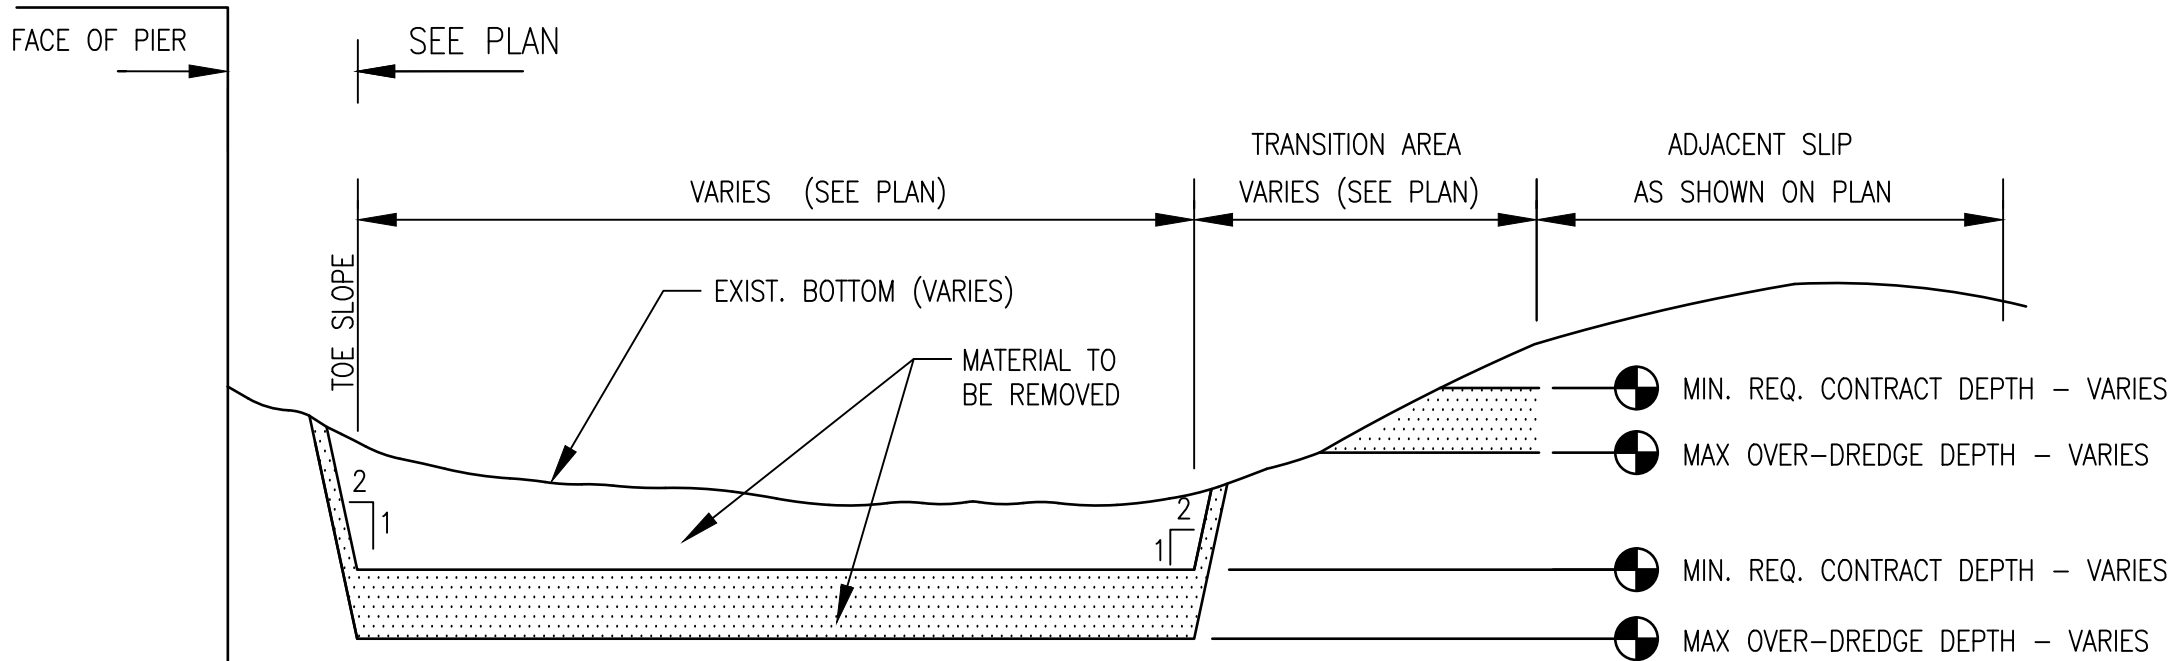

B
V-002

TYPICAL SECTION AT PIERS W/ TRANSITION


NOT TO SCALE

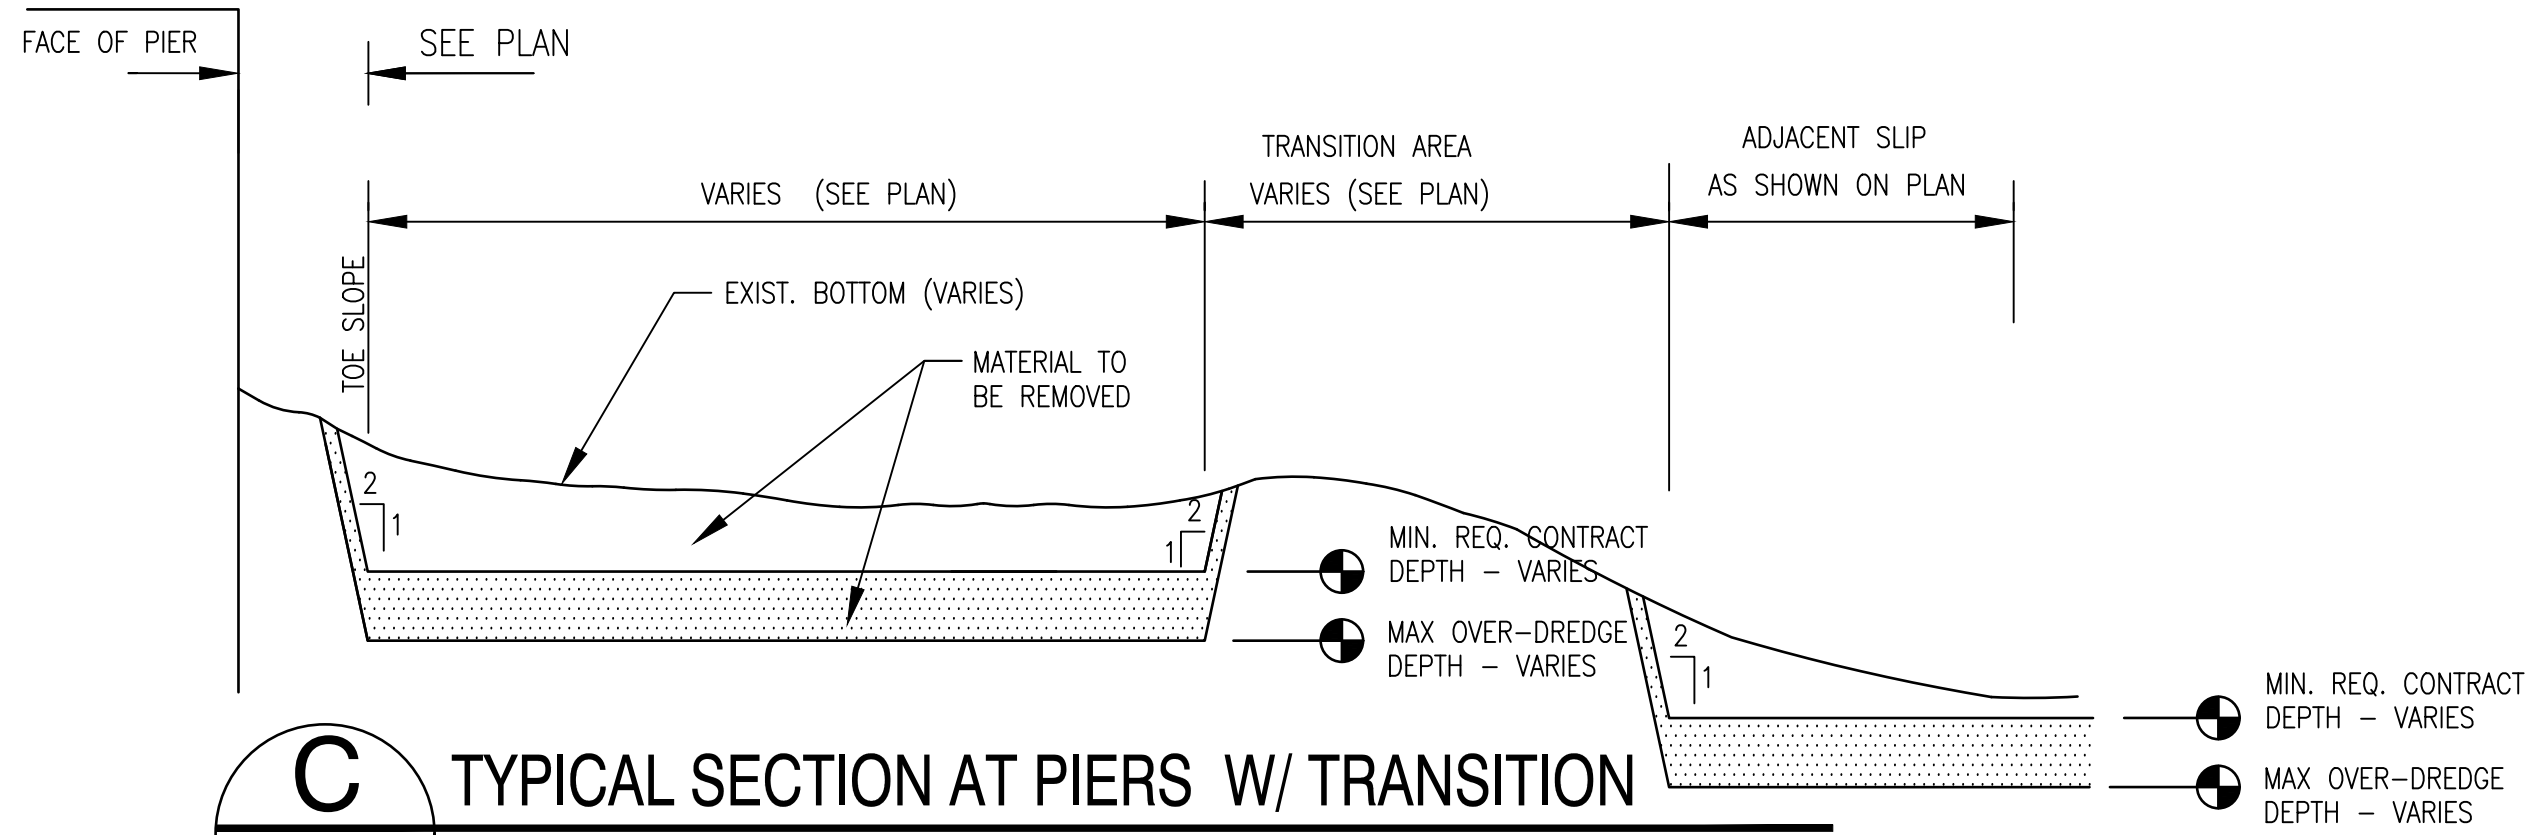

C
V-002

TYPICAL SECTION AT PIERS W/ TRANSITION

NOT TO SCALE

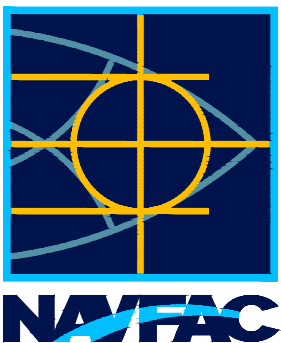

APPROVED

CI-HYDRO BRANCH MGR.

APPROVED

FOR COMMANDER NAVFAC

DATE
MR. RALPH FULP
NS NORFOLK PORT OPERATIONS
PER SAT TO MEMO ON FILE

ACTIVITY - SATISFACTORY TO DATE 02-18-2025

PROJECT MGR. DSG SEAL

DES. JSG DRW. JSG CHK. JSG

FIRE PROTECTION N/A

BRANCH MANAGER DLB

CHIEF ENG/ARCH. EJA

NAVAL FACILITIES ENGINEERING SYSTEMS COMMAND

NAVAL FACILITIES ENGINEERING COMMAND ~ MID ATLANTIC

NAVAL STATION - NORFOLK VIRGINIA

NORFOLK, VA

NORFOLK NAVAL STATION

SITE PLAN FOR FY 2025 MAINTENANCE DREDGING

AT NAVAL STATION NORFOLK

DETAIL SHEET

CODE ID. NO. 80091 SIZE D

SCALE: AS NOTED

MAXIMO NO.

JOB ORDER NO.

WORK ORDER NO. 1788443

CONSTR. CONTR. NO. N/A

NAVFAC DRAWING NO. 12919176

SHEET 2 OF 9

V-002

DRAWING REVISION: 2 FEB 2011

PRICE PROPOSAL FORM

DREDGING FOR FY25 AND FY26 AT NAVAL STATION, NORFOLK

MOBILIZATION/DEMOBILIZATION FOR FY25 MAINTENANCE DREDGING AT NAVAL STATION, NORFOLK (CLIN 0001)

<u>CLIN</u>	<u>QUANTITY</u>	<u>UNIT</u>	<u>UNIT PRICE</u>	<u>TOTAL PRICE</u>
0001AA	1	LS		
TOTAL FOR CLIN 0001 (CLIN 0001AA)				

FY25 MAINTENANCE DREDGING AT NAVAL STATION, NORFOLK (CLIN 0002)

<u>CLIN</u>	<u>QUANTITY</u>	<u>UNIT</u>	<u>UNIT PRICE</u>	<u>TOTAL PRICE</u>
0002AA	435,364	CY		
0002AB	3,072	CY		
0002AC	120	TONS		
0002AD	1	LS		
0002AE	200	HR		
TOTAL FOR CLIN 0002 (CLIN 0002AA THRU 0002AE)				

TOTAL FOR FY25 AT NS NORFOLK (CLIN 0001 + CLIN 0002)

OPTION

FY26 HYDROID NET MAINTENANCE AT NAVAL STATION, NORFOLK (CLIN 0003)

<u>CLIN</u>	<u>QUANTITY</u>	<u>UNIT</u>	<u>UNIT PRICE</u>	<u>TOTAL PRICE</u>
0003AA	1	LS		
TOTAL FOR CLIN 0003 (CLIN 0003AA)				

**TOTAL FOR FY25 AND FY26 AT NS NORFOLK
(CLINS 0001 THRU 0003)**

BID SCHEDULE

PART 1 GENERAL

1.1 CONTRACT LINE ITEMS

The terms Offeror and Bidder and versions thereof (offer/bid) have the same definition as used within this contract.

Provide the Contract Line Item (CLIN) price for the following items:

CLIN 0001 - BASE PRICE – FY25 DREDGING PROJECT @ NAVAL STATION, NORFOLK.

Price includes the following:

CLIN 0001. Price for mobilization and demobilization from the project site in Norfolk, VA for FY25 Maintenance Dredging Project at Naval Station, Norfolk in accordance with the drawings and specifications, but excluding work described in Contract Line Item (CLIN) **0002 thru 0003**.

CLIN	DESCRIPTION	TOTAL PRICE FOR CLIN 0001AA
0001AA	Total Price for mobilization and demobilization from the project sites in Norfolk, VA for FY25 Dredging Project at Naval Station, Norfolk.	\$_____

CLIN 0002 - BASE PRICE – NAVAL STATION NORFOLK FY 25 MAINTENANCE DREDGING.

Price includes the following:

CLIN 0002AA. Price for bucket dredging at Naval Station Norfolk from identified dredge areas which include Pier 1 North, Pier 1 South, Pier 1 South Approach, Pier 2 South, Pier 2 North, Pier 9 South, Pier 9 North, Pier 9 North Approach, Pier 10 South, Pier 10 South Approach, and Pier 11 North (partial berth) as shown on the dredging plans, as well as transportation to, and disposal of dredged material at the Norfolk Ocean Disposal Site (NODS) in accordance with the drawings and specifications, but excluding work described in Contract Line Item (CLIN) **0002AB thru 0002AE.**

CLIN	ITEM	UNIT	UNIT PRICE	NO. UNITS	TOTAL PRICE FOR CLIN 0002AA (UNIT PRICE X NO. UNITS)
0002AA	Price for bucket dredging at Naval Station Norfolk from identified dredge areas which include Pier 1 North, Pier 1 South, Pier 1 South Approach, Pier 2 South, Pier 2 North, Pier 9 South, Pier 9 North, Pier 9 North Approach, Pier 10 South, Pier 10 South Approach, and Pier 11 North (partial berth) as shown on the dredging plans, as well as transportation to, and disposal of dredged material at the Norfolk Ocean Disposal Site (NODS) in accordance with the drawings and specifications, but excluding work described in Contract Line Item (CLIN) 0002AB thru 0002AE.	Cubic Yard	\$ _____	435,364	\$ _____

MAINTENANCE DREDGING AT NAVAL STATION NORFOLK FY25 & FY26

CLIN 0002AB. Price for bucket dredging at Naval Station Norfolk identified dredge area Pier 11 North Tee as shown on the dredging plans, transportation to, and disposal of dredged material at the Norfolk Ocean Disposal Site (NODS) in accordance with the drawings and specifications, but excluding work described in Contract Line Item (CLIN) **0002AA and 0002AC thru 0002AE.**

CLIN	ITEM	UNIT	UNIT PRICE	NO. UNITS	TOTAL PRICE FOR CLIN 0002AB (UNIT PRICE X NO. UNITS)
0002AB	Price for bucket dredging at Naval Station Norfolk identified dredge area Pier 11 North Tee as shown on the dredging plans, transportation to, and disposal of dredged material at the Norfolk Ocean Disposal Site (NODS) in accordance with the drawings and specifications, but excluding work described in Contract Line Item (CLIN) 0002AA and 0002AC thru 0002AE.	Cubic Yard	\$_____	3,072	\$_____

CLIN 0002AC. Price for the removal and disposal of embedded piling stubs as denoted in Design Revision 01, but excluding work described in contract line item (CLIN) **0002AA thru 0002AB and 0002AD thru 0002AE.**

CLIN	ITEM	UNIT	UNIT PRICE	NO. UNITS	TOTAL PRICE FOR CLIN 0002AC (UNIT PRICE X NO. UNITS)
0002AC	Price for the removal and disposal of embedded piling stubs as denoted in Design Revision 01, but excluding work described in contract line item (CLIN) 0002AA thru 0002AB and 0002 AD thru 0002AE.	TONS	\$_____	120	\$_____

MAINTENANCE DREDGING AT NAVAL STATION NORFOLK FY25 & FY26

CLIN 0002AD. Price for the removal, cleaning, replacement of hydroid net and cable ties, and disposal of demolition debris associated with hydroid net, and incidental related work, but excluding work described in Contract Line Item (CLIN) **0002AA thru 0002AC and 0002AE**. Contractor to assume that 25% of floats require replacement. Hydroid net work cannot be performed between February 1 thru April 15.

CLIN	DESCRIPTION	TOTAL PRICE FOR CLIN 0002AD
0002AD	Price for the removal, cleaning, replacement of hydroid net and cable ties, and disposal of demolition debris associated with hydroid net, and incidental related work, but excluding work described in Contract Line Item (CLIN) 0002AA thru 0002AC and 0002AE . Contractor to assume that 25% of floats require replacement. Hydroid net work cannot be performed between February 1 thru April 15.	\$_____

The quantity in CLIN 0002AE is an additive bid item, over and above the quantity indicated for the FY25 and FY26 Maintenance Dredging drawings and specifications. This item will only be performed at the direction of the Contracting Officer. In the event that some or all of the quantity in CLIN 0002AE is not utilized, a Deductive Modification will be issued to deduct the difference.

CLIN 0002AE. Price for Downtime (delays) pursuant to specification section 35 20 23 Para 3.2.2.1 in accordance with the drawings and specifications, but excluding work described in Contract Line Item (CLIN) **0002AA thru 0002AD**.

CLIN	ITEM	UNIT	UNIT PRICE	NO. UNITS	TOTAL PRICE FOR CLIN 0002AE (UNIT PRICE X NO. UNITS)
0002AE	Downtime (delays) pursuant to specification section 35 20 23 Para 3.2.2.1.	HR	\$_____	200	\$_____

CLIN 0003 - OPTION – FY26 HYDROID NET MAINTENANCE AT NAVAL STATION, NORFOLK.

The decision to award this bid option as described herein shall be at the sole discretion of the Government. The Government reserves the right to award this option no later than January 31, 2026. No provision is made for economic price adjustment. Method of evaluation of bids for award purposes is specified below.

Price includes the following:

CLIN 0003AA. Price for the removal, cleaning, replacement of hydroid net and cable ties, and disposal of demolition debris associated with hydroid net, and incidental related work. Contractor to assume that 25% of floats require replacement. Hydroid net work cannot be performed between February 1 thru April 15.

CLIN	DESCRIPTION	TOTAL PRICE FOR CLIN 0003AA
0003AA	Price for the removal, cleaning, replacement of hydroid net and cable ties, and disposal of demolition debris associated with hydroid net, and incidental related work. Contractor to assume that 25% of floats require replacement. Hydroid net work cannot be performed between February 1 thru April 15.	\$_____

1.2 GENERAL BID NOTES

- a. Award will be made on the total sum of Contract Line Items **0001 thru 0003**. For CLINs **0002AA 0002AB, 0002AC, and 0002AE**, enter unit prices and extended totals in spaces provided. If there is a difference between a unit price and the extended total, the unit price will be held to be the intended bid and the total recomputed accordingly. If an Offeror provides a total but fails to enter a unit price, the total divided by the specified quantity will be held to be the intended unit price.

PART 2 PRODUCTS

Not Used.

PART 3 EXECUTION

Not Used.

CONTRACTOR'S SUBMITTAL TRANSMITTAL

LANTDIV NORFOLK 4-4355/3 (REV 11-99)		CONTRACT NO N40085-24D2507 25F25678	TRANSMITTAL NO: 23	7/11/2025
FROM CONTRACTOR				
Ocean Construction Services, 104 Aragona Blvd, VB, VA 23462		PROJECT TITLE AND LOCATION		
Naval Station Norfolk		Pier 11 Partial Demolition		

CONTRACTOR USE ONLY	REVIEWER USE ONLY
* List only one specification division per form. List only one of the following categories on each transmittal form, and indicate which is being submitted ☐ Contractor Approved ☒ Government Approval ☐ Variation for Government Approval	** ACTION CODES A- Approved, as submitted; Completed B- Approved, except as noted on drawings; Completed C- Approved, resubmission required; Resubmit D- Returned by correspondence; Completed E- Disapproved (see attached); Resubmit F- Receipt acknowledged; Completed G- Other (Specify); Resubmit X- Receipt acknowledged, does not comply; Resubmit

Item No	Proj. Spec. Sect. & Paragraph And/or Proj. DWG No	ITEM IDENTIFICATION (Type, size, model no, Mfg. name, dwg. or brochure number)	No. of Copies	Action Codes	Reviewer's Initials Code and Date
1	03 31 30; 1.2.2	SD-02 Final Demo Survey	Electr	B	DSG / 07-21-25

Contractor's Comments:

	Contractor Representative (Signature)
	ANTHONY DAVIS

Date Received by Rev	From (Reciever)	To

☒ Submittals are returned with action indicated. **Approval of an item does not include approval of any variation from the contract requirements unless the contractor calls attention to and supports the variation**

☐ Submittals are forwarded to ROICC with A-E recommendations indicated in REVIEWER USE ONLY section and in comments below on ONE COPY of the transmittal form

Reviewer's Comments

Approved as noted. Ensure obstruction is removed/demolished as noted in survey.

Dean Gregory, PE
07-21-25

Copies to ROICC (2)	DATE	SIGNATURE
LANTDIV (1)	7/21/2025	
A-E (1)		



Ocean Construction Services, Inc.
104 Aragona Blvd.
Virginia Beach, VA 23462
Ph: 757-200-9590 Fax: 757-493-8921

Contract Number: N40085-24-F-2507 25F2568
Project: Pier 11 Partial Demolition
Location: Naval Station Norfolk

Transmittal No: 23
Item: 1 – Final Demo Survey

"I hereby certify the (equipment) (material) (article) shown and marked in this submittal is that proposed to be incorporated with contract Number **N40085-24-D-2507**, Task **Order # 25F2568** is in compliance with the contract drawings and specification, can be installed in the allocated spaces, and is submitted for Government approval.

Certified by Submittal Reviewer

ANTHONY DAVIS

_____, Date: 7/11/25


Certified by QC Manager

ANTHONY DAVIS


_____, Date: 7/11/25

Signature when applicable

POST

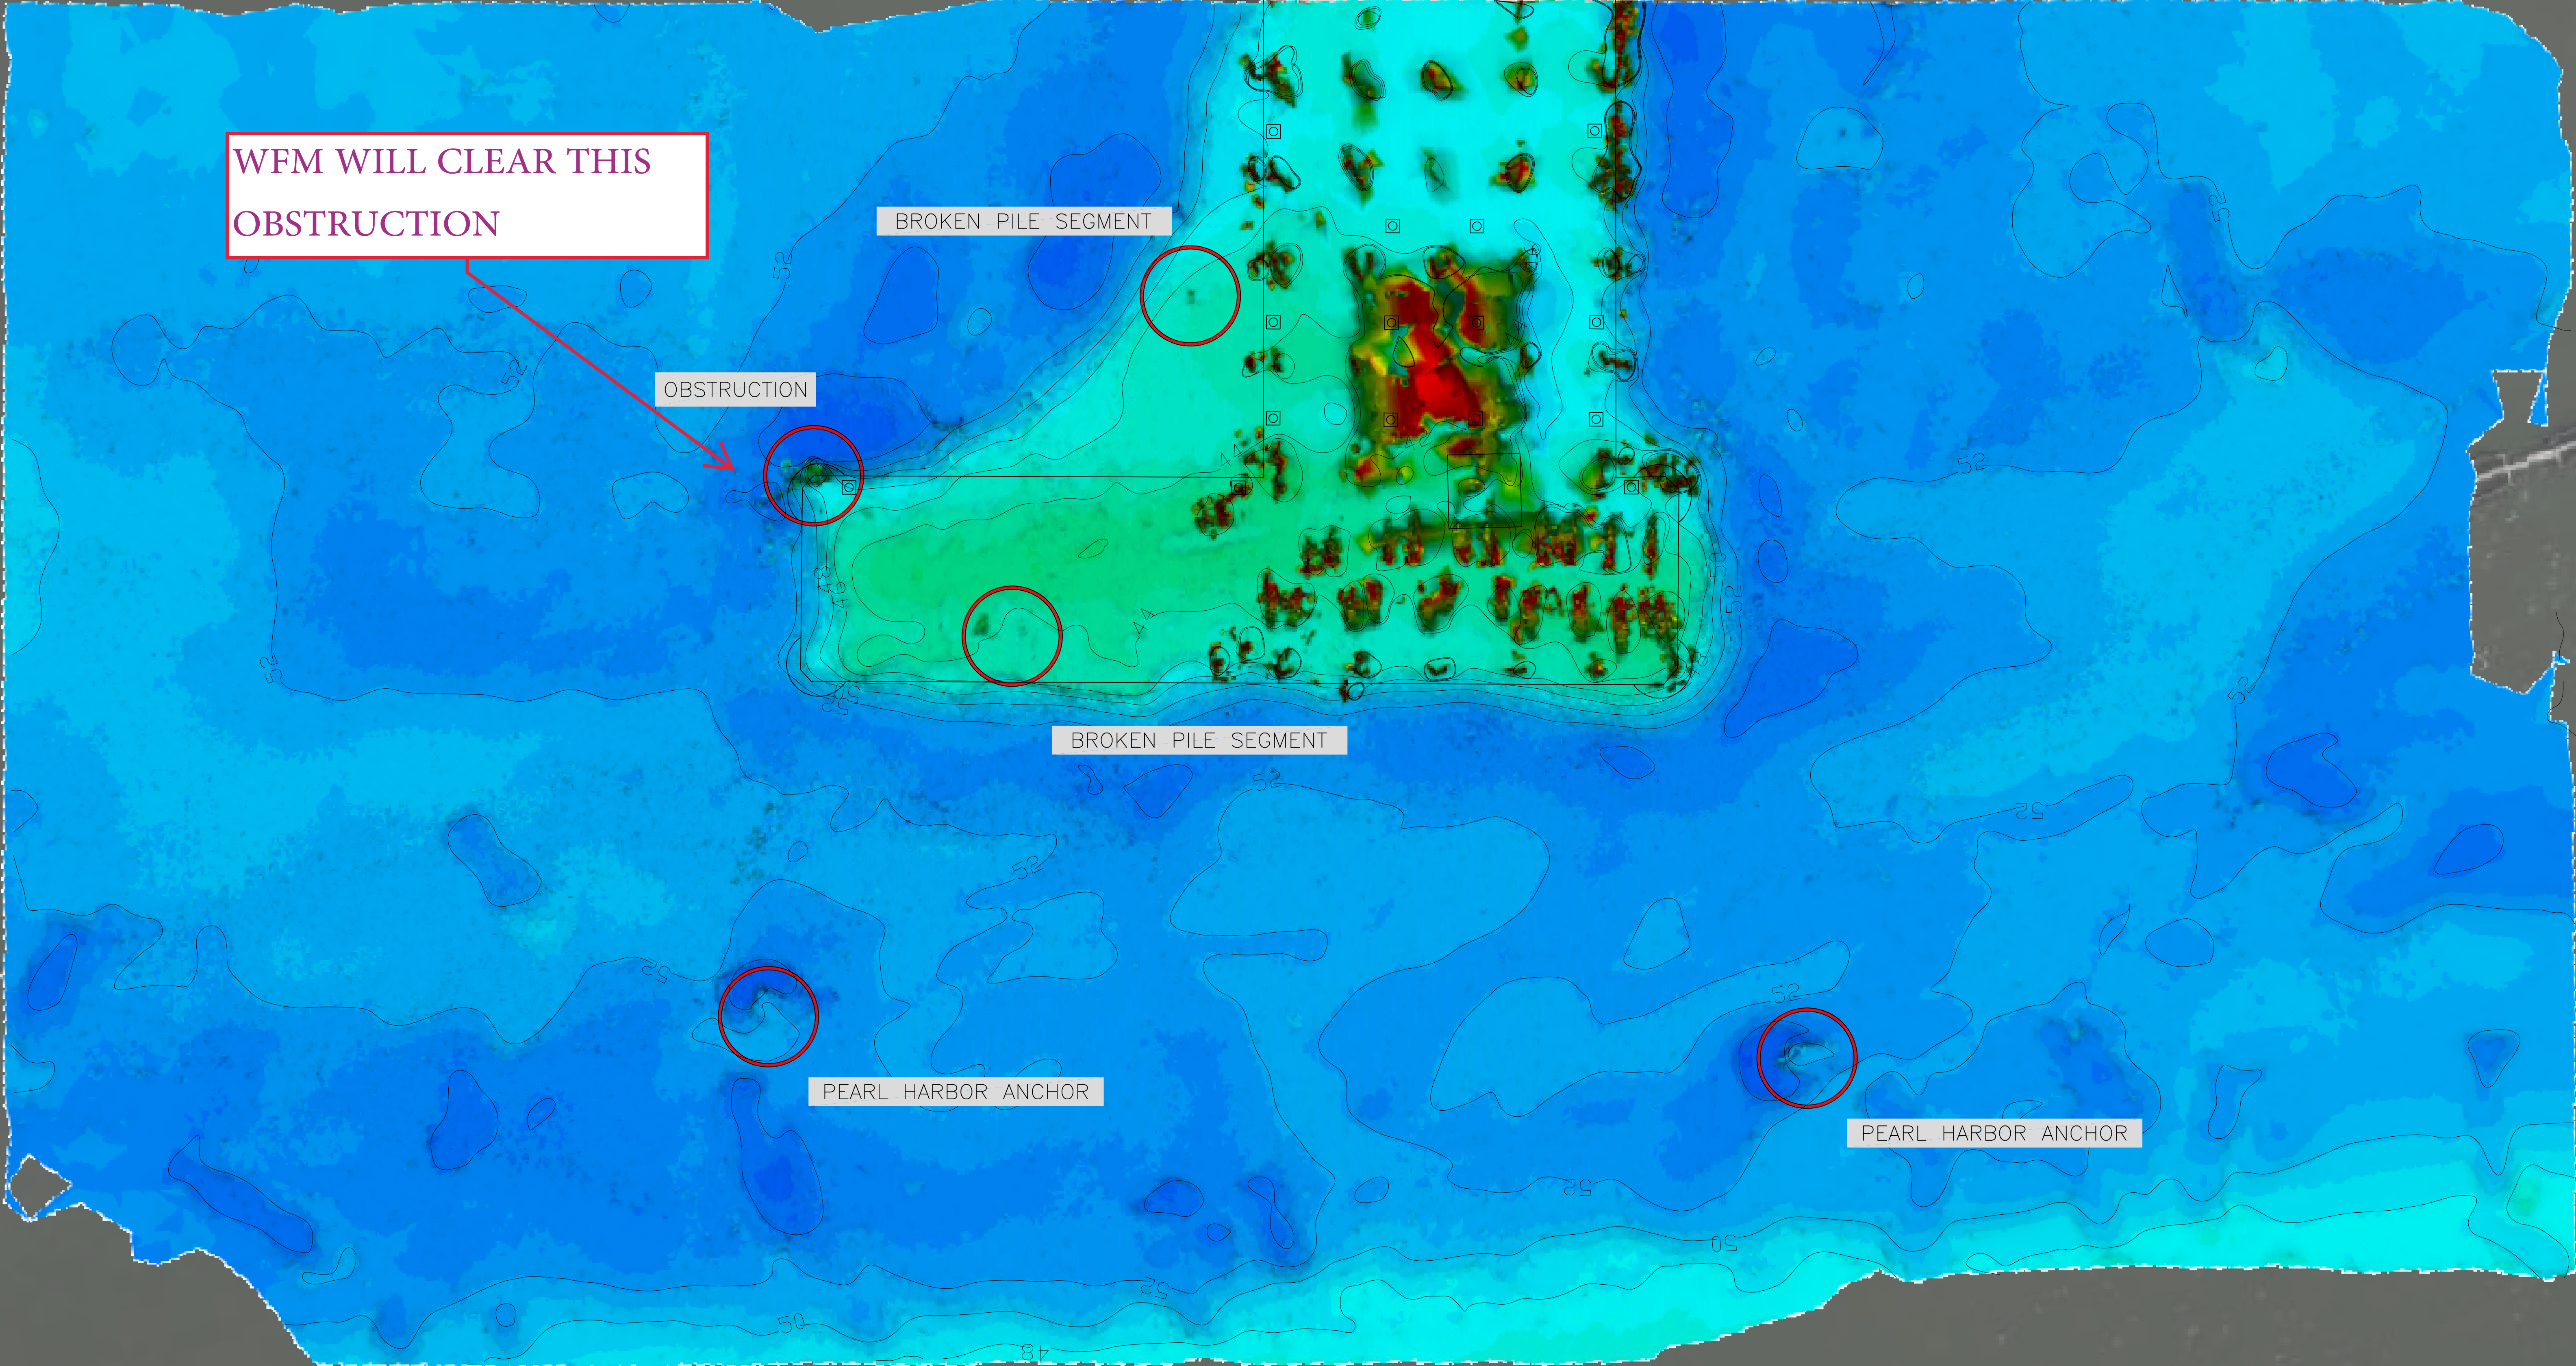

- NOTES:
- A POSTCONSTRUCTION SURVEY WAS COMPLETED ON JUNE 23, 2025 UTILIZING A RESON T50P MULTIBEAM ECHOSOUNDER OPERATING AT 200 kHz AND AN EDGETECH 4200P SIDE SCAN SONAR OPERATING AT 900 KHz.
 - ALL TARGETS NOTED DURING THE POSTCONSTRUCTION DATASETS WERE ALSO MARKED IN THE PRECONSTRUCTION SURVEY WITH THE EXCEPTION OF THE "OBSTRUCTION" LOCATED ON THE NORTH EAST CORNER OF THE DEMOLISHED PIER HEAD FOOTPRINT.

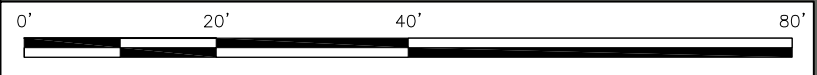


NAVAL BASE NORFOLK PIER 11 PROJECT NORFOLK, VA		2512.250623.POST	
POSTCONSTRUCTION SURVEY DEBRIS CONTACTS		1" = 20'	
JULY 8, 2025		DM	
DATE		DRAWN BY	
SHEET		DRAWING NO	
1 OF 3		001	


MD-ATLANTIC
MARINE CORP.
15314 CARROLLTON BLVD.
CARROLLTON, VA 23314
TEL: 757-745-7475

H: STATE PLANE NAD-83 VIRGINIA SOUTH	UNITS: FEET	VESEL: BAYLEIGH W.
V: MLW - 1.64' SEPARATION BETWEEN NAVD88	SURVEY DATE: JUNE 23, 2025	ECHOSOUNDER: RESON T50 MULTIBEAM OPERATING AT 200. kHz
		GPS: APPLANIX POSMV WAVEMASTER
		CORRECTIONS: WGS 84 NETWORK


POST

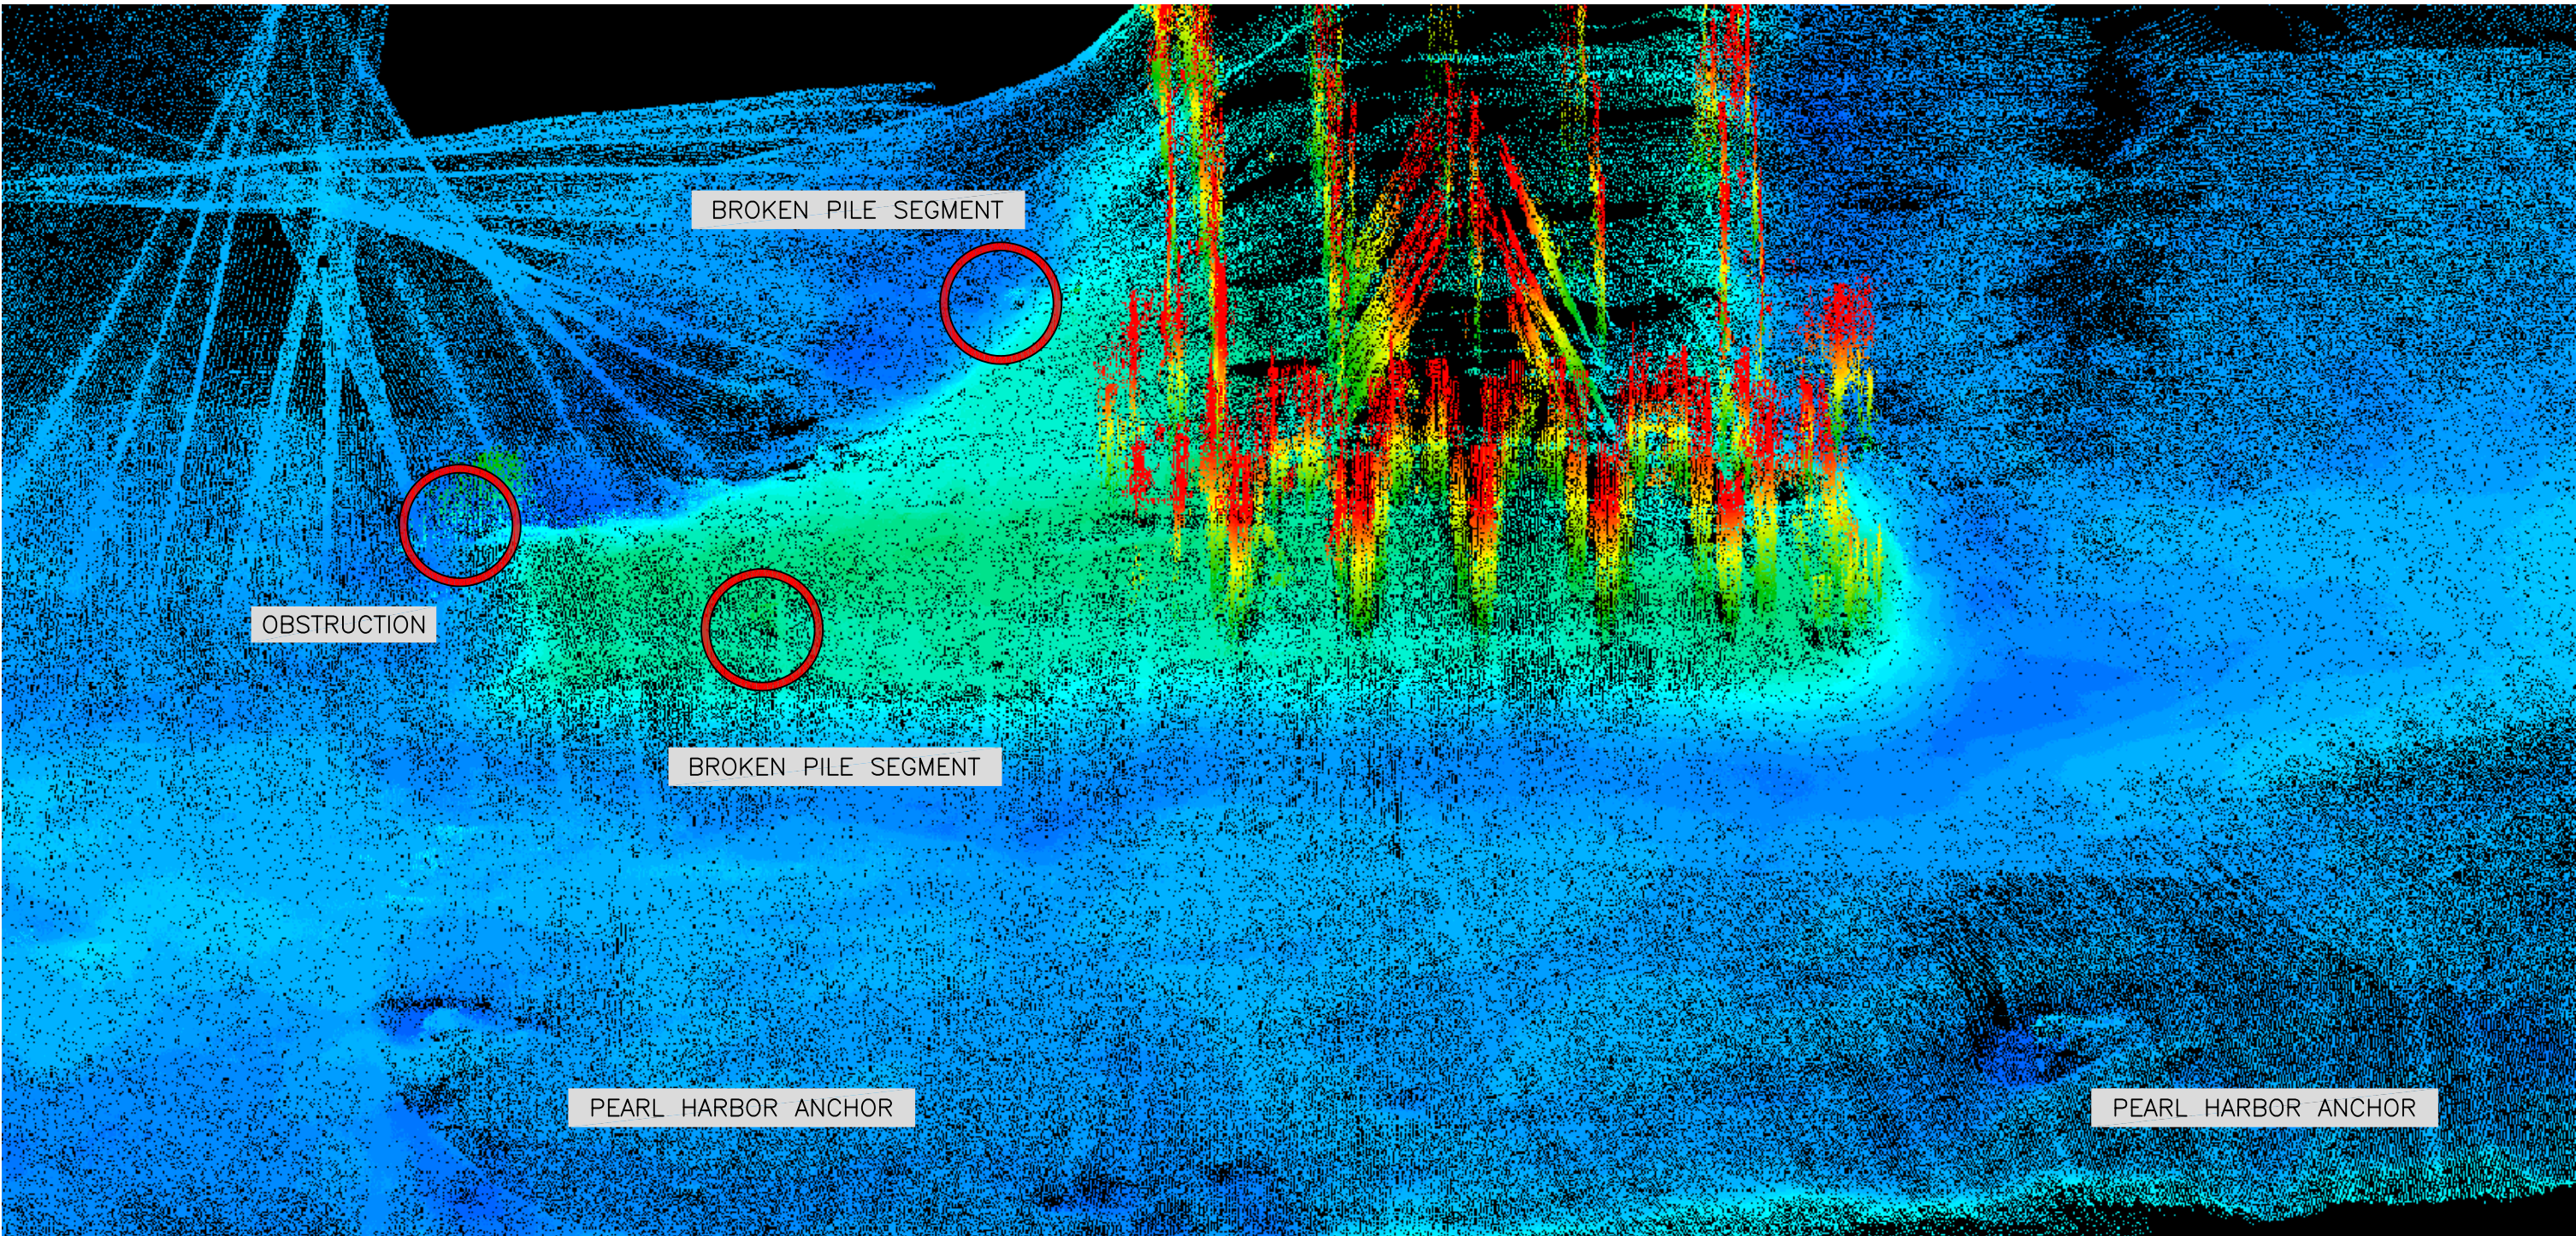


EAST FACE OF PIER

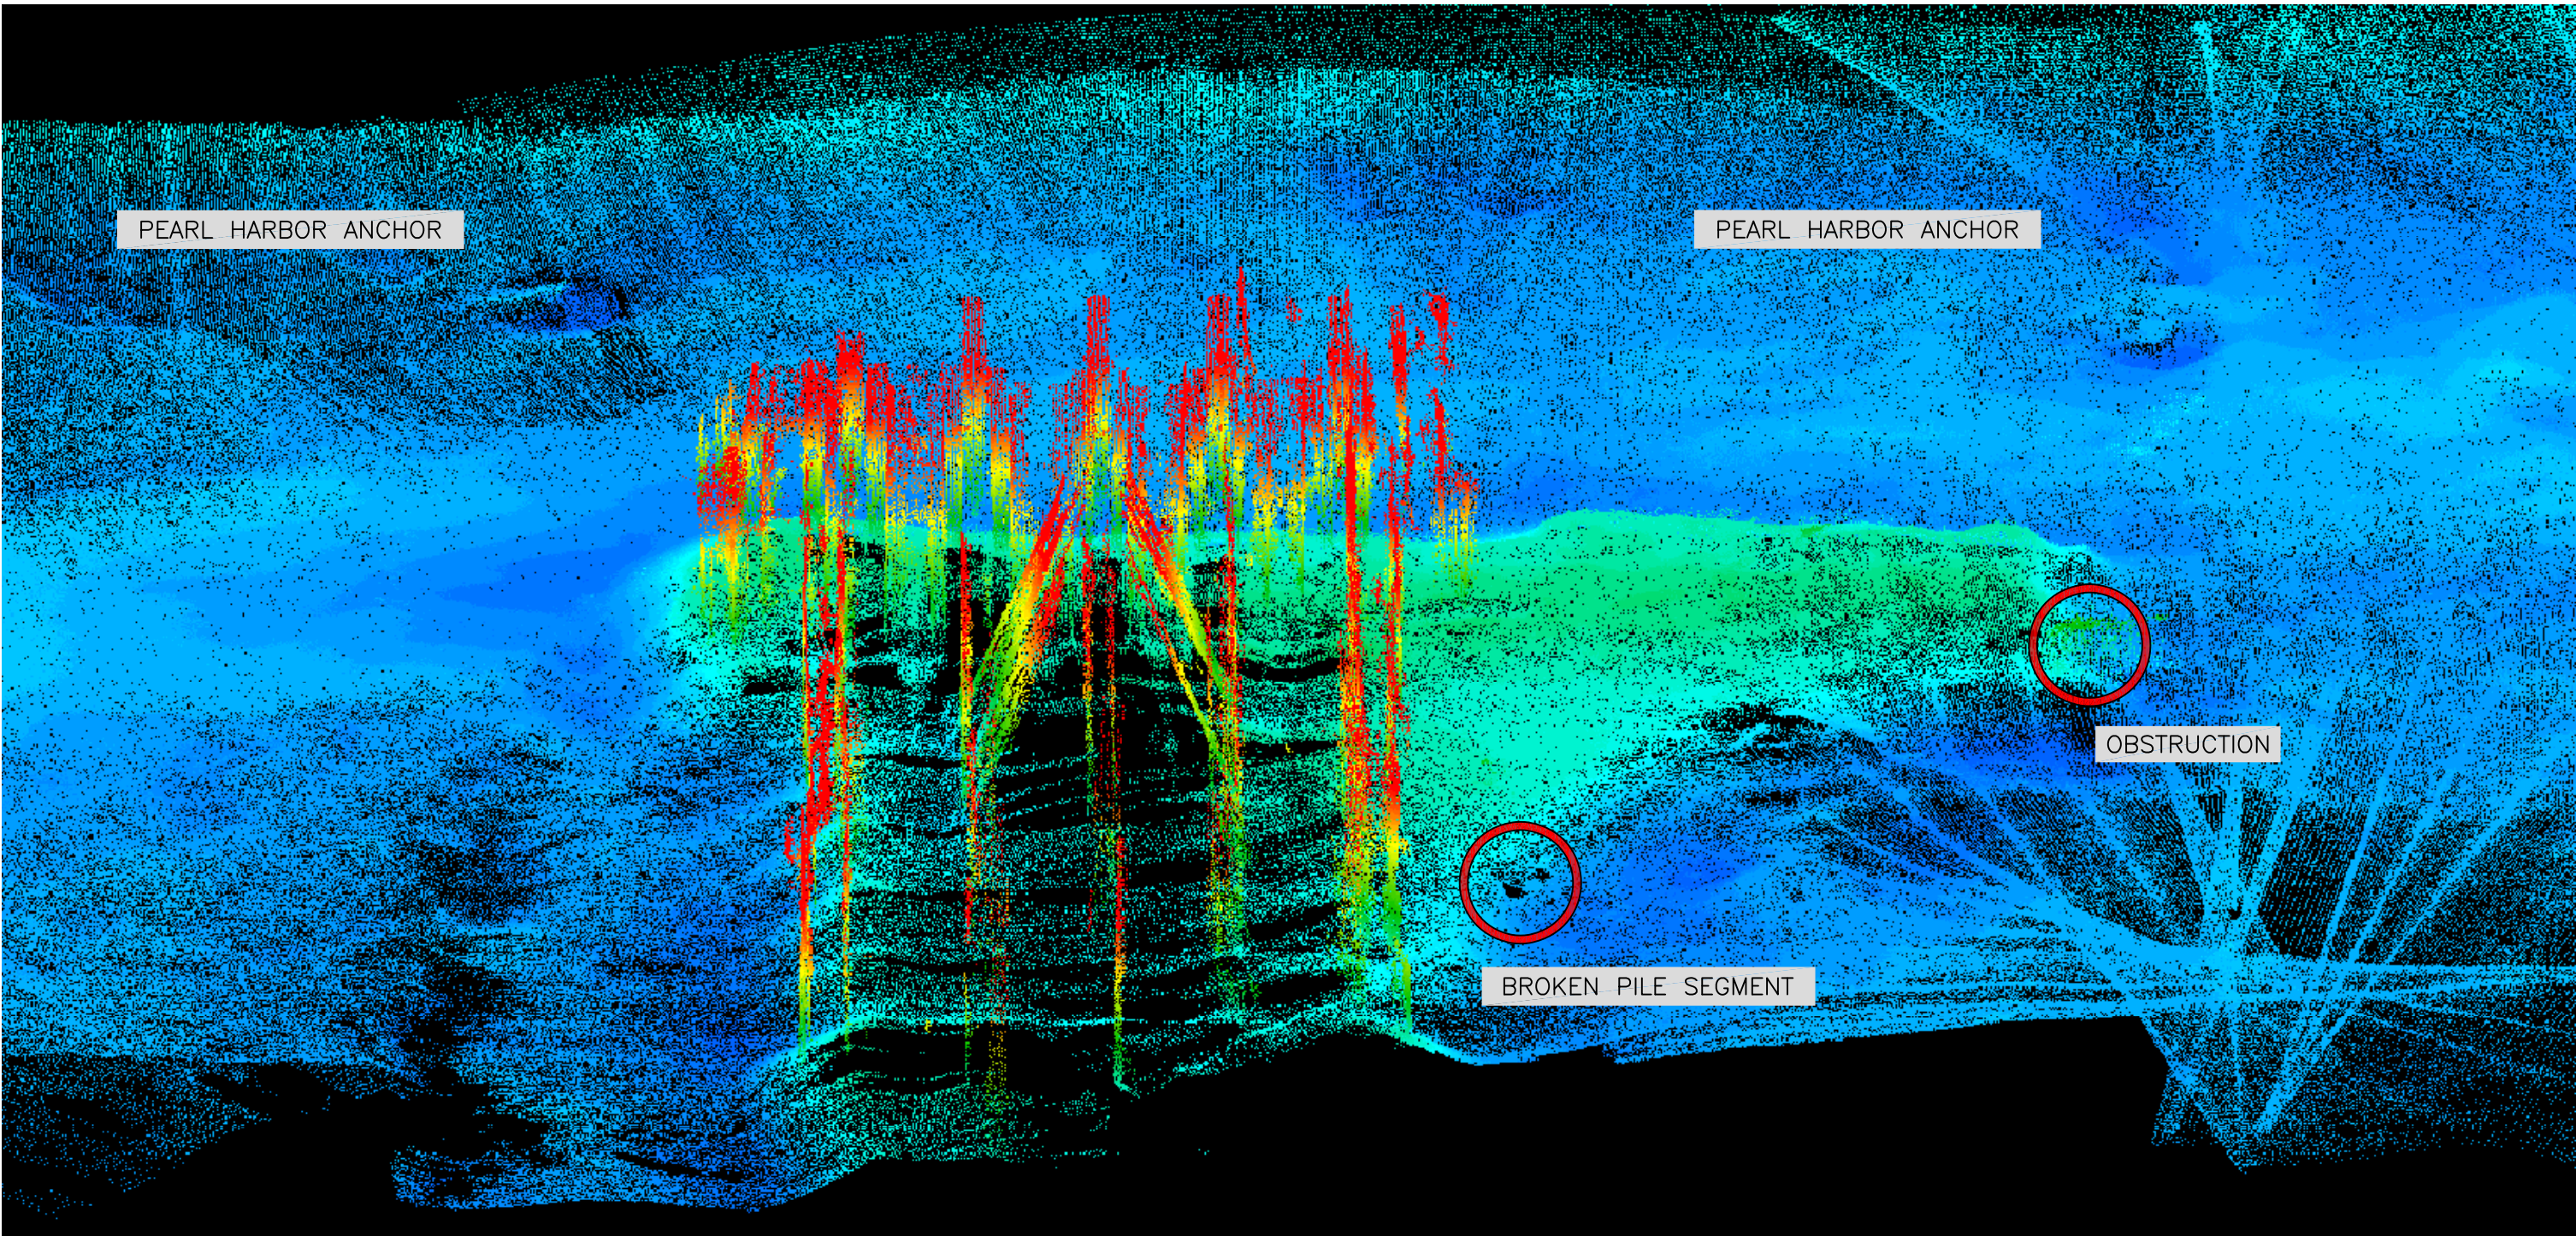


WEST FACE OF PIER

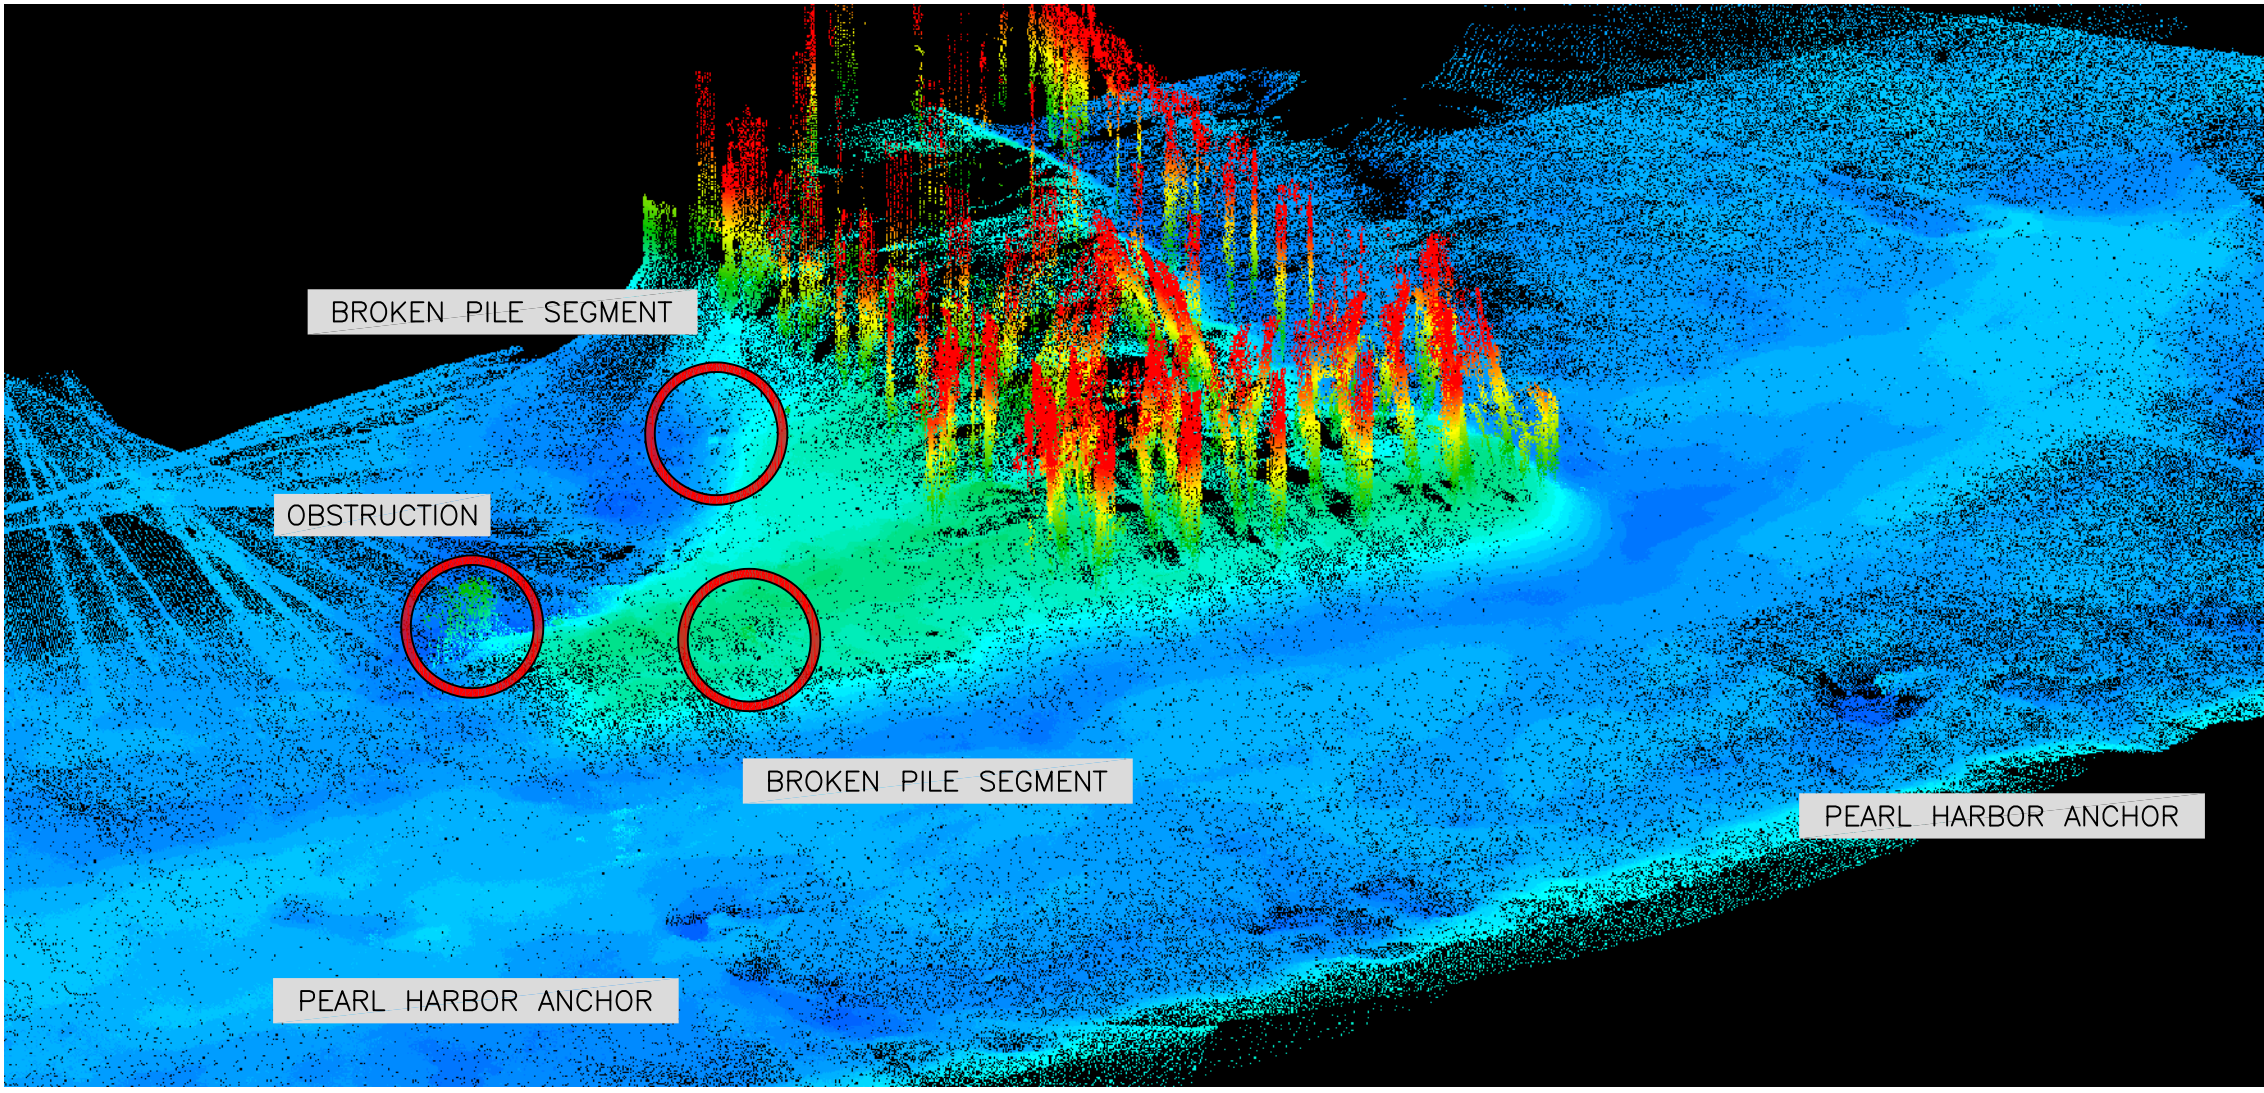


NW CORNER

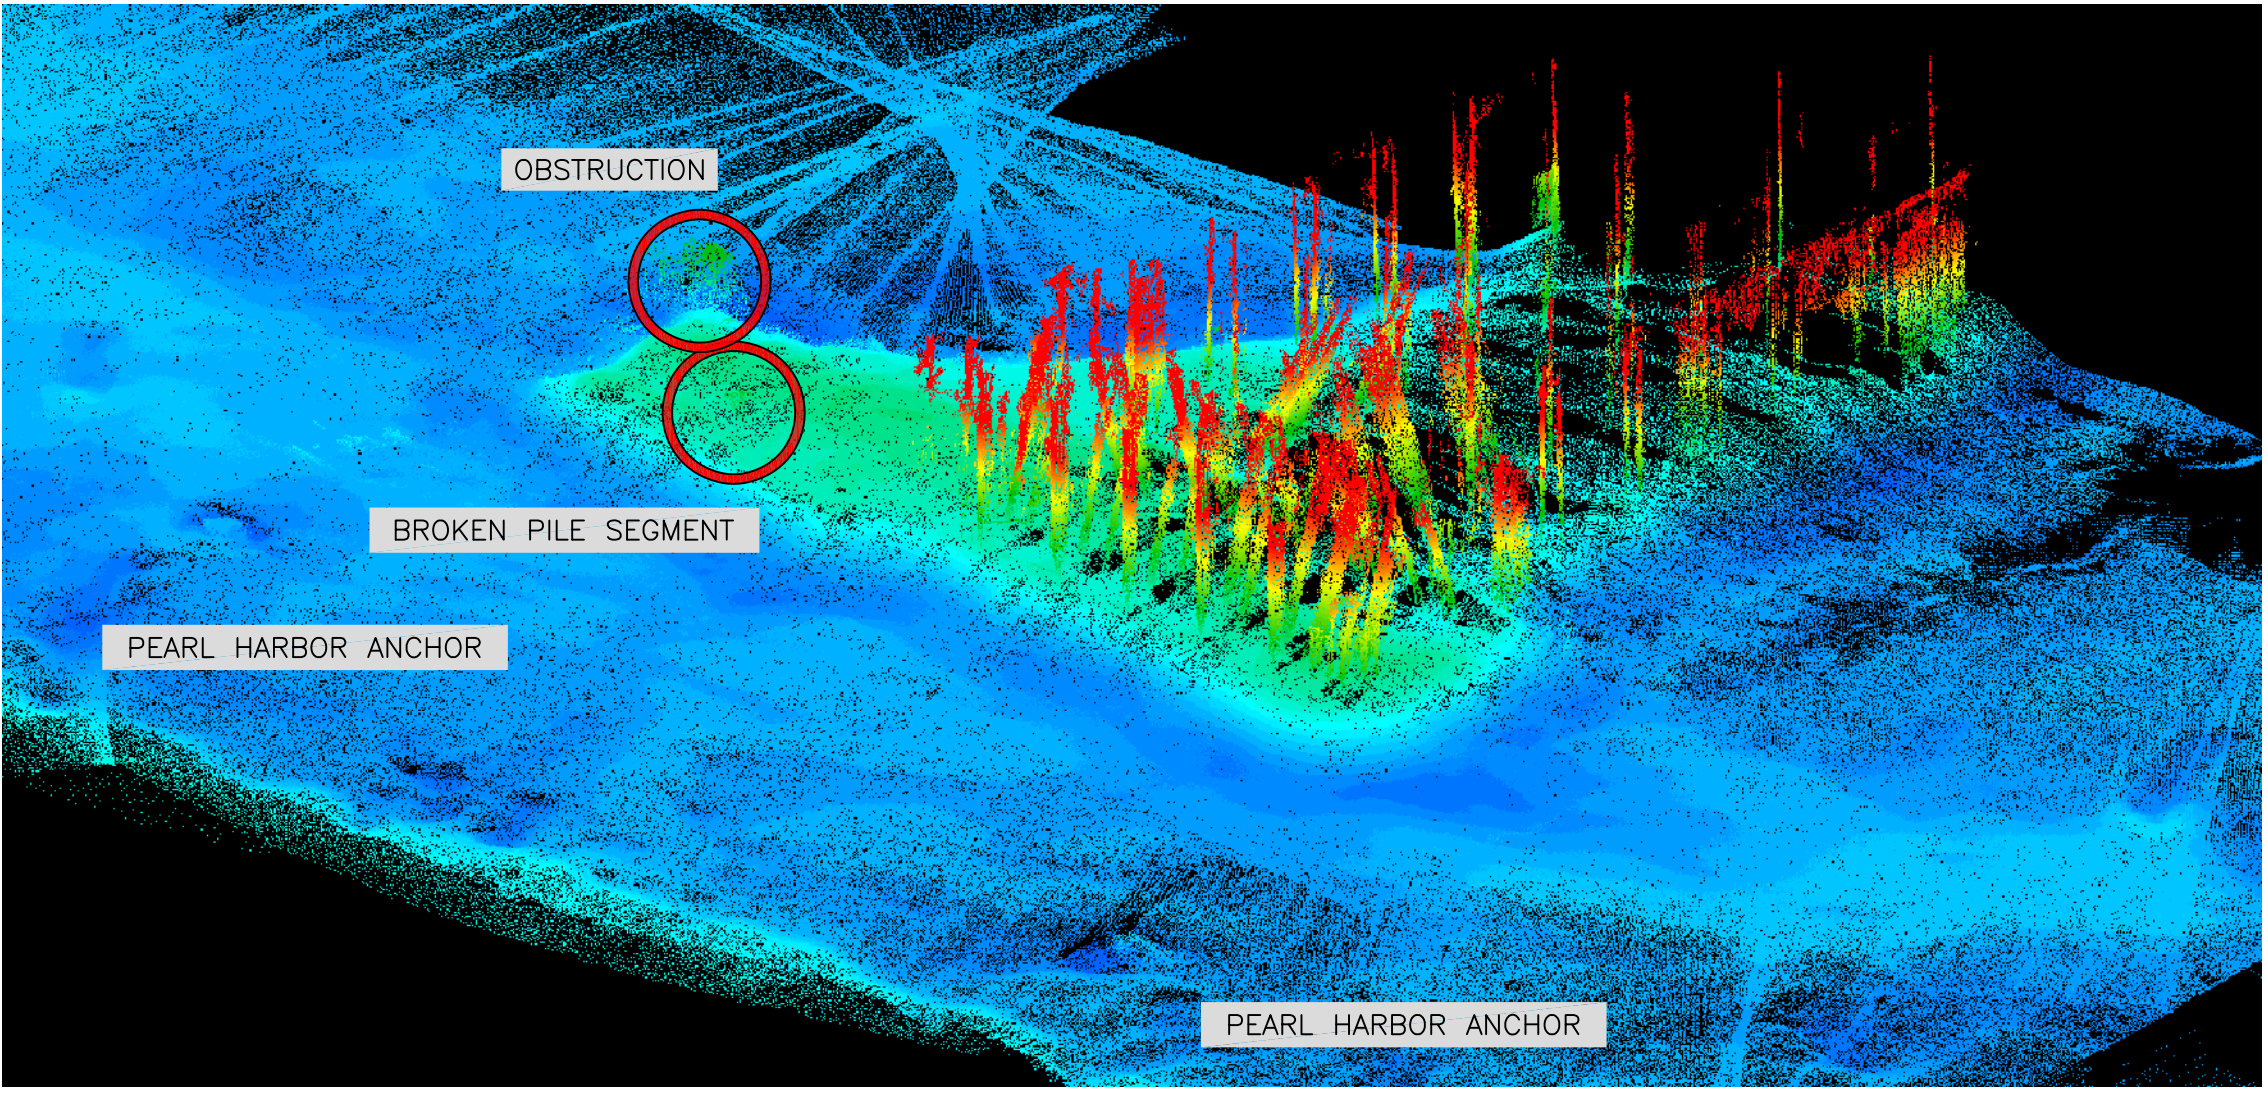

SW CORNER

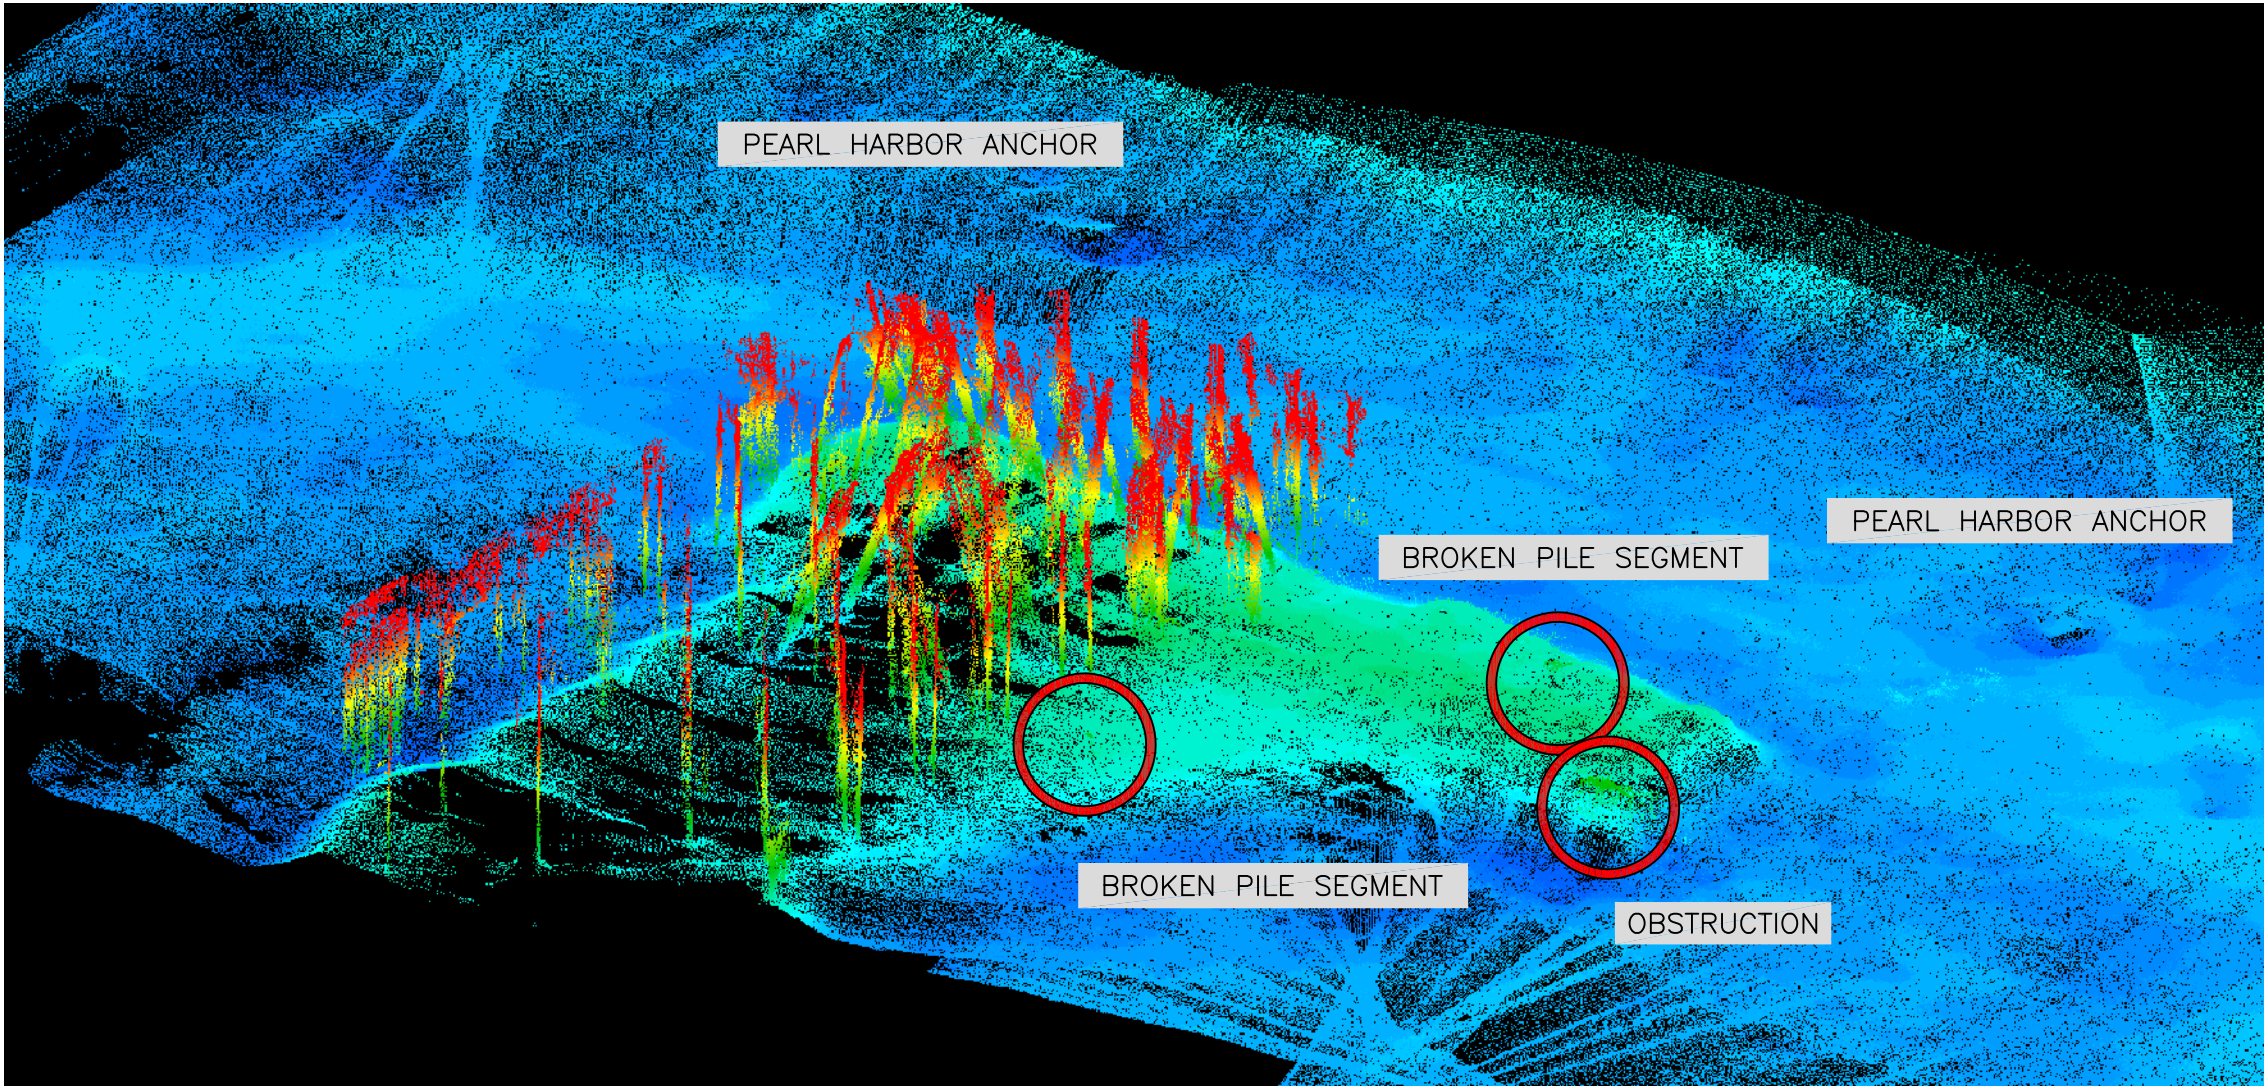


NE CORNER


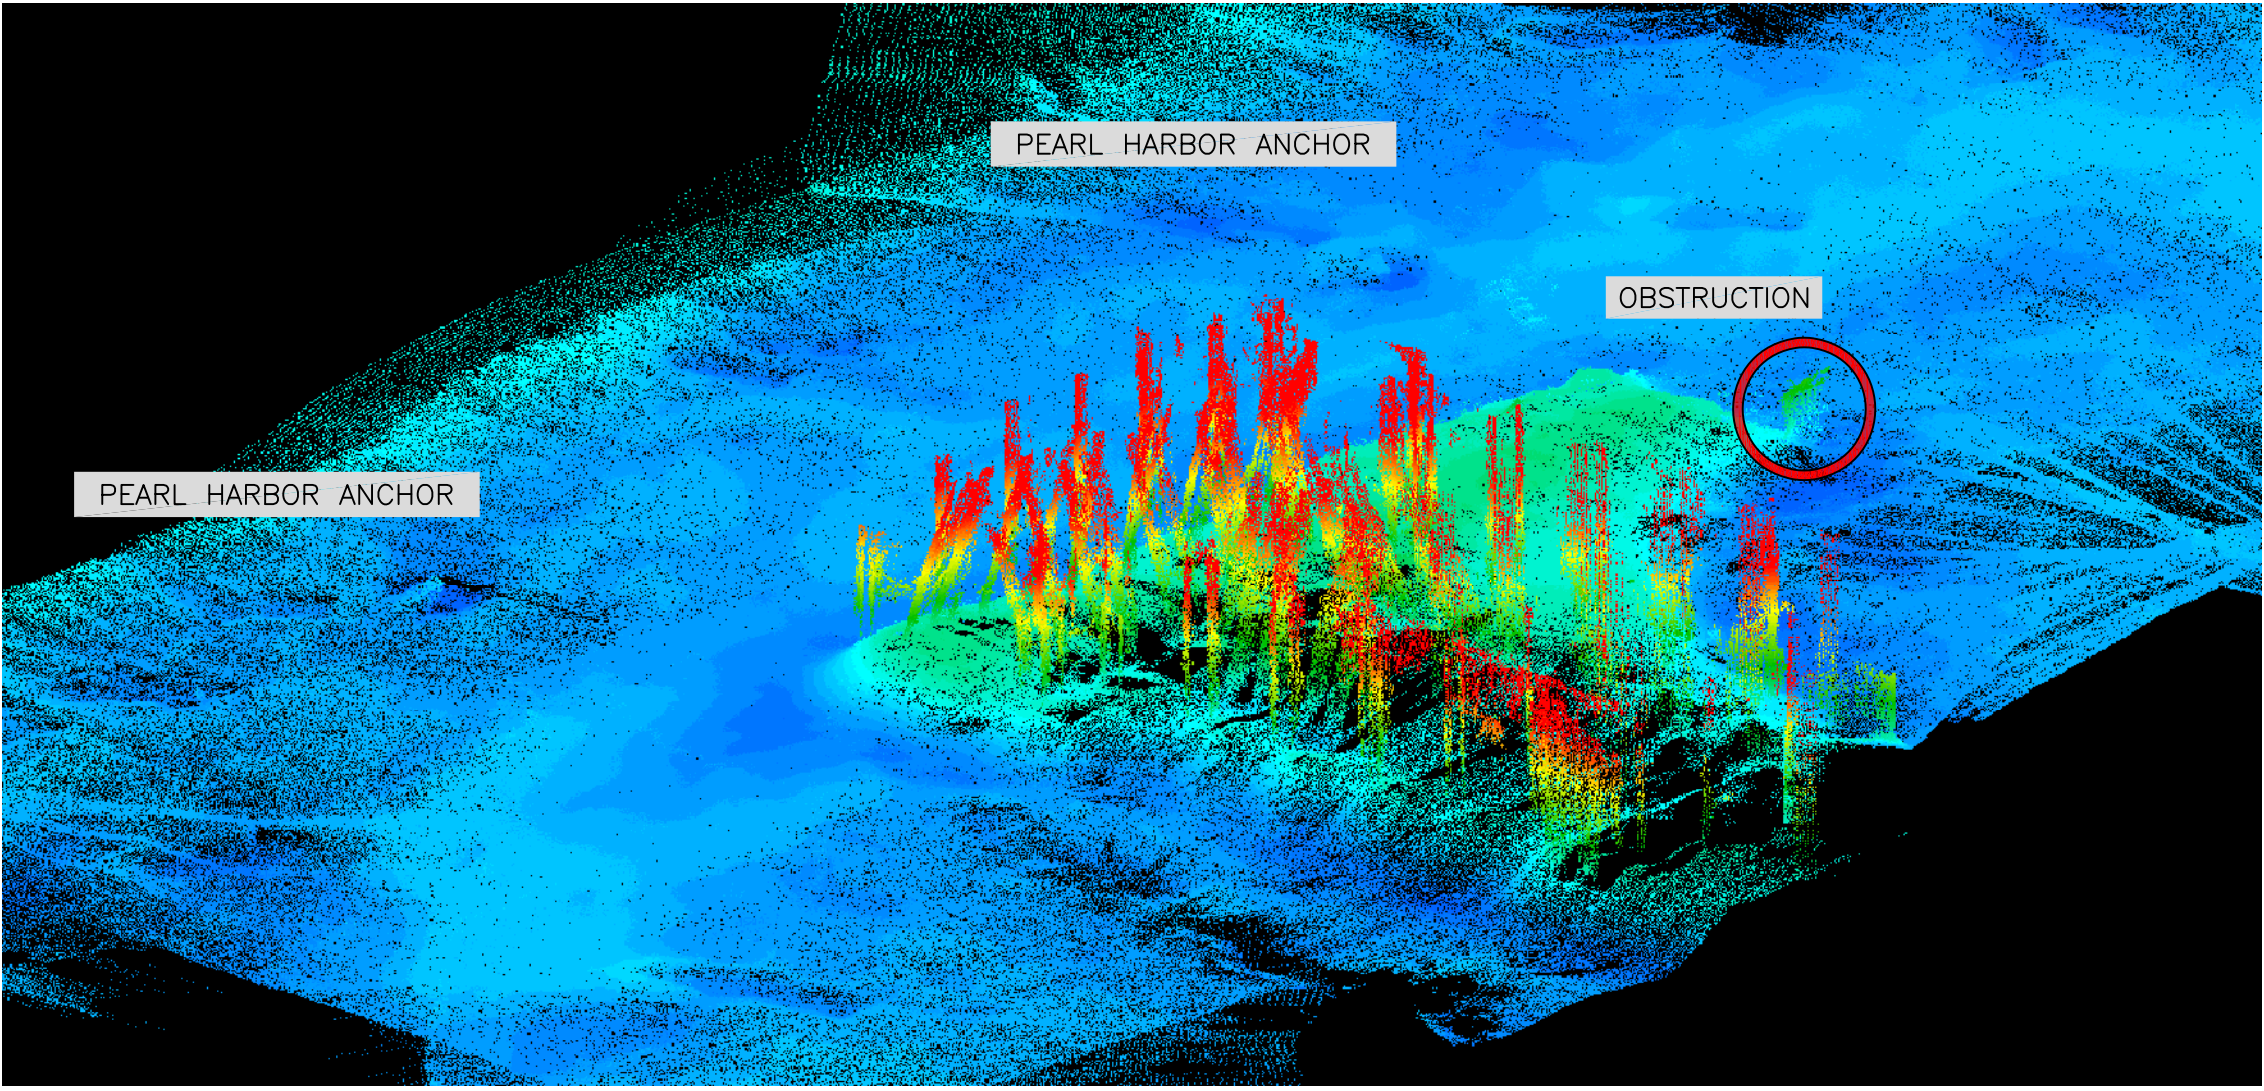


SE CORNER

PRE

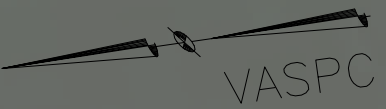

PIER 11

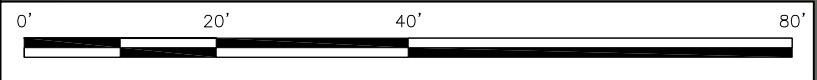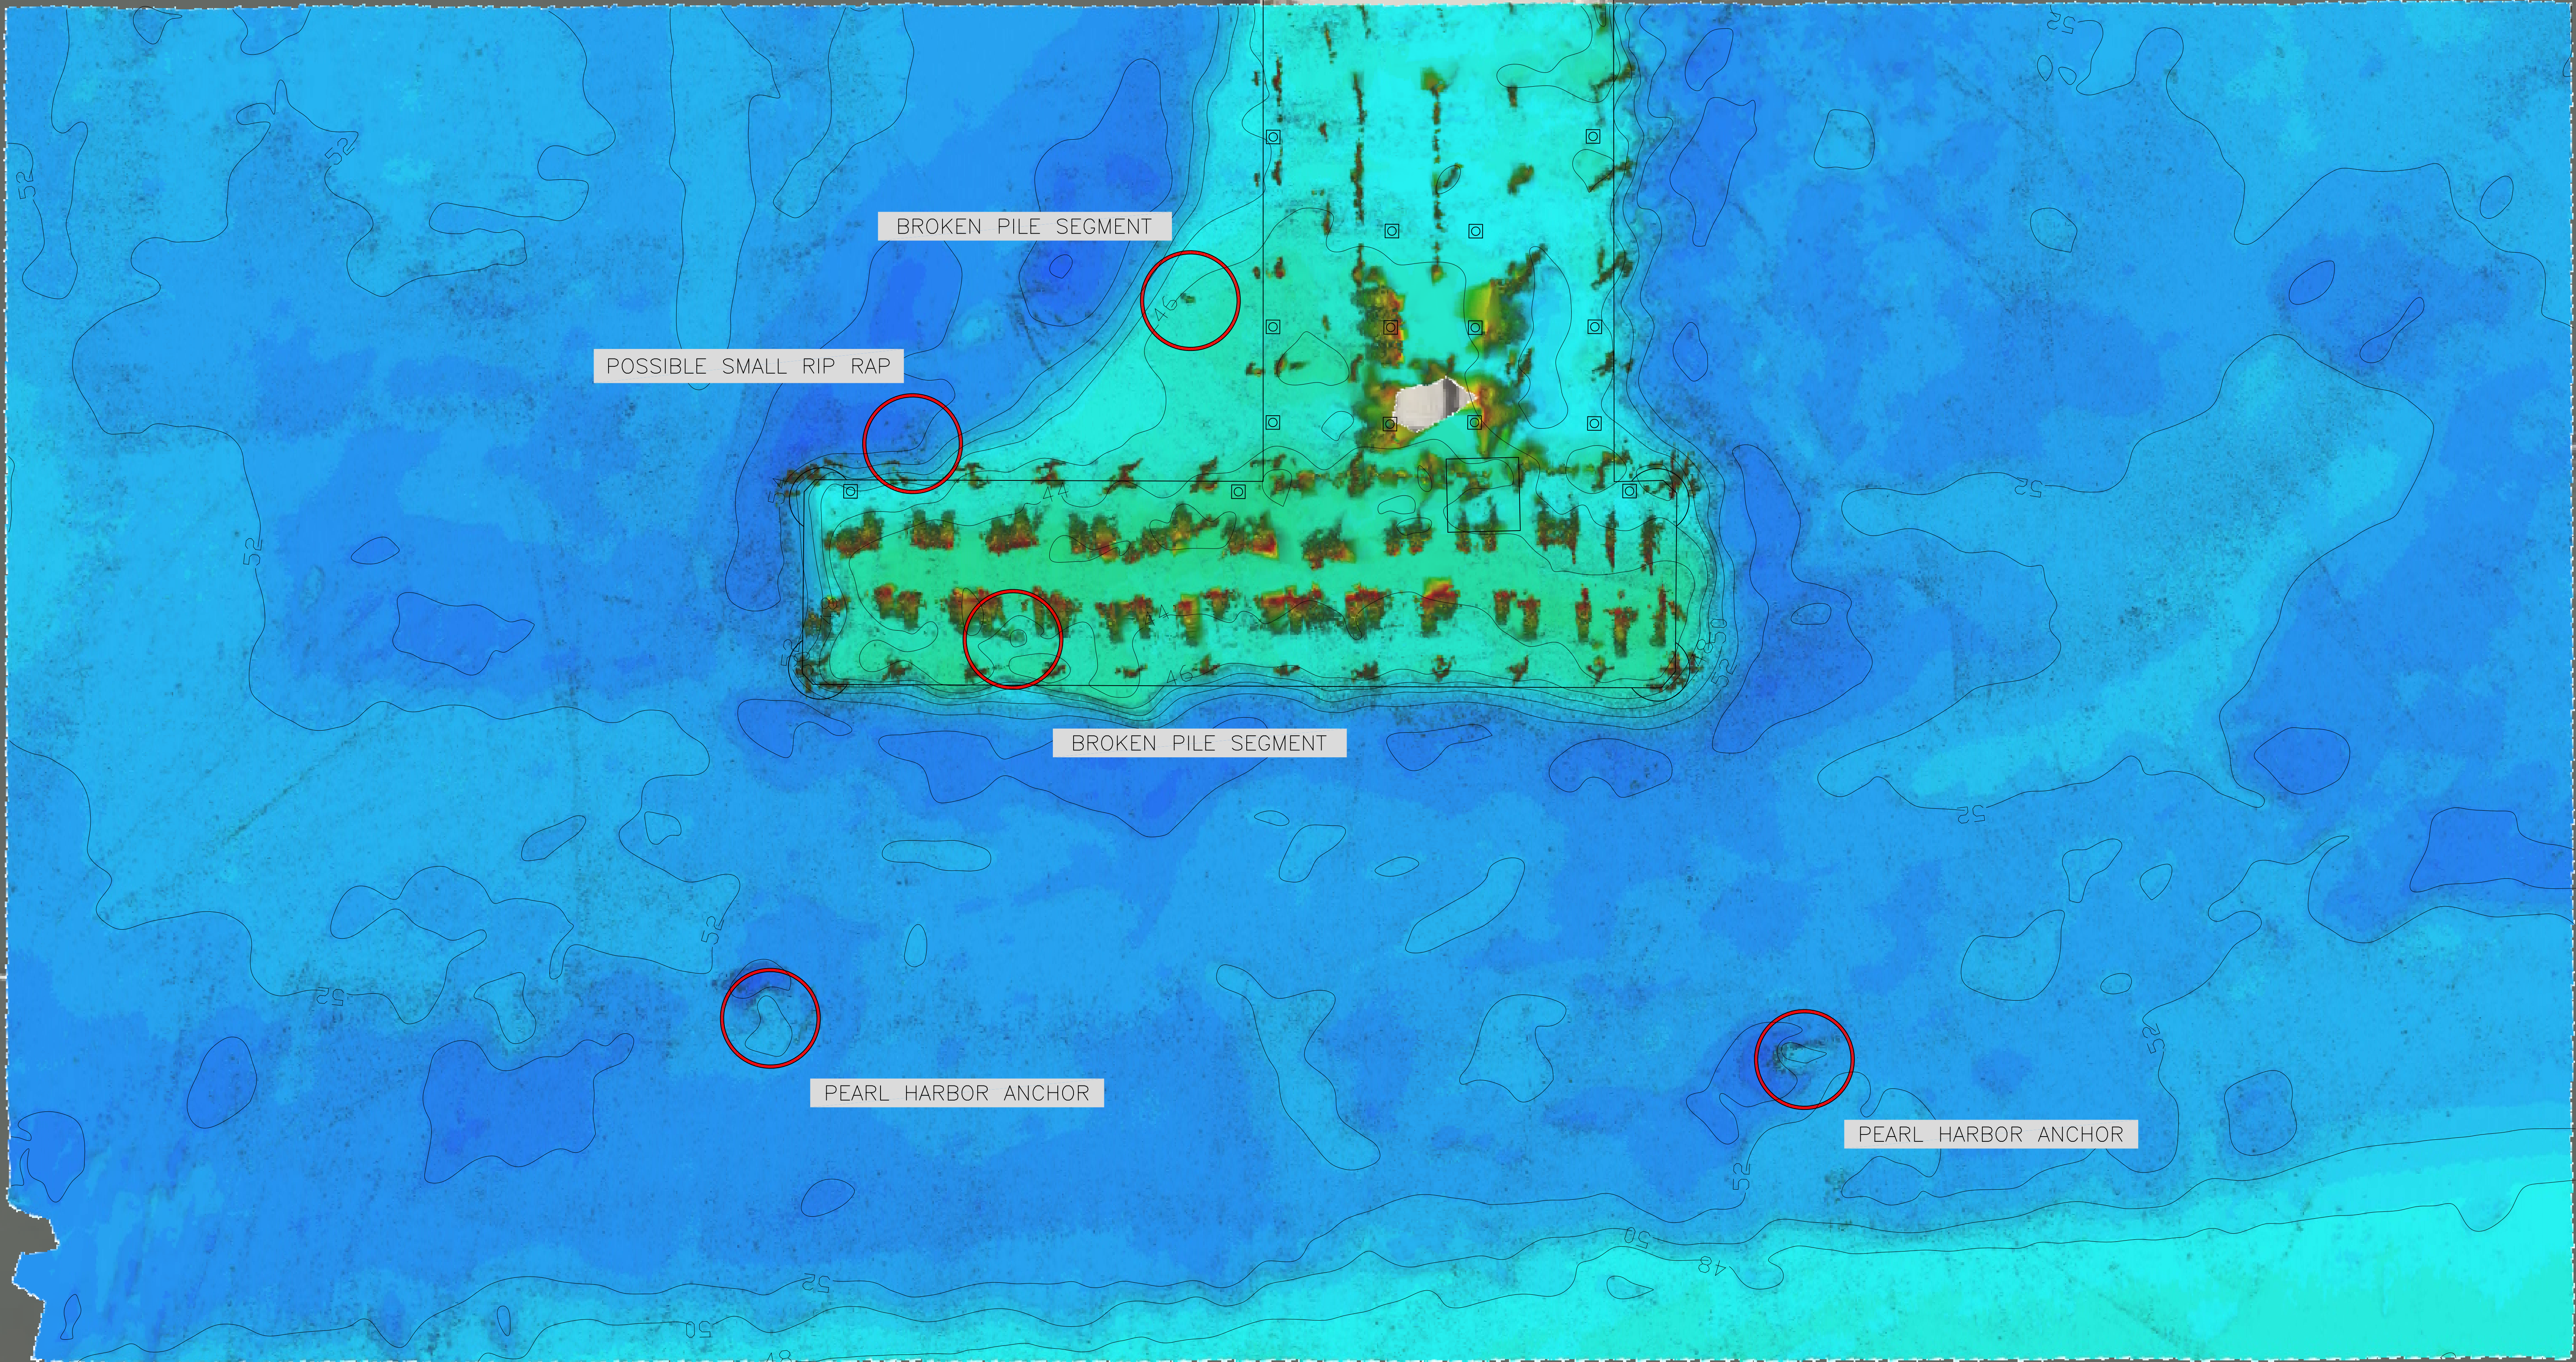


H: STATE PLANE NAD-83 VIRGINIA SOUTH	PROJECT
V: MLW - 1.64' SEPARATION BETWEEN NAVD88	UNITS: FEET
UNITS: FEET	SURVEY DATE: JANUARY 23, 2025
VESEL: BAYLEIGH W.	ECHOSOUNDER: RESON T50 MULTIBEAM OPERATING AT 200 kHz
GPS: APPLANIX POSMV WAVEMASTER	CORRECTIONS: VBS RTK NETWORK

NAVAL BASE NORFOLK PIER 11 PROJECT NORFOLK, VA	PRECONSTRUCTION SURVEY DEBRIS CONTACTS
--	---

NAME FILE NAME 2512.250123.PRE	SCALE 1" = 20'
DRAWN BY DM	DATE JANUARY 31, 2025


DRAWING NO 001	SHEET 1 OF 2
-------------------	-----------------

15314 CARROLLTON BLVD.
CARROLLTON, VA 23314
TEL: 757-412-8375 FAX: 757-257-7006

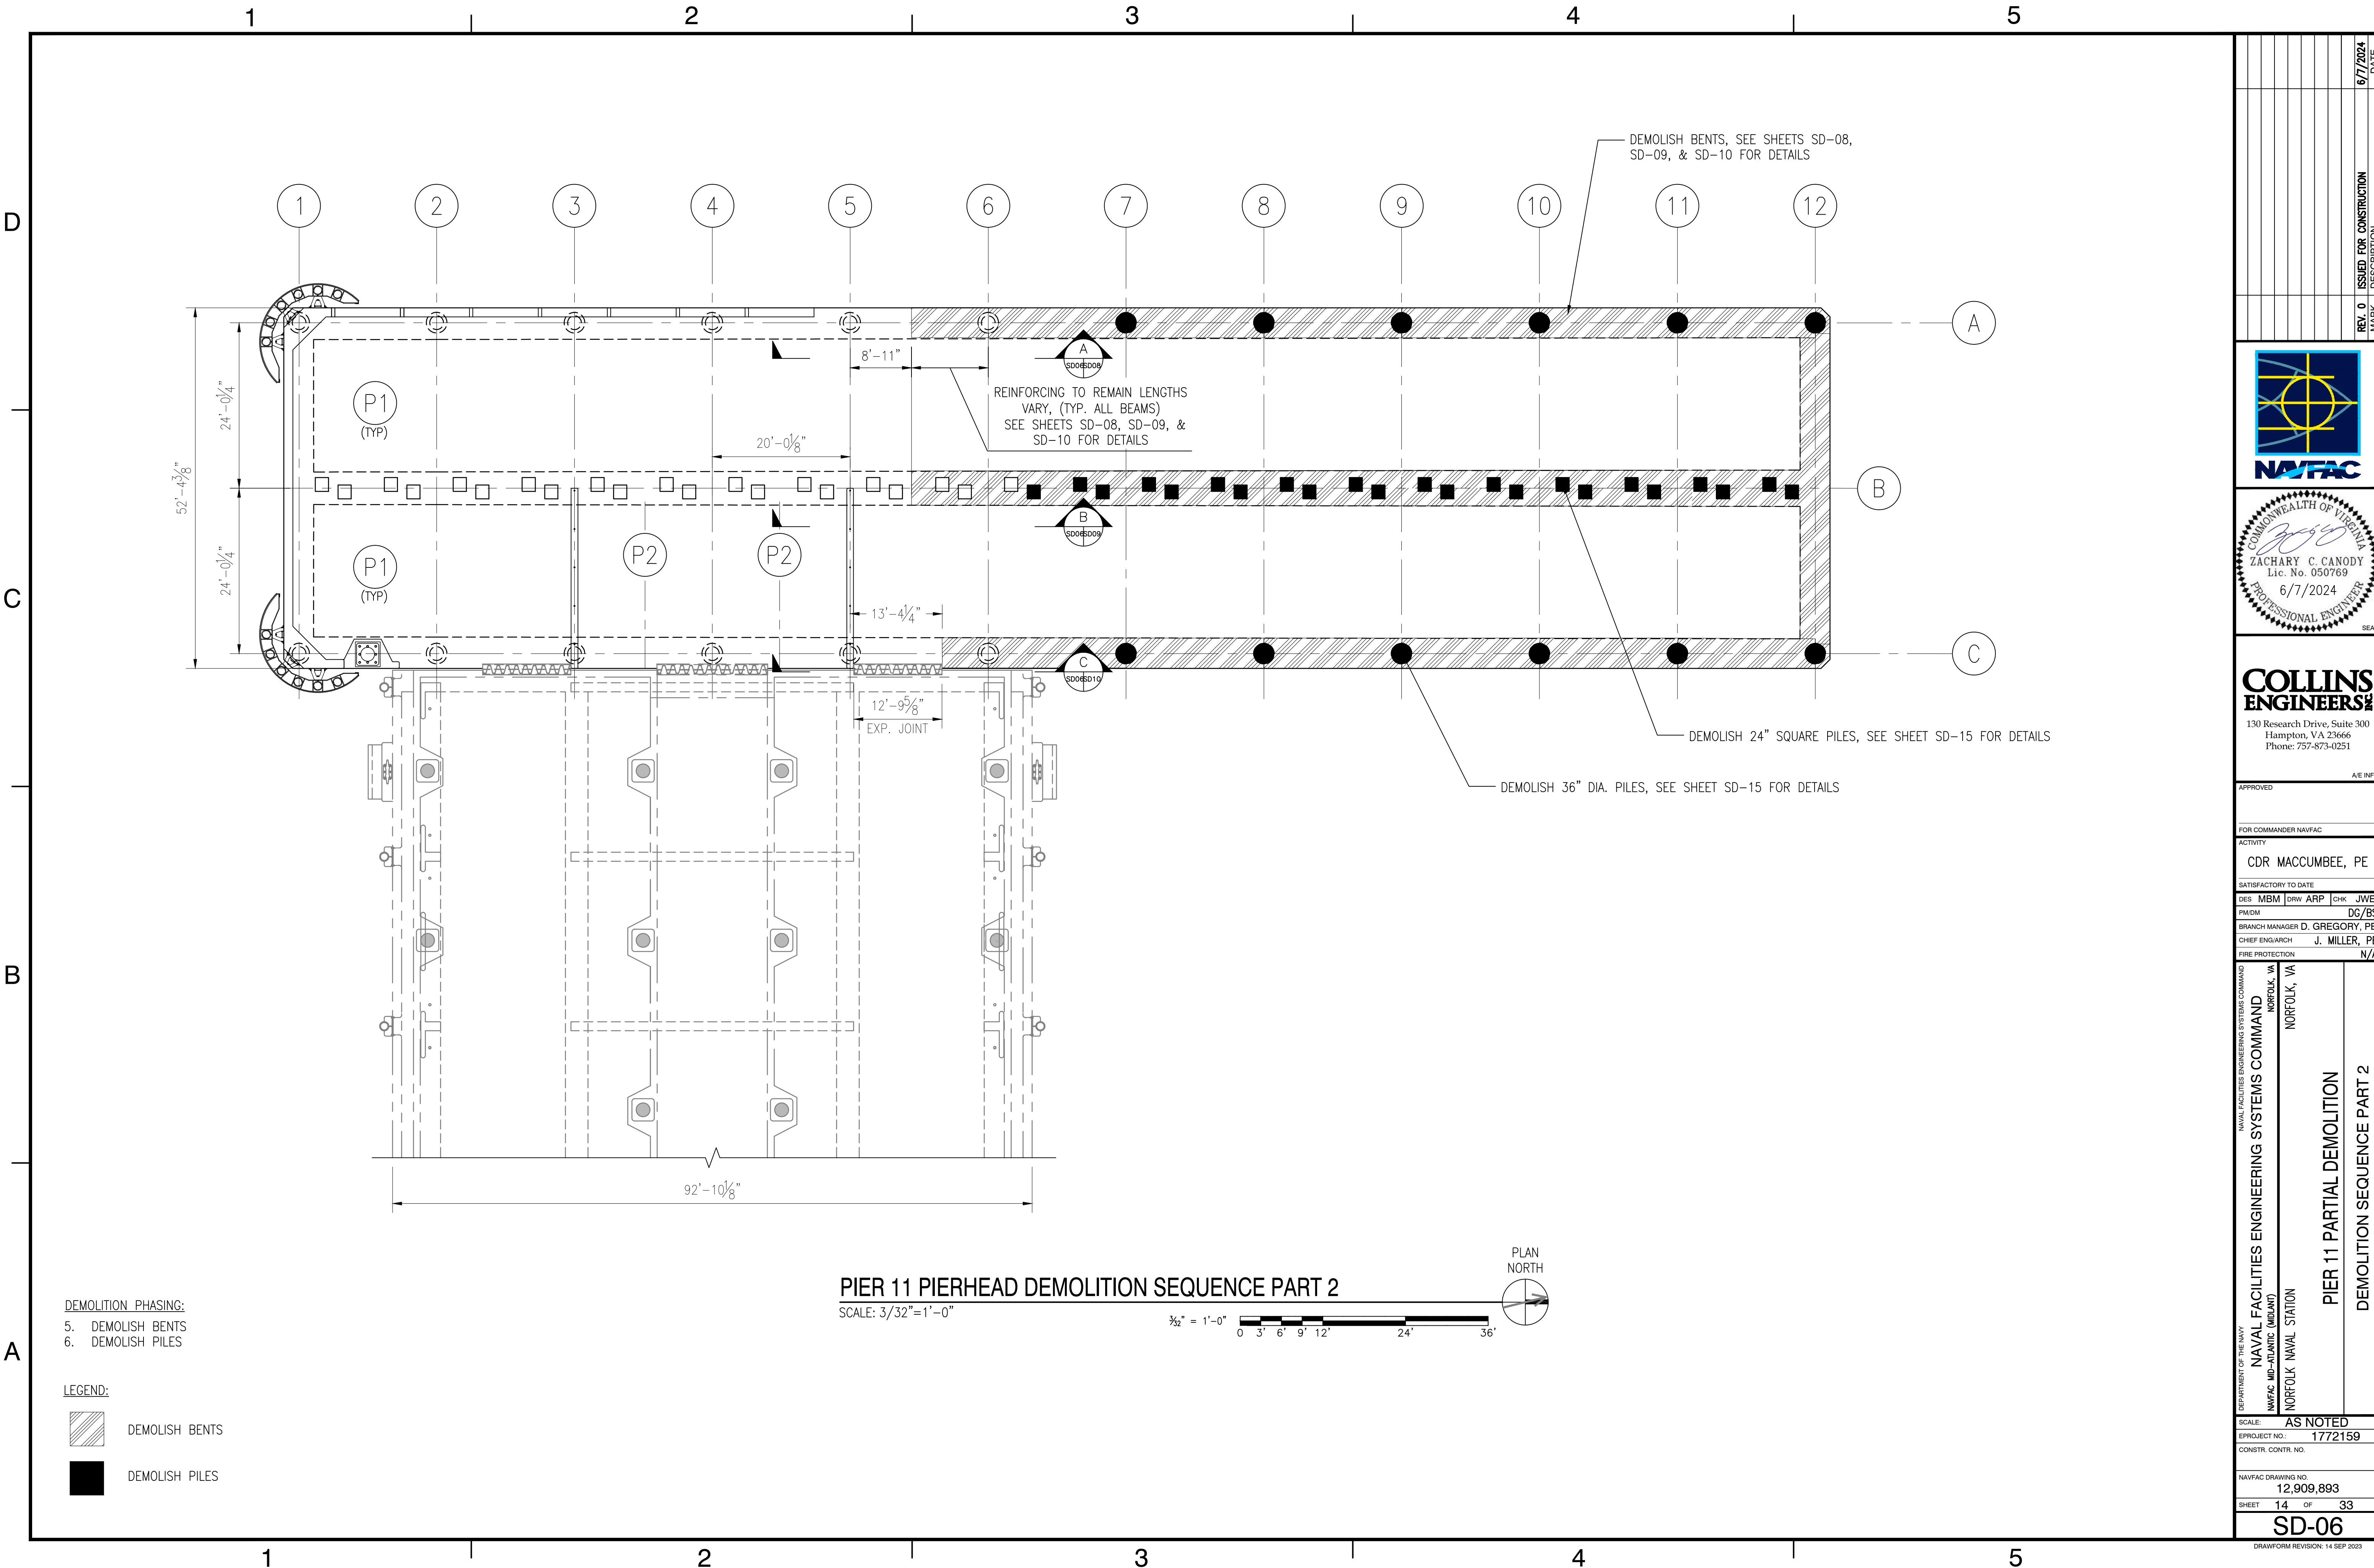

PIER 11 PIERHEAD DEMOLITION SEQUENCE PART 2

SCALE: 3/32"=1'-0"

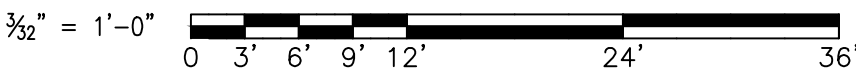


DEMOLITION PHASING:
5. DEMOLISH BENTS
6. DEMOLISH PILES

LEGEND:


- DEMOLISH BENTS
- DEMOLISH PILES

REV. 0		ISSUED FOR CONSTRUCTION	DATE
MARK		DESCRIPTION	6/7/2024
COLLINS ENGINEERS 130 Research Drive, Suite 300 Hampton, VA 23666 Phone: 757-873-0251			
APPROVED			
FOR COMMANDER NAVFAC			
ACTIVITY			
CDR MACCUMBEE, PE			
SATISFACTORY TO DATE			
DES	MBM	DRW	ARP
CHK	JWE		
PM	DC	BS	
BRANCH MANAGER D. GREGORY, PE			
CHIEF ENGINEER J. MILLER, PE			
FIRE PROTECTION N/A			
NAVY FACILITIES ENGINEERING SYSTEMS COMMAND			
NAVFAC MID-ATLANTIC (JULIANT)			
NORFOLK, VA			
NORFOLK NAVAL STATION			
PIER 11 PARTIAL DEMOLITION			
DEMOLITION SEQUENCE PART 2			
SCALE: AS NOTED			
EPROJCT NO.: 1772159			
CONSTR. CONTR. NO.			
NAVFAC DRAWING NO. 12,909,893			
SHEET 14 OF 33			
SD-06			
DRAWFORM REVISION: 14 SEP 2023			



1. "PIER 11 REPLACEMENT", SHEET S-653 AND S-654 BY LANTDIV NAVAL FACILITIES ENGINEERING COMMAND, DATED DECEMBER 2008

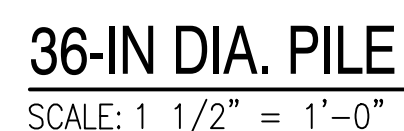

1. DESIGN THE 3-FT DIA. PILE FOR AN AXIAL COMPRESSIVE LOAD OF 303.1 TONS (275 METRIC TONS) (EST. BID LENGTH = 98.4 FT (30.1-M)).
2. PILES MAY BE PRECAST AND PRESTRESSED MONOLITHICALLY TO THE FULL DESIGN LENGTH REQUIRED, OR PRECAST IN SECTIONS POST-TENSION TOGETHER TO THE FULL DESIGN LENGTH.
3. COAT THE TOP 24.61 FT (7500 MM) OF ALL PILES WITH COAL TAR EPOXY PRIOR TO DRIVING.
4. CONTRACTOR MAY SUBMIT FOR APPROVAL, ALTERNATIVE PILES DIAMETERS. ONLY CYLINDRICAL, CENTERFUGALLY-CAST PILES ARE ACCEPTABLE.

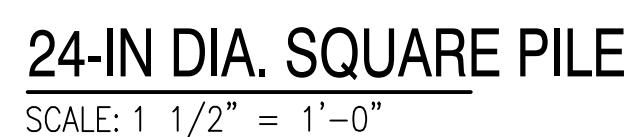

1. DESIGN THE 2-FT SQUARE PILES FOR A COMPRESSIVE OR TENSILE AXIAL LOAD OF 198.4 TONS (180 METRIC TONS) (EST. BID LENGTH = 170.6 FT (52.0 M)). DESIGN THE EFFECTIVE PRESTRESS (AFTER LOSSES) TO PREVENT NET CONCRETE TENSION AT FULL TENSILE PILE LOADING.
2. ANCHORAGE IS ACHIEVED BY EXPOSING, SPLAYING, AND CASTING THE PILE PRESTRESSING STRAND INTO CONCRETE CAPS THE CONTRACTOR MAY, AT HIS OPTION, SUBMIT FOR APPROVAL ALTERNATIVE MEANS FOR ACHIEVING A LIVE LOAD ANCHORAGE OF 198.4 US TONS (180 METRIC TONS).
3. COAT THE TOP 24.61 FT (7500 MM) OF ALL PILES WITH COAL TAR EPOXY PRIOR TO DRIVING.
4. HARD DRIVING IS ANTICIPATED. REINFORCE PILES ADEQUATELY TO PENETRATE SAND AND CEMENTED SHELLS EXHIBITED A STANDARD PENETRATION OF 50 TO 60 BLOWS PER FOOT.

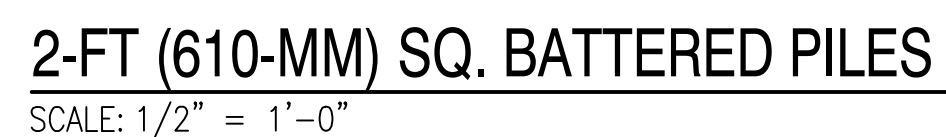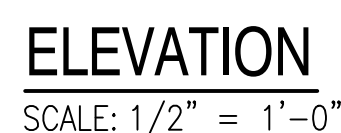[illegible]