
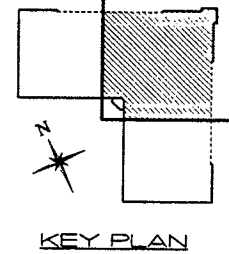


LEV ZETLIN ASSOCIATES
NEW YORK, N.Y. 10011
TEL. 212-741-1500
FAX 212-741-1500
10/15/98
360A108

PLOTTING SCALE: 1/8" = 1'-0"

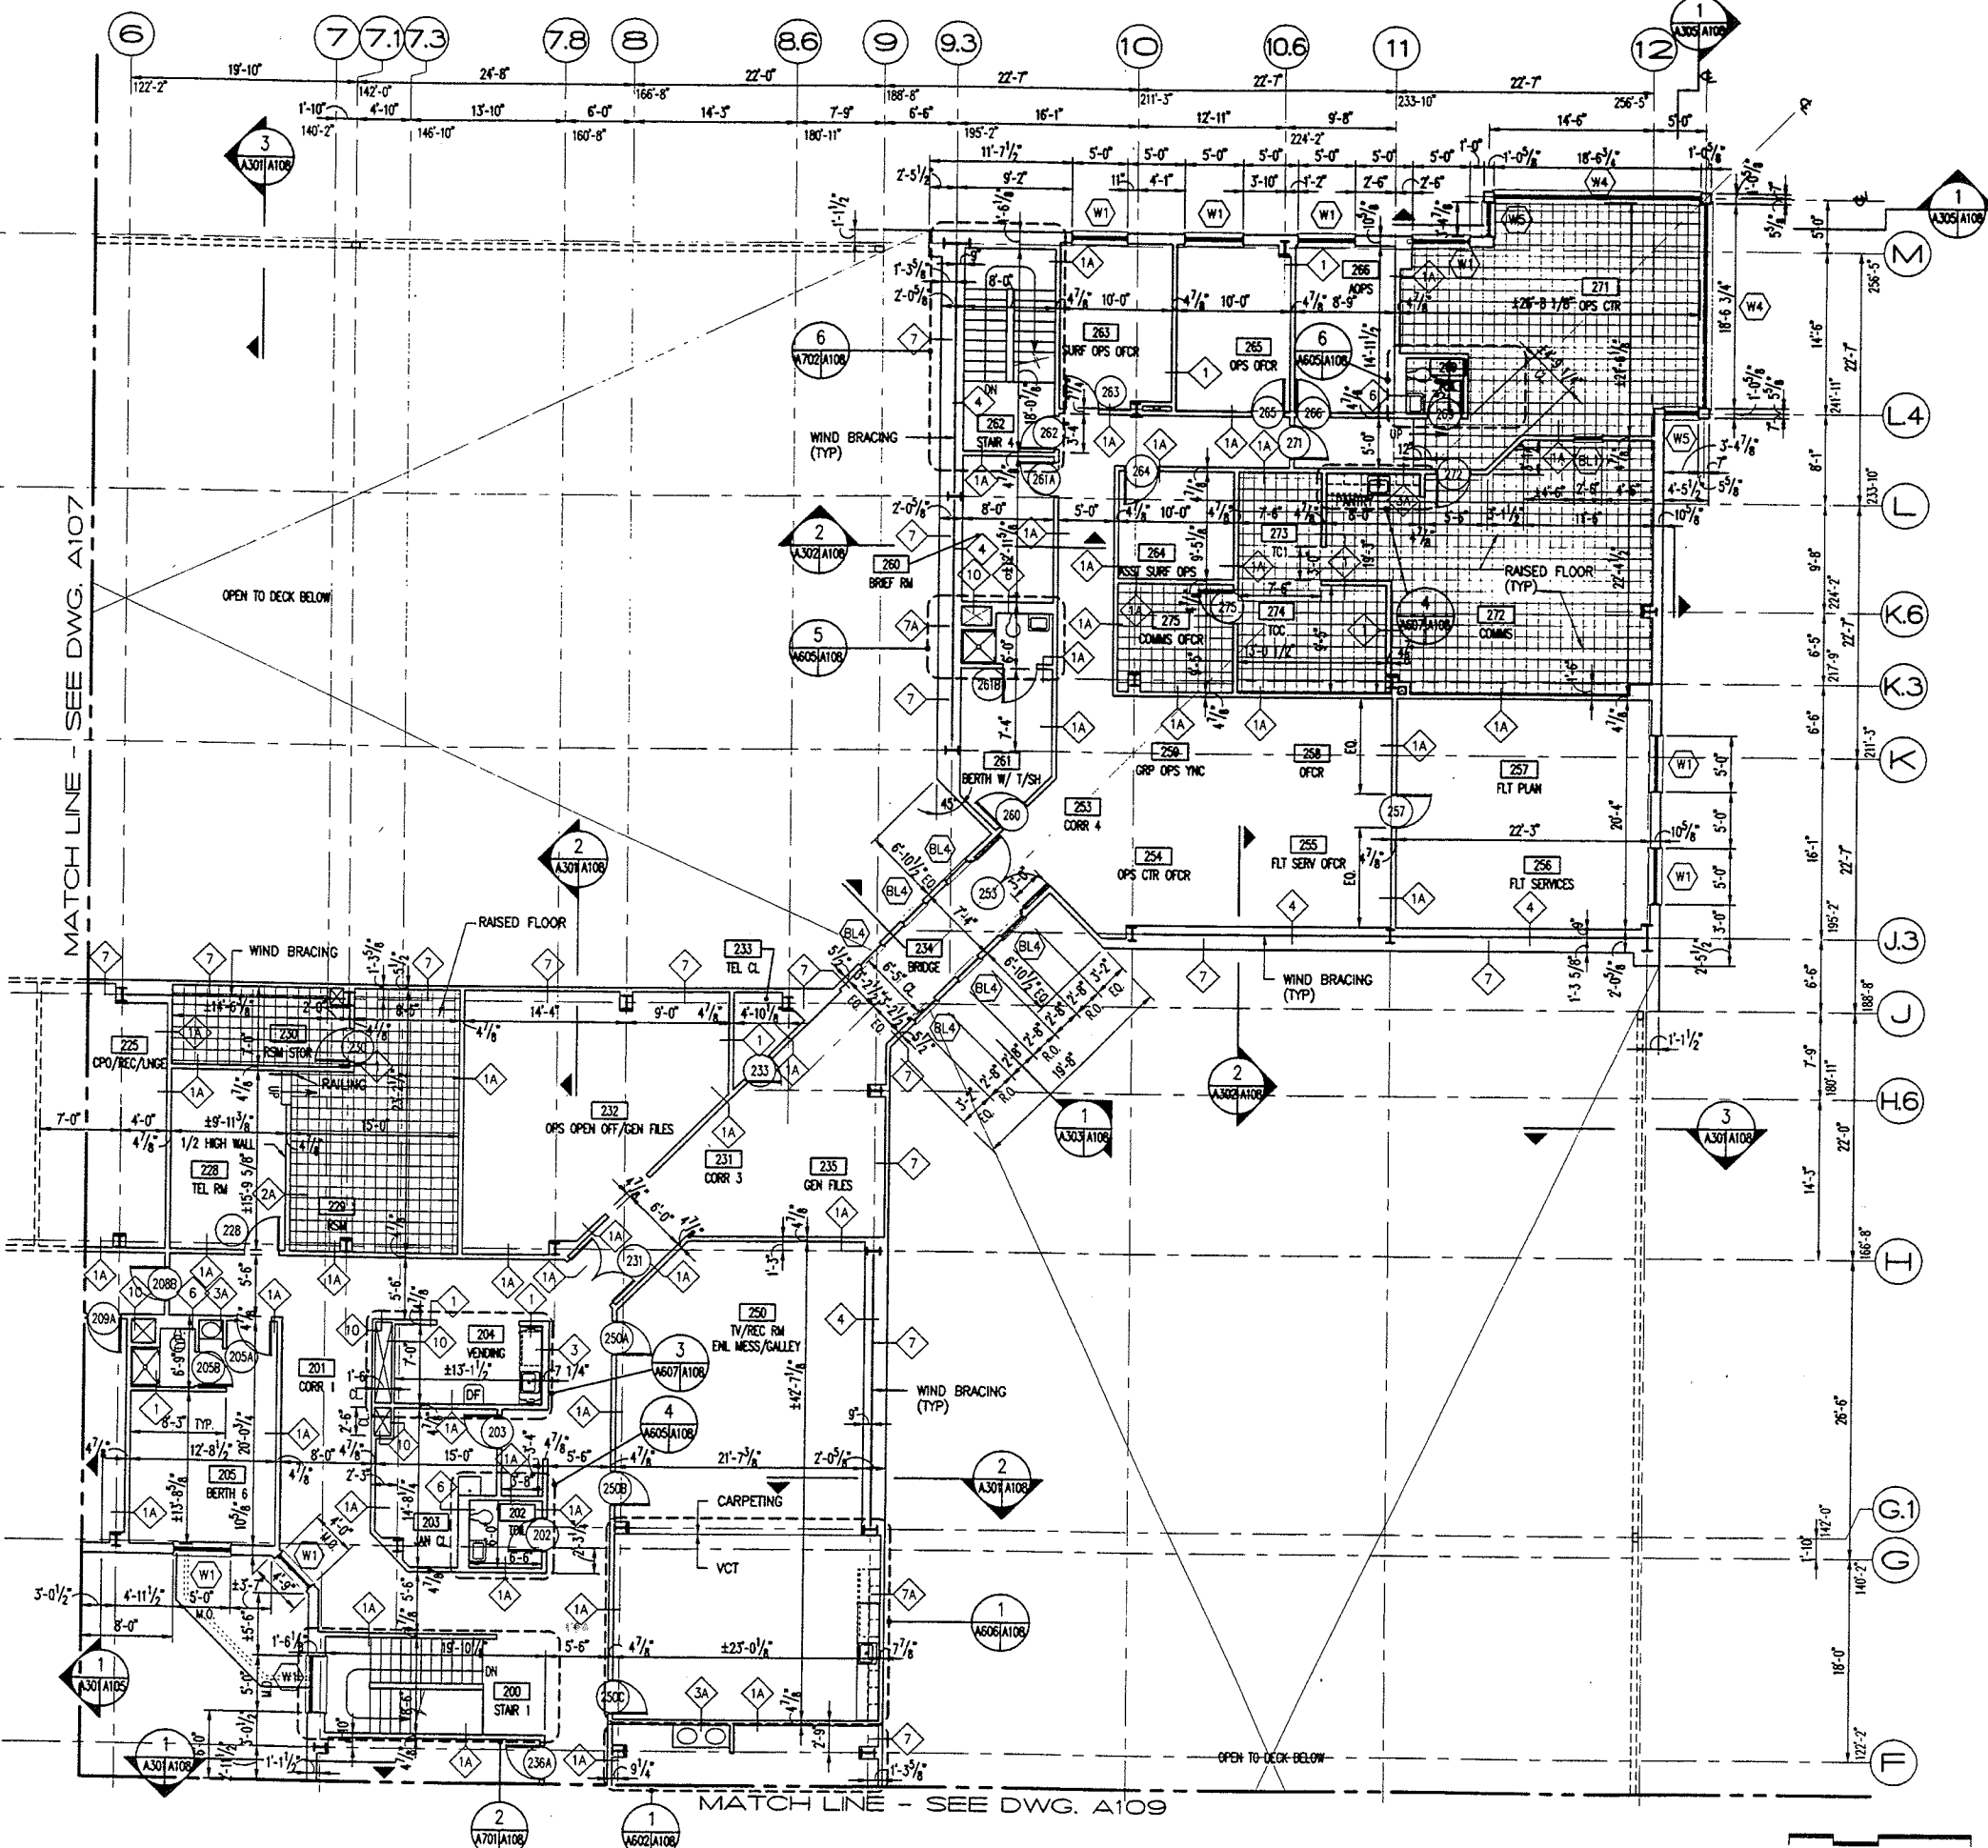

3/30/99			RECORD DRAWING		
REV.	DATE	APPR.	DESCRIPTION		BY
DESIGNED	A.S.		U.S. COAST GUARD		NORFOLK, VA.
DRAWN	J.O.		FACILITIES DESIGN & CONSTRUCTION CENTER		
EDITED	A.S.		CIVIL ENGINEERING		
CHECKED	D.M.		MID-ATLANTIC AIR STATION CONSOLIDATION		
REVIEWED BY:			AIR STATION ATLANTIC CITY		
PROJECT ENGINEER			ATLANTIC CITY		NEW JERSEY
REVIEWED BY:			ARCHITECTURE		
BRANCH CHIEF			SECOND FLOOR PLAN - PART "B"		
REVIEWED BY:			APPROVED:	DISCIPLINE/SHT NO.	A108
			CHIEF OF DIVISION	DATE	
			DRAWING NUMBER		05-X3660
			SCALE: 1/8"=1'-0"		SHEET 49 OF 241

LEV ZETLIN ASSOCIATES
641 Avenue of the Americas
New York, N.Y. 10011
Tel. 212-741-1500

THIS DRAWING HAS BEEN REDUCED TO HALF SIZE