


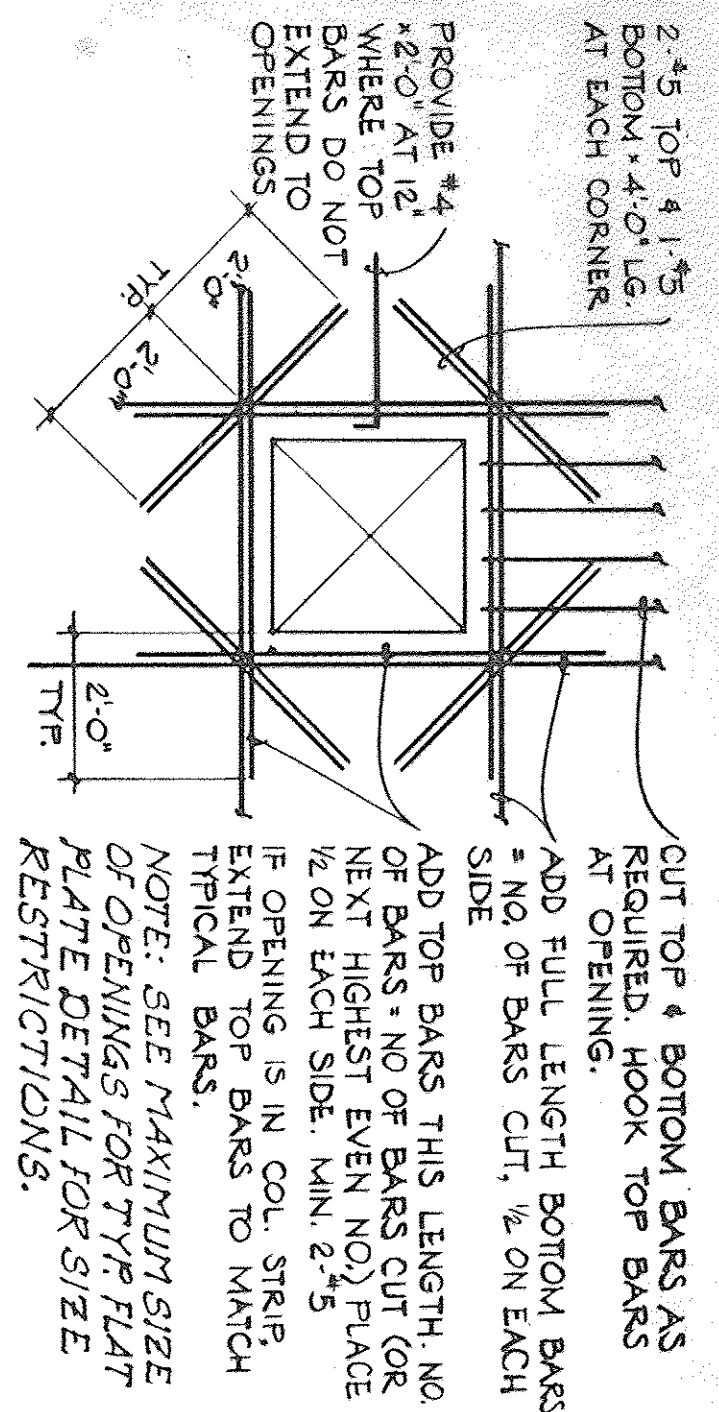


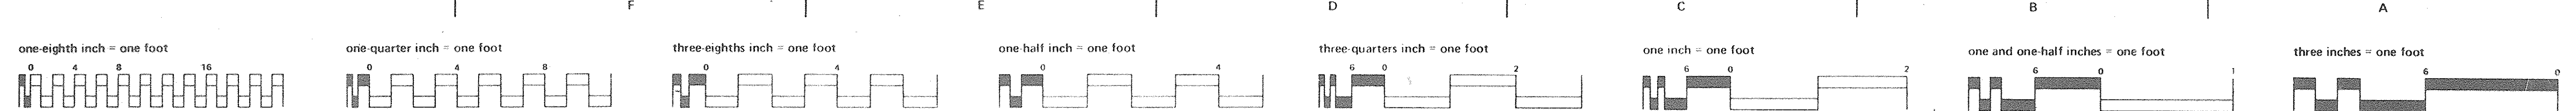


TYPICAL FLAT PLATE OPENING DETAILS

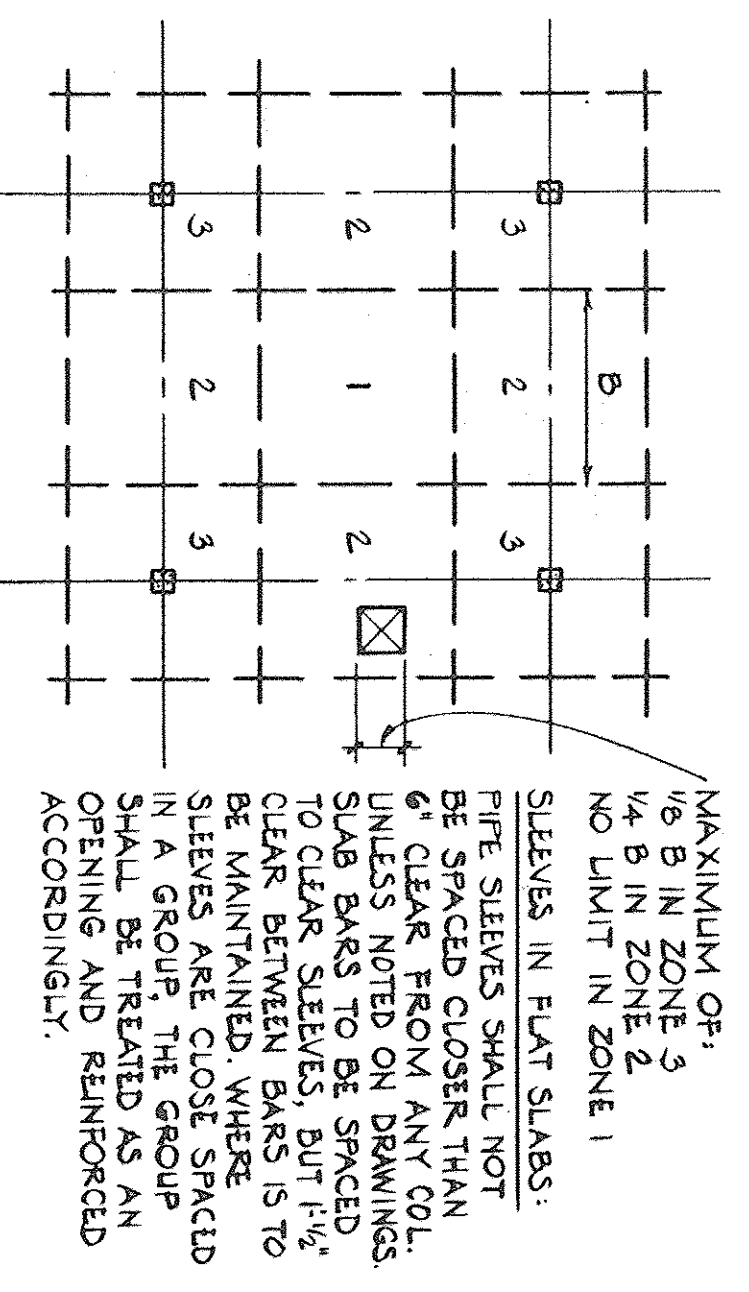


MAXIMUM SIZE OF OPENINGS FOR TYPICAL FLAT PLATE

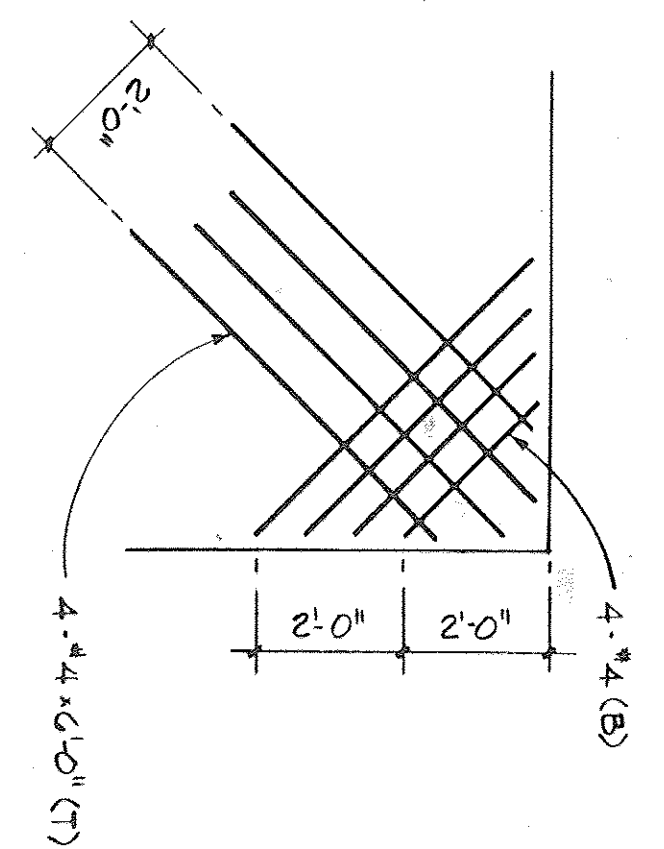


TYPICAL STRUCTURAL SLAB CORNER DETAIL

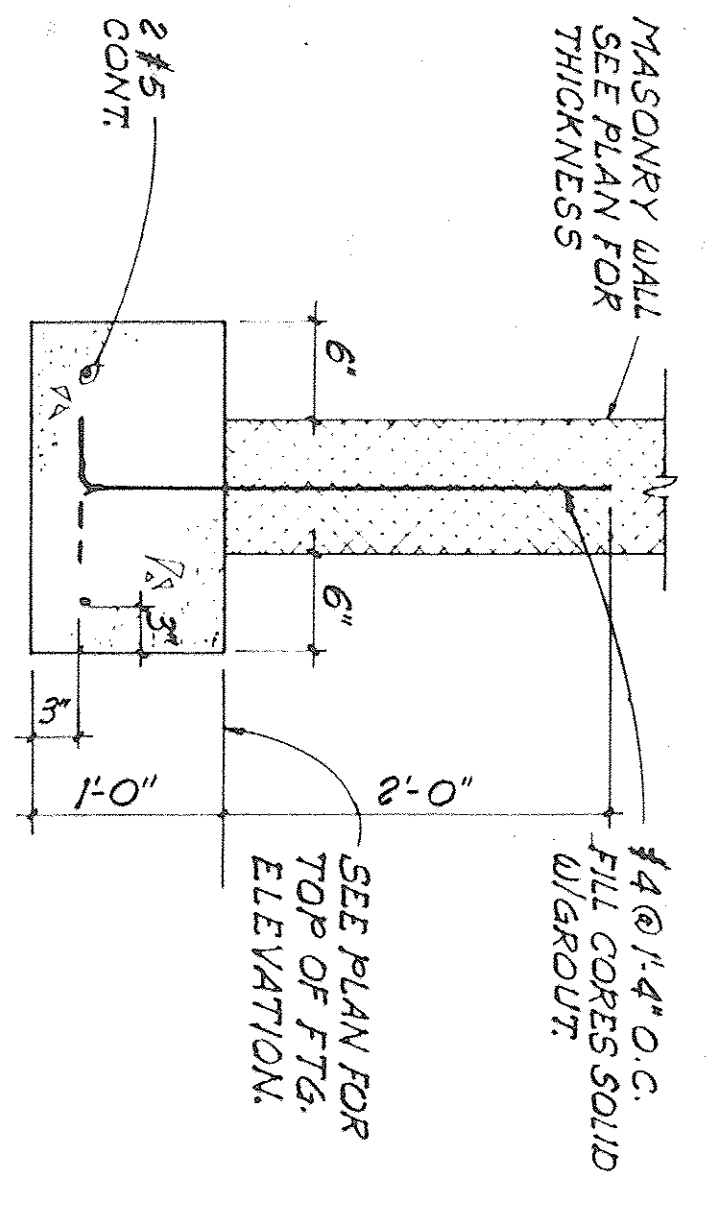


TYPICAL MASONRY WALL FOOTING

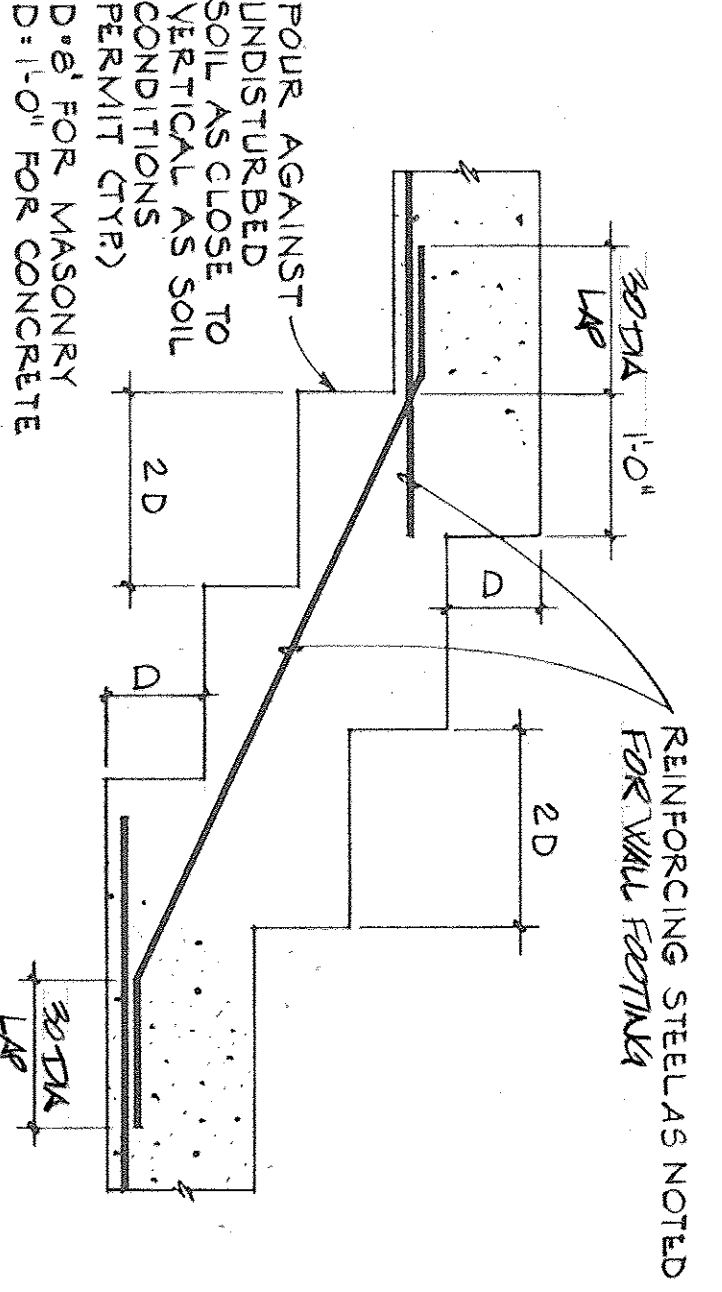


TYPICAL STEPPED WALL FOOTING

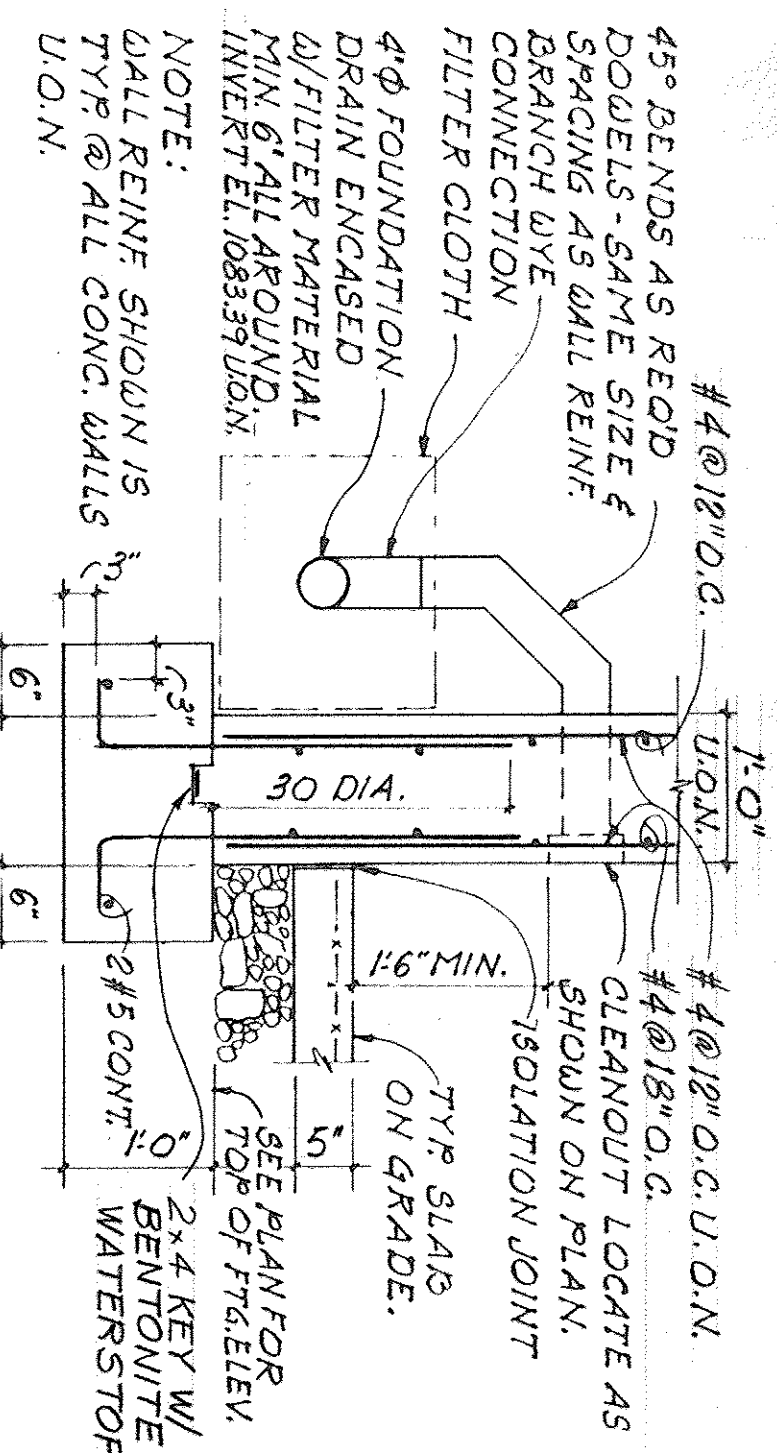


TYP. CONCRETE WALL SUPPORT DETAIL

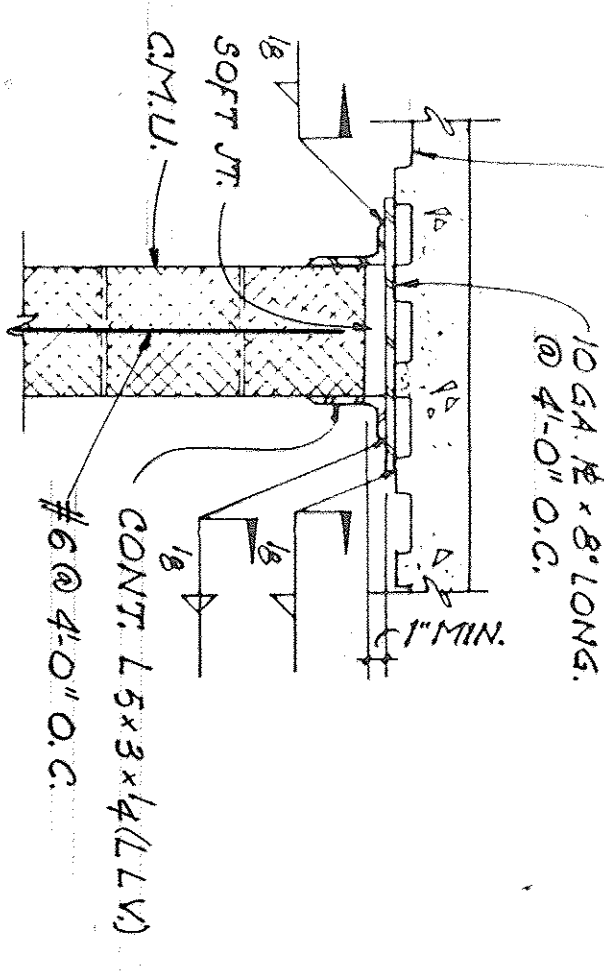


TYP. DECK WITH CONCRETE TOPPING

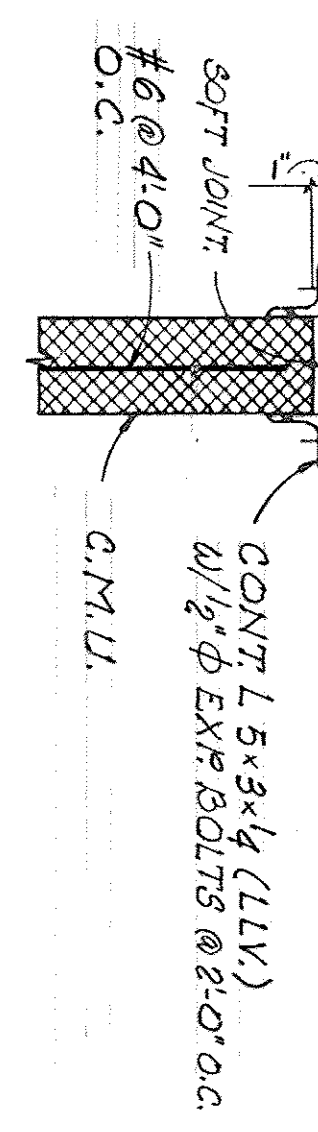


TYPICAL NON-STRUCTURAL MASONRY PARTITION ANCHORAGE DETAIL

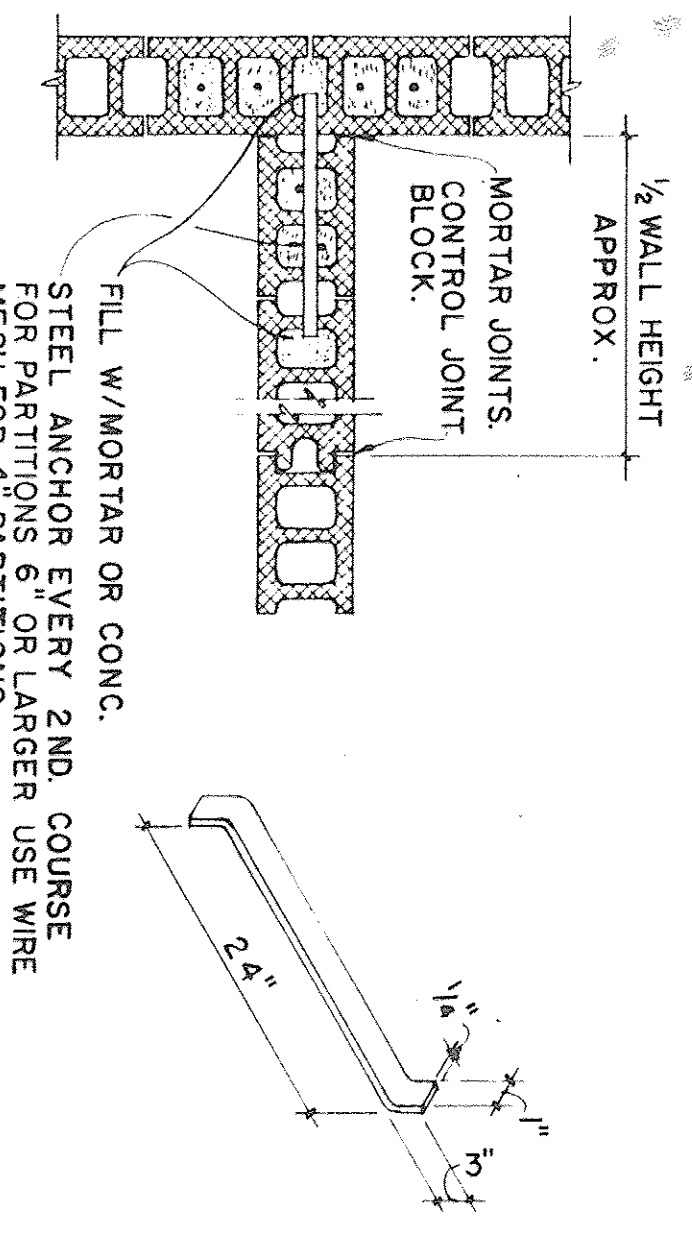


INTERSECTION OF WALLS OR PARTITIONS

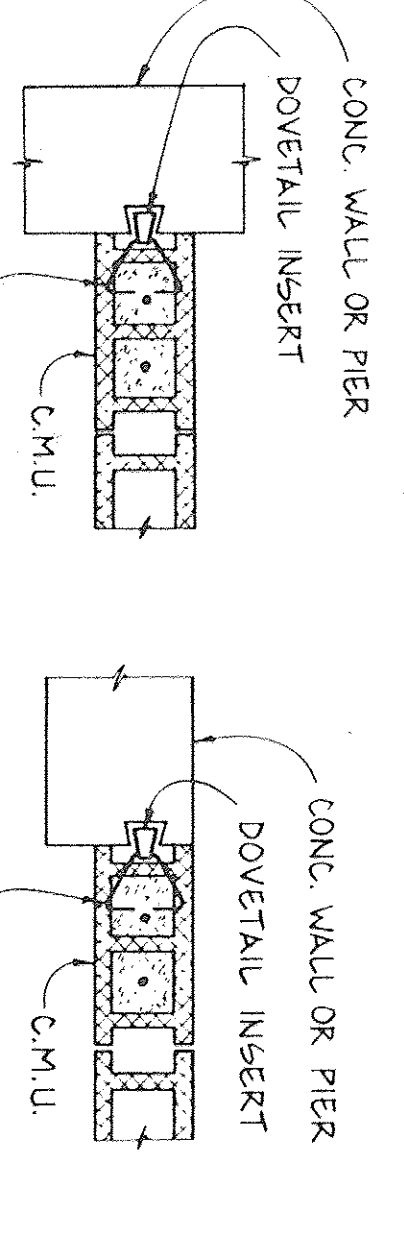


TYP. JOINT DETAIL OF MASONRY WALL ABUTTING CONC. WALL OR PIER

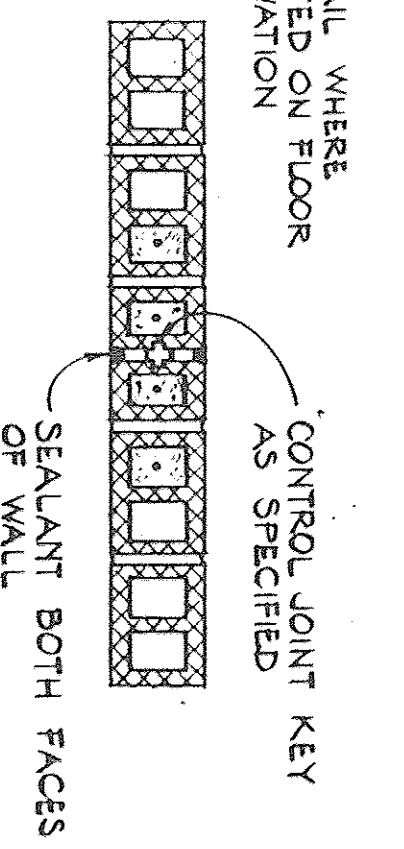


BASIC CONTROL JOINT (C.J.) FOR MASONRY WALLS

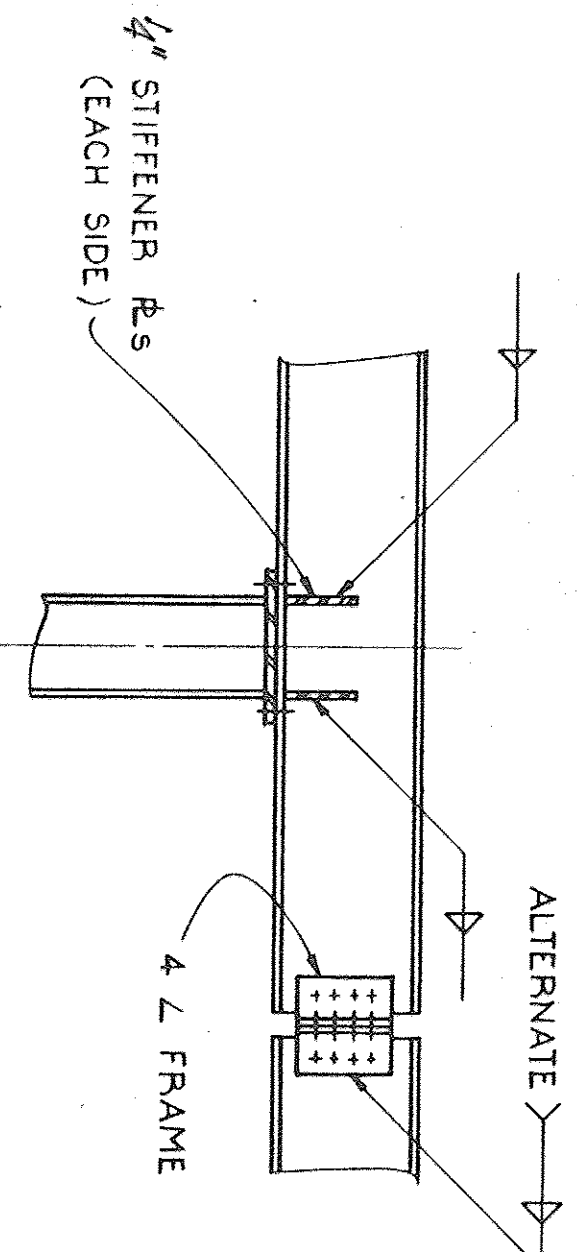


TYPICAL CANTILEVERED BEAM DETAIL

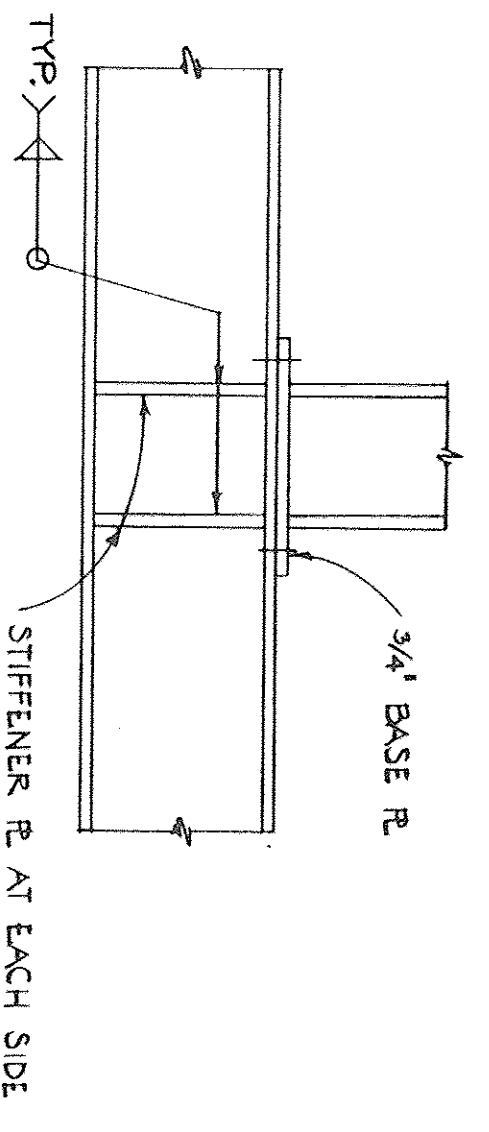


BEAM SUPPORTING COLUMN

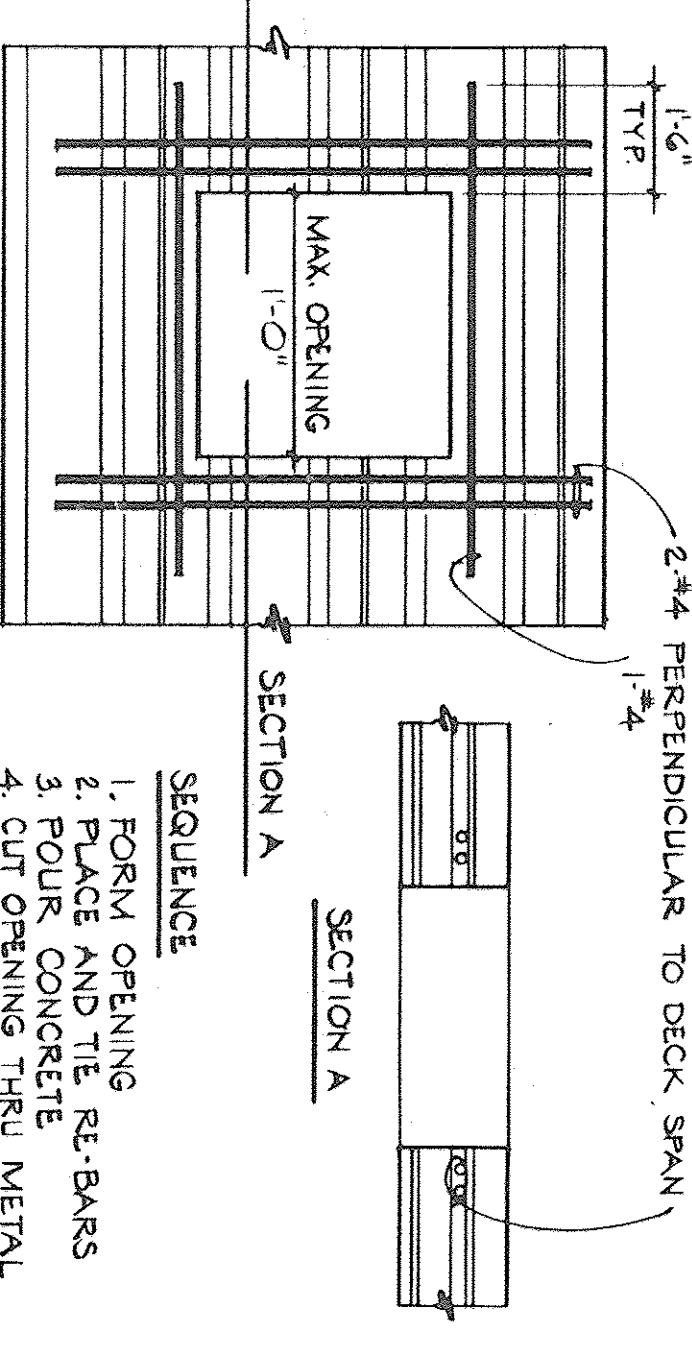


REINFORCED OPENING THROUGH COMPOSITE METAL DECK

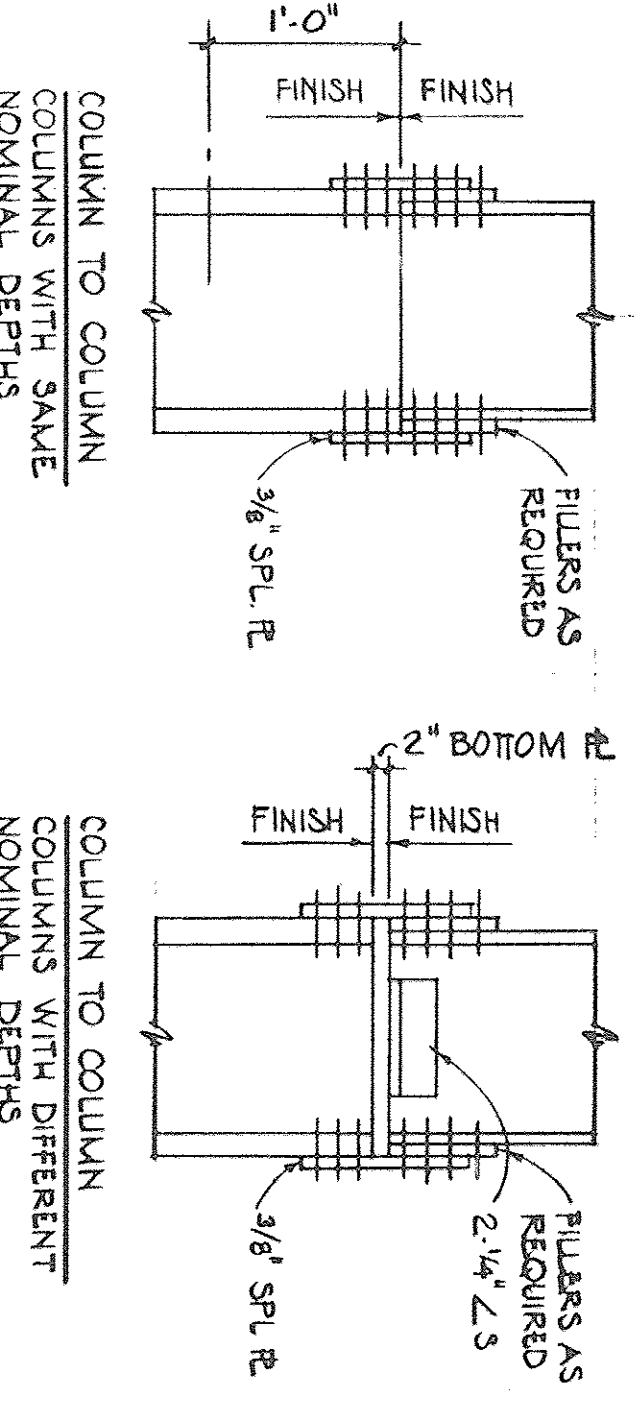


TYPICAL BOLTED COLUMN SPICES

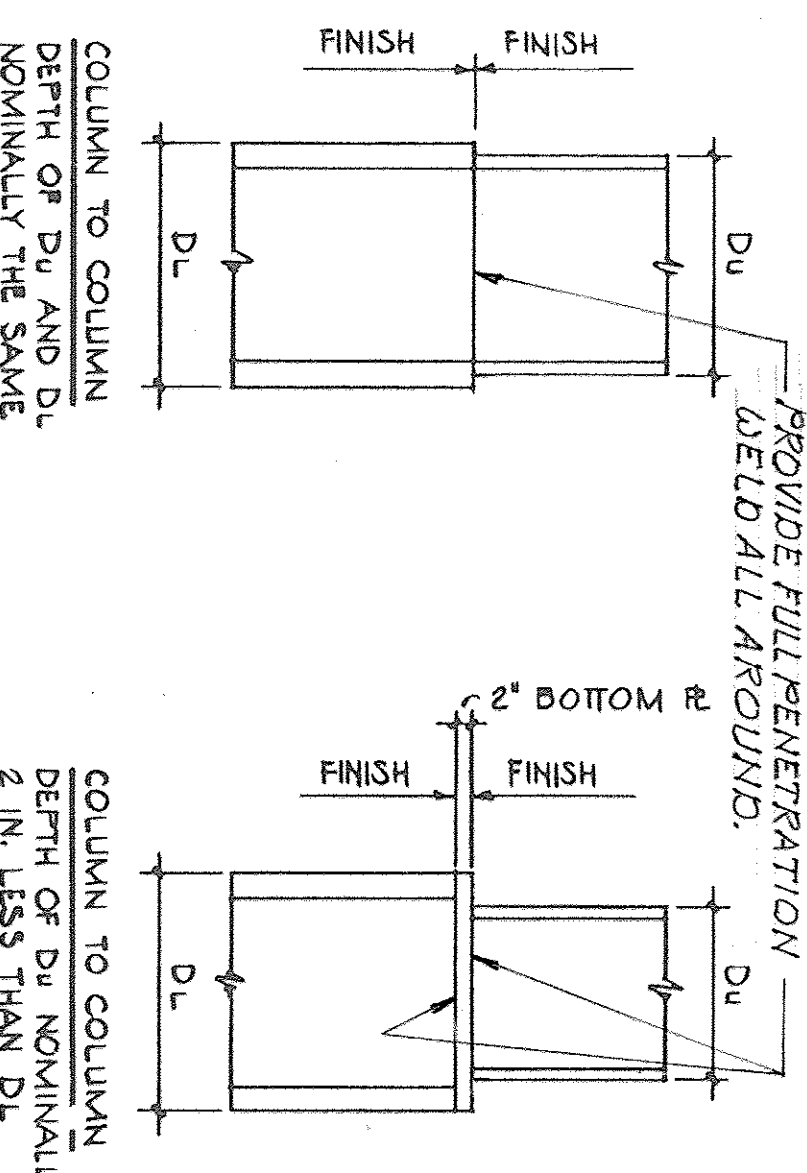


TYPICAL WELDED COLUMN SPICES

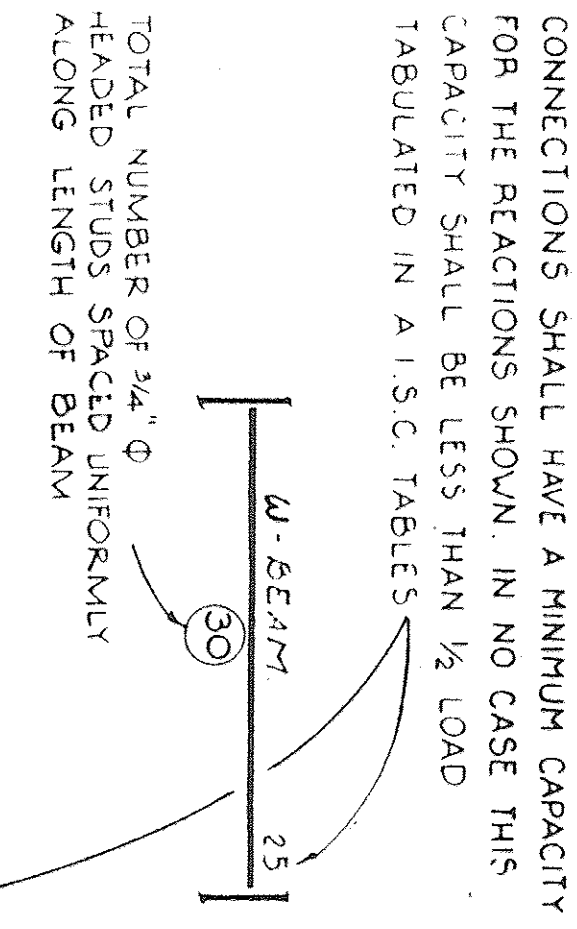


CONNECTIONS SHALL HAVE A MINIMUM CAPACITY FOR THE REACTIONS SHOWN. IN NO CASE THIS CAPACITY SHALL BE LESS THAN 1/2 LOAD TABULATED IN A.I.S.C. TABLES

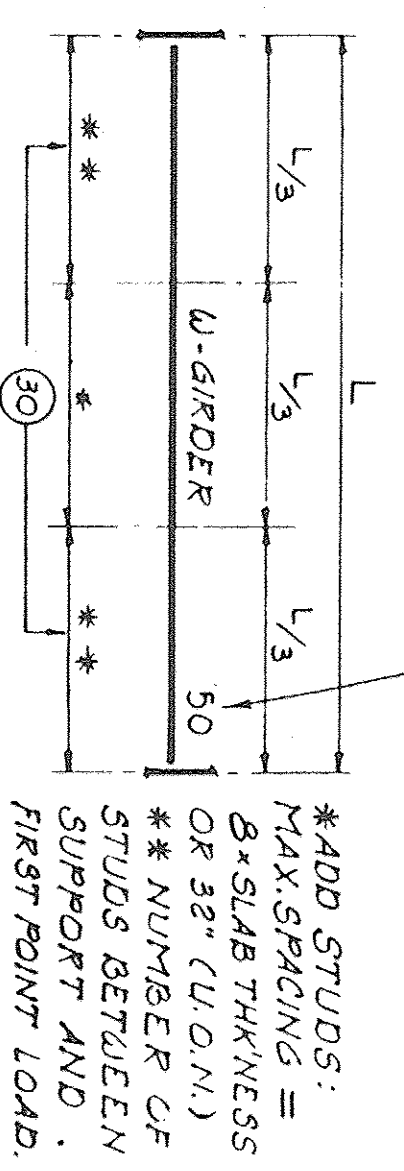


TYP. SHEAR CONNECTOR LAYOUT

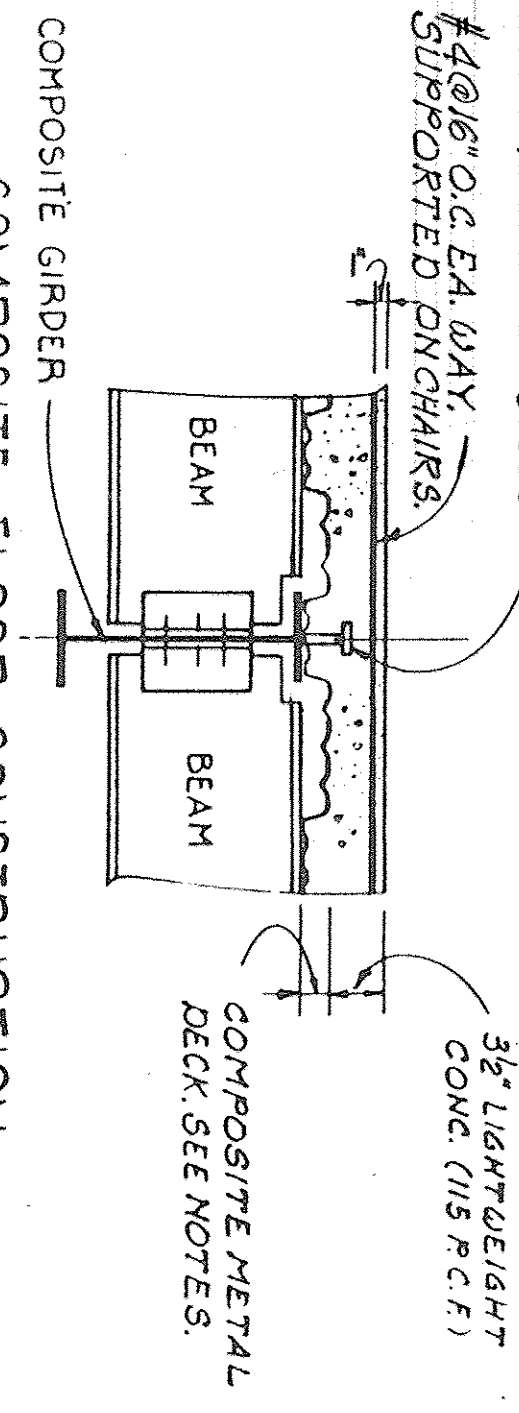


COMPOSITE FLOOR CONSTRUCTION

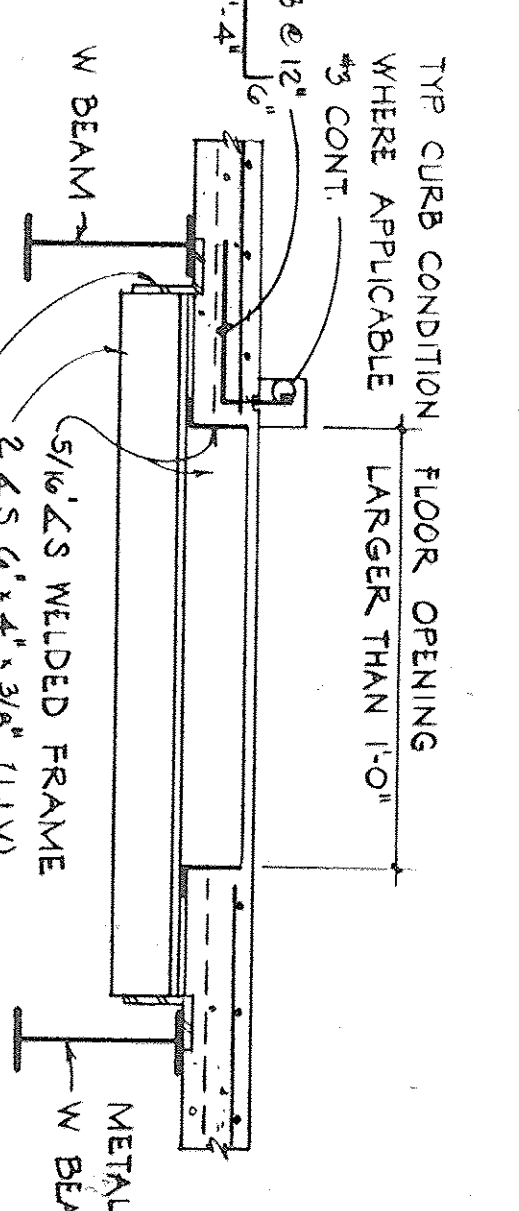


TYPICAL FRAMING FOR OPENING THROUGH METAL DECK

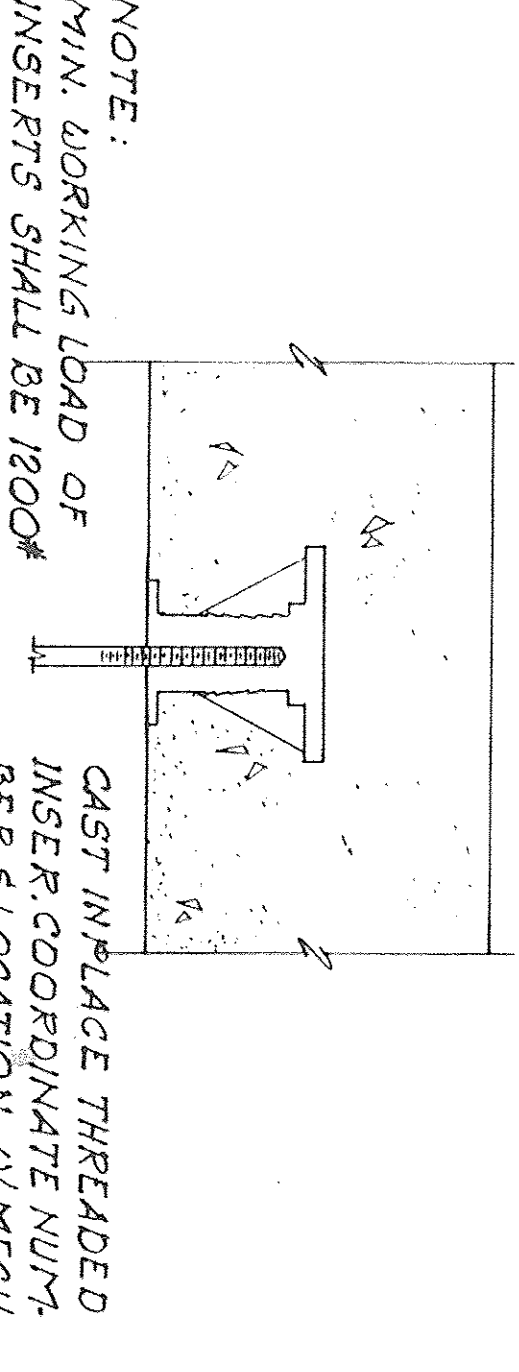


TYPICAL THREADED INSERT DETAIL FOR EQUIPMENT HUNG FROM SLAB

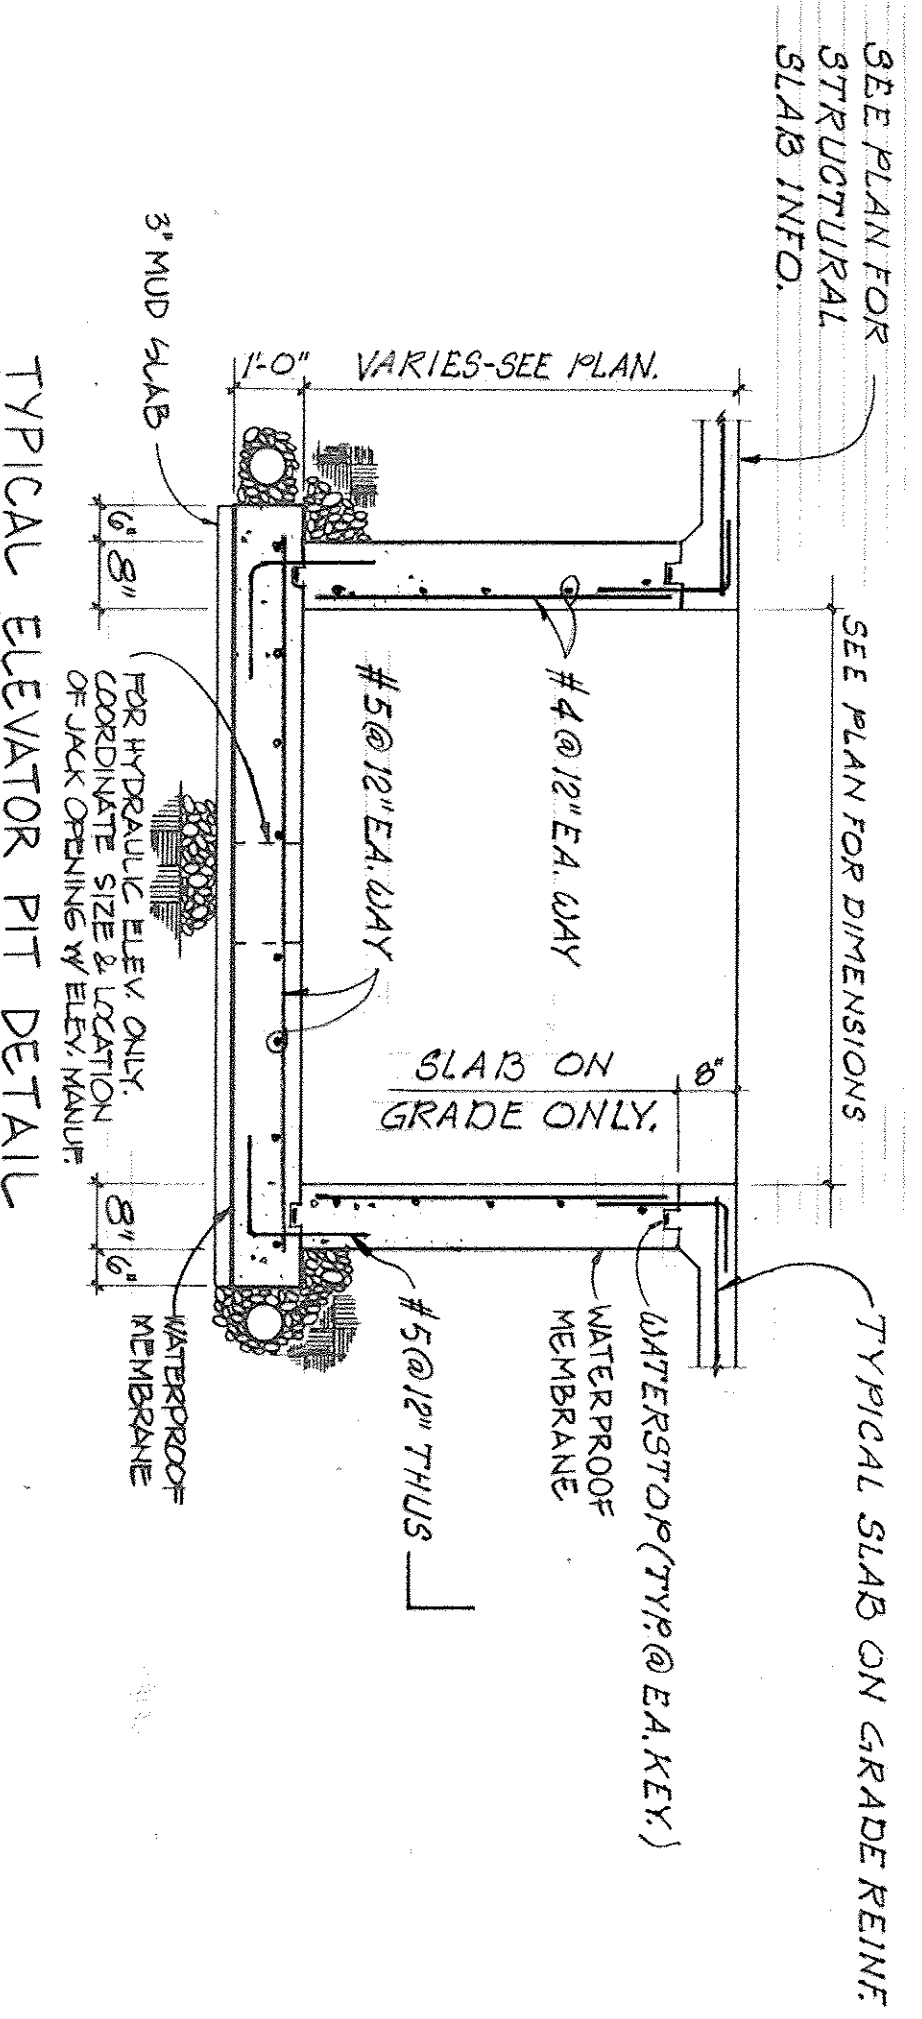


TYPICAL ELEVATOR PIT DETAIL

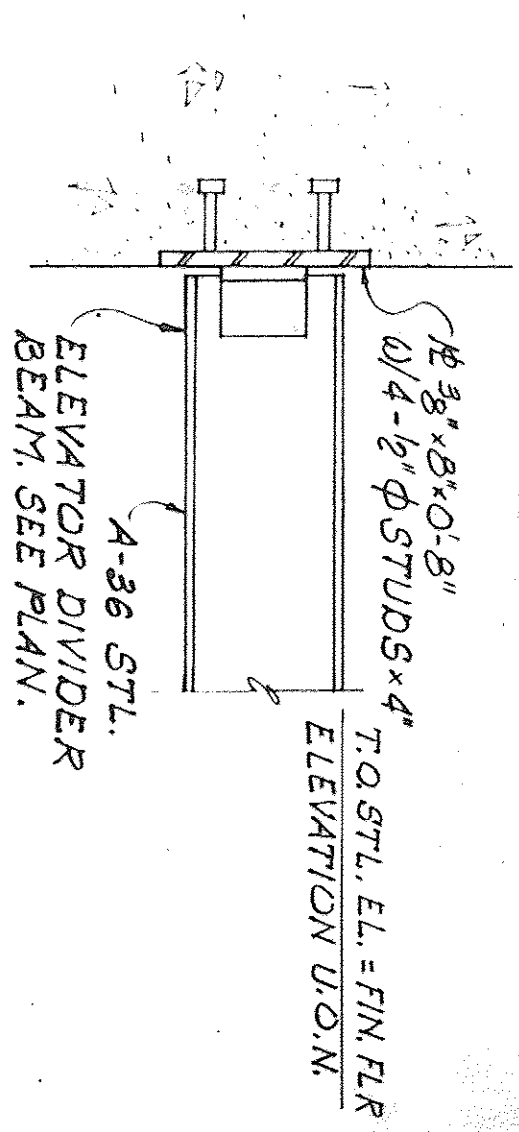


TYP. ELEVATOR DIVIDER BEAM CONNECTION

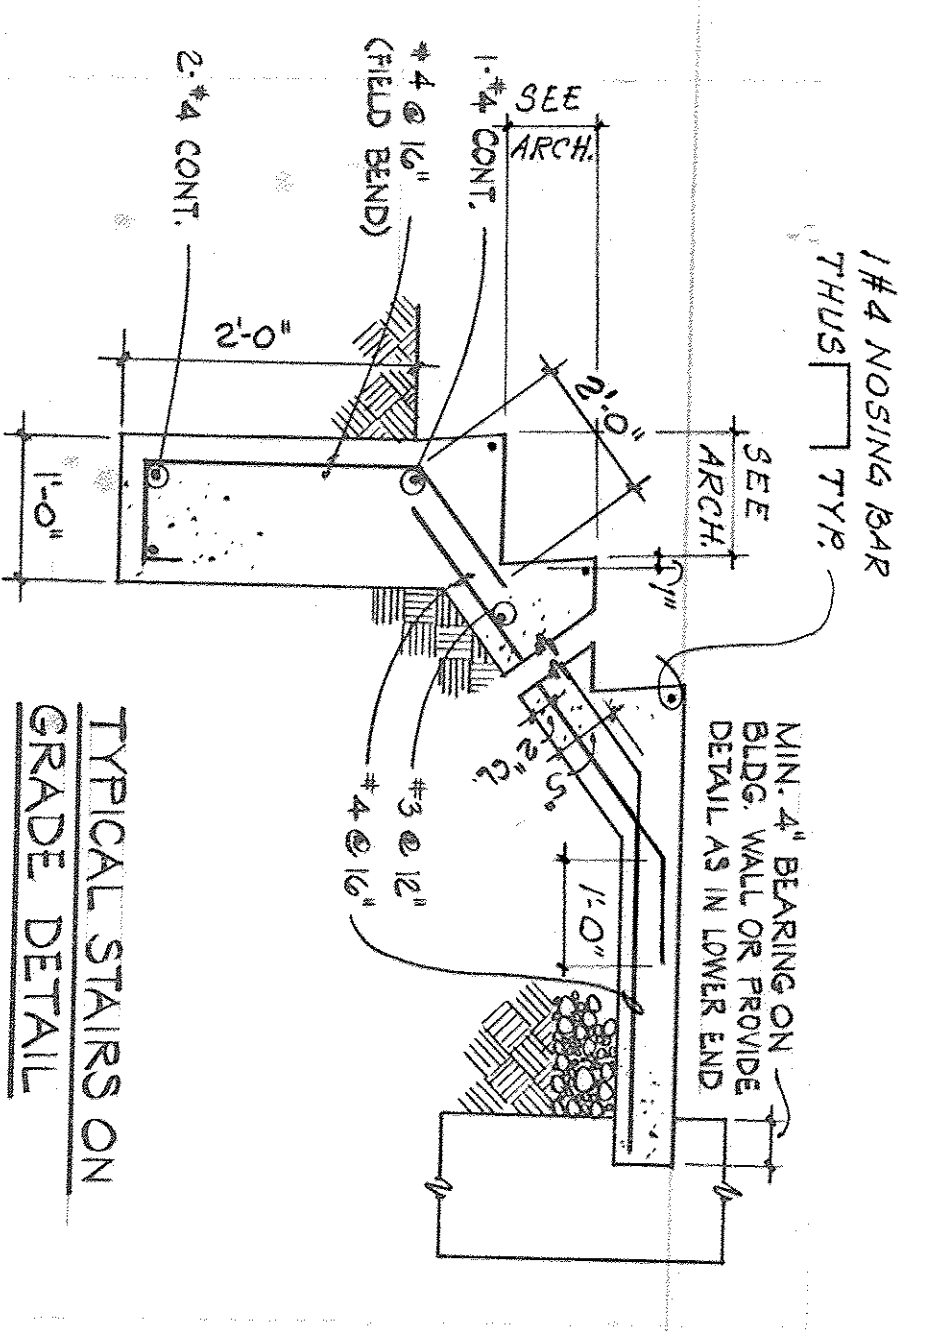

TYPICAL STAIRS ON GRADE DETAIL

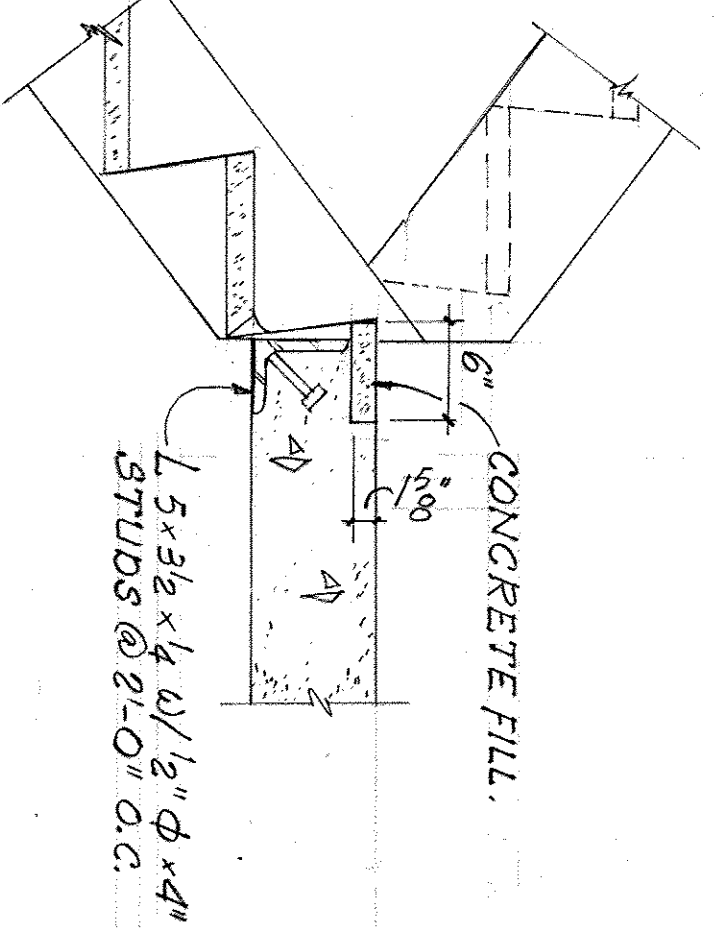

DETAIL AT FLOOR (CONCRETE STRUCTURE)

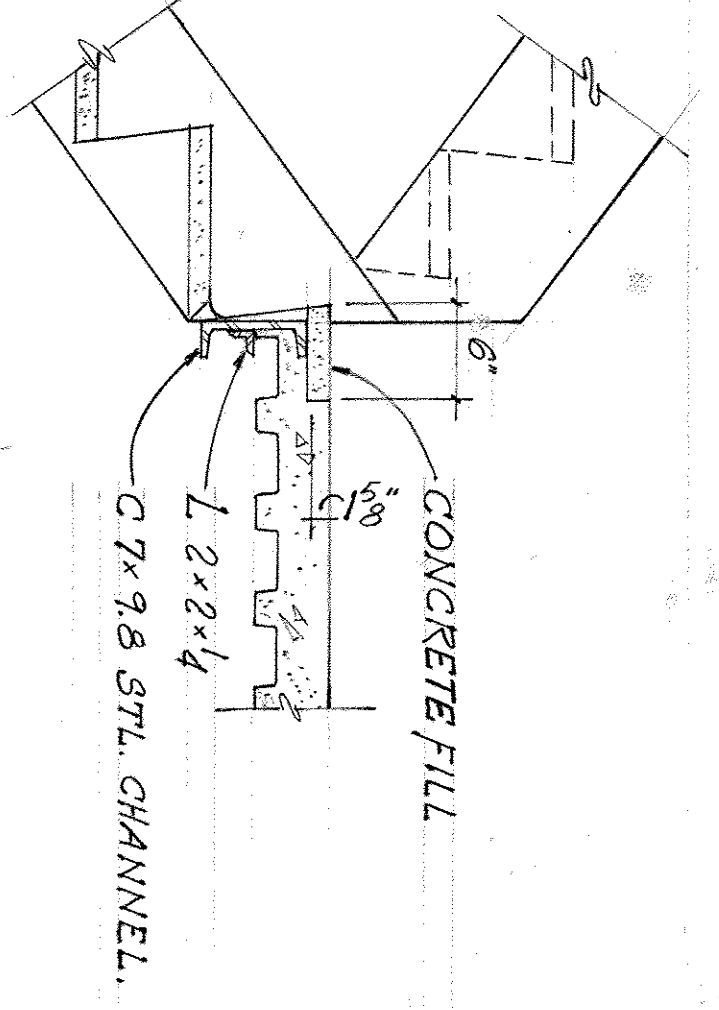

DETAIL AT FLOOR (STEEL STRUCTURE)

RECORD DRAWINGS

DATE

REVISION

COMMONWEALTH OF VIRGINIA

D. CRAIG MYERS

No. 16181

PROFESSIONAL SEAL

WVKR - TAG

ARCHITECTURE - ENGINEERING - PLANNING

Alexandria, Virginia — Charleston, W. Virginia

Drawing Title

TYPICAL DETAILS & NOTES

Project Title

OUTPATIENT / CLINICAL / NURSING UNIT ADDITION AND ALTERATIONS

Building Number

143

Location

VA/MC SALEM, VIRGINIA

Approved Project Director

Approved

Approved

Approved

Date

JAN 22 1988

Project No.

658-050

Drawing No.

14352

Drawn By

HS

Checked By

KWC

Designated By

HS

Veterans Administration