



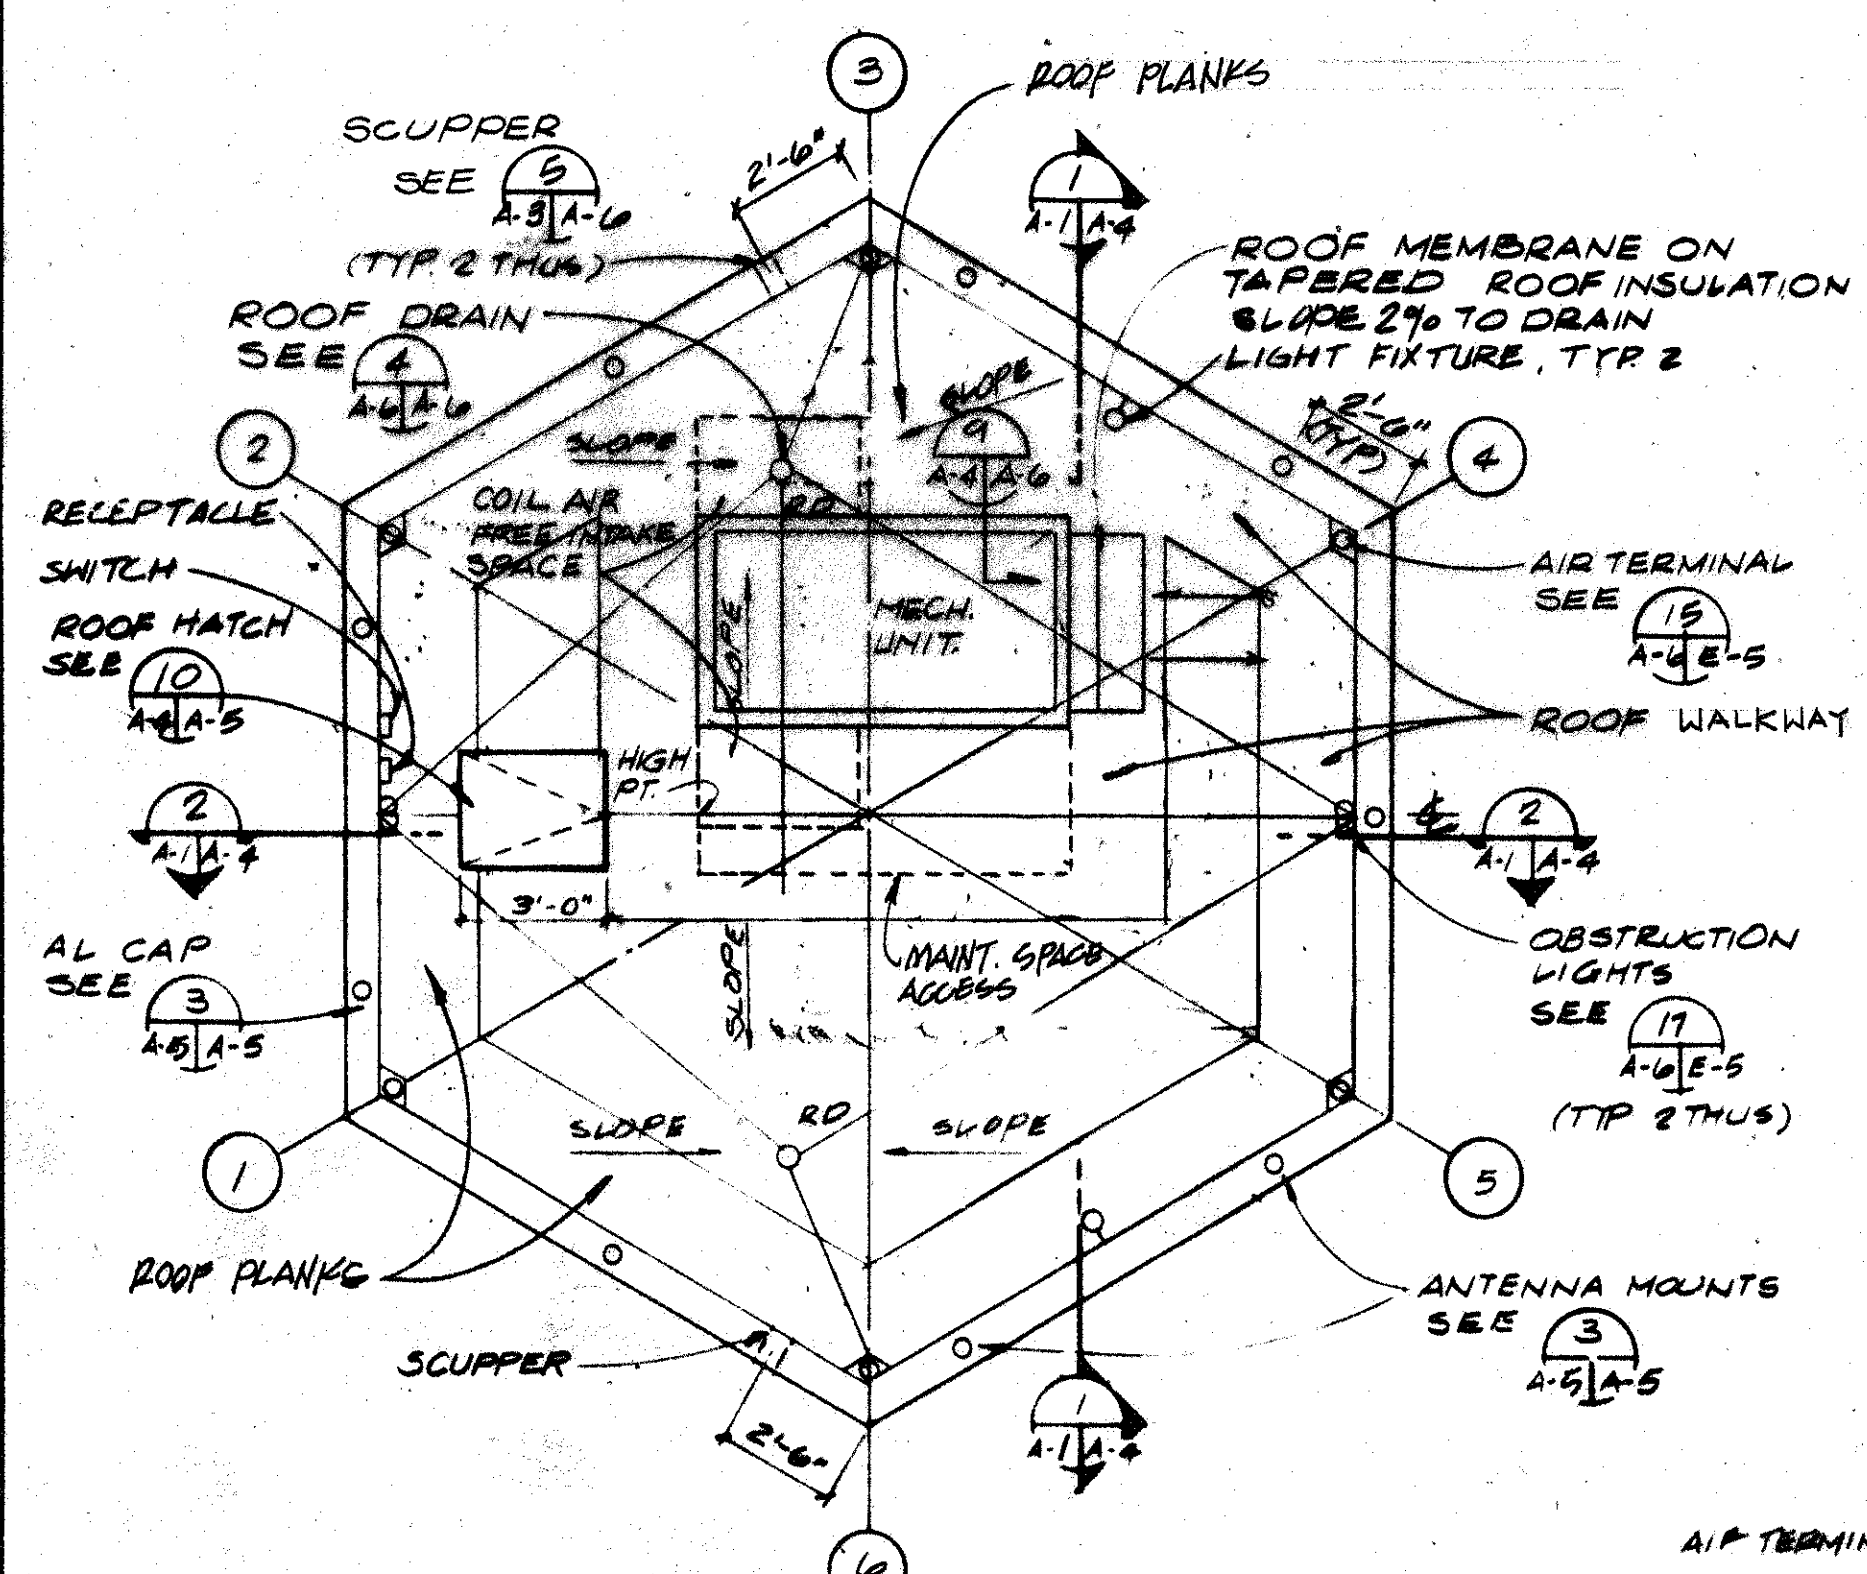


ROOF PLAN
SCALE: 1/4" = 1'-0"


CAB COLUMN RACEWAY USE SCHEDULE		
COL. NO.	USE	REMARKS
1	STORM DRAIN AND CONDENSATE	
2	LIGHTNING PROTECTION	
3	LIGHTING/POWER	TWO 1 1/2" FLEX CONDUITS IN COLUMN
4	FAA	
5	LIGHTNING PROTECTION	
6	FAA	

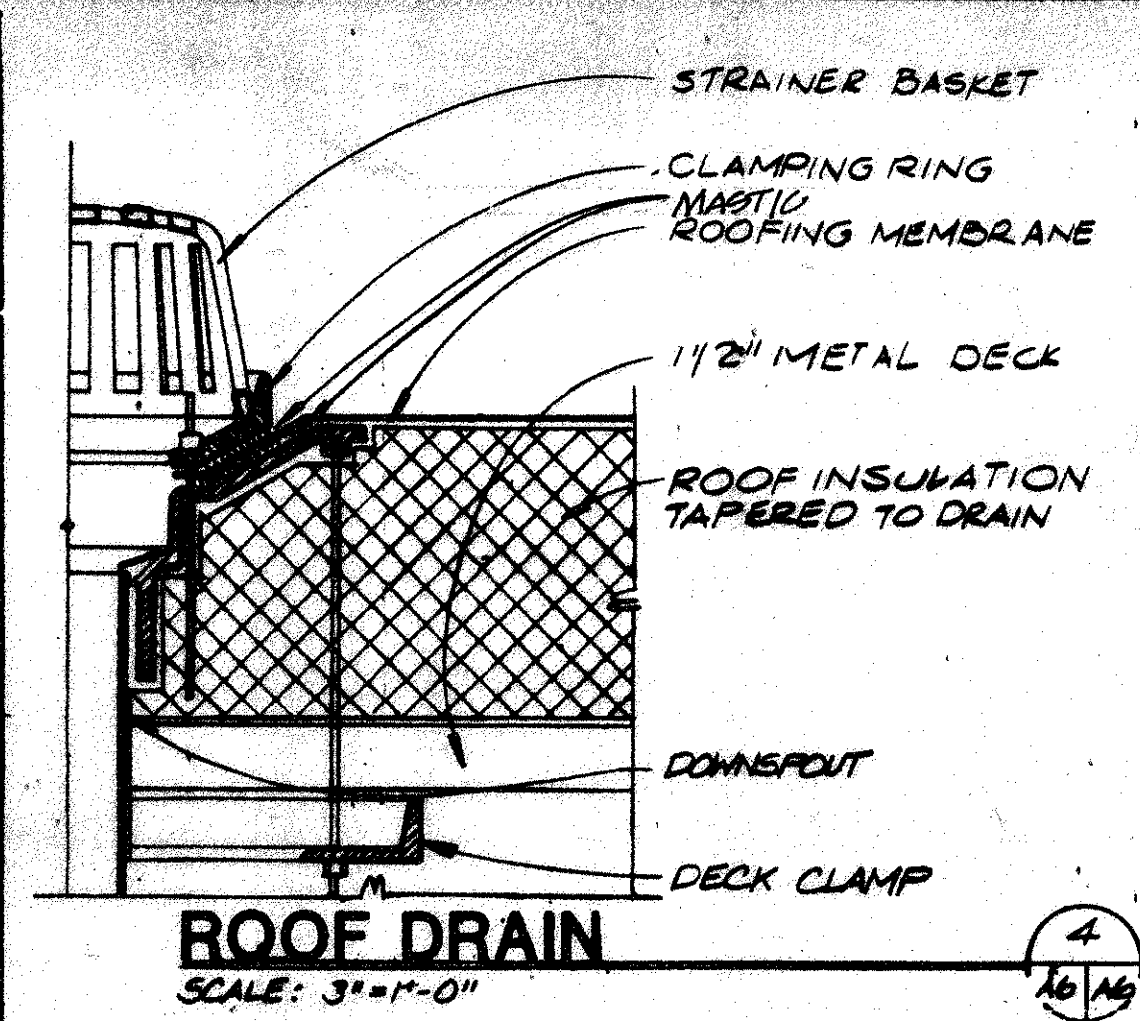


ROOF DRAIN
SCALE: 3" = 1'-0"

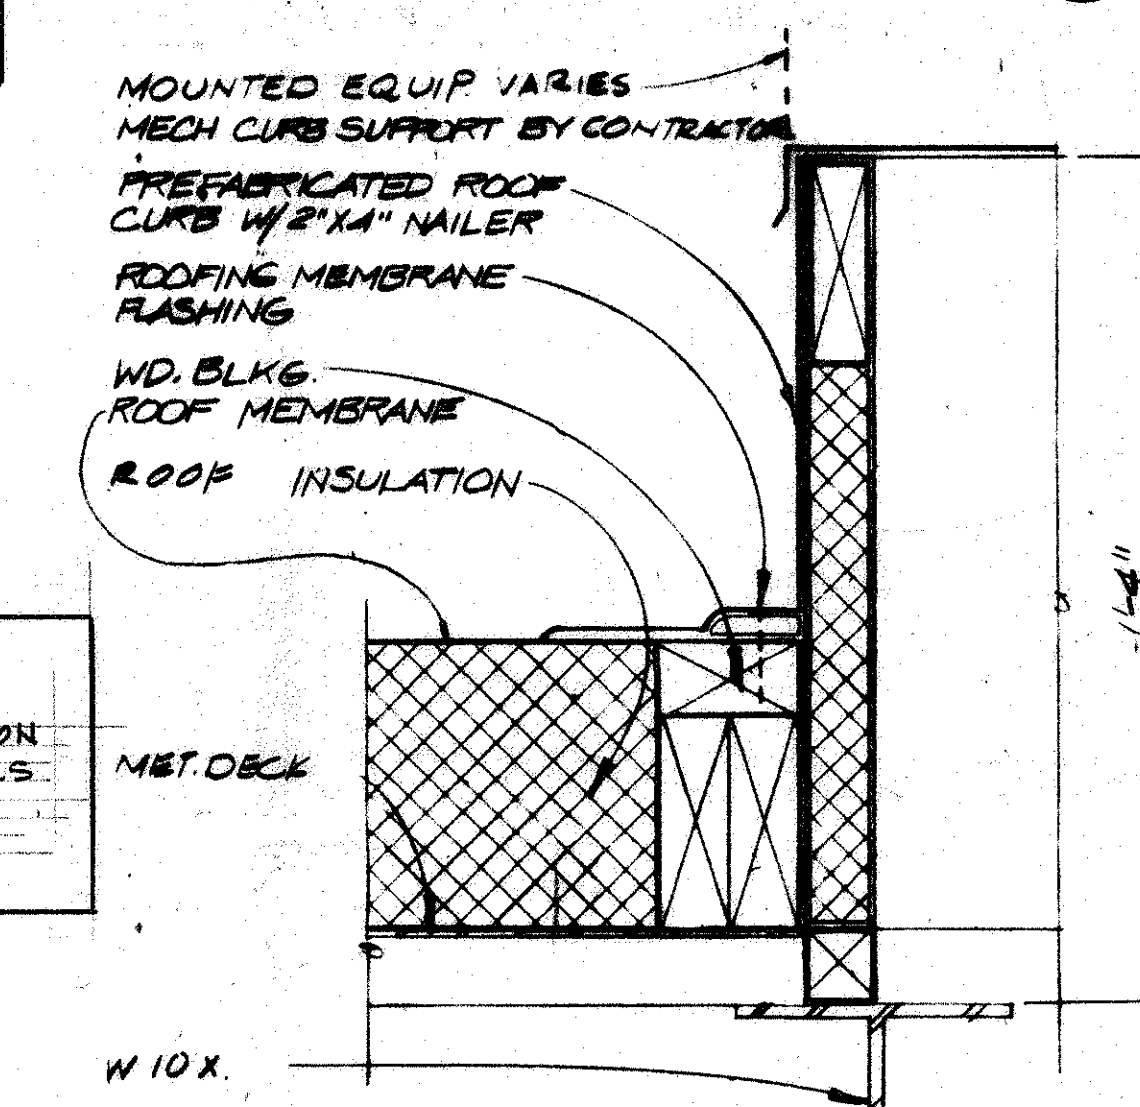


MECH EQUIPMENT CURB
SCALE: 3" = 1'-0"

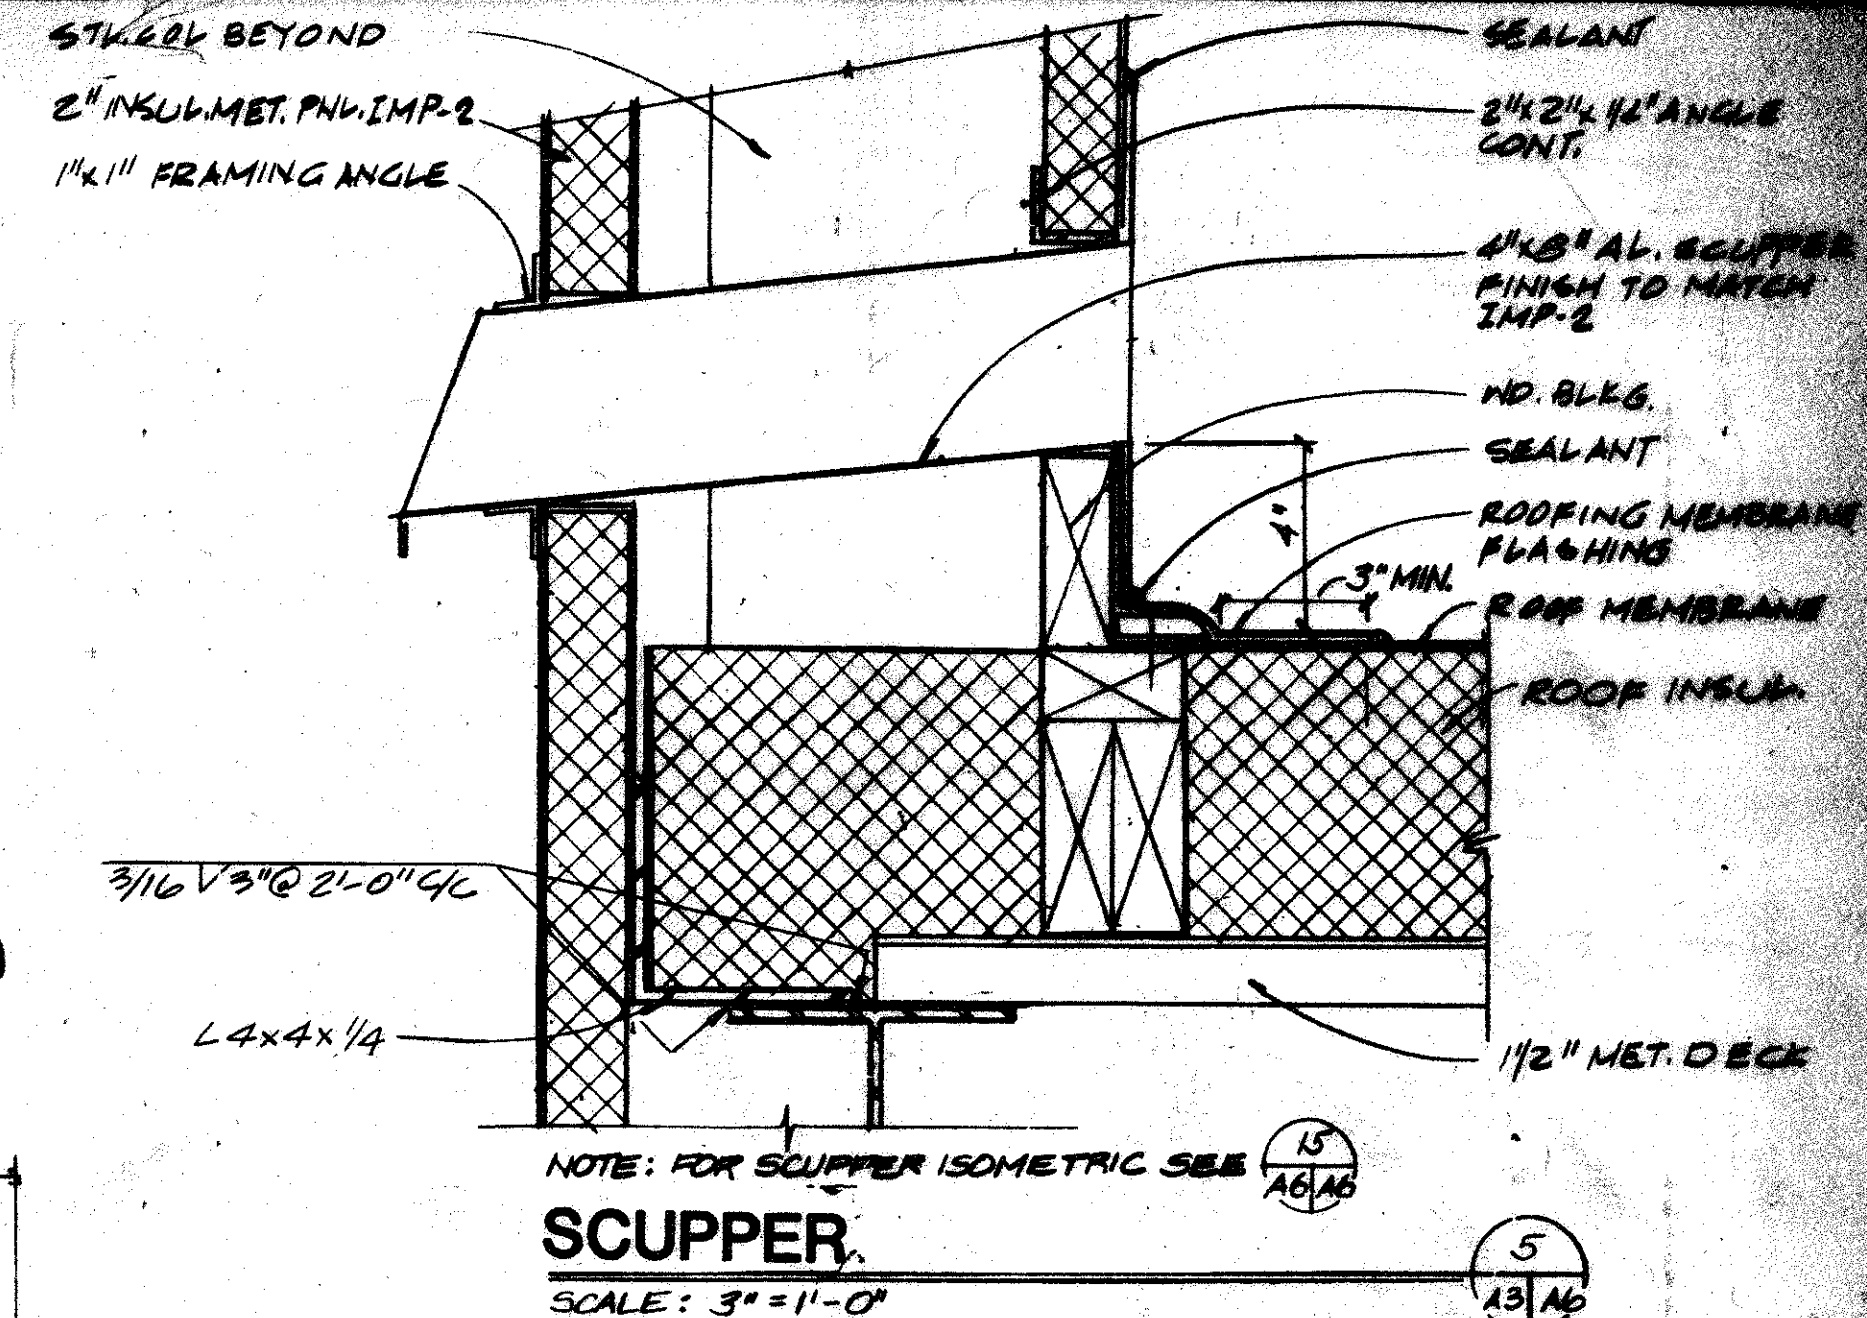


SCUPPER
SCALE: 3" = 1'-0"

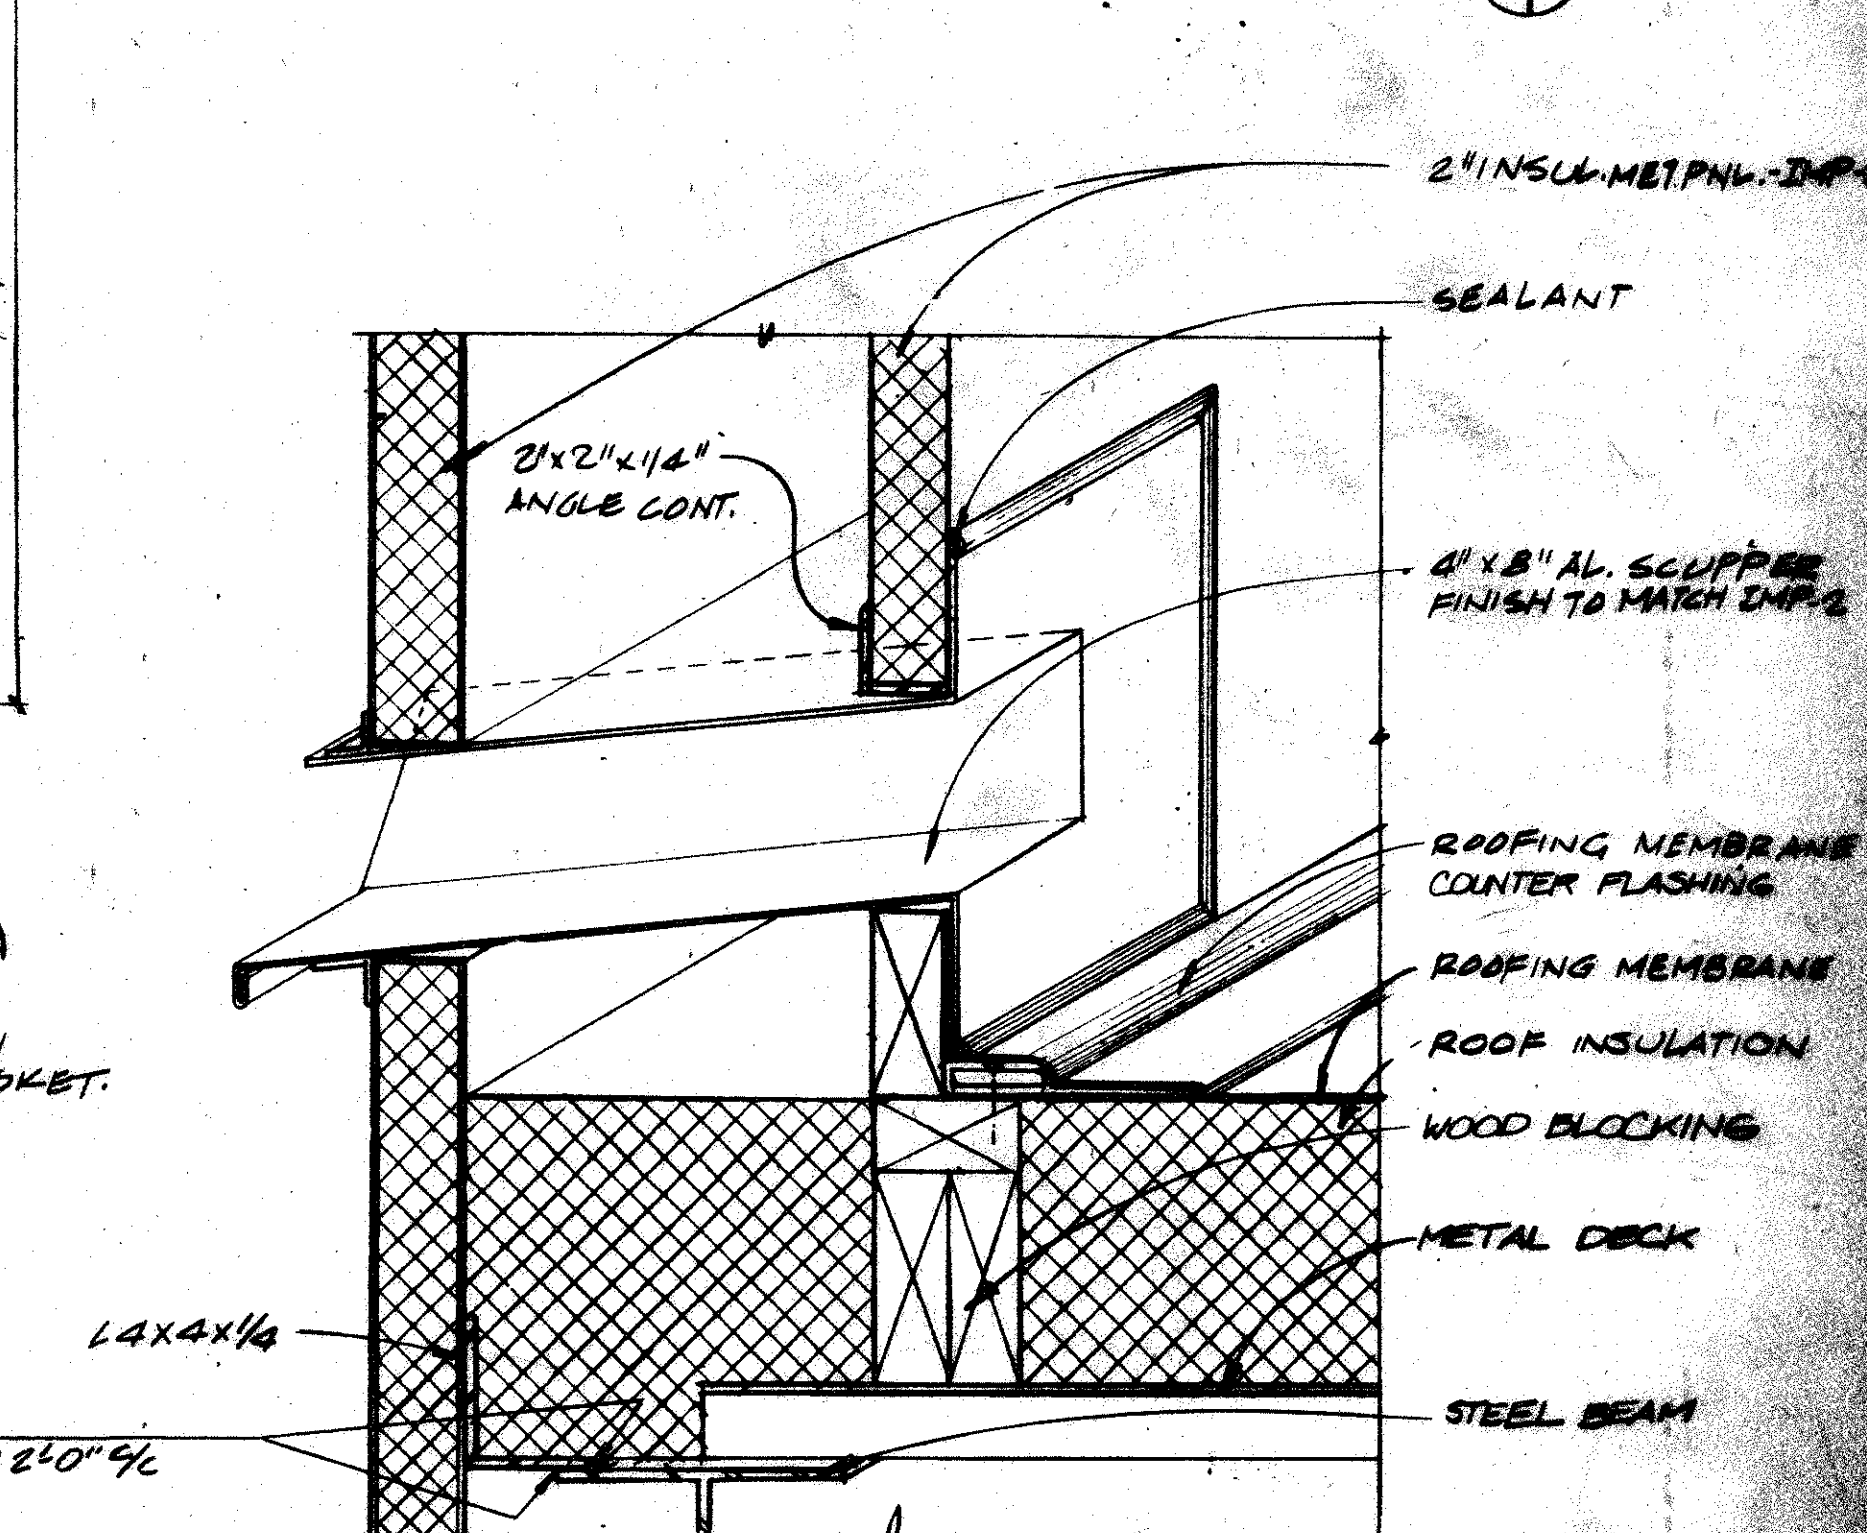


SCUPPER ISOMETRIC
SCALE: 3" = 1'-0"

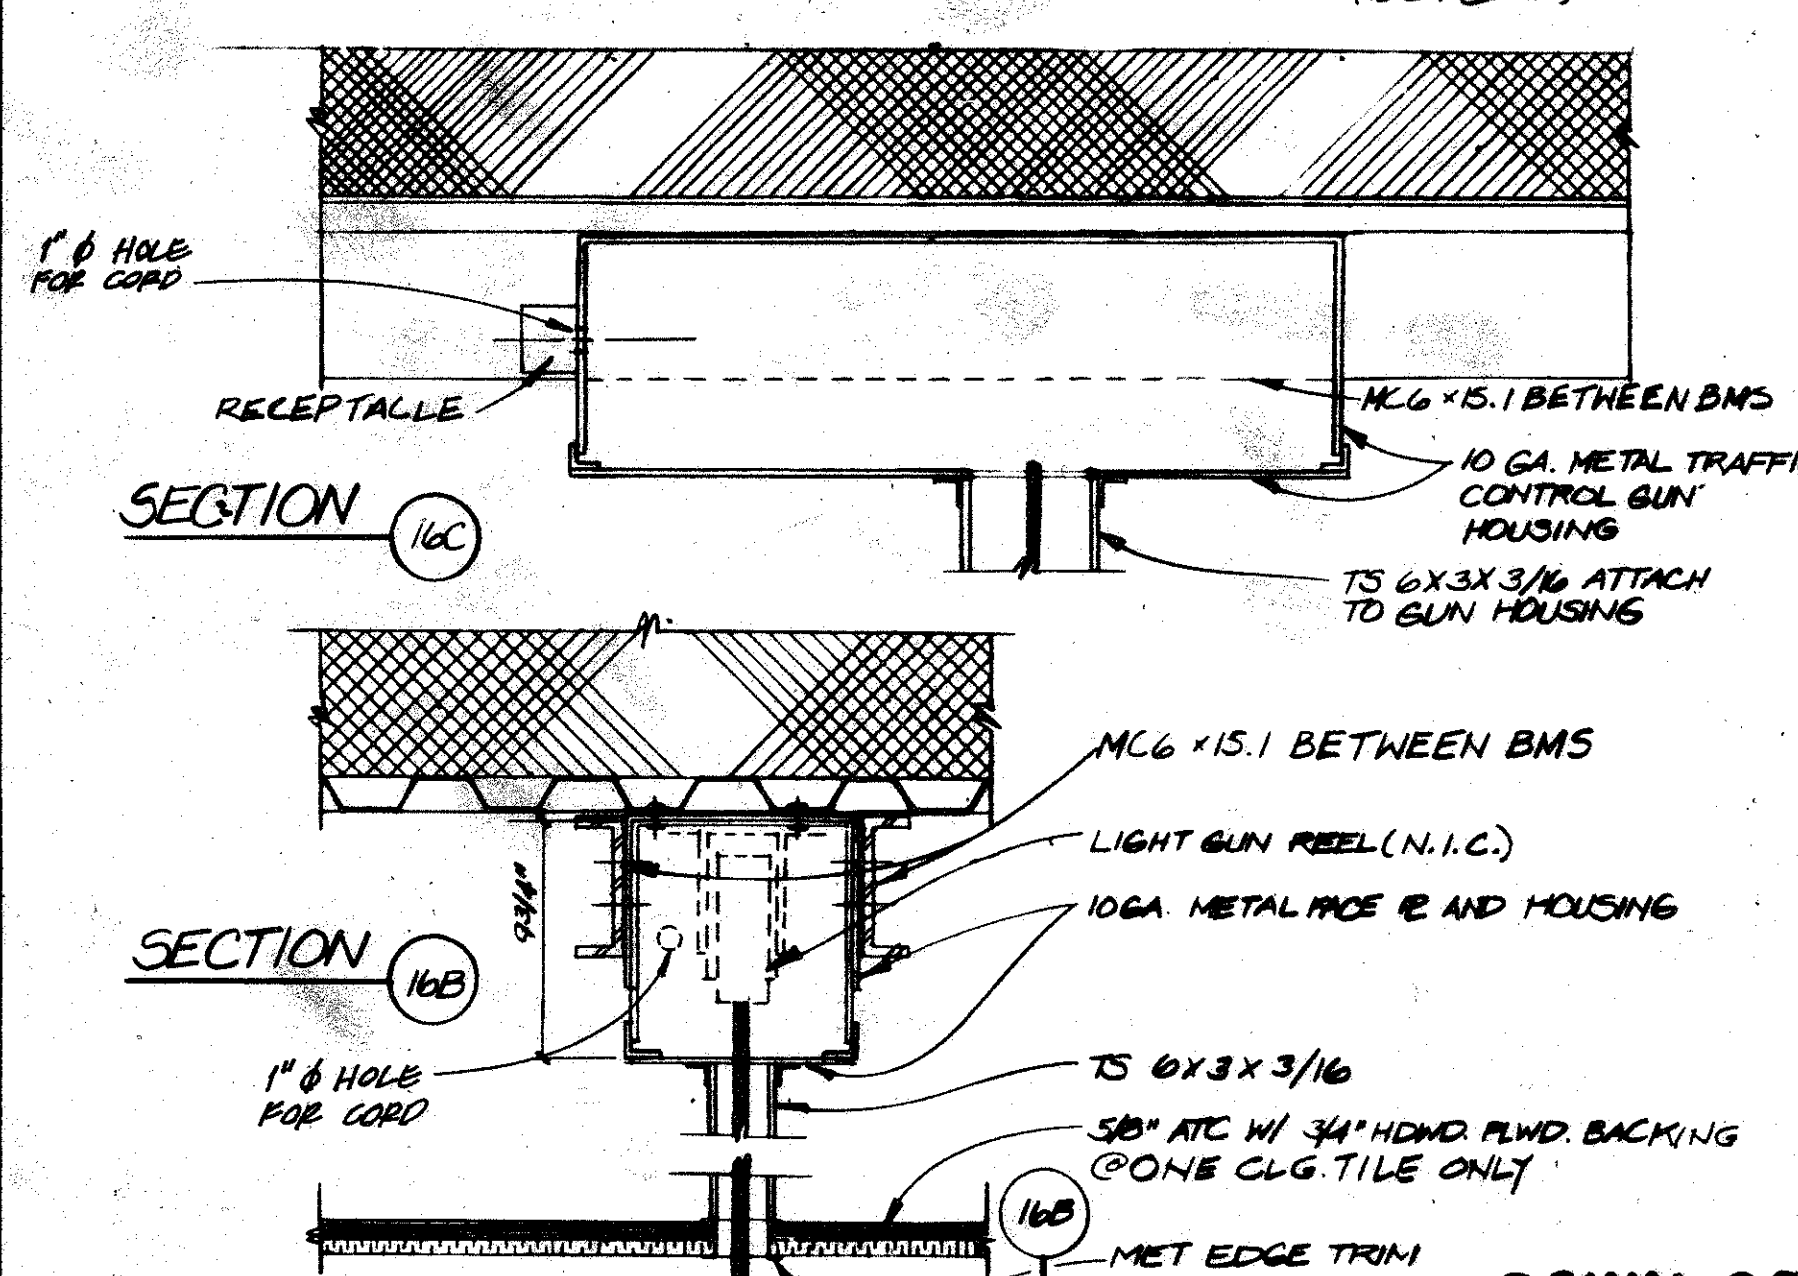


LIGHT GUN HOUSING
SCALE: 1 1/2" = 1'-0"

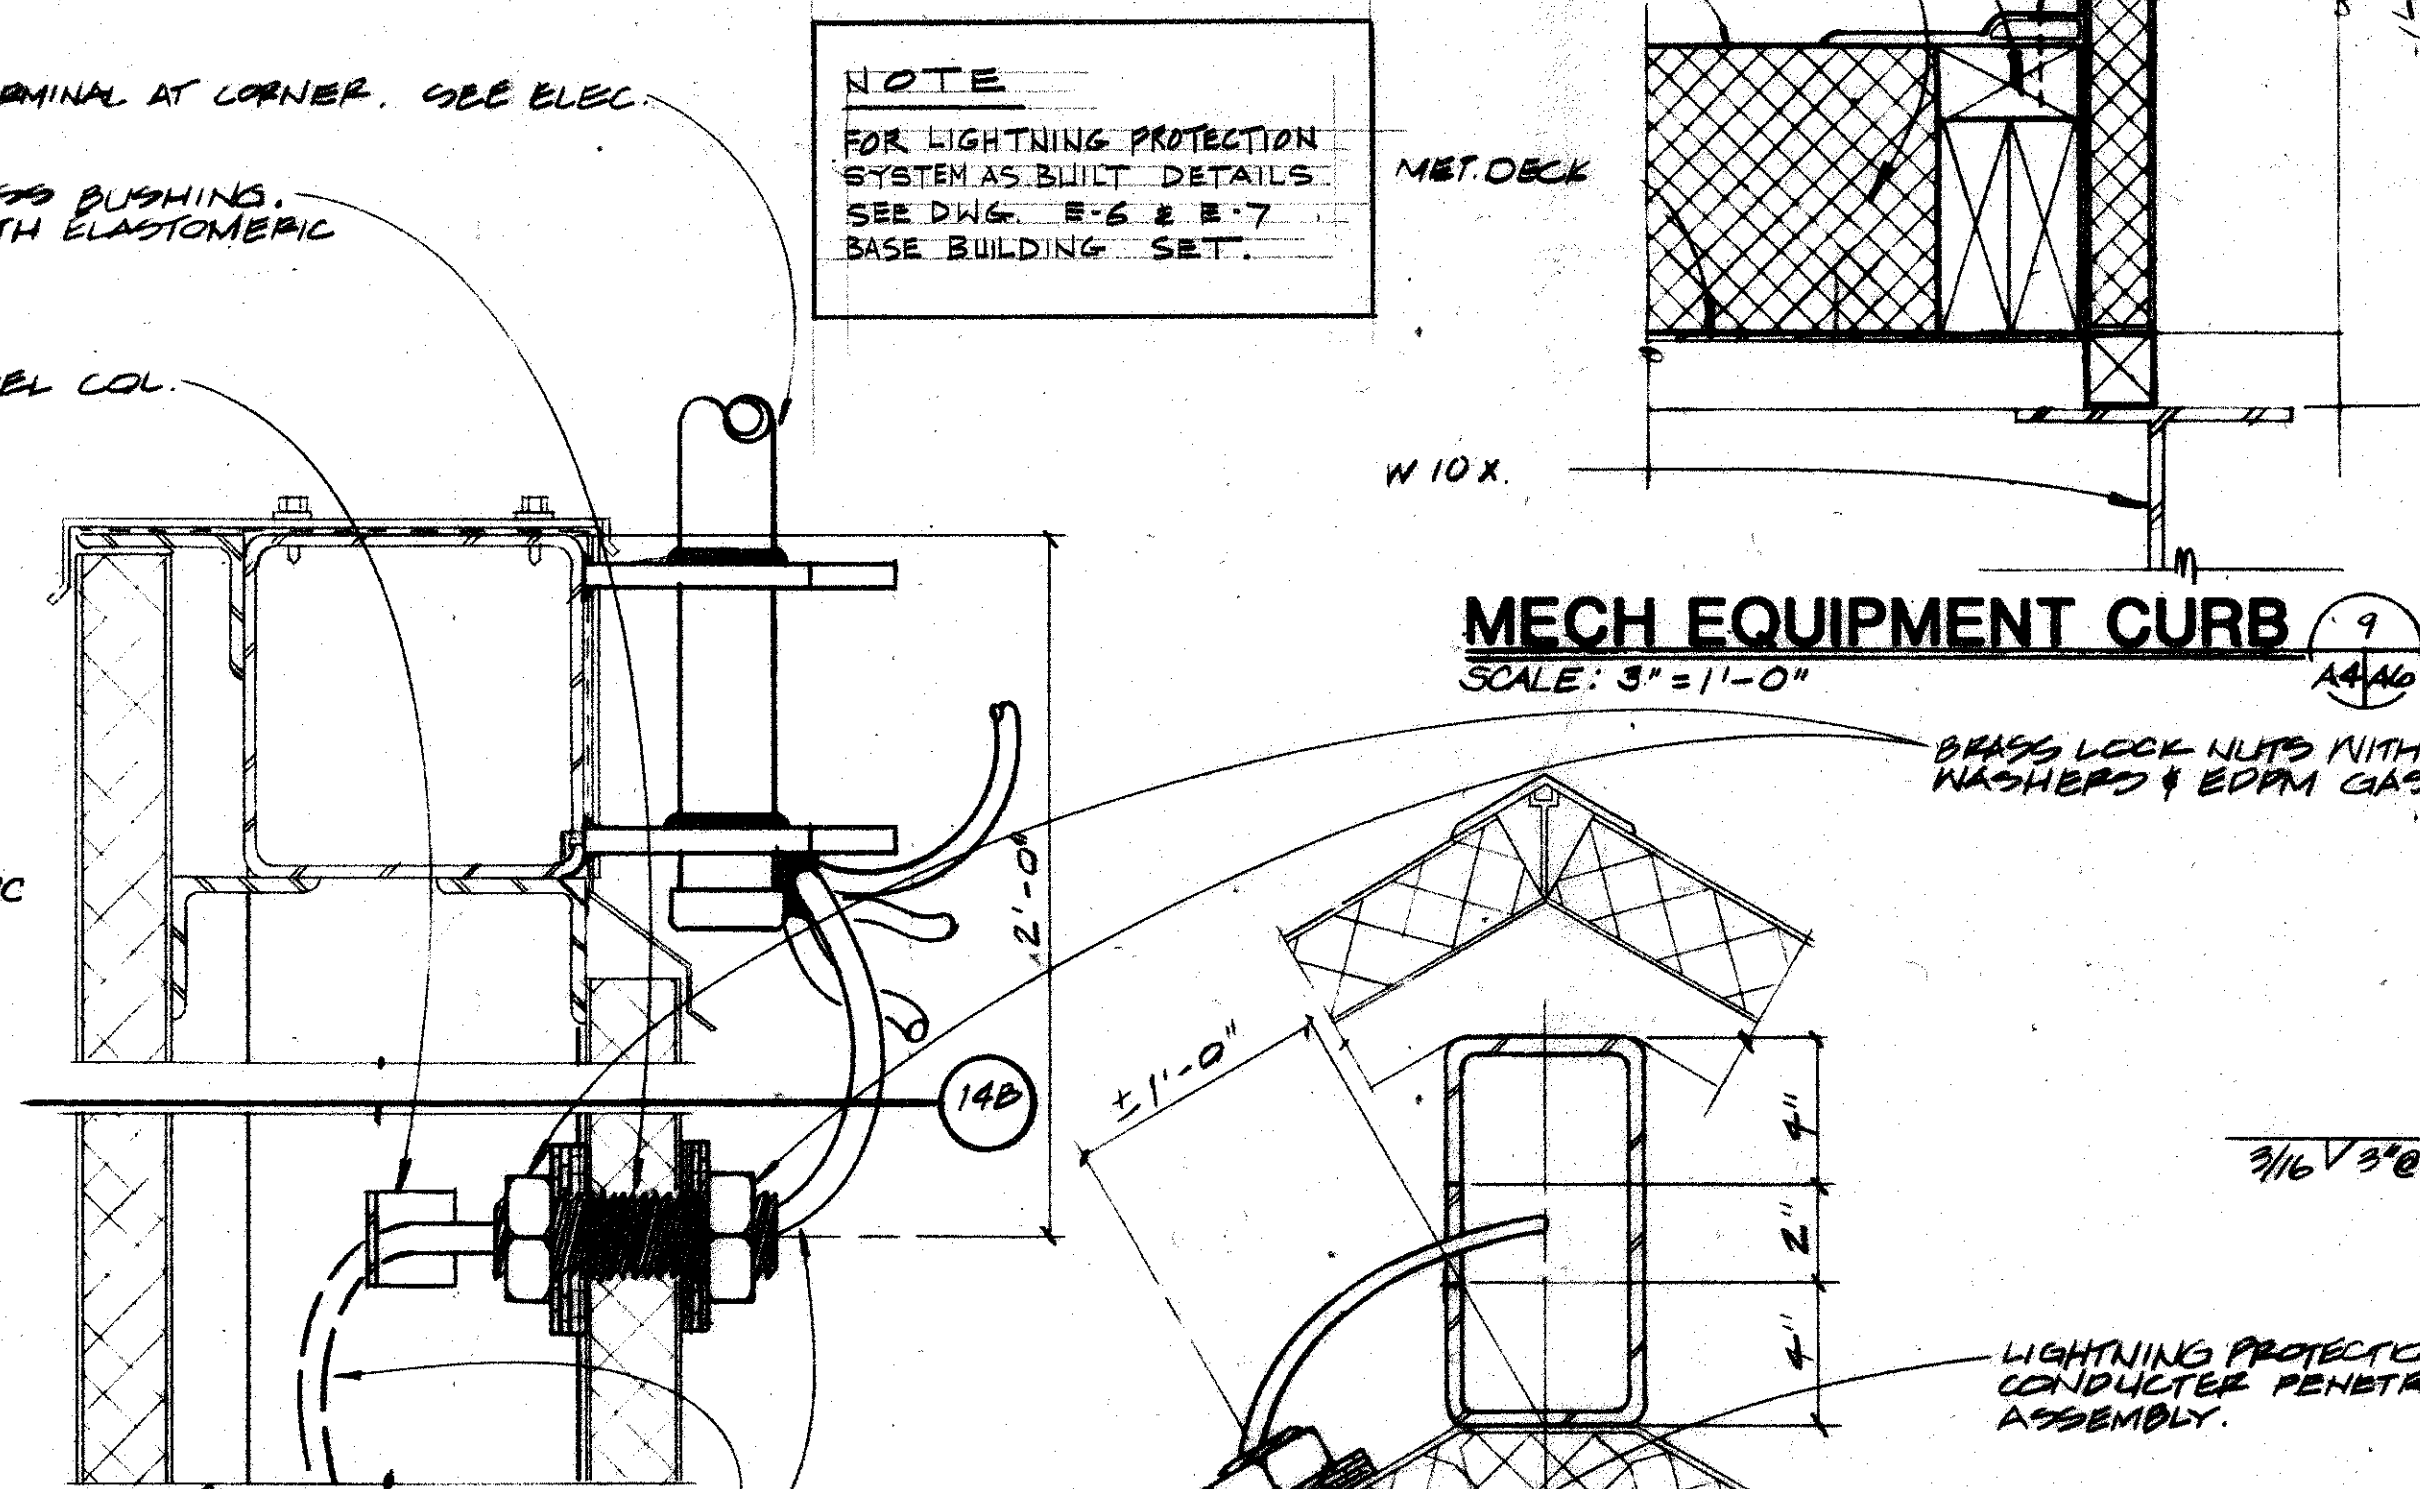

DOWN CONDUCTOR COLUMN ENTRY
NOT TO SCALE

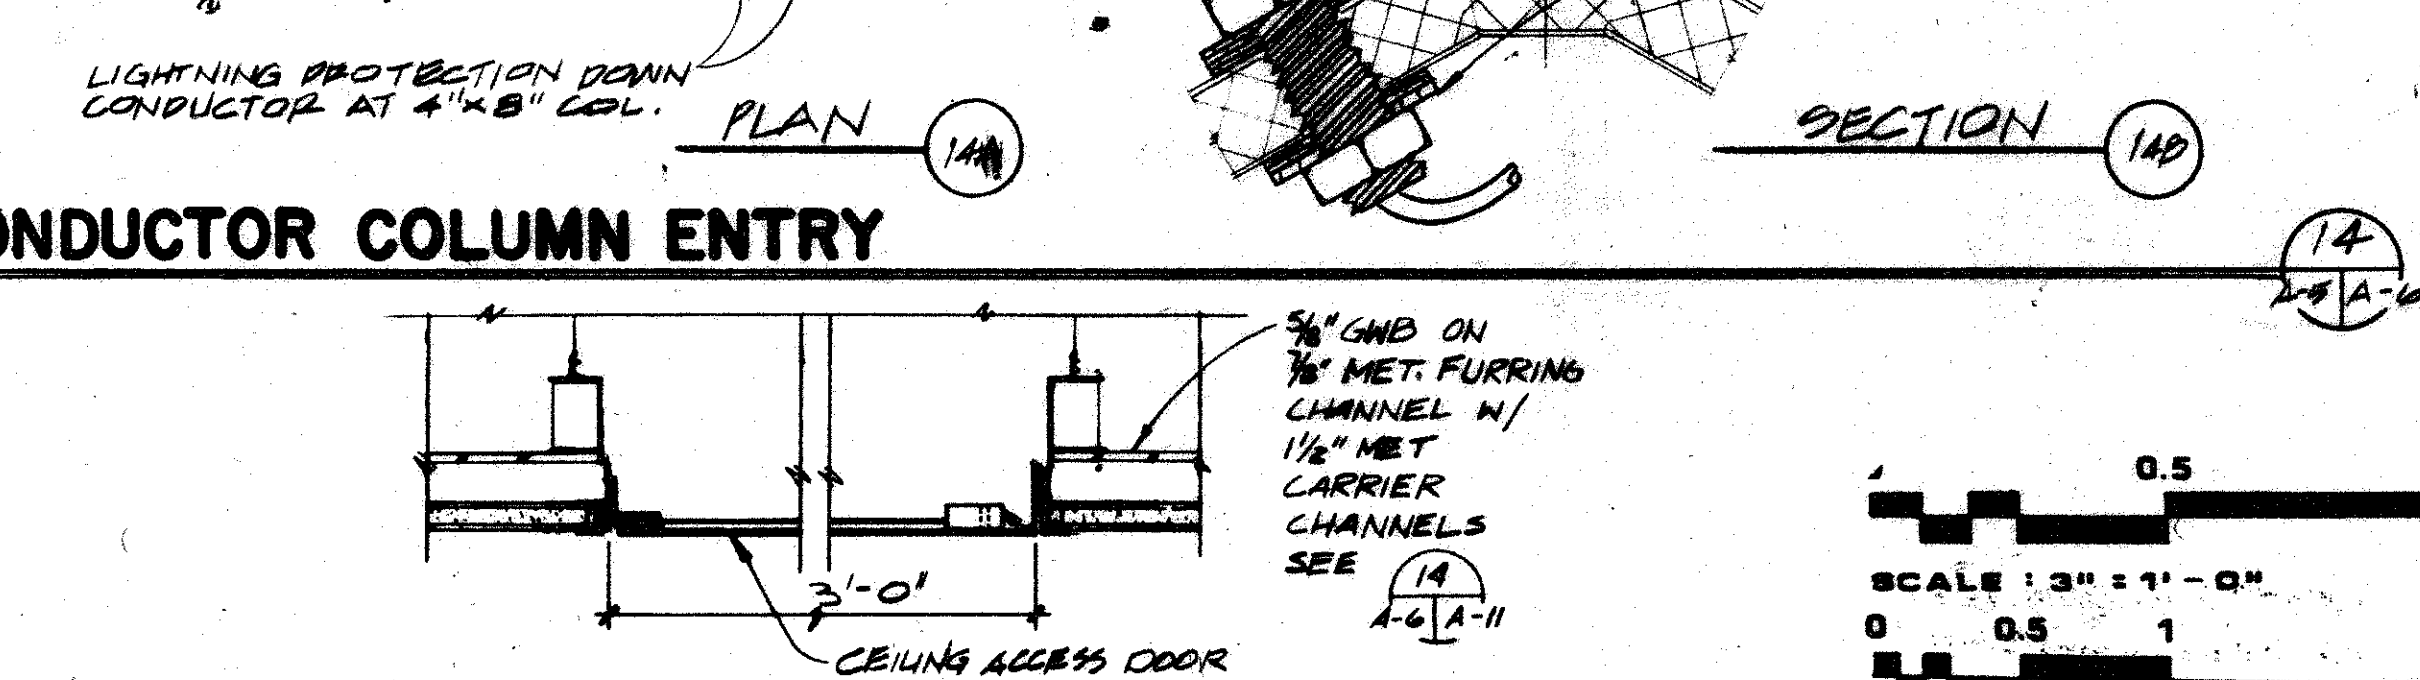

CEILING HATCH
SCALE: 3" = 1'-0"

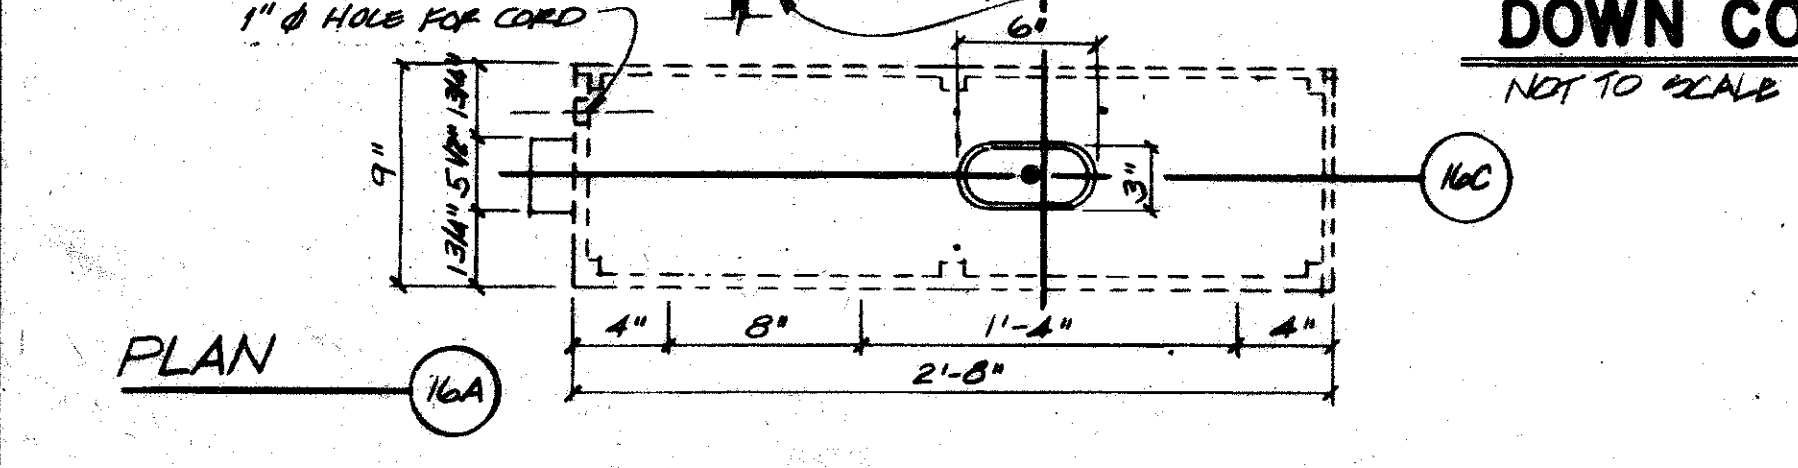

F	A-G
F	A-G

	B 10-16-87 AS BUILT & MAKE SITE DWG.	
	A 4/12/86 SITE ADAPT-D-6055A-A-6	
	REV. LTR. DATE DESCRIPTION	
	DESIGNED BY: MDS DRAWN BY: VL CHECKED BY: PEH	ISSUED BY: PROGRAM ENGINEERING & MAINTENANCE SERVICE

**DEPARTMENT OF TRANSPORTATION
FEDERAL AVIATION ADMINISTRATION**
WASHINGTON, D.C. 20591

**LOW ACTIVITY LEVEL
AIRPORT TRAFFIC CONTROL TOWER**

CAB ROOF PLAN AND DETAILS

SAN LUIS OBISPO, CALIF.

MANAGER, STRUCTURES PROGRAM, APM-520

020884-27

SAN LUIS OBISPO, COUNTY AIRPORT
SAN LUIS OBISPO, CALIF.