

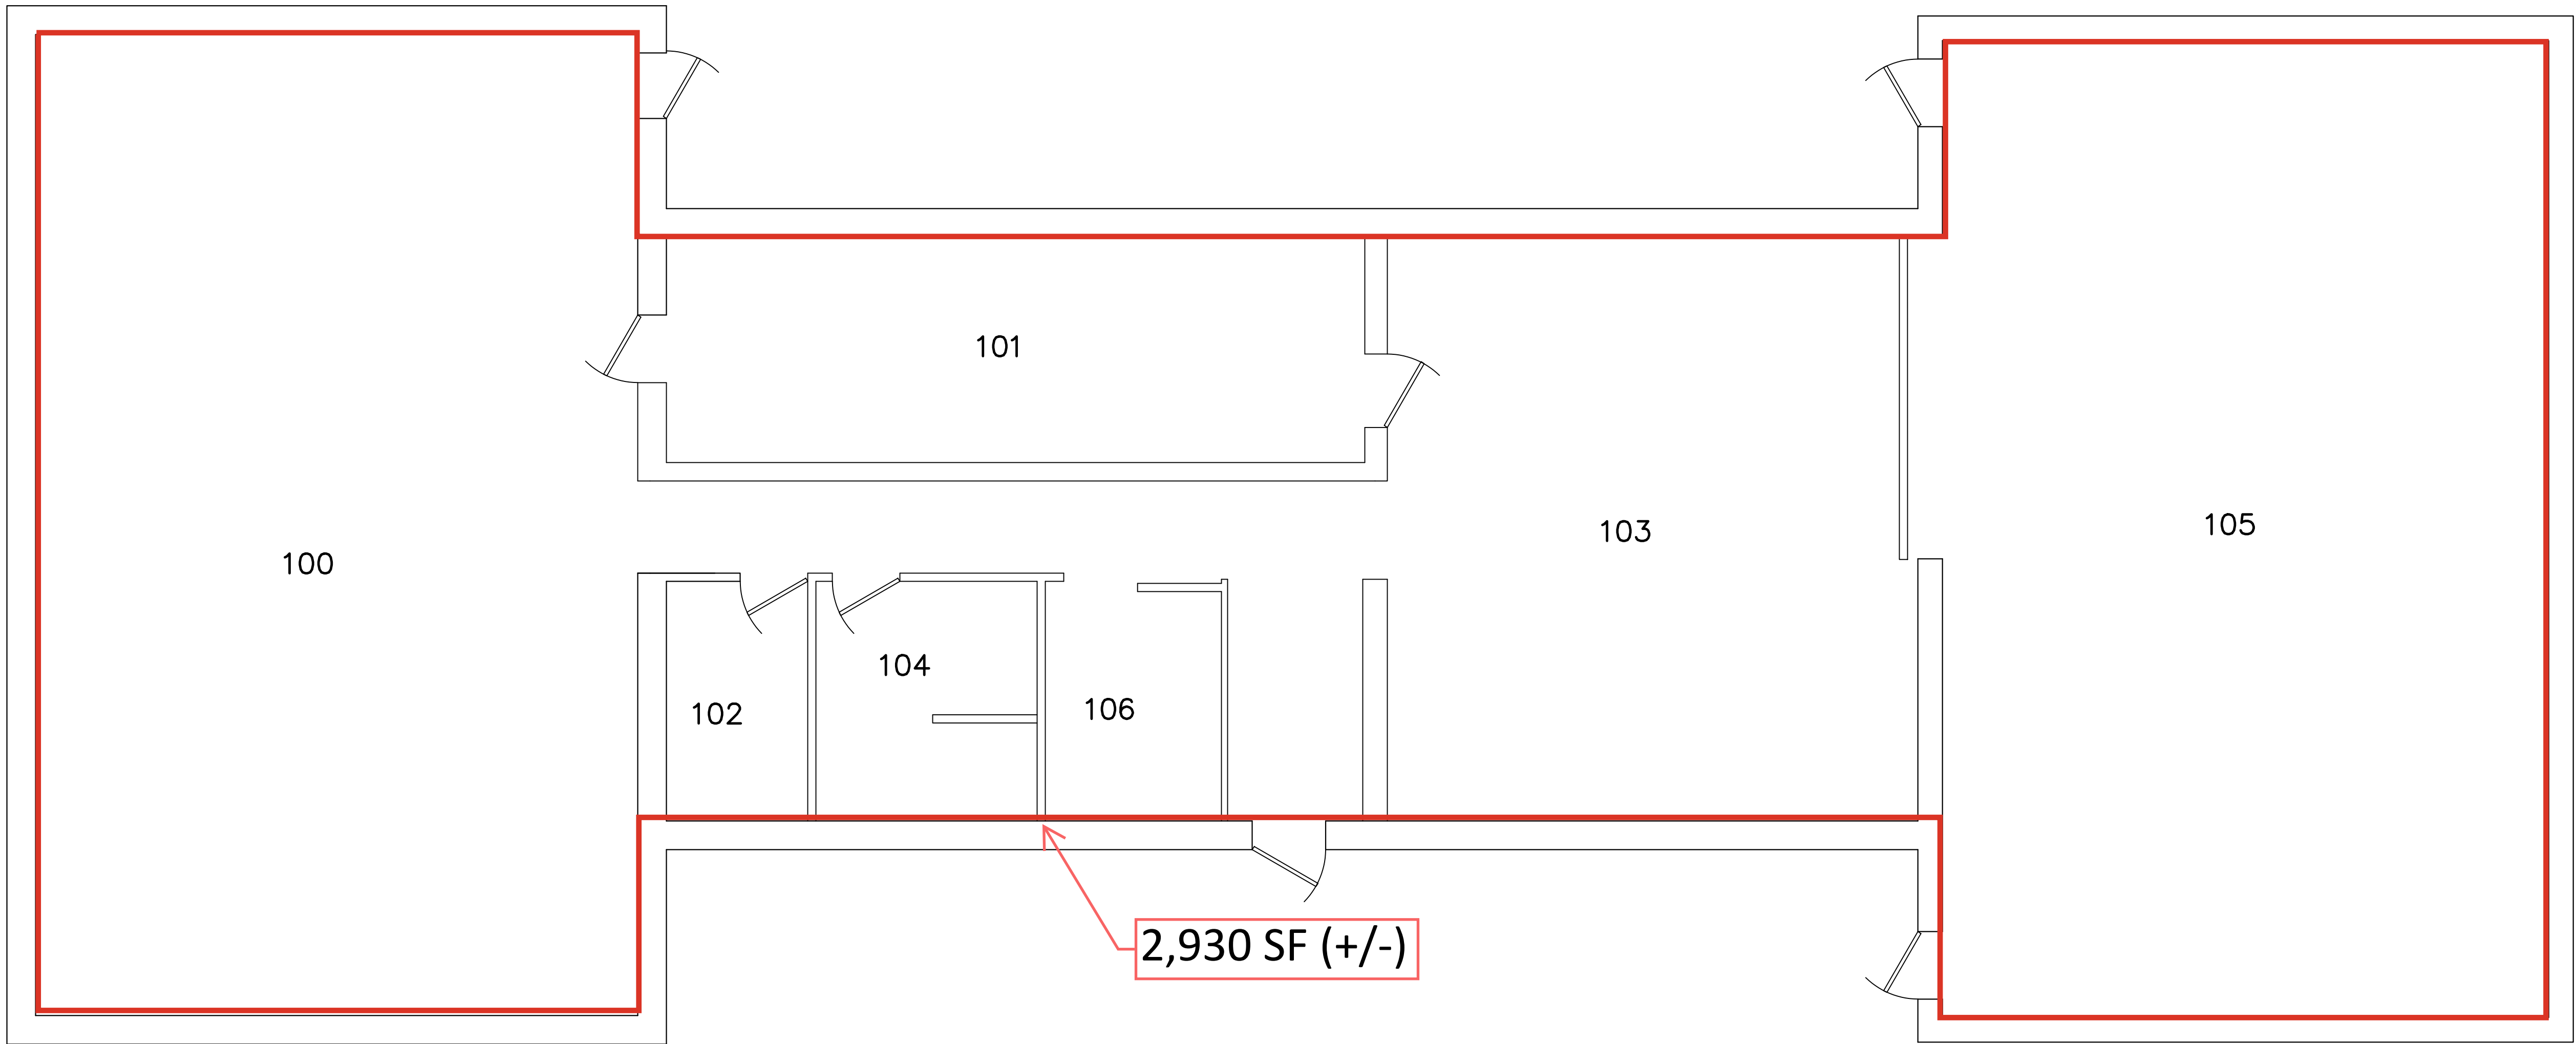


XREFS: \\MASSC\More Users\bugherly Spec\PIRNE STANDARD Files\ACAD\PROJ\2118\WA BUILDING AS-BUILT\DRAWINGS\2118-B41.DWG Scale:1:1 Date:01/22/2008 Time:11:17 Layout:Layout1

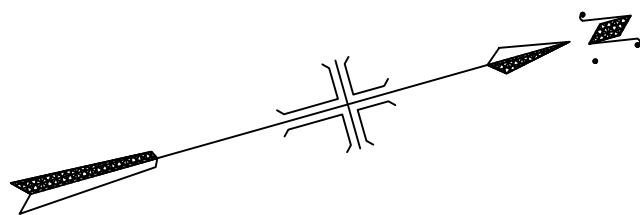

LEGEND:

- DOOR
- WINDOW
- INTERIOR WALL
- EXTERIOR WALL
- STAIRS
- HAND RAIL
- CAGED AREA
- COLUMNS

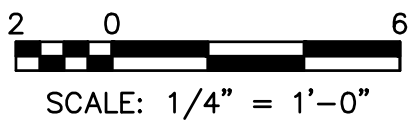

BUILDING 41 – BANQUET ROOM					
WATERVLIET ARSENAL					
WATERVLIET, NEW YORK					
	Name	Date	Rev.	Date	Description
DRAWN	TAL	-			
CHECKED	EAG	6/22/07			
SUBMITTED	-	-	Scale: 1/4"=1'-0"		
			Date: DECEMBER 2007		
CHIEF ENGINEERING DIVISION			Drawing Number	Sheet	
DIRECTOR, ENGINEERING & HOUSING			6021-41-1	1 OF 1	