
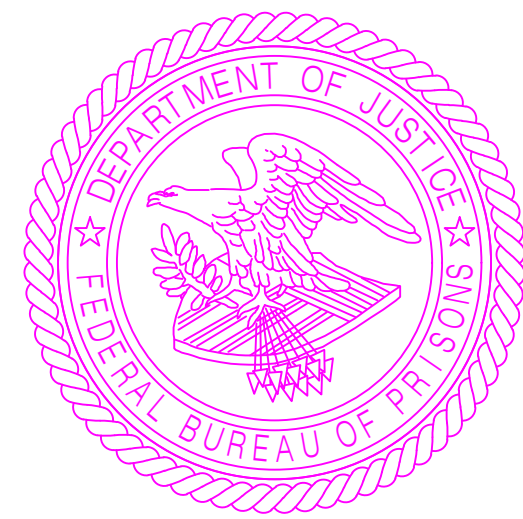


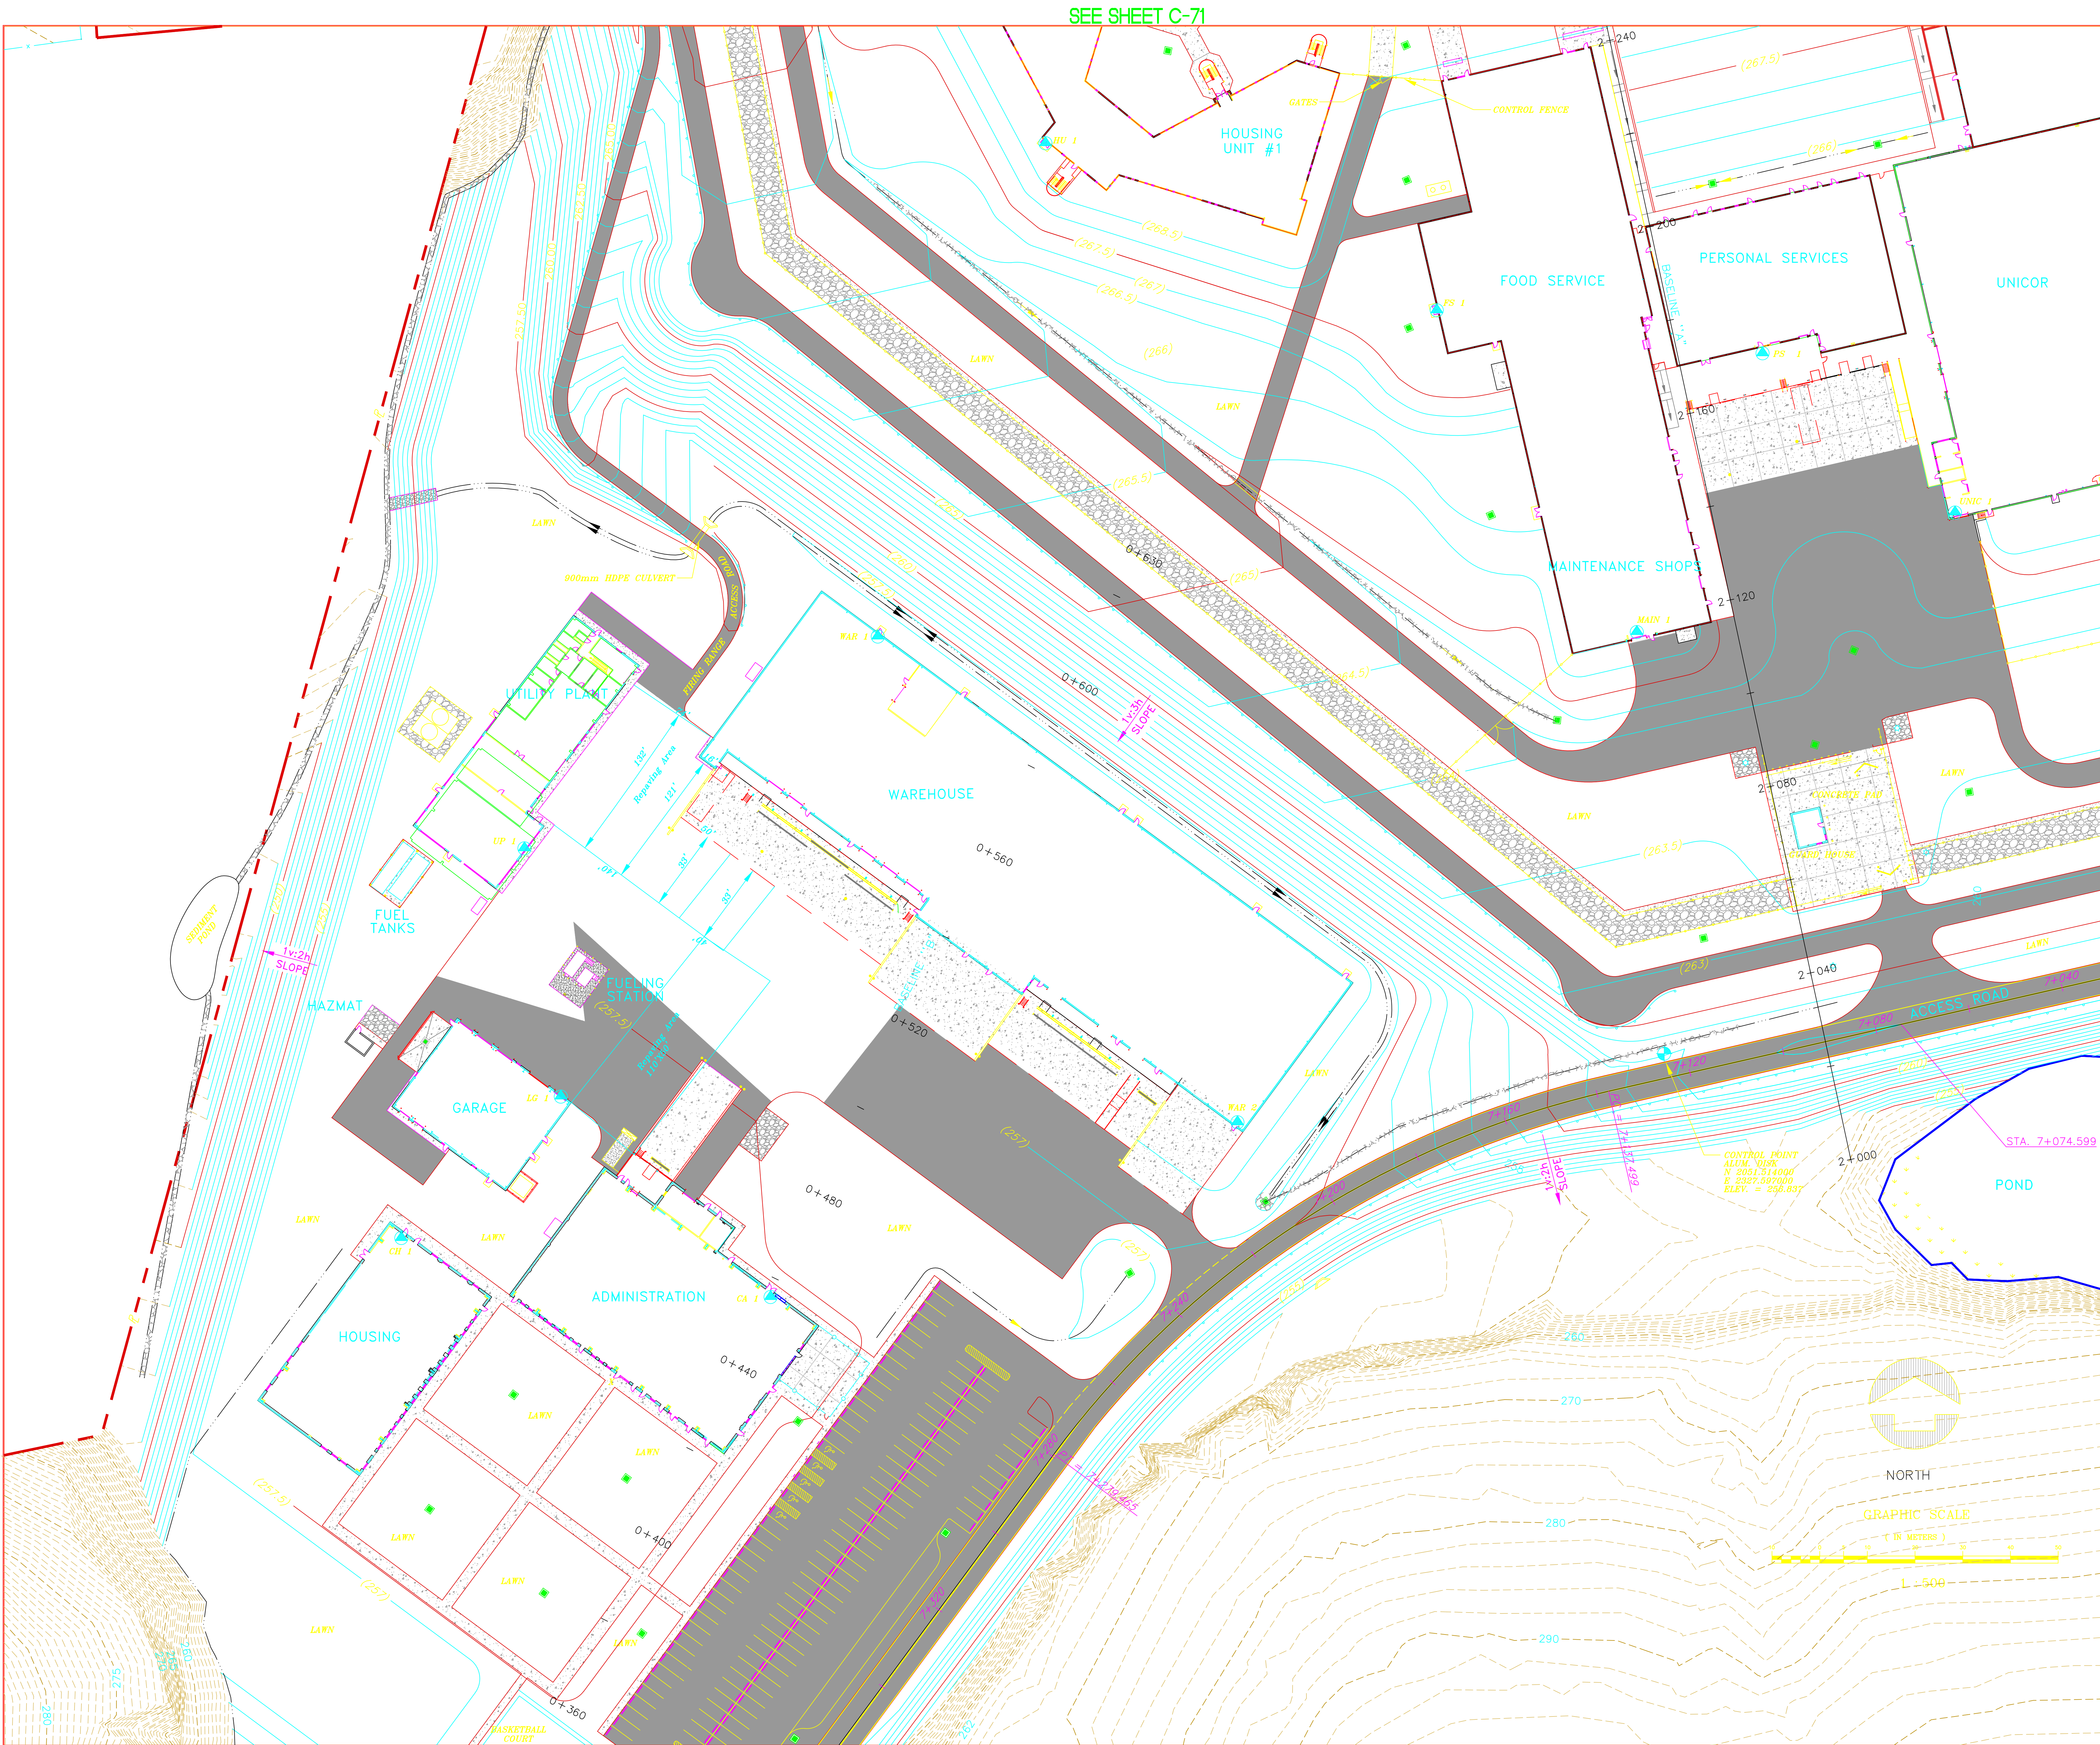

Federal Correctional Institution
Glenville, West Virginia
CONTRACT NO. JX00C-358
FEDERAL BUREAU OF PRISONS

DESIGN/BUILDER
BELL JUSTICE FACILITIES
1340 Lexington Ave.
Rochester, NY 14606
TEL: (716)-277-1000 / (716)-254-7501 FAX

ARCHITECTS
OMNI/KMD Justice
OMNI Associates
1543 Fairmont Ave. Suite 201
Fairmont, WV 26554
TEL: (304)-367-1417 / (304)-367-1418 FAX

KMD Justice
119 Fifth Avenue
New York, NY 10003
TEL: (212)-253-2272 / (212)-253-2282 FAX

CIVIL ENGINEERS
Thrasher Engineering, Inc.
30 Columbia Boulevard
Clarksburg, WV 26301
TEL: (304)-624-4108 / (304)-624-7831 FAX


STRUCTURAL ENGINEERS
LeMessurier Consultants
675 Massachusetts Ave.
Cambridge, MA 02139
TEL: (617)-868-1200 / (617)-661-7520 FAX

MEP ENGINEERS
GRW Engineers, Inc.
801 Corporate Drive
Lexington, KY 40503
TEL: (606)-223-3999 / (606)-223-8917 FAX

SECURITY PLANNING
Buford Goff & Associates
1331 Elmwood Ave.
Columbia, SC 29201
TEL: (803)-254-6302 / (803)-771-6142 FAX


FOOD SERVICES/LAUNDRY PLANNING
Romano Gatlund
99 W. Hoffman Ave.
Lindenhurst, NY 11757
TEL: (631)-226-7700 / (631)-226-7175 FAX

DESIGN BUILD
**FEDERAL CORRECTIONAL INSTITUTION
GLENVILLE, WEST VIRGINIA**

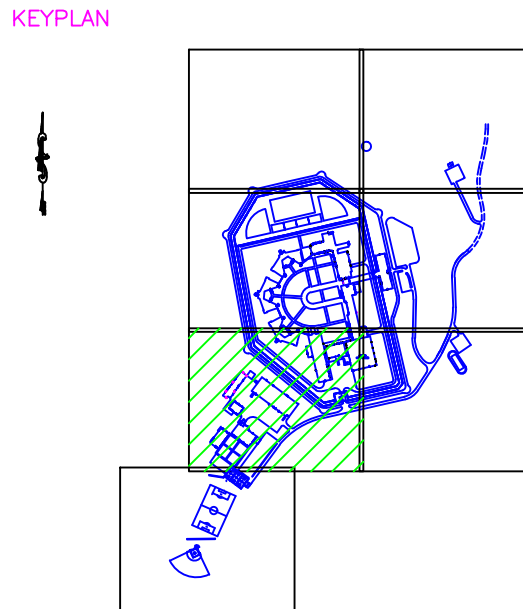

NO.	REVISION	DATE
1	AS BUILT	9/16/02
0	ISSUED FOR CONSTRUCTION FINAL ISSUE	1/5/01

PHONE (304) 624-4108
FAX (304) 624-7831
THRASHER
CIVIL, ENVIRONMENTAL, AND CONSULTING
30 COLUMBIA BOULEVARD - CLARKSBURG, WV 26301

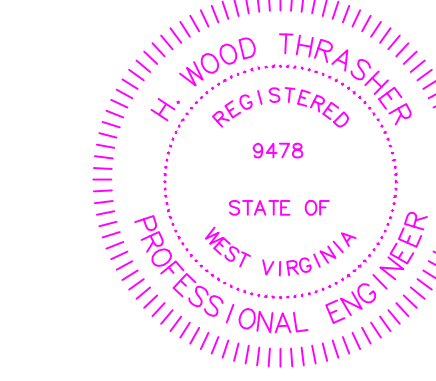

AS BUILT

**FEDERAL
CORRECTIONAL INSTITUTION
GLENVILLE, WEST VIRGINIA**

PROJECT NO.	JOB#	30-B24
DRAWN BY	MO	CHKD. BY CDF
DATE	8 August 2000	CHK DATE 8/6/00
SCALE	1:500	
TITLE	FINE GRADING, PAVING PLAN	
NUMBER	C-73	

PROPERTY OF THE GOVERNMENT