


XREFS: IMAGES:None  
User:Leandroasadi\_Spec:PRIME STANDARD File:1\ACAD\PROJ\2118\WVA BUILDING AS-BUILT\DRAWINGS\2118-B44-01.DWG Scale:1:1 Date:07/16/2008 Time:08:52 Layout:Layout1

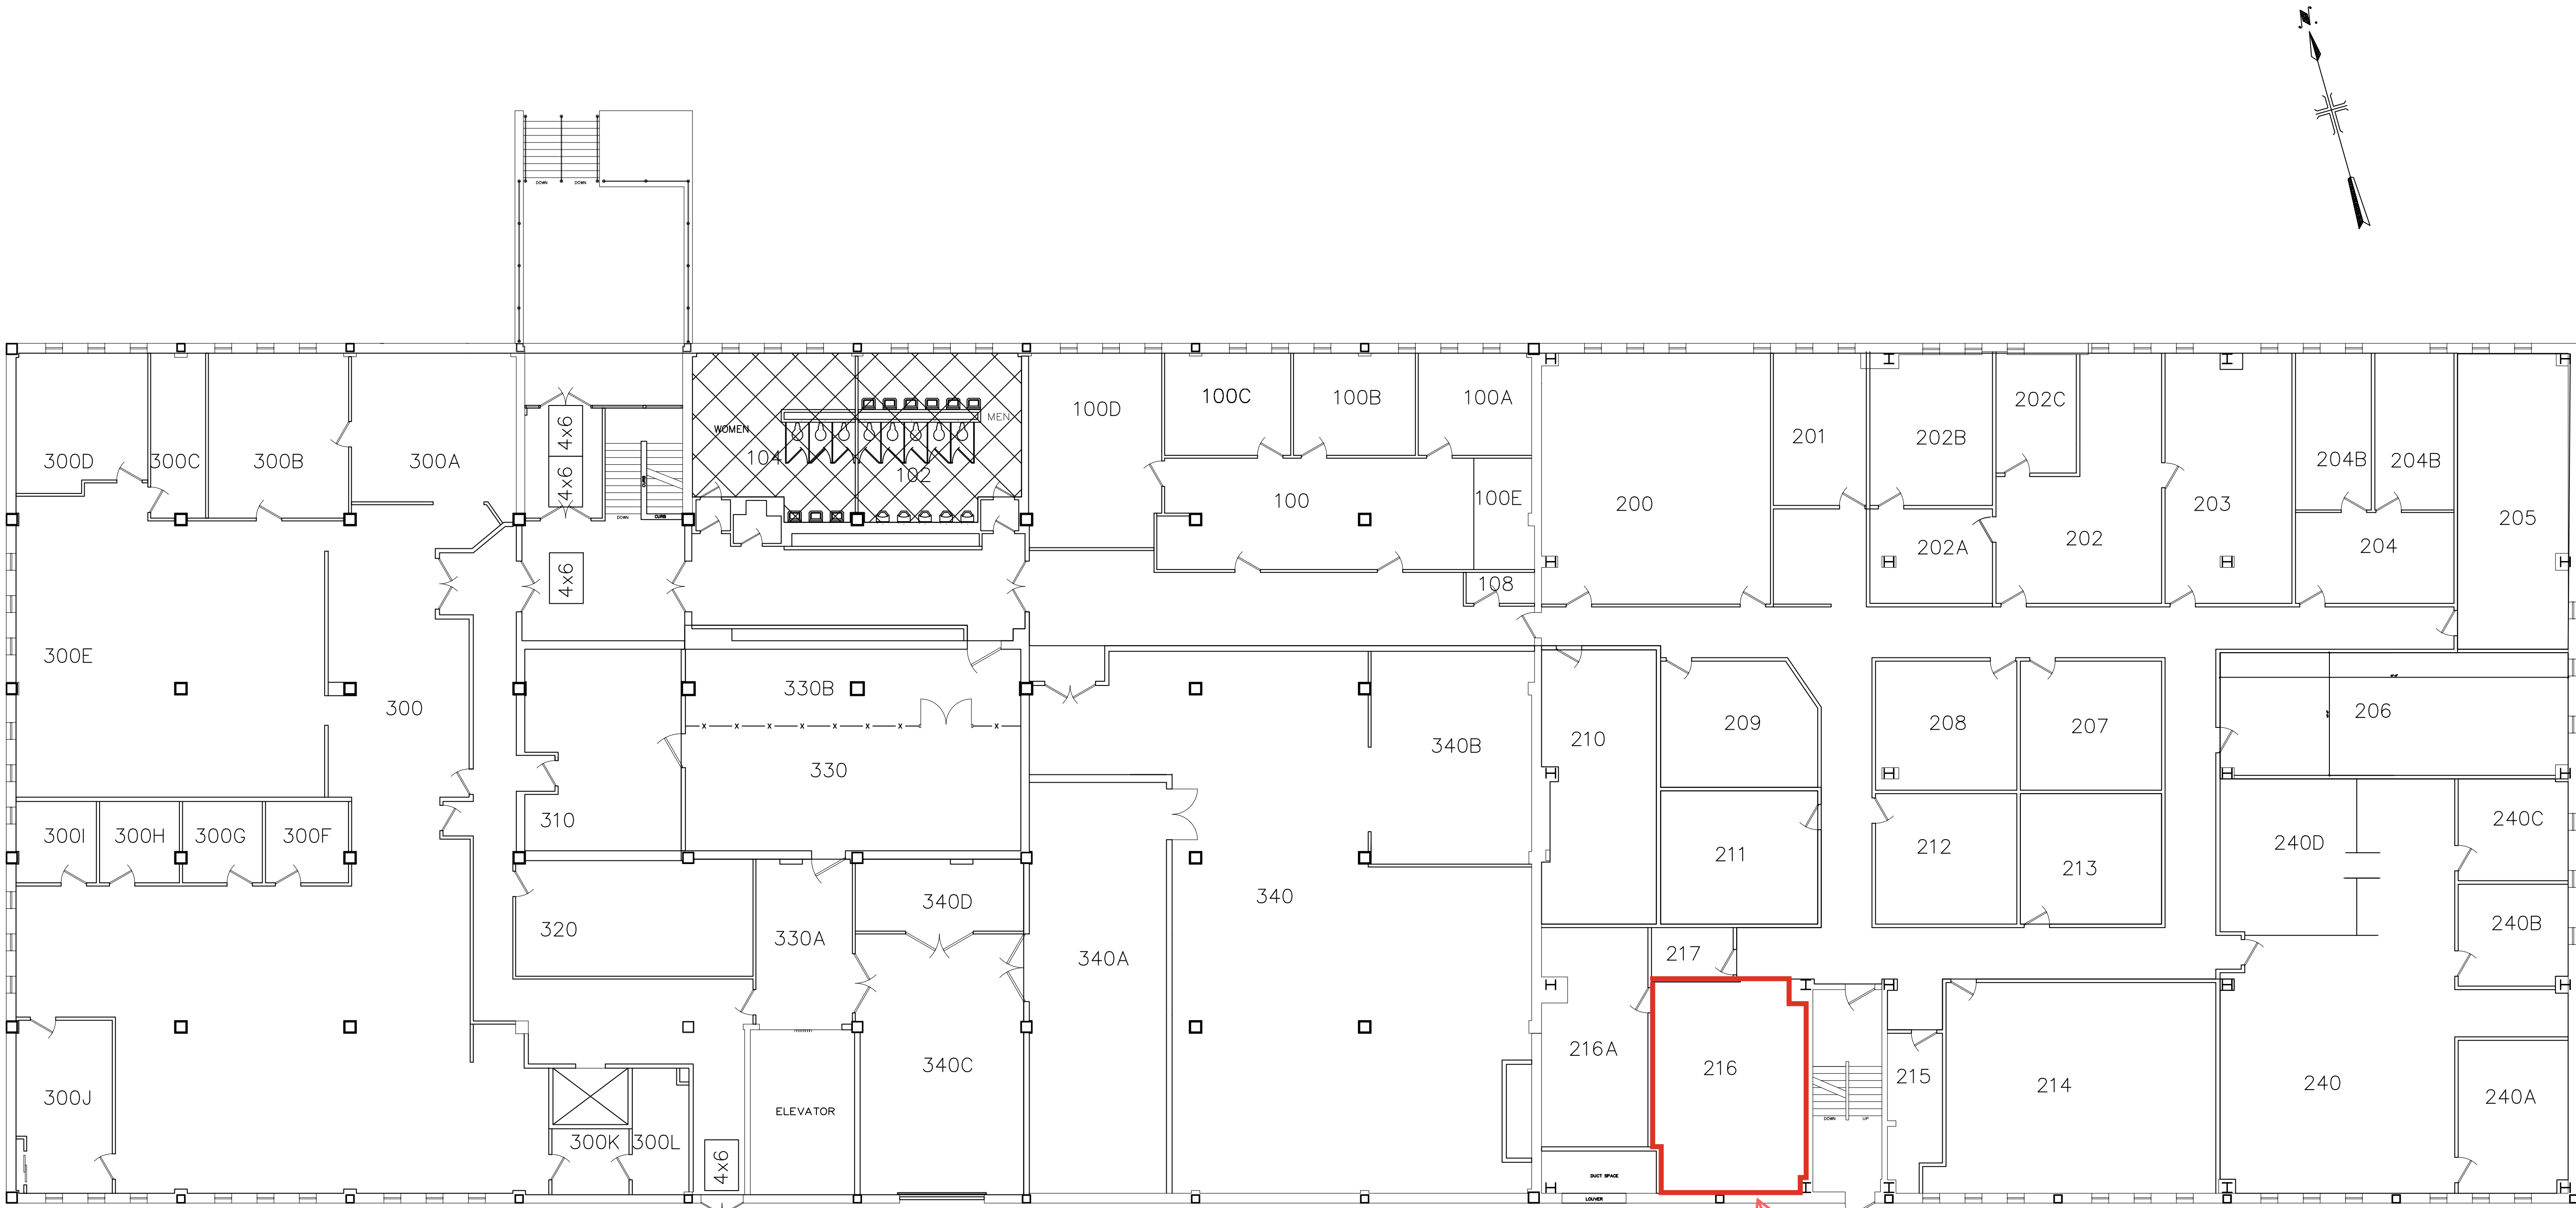

445 SF (+/-)

LEGEND:

- DOOR
- WINDOW
- INTERIOR WALL
- EXTERIOR WALL
- STAIRS
- HAND RAIL
- CAGED AREA
- COLUMNS

6 0 6 12  
SCALE: 3/32" = 1'-0"

| BUILDING 44 – FIRST FLOOR       |      |         |                    |      |             |
|---------------------------------|------|---------|--------------------|------|-------------|
| WATERVLJET ARSENAL              |      |         |                    |      |             |
| WATERVLJET, NEW YORK            |      |         |                    |      |             |
|                                 | Name | Date    | Rev.               | Date | Description |
| DRAWN                           | RNT  | -       |                    |      |             |
| CHECKED                         | EAG  | 6/22/07 |                    |      |             |
|                                 |      |         |                    |      |             |
| SUBMITTED                       | -    | -       | Scale: 3/32"=1'-0" |      |             |
|                                 |      |         | Date: APRIL 2007   |      |             |
| CHIEF ENGINEERING DIVISION      |      |         | Drawing Number     |      | Sheet       |
| DIRECTOR, ENGINEERING & HOUSING |      |         | 6007-44-1          |      | 1 OF 2      |