

D

C

B

A


D

C


B

A


NO.	REVISION	BY	DATE
1	INITIAL RELEASE	BSB	3-12-19
A	REVISED FOR RESUBMITTAL	BSB	5-2-19

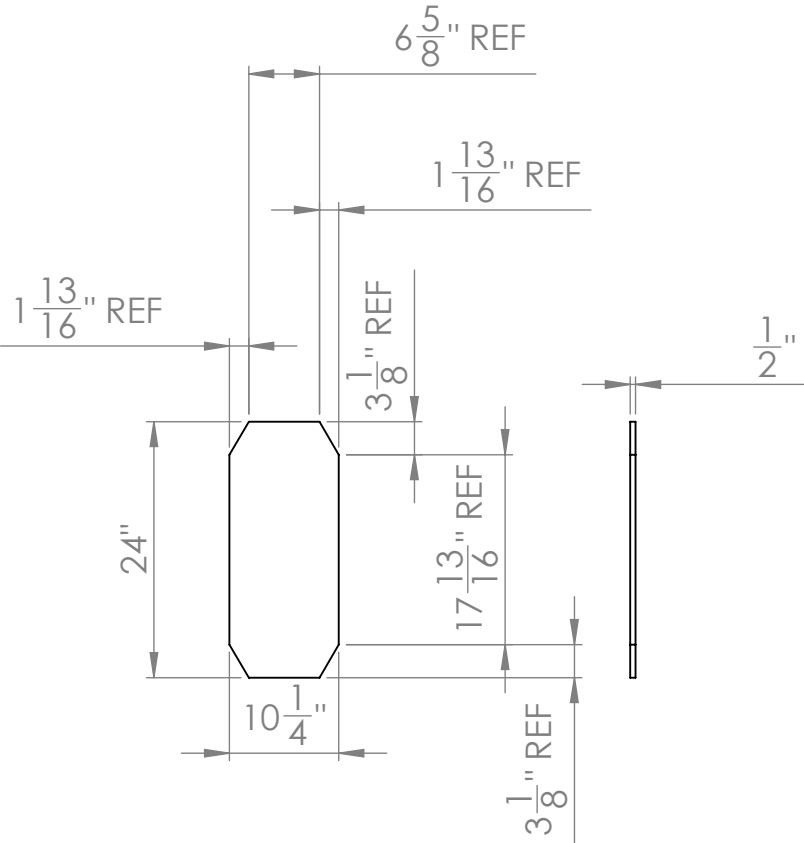


ITEM 1: CAP PLATE
NOTE:
1.) Material: ASTM A36
2.) Est. Weight: 33 lbs
3.) REF Lifting Beam DWG # 10-C-11258
4.) Cut to Suit Assembly REF 10-C-11258 SECTION E-E

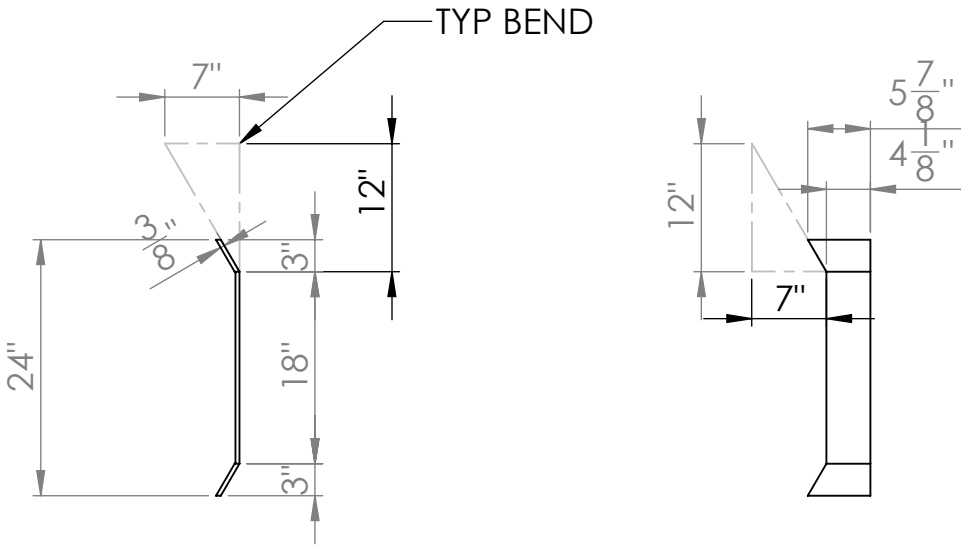


ITEM 2: CUT PLATE A
NOTE:
1.) Material: ASTM A36
2.) Est. Weight: 12 lbs
3.) REF Lifting Beam DWG # 10-C-11258
4.) Cut to Suit Assembly REF 10-C-11258 SECTION E-E

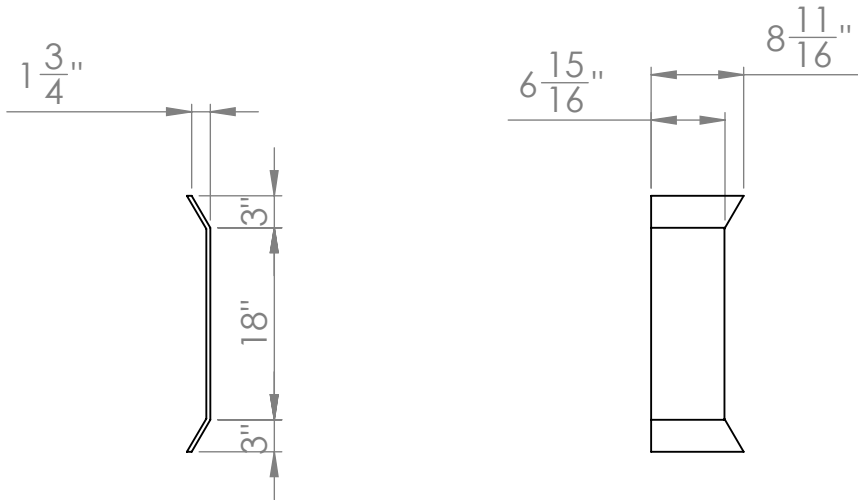


ITEM 3: CUT PLATE B
NOTE:
1.) Material: ASTM A36
2.) Est. Weight: 19 lbs
3.) REF Lifting Beam DWG # 10-C-11258
4.) Cut to Suit Assembly REF 10-C-11258 SECTION E-E

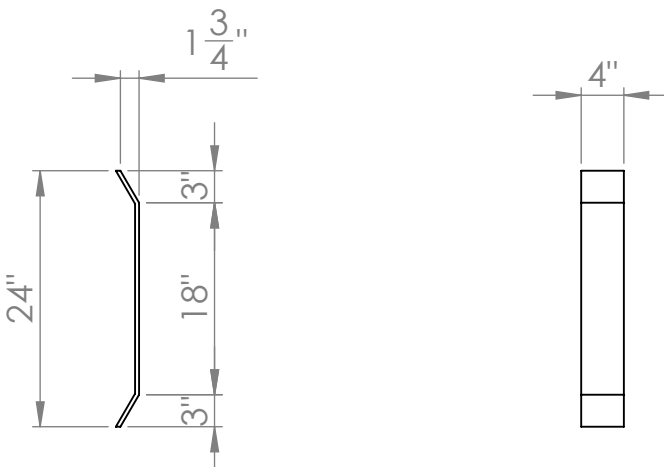

ITEM 4: BENT PLATE B
NOTE:
1.) Material: ASTM A36
2.) Est. Weight: 11 lbs
3.) REF Lifting Beam DWG # 10-C-11258
4.) Cut to Suit Assembly REF 10-C-11258 SECTION E-E

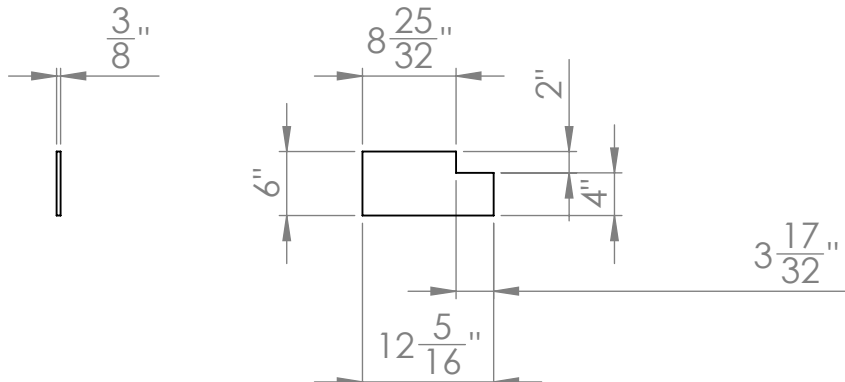

ITEM 5: TOP & BOTTOM PLATE
NOTE:
1.) Material: ASTM A36
2.) Est. Weight: 11 lbs
3.) REF Lifting Beam DWG # 10-C-11258
4.) Cut to Suit Assembly REF 10-C-11258 SECTION E-E

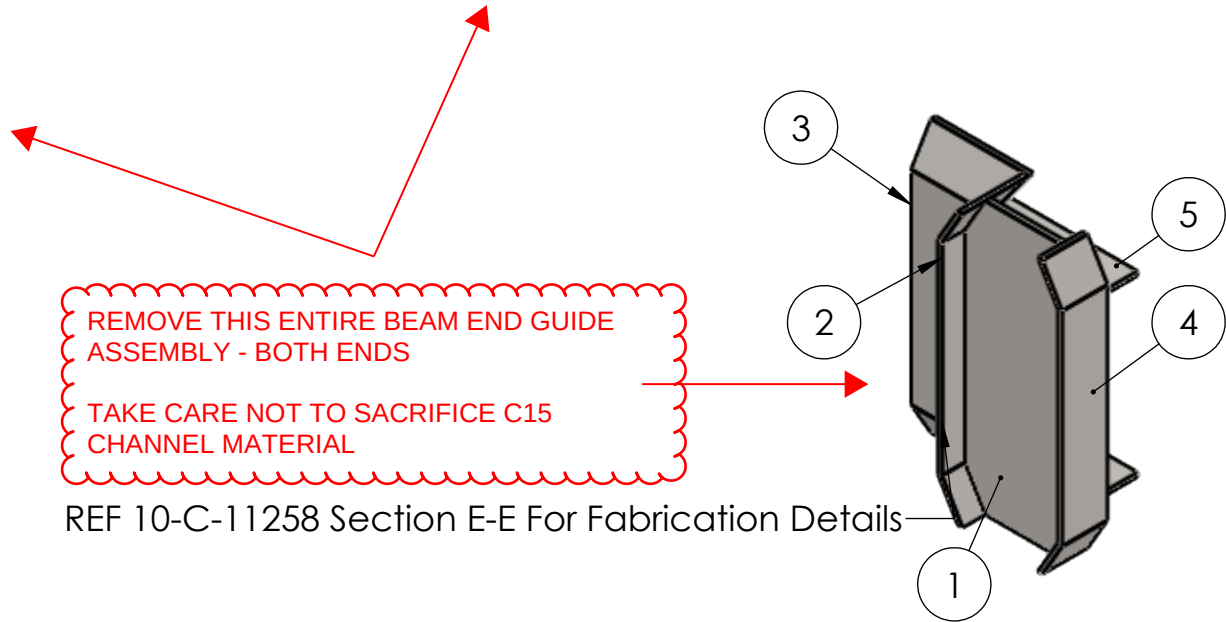

REMOVE THIS ENTIRE BEAM END GUIDE
ASSEMBLY - BOTH ENDS

TAKE CARE NOT TO SACRIFICE C15
CHANNEL MATERIAL

REF 10-C-11258 Section E-E For Fabrication Details

FINAL

PROPOSED MODIFICATIONS TO THE ORIGINAL STOPLOG LIFT BEAM
FABRICATION MARKED IN RED

COLORADO RIVER IRRIGATION PROJECT, HEADGATE ROCK DAM
REHABILITATION OF MAIN CANAL STRUCTURES, MODIFICATION 14
CONTRACT 140A1218D0013/140A1622F0021
MARCH 2026

DOWL PROJECT NO. 4626.12494.01 - MOD 14



ITEM NO.	PART	DESCRIPTION	QTY
1	Cap Plate	24" x 10-1/4" x 1/2" A36 Plate	1
2	Cut Plate A	3/8" A36 Bar	1
3	Cut Plate B	3/8" A36 Bar	1
4	Bent Plate	3/8" A36 Bar	1
5	Top Plate	6" x 3/8" A36 Bar	2

- NOTES:
- THIS PRINT IS LOANED SUBJECT TO RETURN UPON DEMAND & UPON THE EXPRESS CONDITION THAT IT IS NOT TO BE USED DIRECTLY OR INDIRECTLY IN ANY WAY DETRIMENTAL TO USS'S INTERESTS.
 - THIS IS A COMPUTER GENERATED DRAWING AND IS NOT TO BE REVISED BY MANUAL METHODS.
 - ALL DIMENSIONS ARE IN FEET AND/OR INCHES UNLESS INDICATED OTHERWISE.
 - BREAK ALL SHARP EDGES AND CORNERS.
 - ALL DIMENSION IN PARENTHESES () ARE REFERENCE ONLY AND NOT FOR CONSTRUCTION OR INSPECTION PURPOSES.
 - ALL MACHINED FASTENER THREADS ARE TO ANSI B1.1-2003 UNLESS NOTED OTHERWISE.
 - ALL PIPE THREADS ARE TO ANSI/ASME B1.20.1-1983 (R2006) UNLESS NOTED OTHERWISE.
 - ALL DRYSEAL PIPE THREADS ARE TO ANSI/ASME B1.20.3-1976 (R2003) UNLESS NOTED OTHERWISE.
 - ALL WELDING TO AWS D01.1 UNLESS NOTED OTHERWISE.
 - KEY SLOTS ARE TO ANSI B17.1-1967(1998).

DIMENSIONAL TOLERANCES (UNLESS OTHERWISE NOTED)
2-PLACE ±0.010
3-PLACE ±0.005
FRACTION ±0.015

TITLE:

LIFTING BEAM GUIDE COMPONENTS
BIA COLORADO RIVER

SCALE: 1:18

DATE: 5-2-19

APPROVED BY:

DRAWN BY: BSB


REV.: A

C

USS UNDERWATER SCREENING SERVICES
1-888-296-1920 FORTY-FORT, PA

DRAWING NO.: 10-B-11262



NO.	REVISION	BY	DATE
1	INITIAL RELEASE	BSB	3-12-19
A	REVISED FOR RESUBMITTAL	BSB	5-2-19

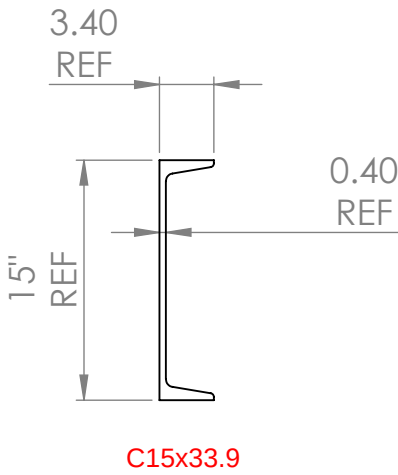

SHORTEN C15 CHANNEL PAIR LENGTH TO 19'-5" -
SYMETRICAL ABOUT THE LIFT BEAM CENTERLINE

LIFT BEAM MODIFICATION SUMMARY:

- REMOVE END GUIDE ASSEMBLY, BOTH ENDS
- SHORTEN C15 CHANNEL PAIR LENGTH
- RECONSTRUCT END GUIDE ASSEMBLY
EACH END PER MODIFICATION DETAILS
- NO CHANGE TO BEAM "INTERIOR"

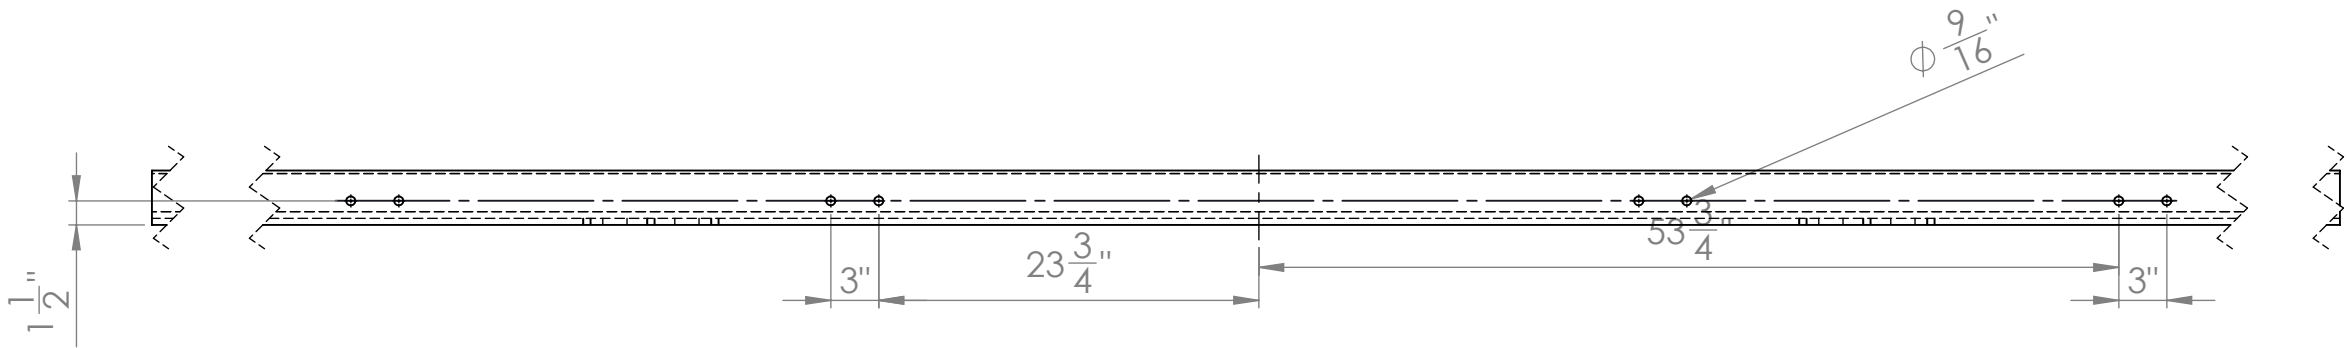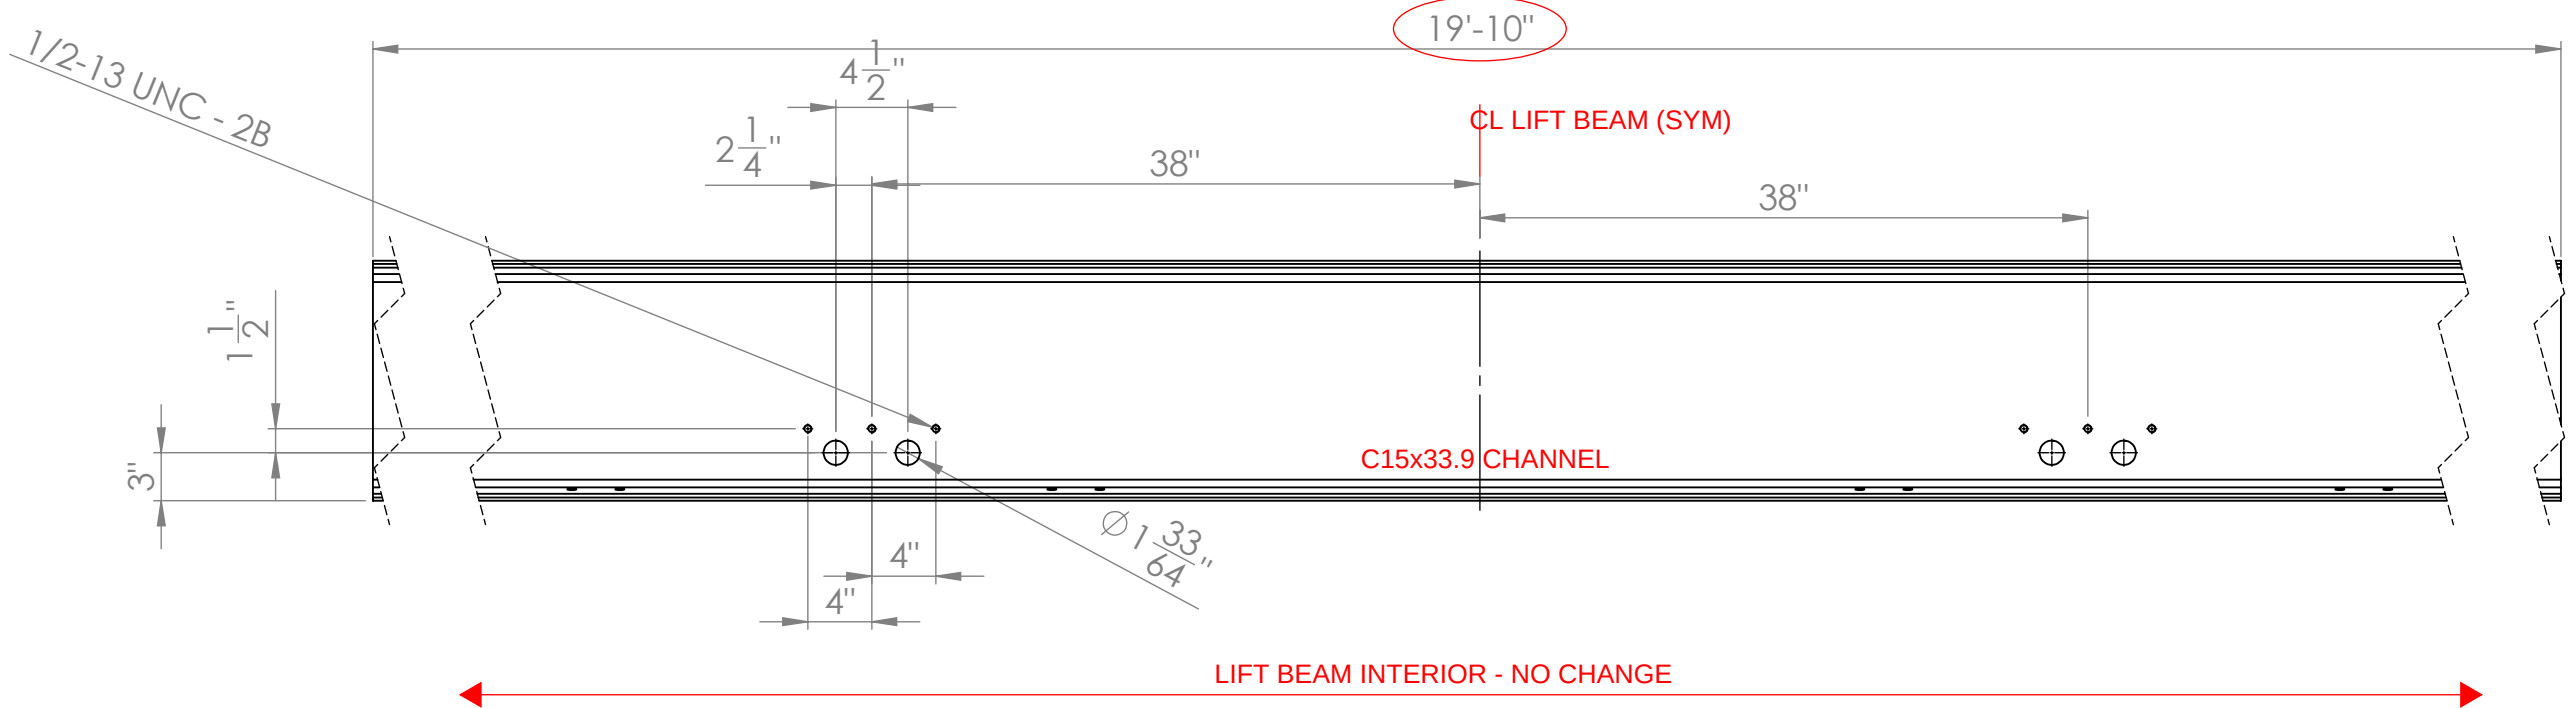

NOTES:

- THIS PRINT IS LOANED SUBJECT TO RETURN UPON DEMAND & UPON THE EXPRESS CONDITION THAT IT IS NOT TO BE USED DIRECTLY OR INDIRECTLY IN ANY WAY DETRIMENTAL TO USS'S INTERESTS.
- THIS IS A COMPUTER GENERATED DRAWING AND IS NOT TO BE REVISED BY MANUAL METHODS.
- ALL DIMENSIONS ARE IN FEET AND/OR INCHES UNLESS INDICATED OTHERWISE.
- BREAK ALL SHARP EDGES AND CORNERS.
- ALL DIMENSION IN PARENTHESES () ARE REFERENCE ONLY AND NOT FOR CONSTRUCTION OR INSPECTION PURPOSES.
- ALL MACHINED FASTENER THREADS ARE TO ANSI B1.1-2003 UNLESS NOTED OTHERWISE.
- ALL PIPE THREADS ARE TO ANSI/ASME B1.20.1-1983 (R2006) UNLESS NOTED OTHERWISE.
- ALL DRYSEAL PIPE THREADS ARE TO ANSI/ASME B1.20.3-1976 (R2003) UNLESS NOTED OTHERWISE.
- ALL WELDING TO AWS D01.1 UNLESS NOTED OTHERWISE.
- KEY SLOTS ARE TO ANSI B17.1-1967(1998).

Notes:

- C15 x 33.9# C Channel
- Material: ASTM A36
- Est. Weight: 667 lbs

FINAL

PROPOSED MODIFICATIONS TO THE ORIGINAL STOPLOG LIFT
BEAM FABRICATION MARKED IN RED

MARCH 2026

DOWL PROJECT NO. 4626.12494.01 - MOD 14




FABRICATION NOTES:

- Welding Symbols apply to the joints of all members of similar identification
- All fillet welds shall be returned

DIMENSIONAL TOLERANCES (UNLESS OTHERWISE NOTED)

- 2-PLACE ±0.010
3-PLACE ±0.005
FRACTION ±0.015

TITLE: LIFTING BEAM C CHANNEL BIA COLORADO RIVER					
SCALE: 1:12	DATE: 5-2-19	APPROVED BY:	DRAWN BY: BSB	REV.: A	C
USS UNDERWATER SCREENING SERVICES 1-888-296-1920 FORTY-FORT, PA			DRAWING NO.: 10-B-11266		

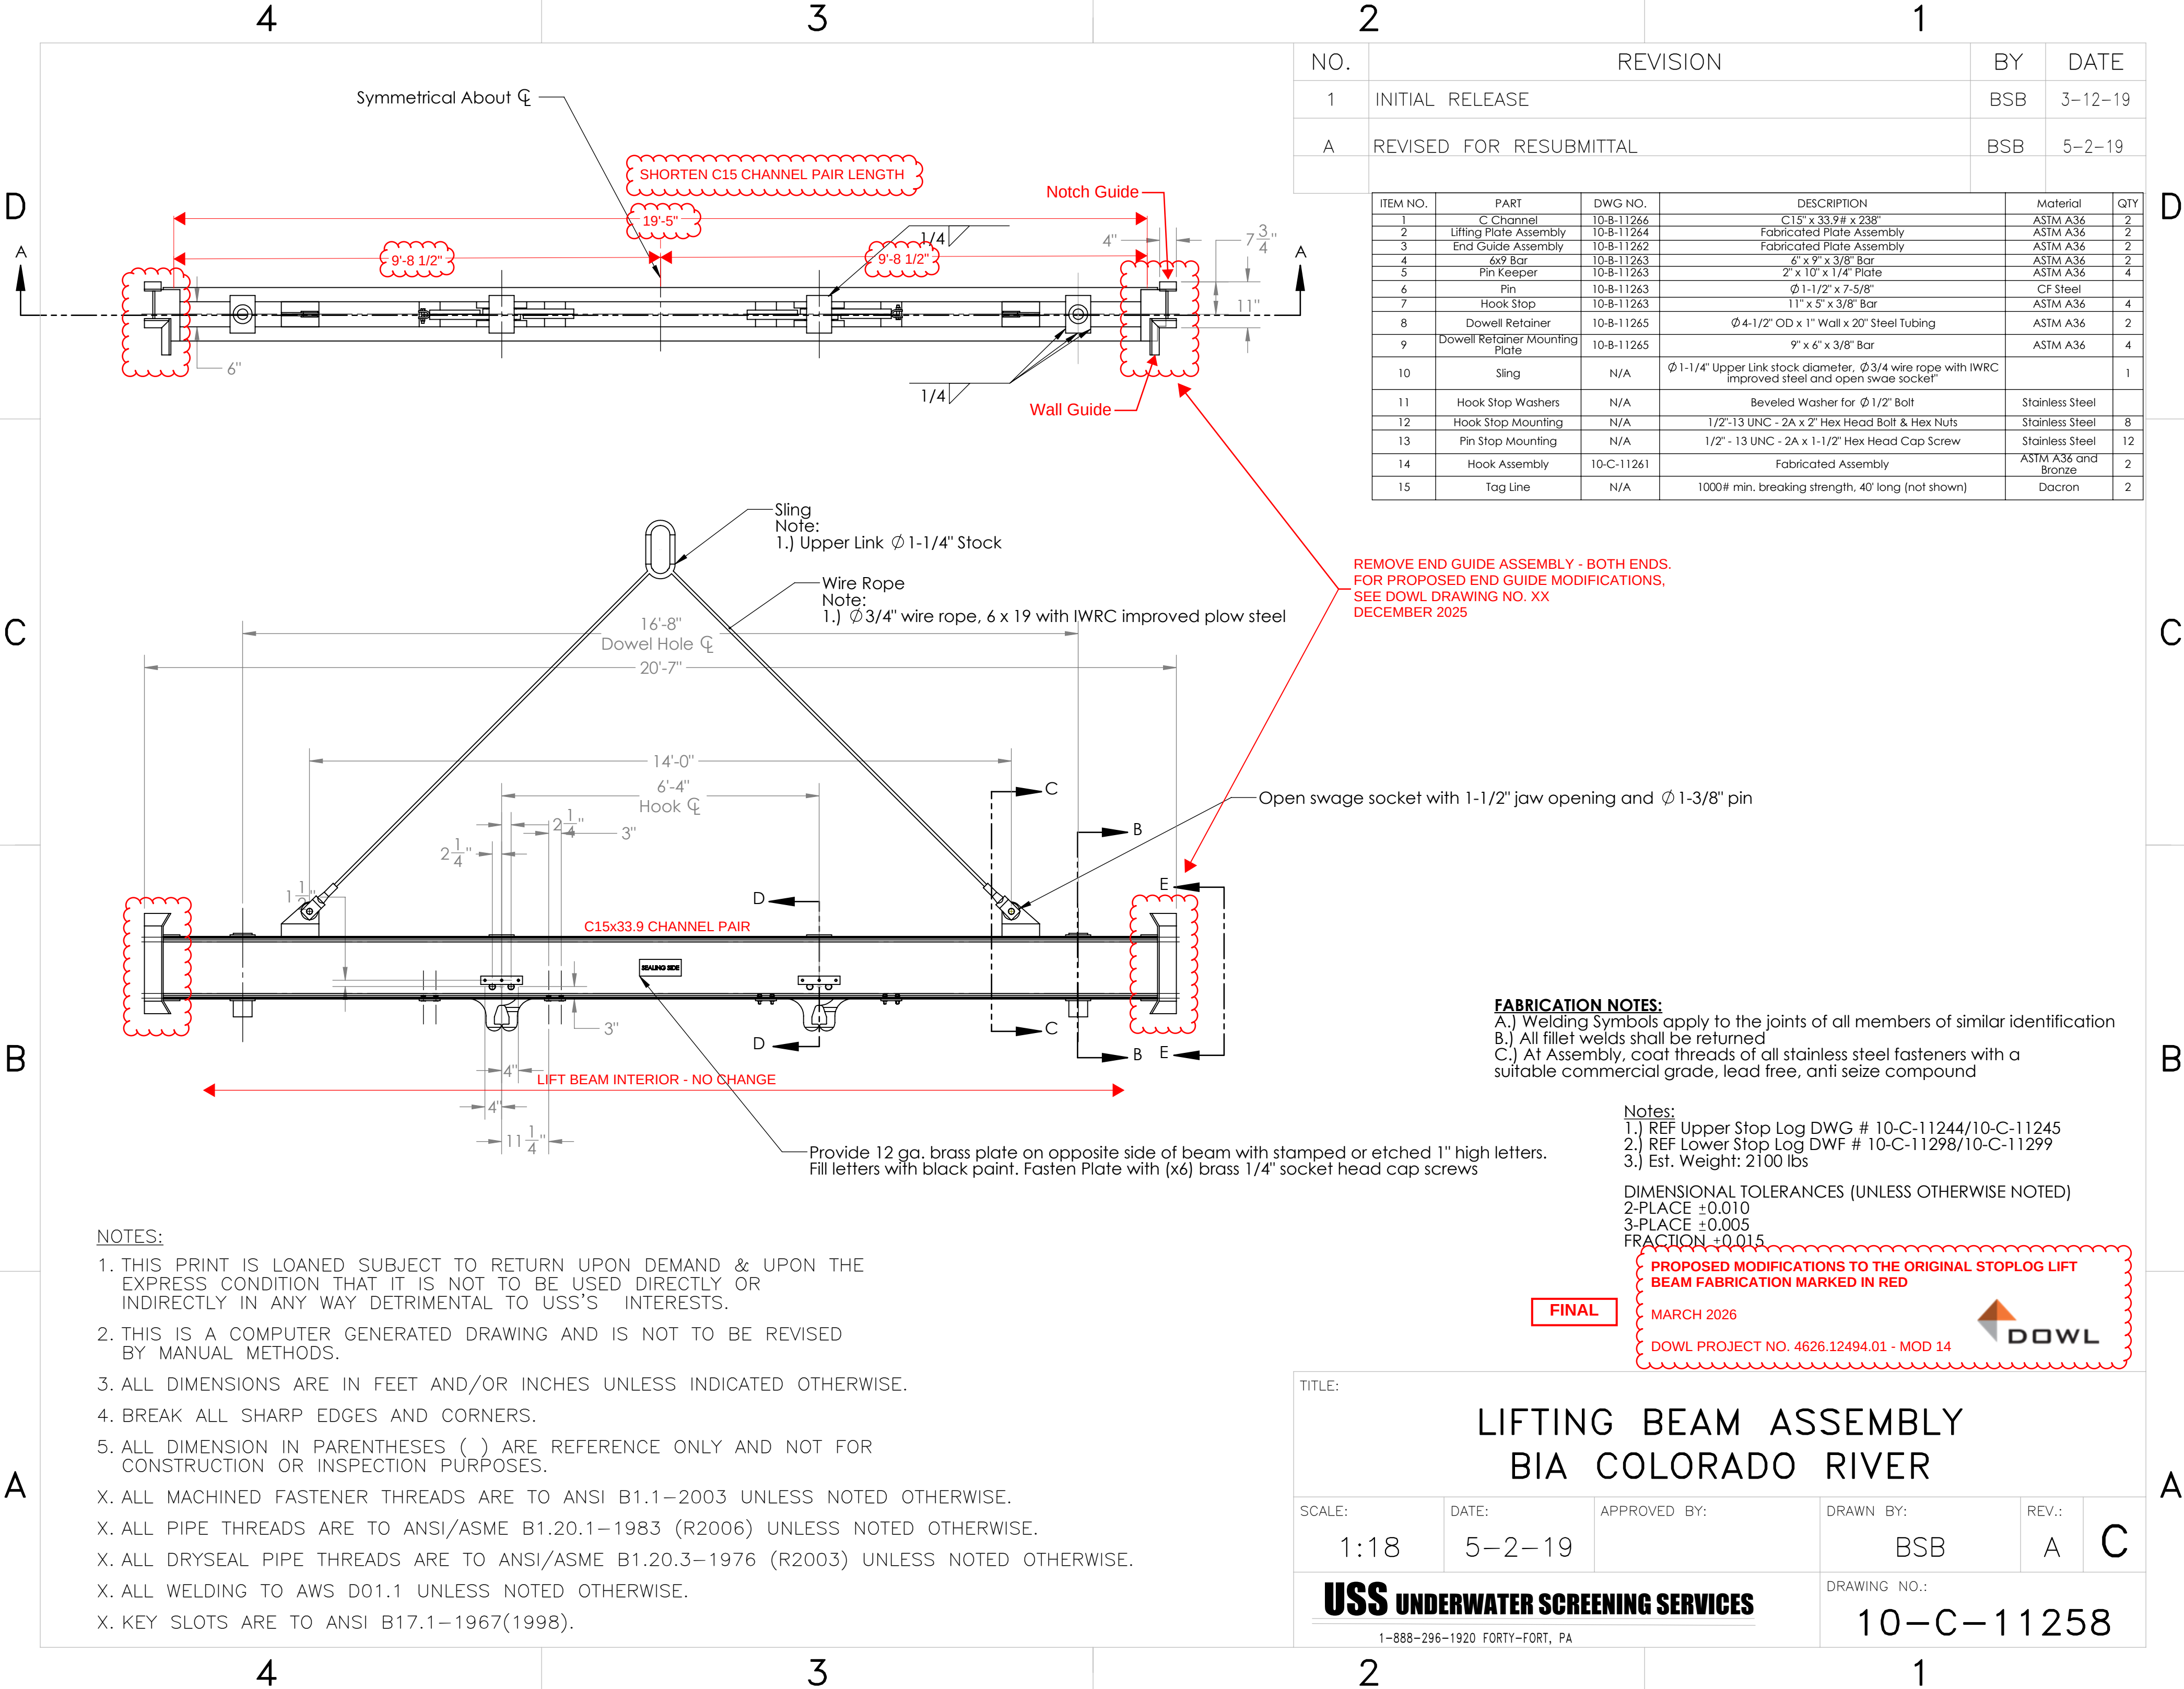

NO.	REVISION	BY	DATE
1	INITIAL RELEASE	BSB	3-12-19
A	REVISED FOR RESUBMITTAL	BSB	5-2-19

ITEM NO.	PART	DWG NO.	DESCRIPTION	Material	QTY
1	C Channel	10-B-11266	C15" x 33.9# x 238"	ASTM A36	2
2	Lifting Plate Assembly	10-B-11264	Fabricated Plate Assembly	ASTM A36	2
3	End Guide Assembly	10-B-11262	Fabricated Plate Assembly	ASTM A36	2
4	6x9 Bar	10-B-11263	6" x 9" x 3/8" Bar	ASTM A36	2
5	Pin Keeper	10-B-11263	2" x 10" x 1/4" Plate	ASTM A36	4
6	Pin	10-B-11263	Ø 1-1/2" x 7-5/8"	CF Steel	
7	Hook Stop	10-B-11263	11" x 5" x 3/8" Bar	ASTM A36	4
8	Dowell Retainer	10-B-11265	Ø 4-1/2" OD x 1" Wall x 20" Steel Tubing	ASTM A36	2
9	Dowell Retainer Mounting Plate	10-B-11265	9" x 6" x 3/8" Bar	ASTM A36	4
10	Sling	N/A	Ø 1-1/4" Upper Link stock diameter, Ø 3/4 wire rope with IWRC improved steel and open swae socket"		1
11	Hook Stop Washers	N/A	Beveled Washer for Ø 1/2" Bolt	Stainless Steel	
12	Hook Stop Mounting	N/A	1/2"-13 UNC - 2A x 2" Hex Head Bolt & Hex Nuts	Stainless Steel	8
13	Pin Stop Mounting	N/A	1/2" - 13 UNC - 2A x 1-1/2" Hex Head Cap Screw	Stainless Steel	12
14	Hook Assembly	10-C-11261	Fabricated Assembly	ASTM A36 and Bronze	2
15	Tag Line	N/A	1000# min. breaking strength, 40' long (not shown)	Dacron	2

- NOTES:
- THIS PRINT IS LOANED SUBJECT TO RETURN UPON DEMAND & UPON THE EXPRESS CONDITION THAT IT IS NOT TO BE USED DIRECTLY OR INDIRECTLY IN ANY WAY DETRIMENTAL TO USS'S INTERESTS.
 - THIS IS A COMPUTER GENERATED DRAWING AND IS NOT TO BE REVISED BY MANUAL METHODS.
 - ALL DIMENSIONS ARE IN FEET AND/OR INCHES UNLESS INDICATED OTHERWISE.
 - BREAK ALL SHARP EDGES AND CORNERS.
 - ALL DIMENSION IN PARENTHESES () ARE REFERENCE ONLY AND NOT FOR CONSTRUCTION OR INSPECTION PURPOSES.
 - ALL MACHINED FASTENER THREADS ARE TO ANSI B1.1-2003 UNLESS NOTED OTHERWISE.
 - ALL PIPE THREADS ARE TO ANSI/ASME B1.20.1-1983 (R2006) UNLESS NOTED OTHERWISE.
 - ALL DRYSEAL PIPE THREADS ARE TO ANSI/ASME B1.20.3-1976 (R2003) UNLESS NOTED OTHERWISE.
 - ALL WELDING TO AWS D01.1 UNLESS NOTED OTHERWISE.
 - KEY SLOTS ARE TO ANSI B17.1-1967(1998).

TITLE:

LIFTING BEAM ASSEMBLY
BIA COLORADO RIVER

SCALE:

1:18

DATE:

5-2-19

APPROVED BY:

BSB

DRAWN BY:

A

REV.:

C







DRAWING NO.:

10-C-11258

USS UNDERWATER SCREENING SERVICES

1-888-296-1920 FORTY-FORT, PA

NO.	REVISION	BY	DATE
1	INITIAL RELEASE	BSB	3-12-19
A	REVISED FOR RESUBMITTAL	BSB	5-2-19

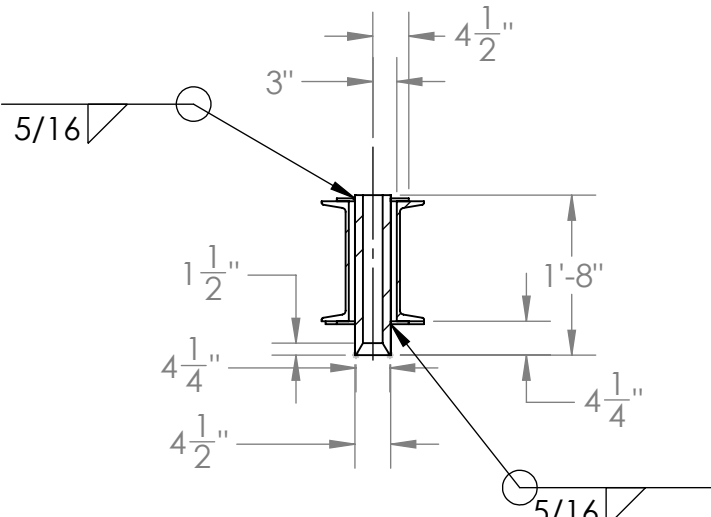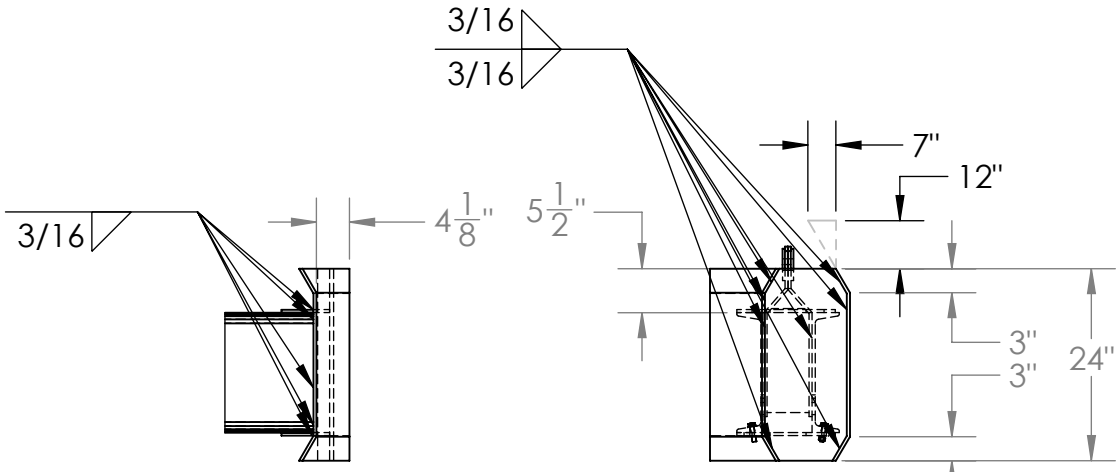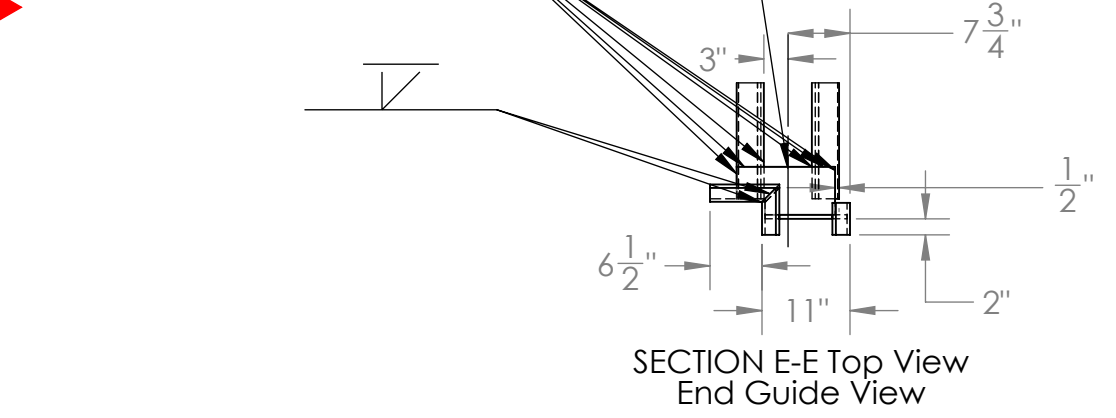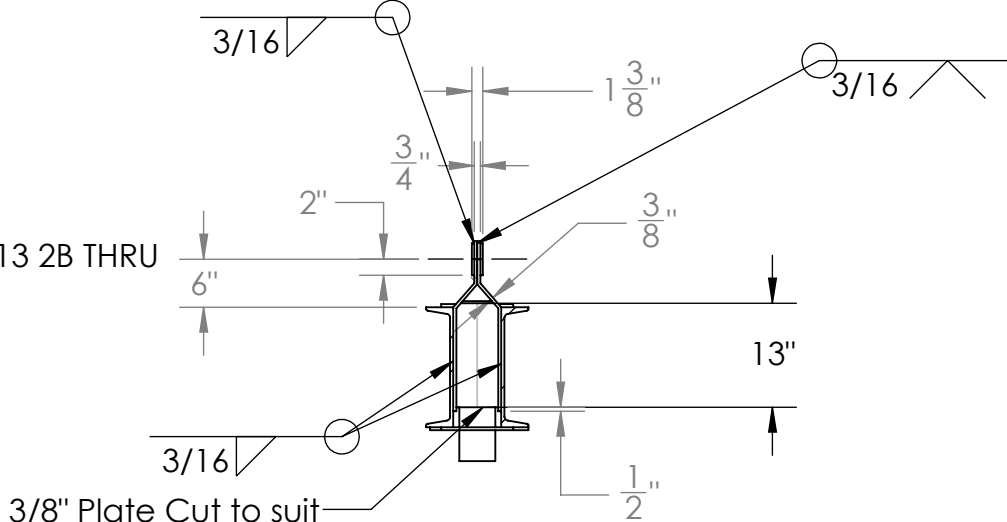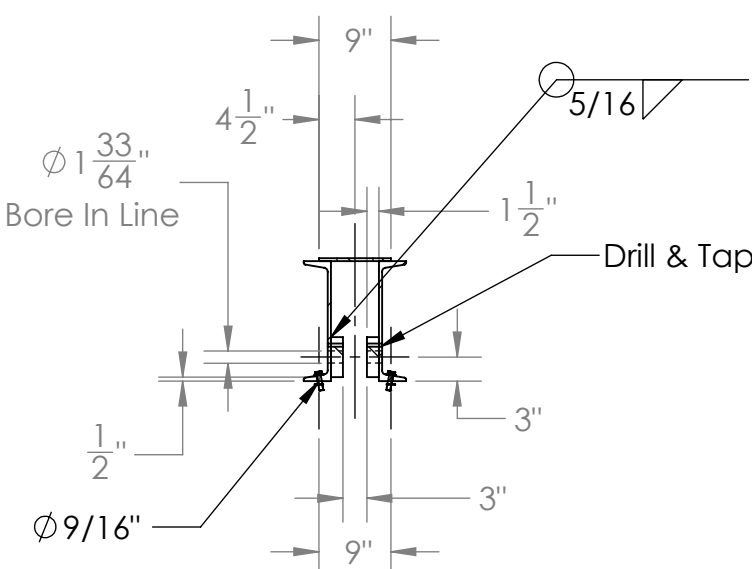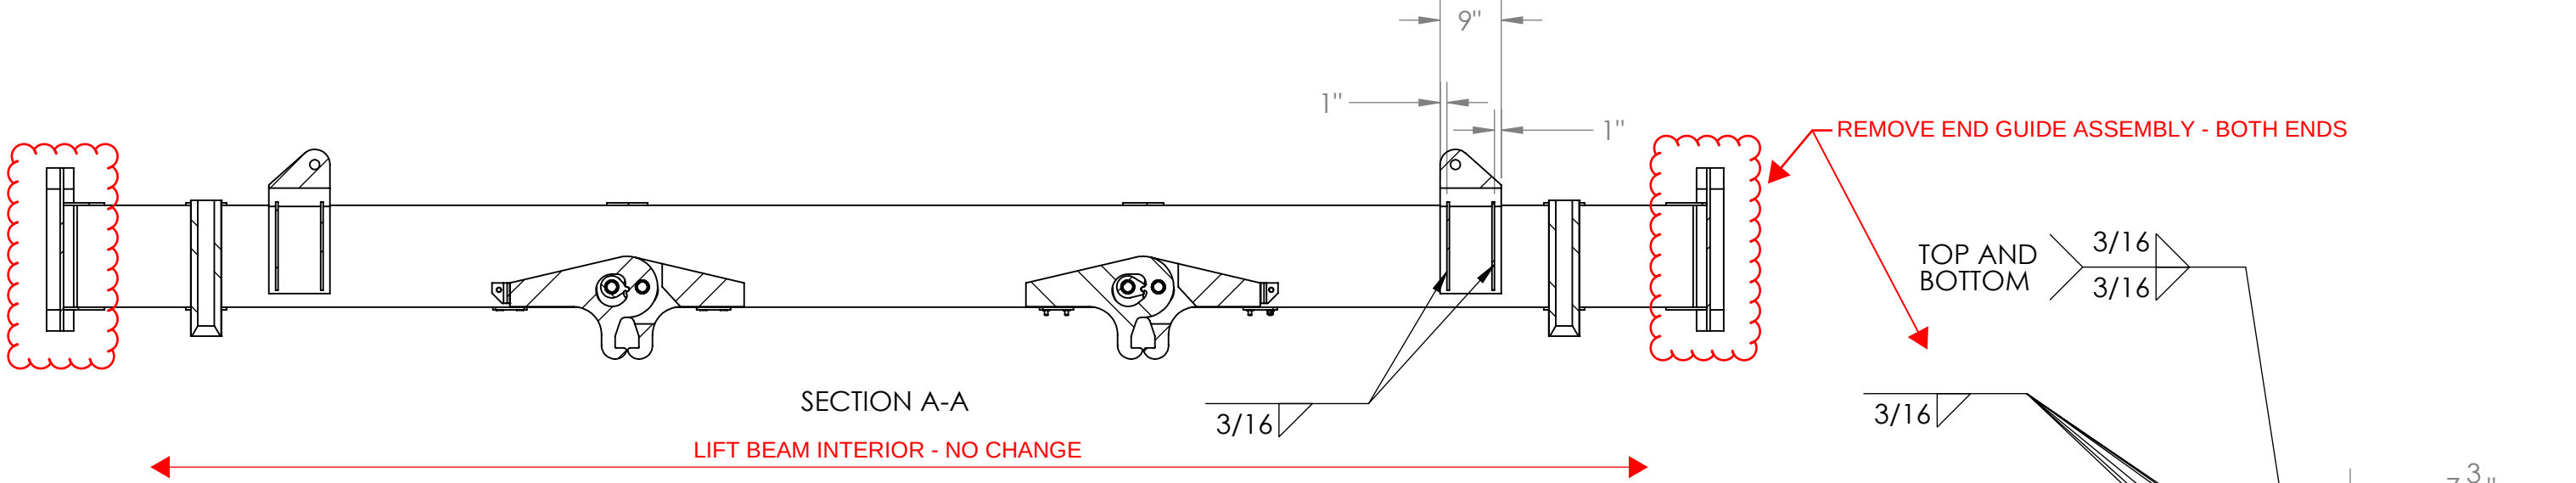

FABRICATION NOTES:
A.) Welding Symbols apply to the joints of all members of similar identification
B.) All fillet welds shall be returned

DIMENSIONAL TOLERANCES (UNLESS OTHERWISE NOTED)
2-PLACE ±0.010
3-PLACE ±0.005
FRACTION ±0.015

PROPOSED MODIFICATIONS TO THE ORIGINAL STOPLOG LIFT BEAM FABRICATION MARKED IN RED

MARCH 2026
DOWL PROJECT NO. 4626.12494.01 - MOD 14



FINAL

- NOTES:
1. THIS PRINT IS LOANED SUBJECT TO RETURN UPON DEMAND & UPON THE EXPRESS CONDITION THAT IT IS NOT TO BE USED DIRECTLY OR INDIRECTLY IN ANY WAY DETRIMENTAL TO USS'S INTERESTS.
 2. THIS IS A COMPUTER GENERATED DRAWING AND IS NOT TO BE REVISED BY MANUAL METHODS.
 3. ALL DIMENSIONS ARE IN FEET AND/OR INCHES UNLESS INDICATED OTHERWISE.
 4. BREAK ALL SHARP EDGES AND CORNERS.
 5. ALL DIMENSION IN PARENTHESES () ARE REFERENCE ONLY AND NOT FOR CONSTRUCTION OR INSPECTION PURPOSES.
 - X. ALL MACHINED FASTENER THREADS ARE TO ANSI B1.1-2003 UNLESS NOTED OTHERWISE.
 - X. ALL PIPE THREADS ARE TO ANSI/ASME B1.20.1-1983 (R2006) UNLESS NOTED OTHERWISE.
 - X. ALL DRYSEAL PIPE THREADS ARE TO ANSI/ASME B1.20.3-1976 (R2003) UNLESS NOTED OTHERWISE.
 - X. ALL WELDING TO AWS D01.1 UNLESS NOTED OTHERWISE.
 - X. KEY SLOTS ARE TO ANSI B17.1-1967(1998).

TITLE:

LIFTING BEAM ASSEMBLY
BIA COLORADO RIVER

SCALE:

1:18

DATE:

5-2-19

APPROVED BY:

DRAWN BY:

BSB

REV.:

A

C

DRAWING NO.:

10-C-11258

USS UNDERWATER SCREENING SERVICES

1-888-296-1920 FORTY-FORT, PA

D

C

B

A

D

C

B

A