

General Notes:

1. EXISTING CONDITIONS ARE BASED ON EXISTING PLANS AND FIELD VERIFICATION WHERE FEASIBLE. ACTUAL CONDITIONS MAY DIFFER FROM THOSE INDICATED. CONTRACTOR TO FIELD VERIFY IN ADVANCE THE LOCATION AND CONDITION OF THESE EXISTING SYSTEMS SHOWN TO BE MODIFIED OR REMOVED. DURING REMOVAL, CONDITIONS OF REMOVED MATERIALS SHOULD NOT BE FOUND TO DIFFER SIGNIFICANTLY FROM CONSTRUCTION DOCUMENTS.
2. PLUMBING FLOOR PLANS INDICATE FINAL PHASE PLUMBING SYSTEMS LAYOUT UNLESS OTHERWISE INDICATED. PHASING OF PLUMBING DEMOLITION AND NEW WORK IN EXISTING SPACES MAY REQUIRE TEMPORARY REDUCTION OF PIPING AND/OR RESTRICTION OF EQUIPMENT. EVERY EFFORT MUST BE MADE TO MAINTAIN THE FLOW OF UNCONTAMINATED WASTE AND VENT. IN OPERATION, IN REMODELING AREA, DURING DEMOLITION AND RECONSTRUCTION, ALL SHUTDOWNS MUST BE APPROVED AND COORDINATED WITH DOWNER IN ADVANCE.
3. COORDINATE ALL PIPE ROUTING AND PIPE ELEVATIONS WITH EXISTING CONDITIONS IN ADVANCE OF INSTALLATION.
4. ALL VALVES TO BE INSTALLED ARE TO BE ACCESSIBLE. PROVIDE ACCESS PANELS AS REQUIRED.
5. PROVIDE STRAINERS IMMEDIATELY UPSTREAM OF ALL BALANCING VALVES.
6. ALL TRAP ARMS TO BE CAST IRON.
7. DUCTECTRIC UNIONS REQUIRED AT ALL CONNECTIONS BETWEEN ALL DISSIMILAR METALS.
8. EXISTING VENTING TO BE REUSED.
9. ALL EXISTING VERTICAL WASTE PIPING PENETRATING FIRST FLOOR AND CONNECTING INTO WASTE LINES LOCATED WITHIN THE CRAWL SPACE AND/OR BASEMENT CEILING SHALL BE REPLACED.
10. CUT, PATCH, AND PAINT ALL EXISTING HARD SURFACES, INCLUDING WALLS, CEILING, AND PERFORMED, AND MATCH EXISTING ADJACENT SURFACES. WHERE WORK IS PERFORMED IN LAVIN CEILING AREAS, REPLACE ANY BROKEN CEILING TILE, DUE TO THIS WORK, WITH NEW TILE.
11. IF ELEMENTAL MERCURY IS FOUND IN ANY OF THE PIPE BEING REMOVED, THE CONTRACTOR SHALL STOP WORK, CONTACT THE CONTRACTING OFFICE/CDOR, WHO WILL, IN RESPONSE, ADVISE THE AREA STILL CLEAN UP. THE PIPE CONTAINING THE MERCURY SHALL REMAIN IN THE AREA FOR REMOVAL BY THE TEAM.
12. DURING DEMO OF THE CAST IRON PIPE, THE PIPE SHALL BE DISCONNECTED BY CUTTING ABOVE AND BELOW THE LEAD BY JOINT.

2. PLUMBING FLOOR PLANS INDICATE FINAL PHASE PLUMBING SYSTEMS LAYOUT UNLESS OTHERWISE INDICATED. PHASING OF PLUMBING DEMOLITION AND NEW WORK IN EXISTING BUILDINGS SHALL BE COORDINATED WITH THE RESULTS OF PIPING AND/OR RELATIONSHIP OF EQUIPMENT. EVERY EFFORT MUST BE MADE TO KEEP ALL SERVICES, DOMESTIC WATER, WASTE AND VENT, IN OPERATION IN REMODELING AREA DURING DEMOLITION AND CONSTRUCTION. ALL SHUTDOWNS MUST BE APPROVED AND COORDINATED WITH DOWNER IN ADVANCE.
3. COORDINATE ALL PIPE ROUTING AND PIPE ELEVATIONS WITH EXISTING CONDITIONS IN ADVANCE OF INSTALLATION.
4. ALL VALVES TO BE INSTALLED ARE TO BE ACCESSIBLE. PROVIDE ACCESS PANELS AS REQUIRED.
5. PROVIDE STRAINERS IMMEDIATELY UPSTREAM OF ALL BALANCING VALVES.
6. ALL TRAP ARMS TO BE CAST IRON.
7. DIELECTRIC UNIONS REQUIRED AT CONNECTIONS BETWEEN ALL DISSIMILAR METALS.
8. EXISTING VENTING TO BE REUSED.
9. ALL EXISTING VERTICAL WASTE PIPING PENETRATING FIRST FLOOR AND CONNECTING INTO WASTE LINES LOCATED WITHIN THE CRAWL SPACE AND/OR BASEMENT CEILING SHALL BE REPLACED.
10. CUT, PATCH, AND PAINT ALL EXISTING HARD SURFACES WHERE WORK HAS BEEN PERFORMED TO MATCH EXISTING ADJACENT SURFACES. WHERE WORK IS PERFORMED IN CEILING TILES, THE TILES SHALL BE REMOVED AND NEW TILES, MATCHING EXISTING, BE INSTALLED. NEW TILE.
11. IF ELEMENTAL MERCURY IS FOUND IN ANY OF THE PIPE BEING REMOVED, THE CONTRACTOR SHALL STOP WORK, CONTACT THE CONTRACTING OFFICE/CORP. WHO WILL, IN TURN, ARRANGE FOR THE AS APPROPRIATE REMEDIATION. THE CONTRACTOR SHALL REMAIN IN THE AREA FOR REMOVAL BY THE TEAM.
12. DURING DEMO OF THE CAST IRON PIPE, THE PIPE SHALL BE DISCONNECTED BY CUTTING ABOVE AND BELOW THE LEAD TO JOINT.

3. COORDINATE ALL PIPE ROUTING AND PIPE ELEVATIONS WITH EXISTING CONDITIONS IN ADVANCE OF INSTALLATION.
4. ALL VALVES TO BE INSTALLED ARE TO BE ACCESSIBLE. PROVIDE ACCESS PANELS AS REQUIRED.
5. PROVIDE STRAINERS IMMEDIATELY UPSTREAM OF ALL BALANCING VALVES.
6. ALL TRAP ARMS TO BE CAST IRON.
7. DIELECTRIC UNIONS REQUIRED AT DISSIMILAR METALS.
8. EXISTING VENTING TO BE REUSED.
9. ALL EXISTING VERTICAL WASTE PIPING PENETRATING FIRST FLOOR AND CONNECTING INTO WASTE LINES LOCATED WITHIN THE CRAWL SPACE AND/OR BASEMENT CEILING SHALL BE REPLACED.
10. CUT, PATCH, AND PAINT ALL EXISTING HARD SURFACES WHERE WORK HAS BEEN NEARBY. ALL WORK IS TO BE REPAIRED IN SUCH A MANNER AS TO BE UNNOTICABLE IN LAWN CEILING AREAS. REPLACE ANY BROKEN CEILING TILE, DUE TO THIS WORK, WITH NEW TILE.
11. IF ELEMENTAL MERCURY IS FOUND IN ANY OF THE PIPE BEING REMOVED, THE CONTRACTOR SHALL STOP WORK, CONTACT THE CONTRACTING OFFICE/CDR, WHO WILL, IN TURN, ARRANGE FOR THE VA TO CLEAN UP THE PIPE. CONTAINING THE MERCURY SHALL REMAIN IN THE AREA FOR REMOVAL BY THE TEAM.
12. DURING DEMO OF THE CAST IRON PIPE, THE PIPE SHALL BE DISCONNECTED BY CUTTING ABOVE AND BELOW THE LEAD TO JOINT.

4. ALL VALVES TO BE INSTALLED ARE TO BE ACCESSIBLE. PROVIDE ACCESS PANELS AS REQUIRED.
5. PROVIDE STRAINERS IMMEDIATELY UPSTREAM OF ALL BALANCING VALVES.
6. ALL TRAP ARMS TO BE CAST IRON.
7. DIELECTRIC UNIONS REQUIRED AT CONNECTIONS BETWEEN ALL DISSIMILAR METALS.
8. EXISTING VENTING TO BE REUSED.
9. ALL EXISTING VERTICAL WASTE PIPING PENETRATING FIRST FLOOR AND CONNECTING INTO WASTE LINES LOCATED WITHIN THE CRAWL SPACE AND/OR BASEMENT CEILING SHALL BE REPLACED.
10. CUT, PATCH, AND PAINT ALL EXISTING HARD SURFACES WHERE WORK HAS BEEN PERFORMED. DISCARD EXISTING ADJACENT SURFACES WHERE DISCARDING IS REQUIRED. LAMIN CEILING AREAS REPLACE ANY BROKEN CEILING TILE, DUE TO THIS WORK, WITH NEW TILE.
11. IF ELEMENTAL MERCURY IS FOUND IN ANY OF THE PIPE BEING REMOVED, THE CONTRACTOR SHALL STOP WORK, CONTACT THE CONTRACTING OFFICE/CORR. WHO WILL, IN TURN, ARRANGE FOR THE VA SPILL CLEAN UP. THE CONTRACTOR SHALL NOT REUSE OR USE THE PIPE CONTAINING THE MERCURY. SHALL REMAIN IN THE AREA FOR REMOVAL BY THE TEAM.
12. DURING DEMO OF THE CAST IRON PIPE, THE PIPE SHALL BE DISCONNECTED BY CUTTING ABOVE AND BELOW THE LEAD TO JOINT.

5. PROVIDE STRAINERS IMMEDIATELY UPSTREAM OF ALL BALANCING VALVES.
6. ALL TRAP ARMS TO BE CAST IRON.
7. DIELECTRIC UNIONS REQUIRED AT CONNECTIONS BETWEEN ALL DISSIMILAR METALS.
8. EXISTING VENTING TO BE REUSED.
9. ALL EXISTING VERTICAL WASTE PIPING PENETRATING FIRST FLOOR AND CONNECTING INTO WASTE LINES LOCATED WITHIN THE CRAWL SPACE AND/OR BASEMENT CEILING SHALL BE REPLACED.
10. CUT, PATCH, AND PAINT ALL EXISTING HARD SURFACES WHERE WORK HAS BEEN PERFORMED TO MATCH EXISTING ADJACENT SURFACES. WHERE WORK IS PERFORMED IN LAWN CEILING AREAS REPLACE ANY BROKEN CEILING TILE, DUE TO THIS WORK, WITH NEW TILE.
11. IF ELEMENTAL MERCURY IS FOUND IN ANY OF THE PIPE BEING REMOVED, THE CONTRACTOR SHALL STOP WORK, CONTACT THE CONTRACTING OFFICE/CDR, AND WILL, IN TURN, ARRANGE FOR THE VA SPILL RESPONSE TEAM OR THE VA IH TO CLEAN UP, THE PIPE CONTAINING THE MERCURY SHALL REMAIN IN THE AREA FOR REMOVAL BY THE TEAM.
12. DURING DEMO OF THE CAST IRON PIPE, THE PIPE SHALL BE DISCONNECTED BY CUTTING ABOVE AND BELOW THE LEAD BY JOINT.

6. ALL TRAP ARMS TO BE CAST IRON.
7. DIELECTRIC UNIONS REQUIRED AT CONNECTIONS BETWEEN ALL DISSIMILAR METALS.
8. EXISTING VENTING TO BE REUSED.
9. ALL EXISTING VERTICAL WASTE PIPING PENETRATING FIRST FLOOR AND CONNECTING INTO WASTE LINES LOCATED WITHIN THE CRAWL SPACE AND/OR BASEMENT CEILING SHALL BE REPLACED.
10. CUT, PATCH, AND PAINT ALL EXISTING HARD SURFACES WHERE WORK HAS BEEN IN PROGRESS. WHERE WORK IS NOT IN PROGRESS, PATCH AND PAINT ALL EXISTING SURFACES WHERE CHECKS IS REQUIRED IN LAIN CEILING AREAS. REPLACE ANY BROKEN CEILING TILE, DUE TO THIS WORK, WITH NEW TILE.
11. IF ELEMENTAL MERCURY IS FOUND IN ANY OF THE PIPE BEING REMOVED, THE CONTRACTOR SHALL STOP WORK, CONTACT THE CONTRACTING OFFICE/CDR, WHO WILL, IN TURN, ARRANGE FOR THE VA SULL CLEAN UP. THE PIPE CONTAINING THE MERCURY SHALL REMAIN IN THE AREA FOR REMOVAL BY THE TEAM.
12. DURING DEMO OF THE CAST IRON PIPE, THE PIPE SHALL BE DISCONNECTED BY CUTTING ABOVE AND BELOW THE LEAD BY JOINT.

8. EXISTING VENTING TO BE REMOVED.
9. ALL EXISTING VERTICAL WASTE PIPING PENETRATING FIRST FLOOR AND CONNECTING INTO WASTE LINES LOCATED WITHIN THE CRRAW SPACE AND/OR BASEMENT CEILING SHALL BE REPLACED.
10. CUT PATCH AND PAINT ALL EXISTING HARD SURFACES WHERE WORK HAS BEEN PERFORMED TO MATCH EXISTING ADJACENT SURFACES. WHERE WORK IS PERFORMED IN LAVIN CEILING AREAS REPLACE ANY BROKEN CEILING TILE, DUE TO THIS WORK, WITH NEW TILE.
11. IF ELEMENTAL MERCURY IS FOUND IN ANY OF THE PIPE BEING REMOVED, THE CONTRACTOR SHALL STOP WORK, CONTACT THE AGENCY AND AGENCY WILL INSTRUCT AND ARRANGE FOR THE VAPOR MITIGATION.
12. DURING DEMO OF THE CAST IRON PIPE, THE PIPE SHALL BE DISCONNECTED BY CUTTING ABOVE AND BELOW THE LEAD BY JOINT.

8. EXISTING VENTING TO BE REUSED.
9. ALL EXISTING VERTICAL WASTE PIPING PENETRATING FIRST FLOOR AND CONNECTING INTO WASTE LINES LOCATED WITHIN THE EXISTING SPANFLOOR BASEMENT CEILING SHALL BE REPLACED.
10. CUT, PATCH AND PAINT ALL EXISTING HARD SURFACES WHERE WORK HAS BEEN PERFORMED TO MATCH EXISTING ADJACENT SURFACES. WHERE WORK IS PERFORMED IN LAWN CEILING AREAS REPLACE ANY BROKEN CEILING TILES, DUE TO THIS WORK, WITH NEW TILE.
11. IF ELEMENTAL MERCURY IS FOUND IN ANY OF THE PIPE BEING REMOVED, THE CONTRACTOR SHALL STOP WORK, CONTACT THE CONTRACTING OFFICE/CDMR, AND WILL, IN TURN, ARRANGE FOR THE VA TO SPILL RESPONSE TEAM FOR THE VA TO CLEAN UP AND CONTAINING THE MERCURY. THE TEAM SHALL REMAIN IN THE AREA FOR REMOVAL BY THE TEAM.
12. DURING DECK OF THE CAST IRON PIPE, THE PIPE SHALL BE DISCONNECTED BY CUTTING ABOVE AND BELOW THE LEADED JOINT.

9. ALL EXISTING VERTICAL WASTE PIPING PENETRATING FIRST FLOOR AND CONNECTING INTO WASTE LINES LOCATED WITHIN THE CRAWL SPACE AND/OR BASEMENT CEILING SHALL BE REPLACED.
10. CUT, PATCH, AND PAINT ALL EXISTING HARD SURFACES WHERE WORK HAS BEEN PERFORMED TO MATCH EXISTING ADJACENT SURFACES. WHERE WORK IS PERFORMED IN LAWN CEILING AREAS REPLACE ANY BROKEN CEILING TILE, DUE TO THIS WORK, WITH NEW TILE.
11. IF ELEMENTAL MERCURY IS FOUND IN ANY OF THE PIPE BEING REMOVED, THE CONTRACTOR SHALL STOP WORK, CONTACT THE CONTRACTING OFFICE/CDM, AND WILL, IN TURN, ARRANGE FOR THE VA TO SPILL RESPONSE TEAM FOR THE VA TO CLEAN UP THE MERCURY. THE CONTRACTOR SHALL REMAIN IN THE AREA FOR REMOVAL BY THE TEAM.
12. DURING DECK OF THE CAST IRON PIPE, THE PIPE SHALL BE DISCONNECTED BY CUTTING ABOVE AND BELOW THE LEADED JOINT.

10. CUT, PATCH, AND PAINT ALL EXISTING HARD SURFACES WHERE WORK HAS BEEN PERFORMED TO MATCH EXISTING ADJACENT SURFACES. WHERE WORK IS PERFORMED IN LAWN CEILING AREAS REPLACE ANY BROKEN CEILING TILE, DUE TO THIS WORK, WITH NEW TILE.
11. IF ELEMENTAL MERCURY IS FOUND IN ANY OF THE FOLLOWING REMEDIAL ACTION CONTRACTOR SHALL STOP WORK, CONTACT THE CONTRACTING OFFICER/CDR AND WILL, IN TURN, ARRANGE FOR THE VA SPILL RESPONSE TEAM OR THE VA HAZ TO CLEAN UP, THE PIPE CONTAINING THE MERCURY SHALL REMAIN IN THE AREA FOR REMOVAL BY THE TEAM.
12. DURING DEMO OF THE CAST IRON PIPE, THE PIPE SHALL BE DISCONNECTED BY CUTTING ABOVE AND BELOW THE LEAD JOINT.

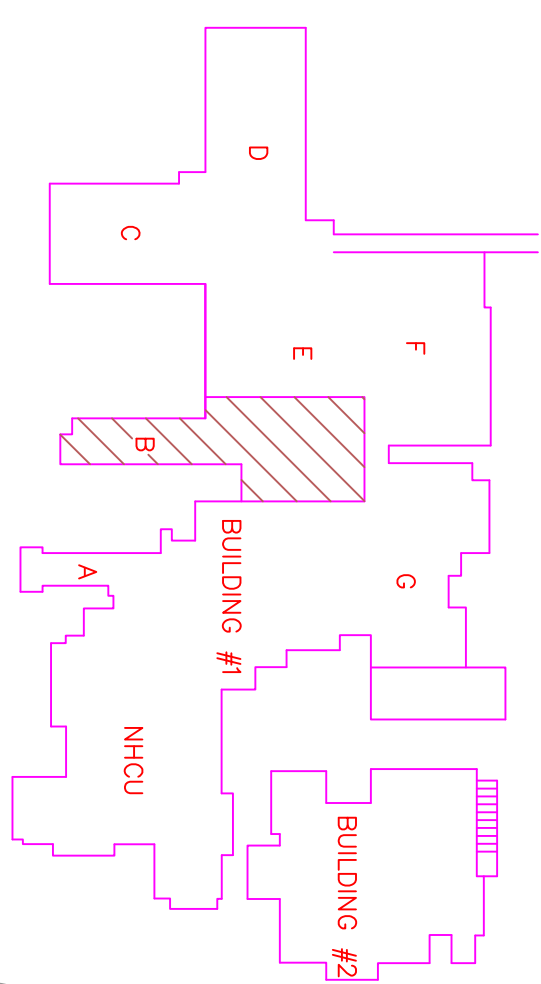
11. IF ELEMENTAL MERCURY IS FOUND IN ANY OF THE PIPE BEING REMOVED, THE CONTRACTOR SHALL STOP WORK, CONTACT THE CONTRACTING OFFICE/CDM/WHO WILL, IN TURN, ARRANGE FOR THE VA SPILL RESPONSE AND FOR THE VA HAZARDOUS WASTE UNIT TO BE NOTIFIED AND THE VA HAZARDOUS WASTE UNIT SHALL REMAIN IN THE AREA FOR REMOVAL BY THE TEAM.
12. DURING DEMO OF THE CAST IRON PIPE, THE PIPE SHALL BE DISCONNECTED BY CUTTING ABOVE AND BELOW THE LEAD JOINT.

12. DURING DEMO OF THE CAST IRON PIPE, THE PIPE SHALL BE DISCONNECTED BY CUTTING ABOVE AND BELOW THE LEADED JOINT.

THIS AREA IS "CORE JOB" AND INCLUDES CONNECTION OF DRAINS FROM FIRST FLOOR PLUMBING FIXTURES TO NEW WASTE LINES.

Westlake Reed One East Camelback Road
Suite 690, Phoenix, Arizona 85012
602.212.0451
www.WRldesign.com

Reed
602.212.0451
www.WRLdesign.com

Leskosky www.WRLdesign.com

△	Date	Revision
	05/23/05	35% SUBMITTAL
	06/13/05	65% SUBMITTAL
	08/01/05	100% SUBMITTAL
	08/08/08	AS-BUILT DRAWINGS

Approved: Asst. Admin.
Engineering Service

Approved:

Approved:

P-101-BB

SHEET 11 OF 19



Department of
Veterans Affairs



ARCHITECT OF RECORD:



1001 N. Alvernon Way, Tucson, Arizona 85711
Tel: 520-620-0255 Fax: 520-620-0535 Email: sbb1@sbb1.biz

BUILDING 1
REPLACE DOMESTIC WATER LINES
AND SEWER DRAIN LINES - PH 1
CARL T. HAYDEN VA MEDICAL CENTER
PHOENIX, ARIZONA

Approved: VA Proj. Mgr

V.A. PROJECT NO:644-05-118
SBEL PROJECT NO: 05049.00
DRAWN BY: MK/JRU
CHECKED BY: RD
DATE: 08/01/05