

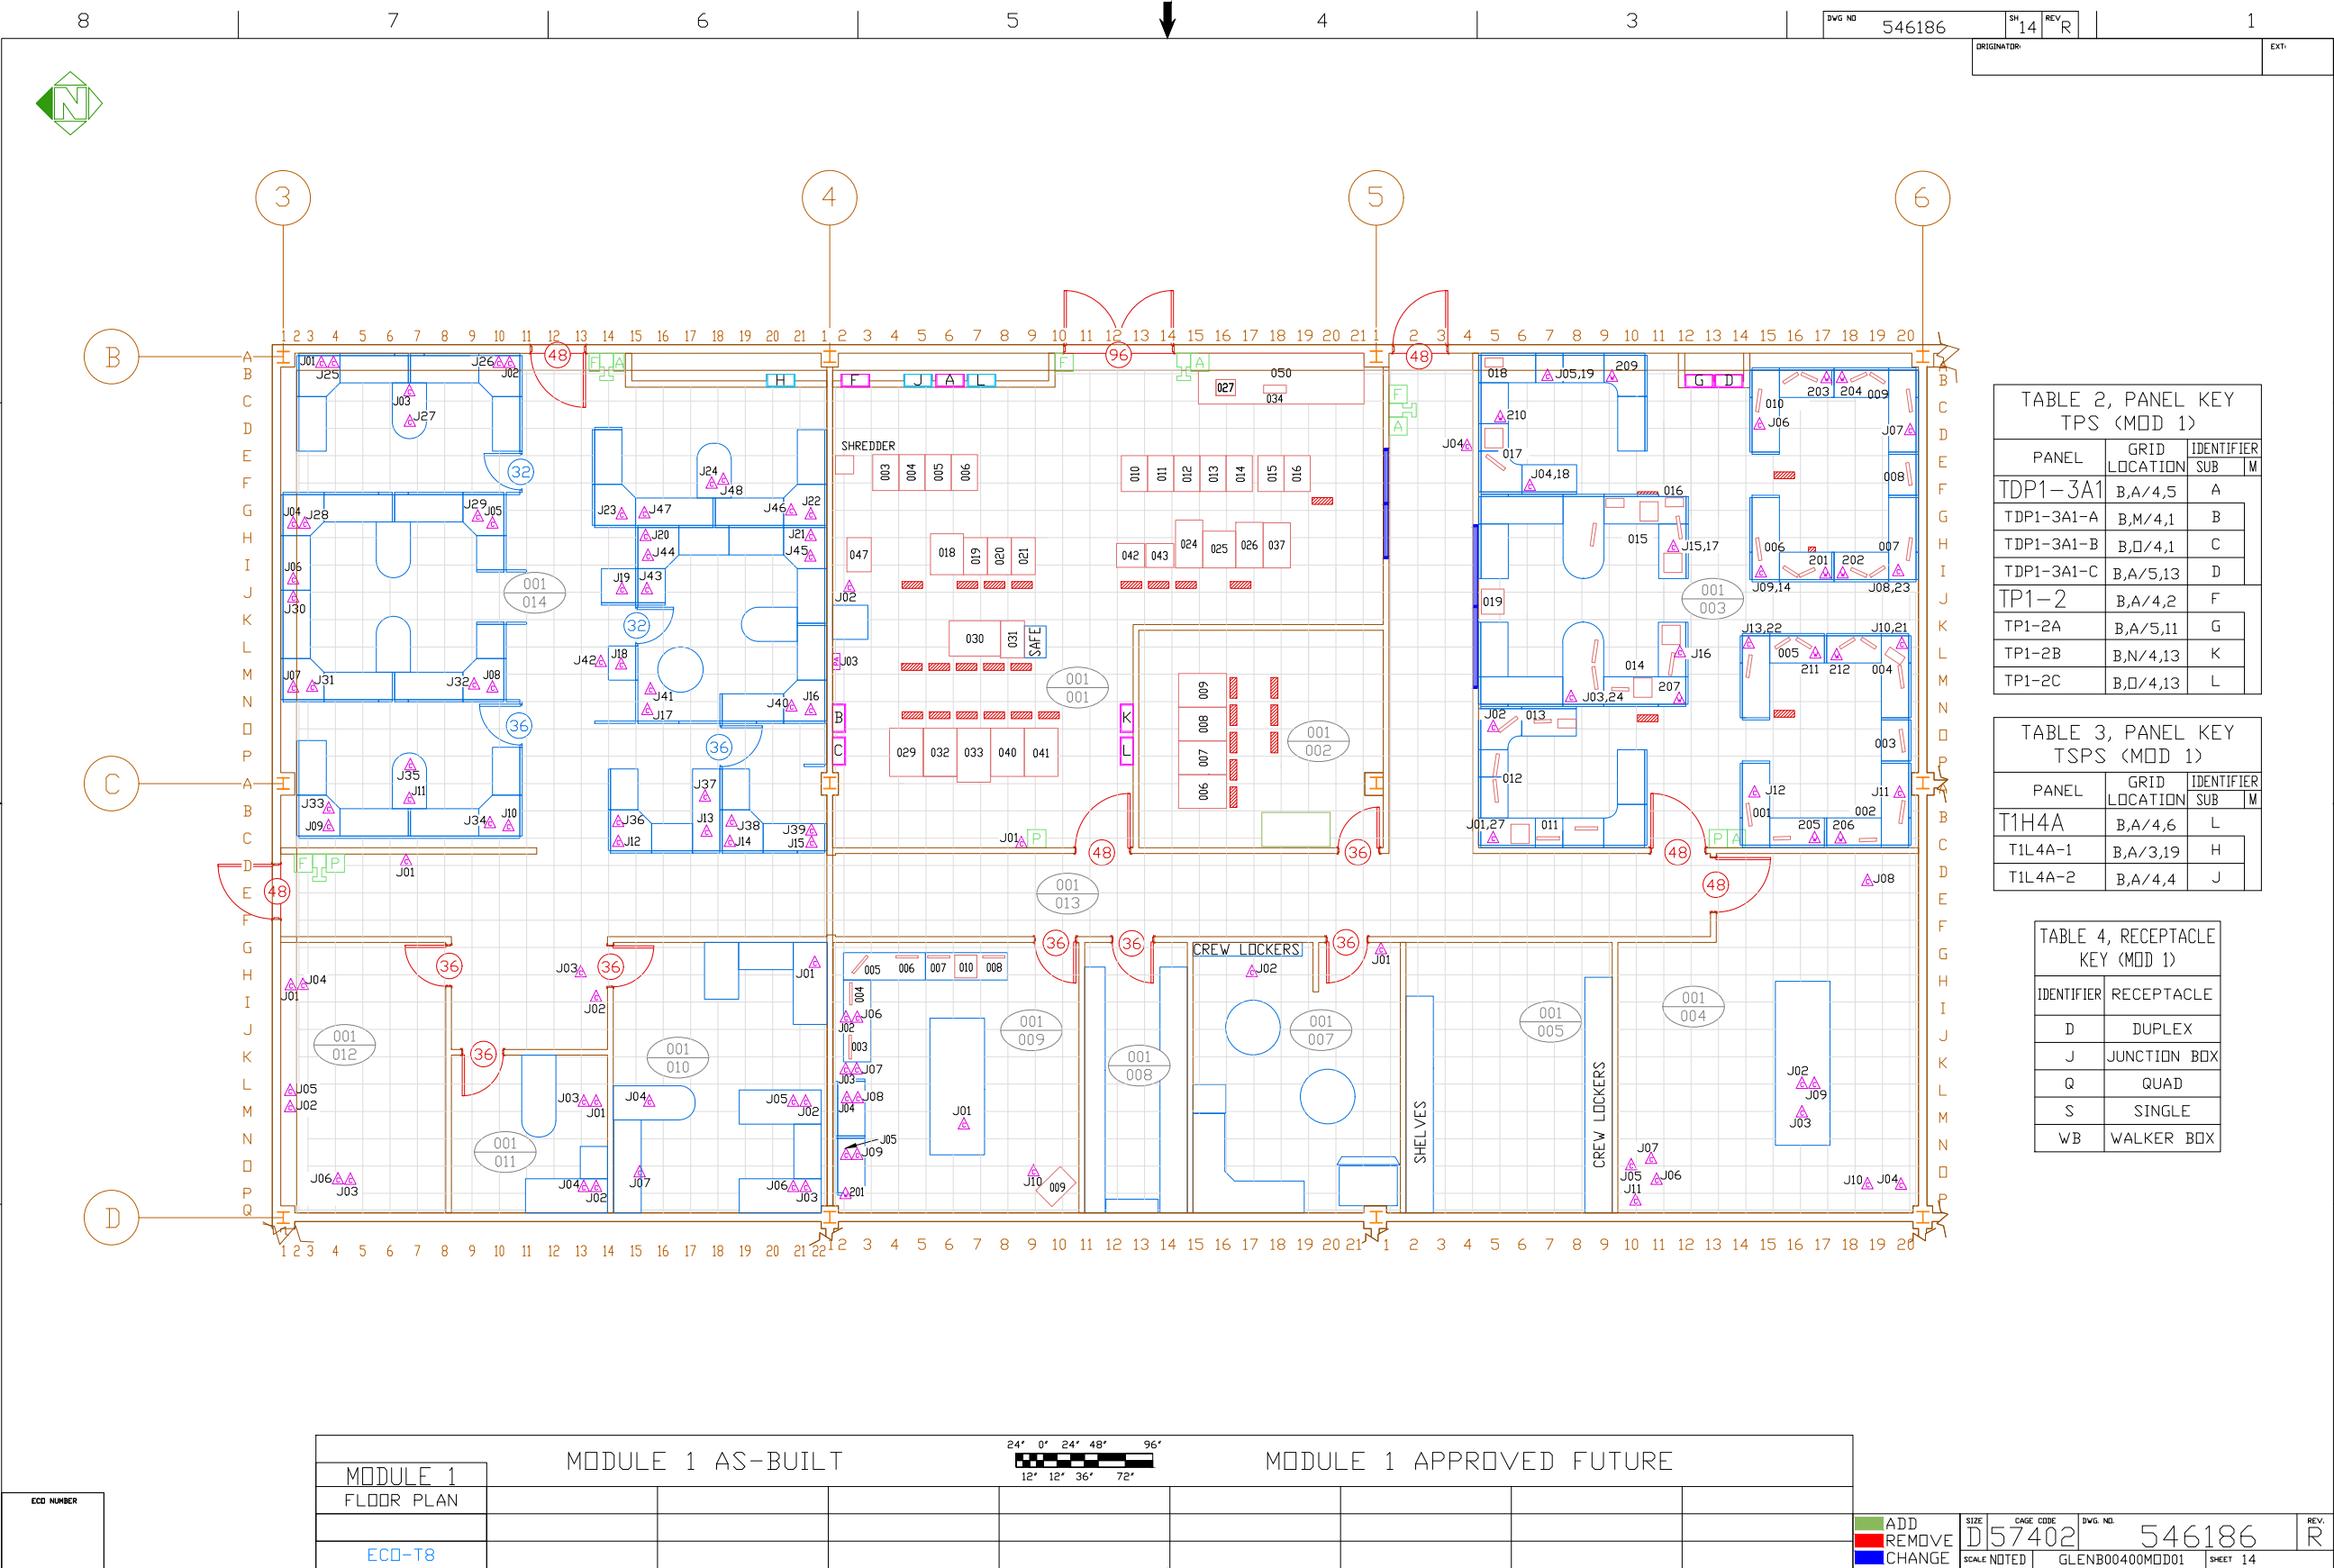


TABLE 2, PANEL KEY TPS (MOD 1)			
PANEL	GRID LOCATION	IDENTIFIER	
		SUB	M
TDP1-3A1	B,A/4,5	A	
TDP1-3A1-A	B,M/4,1	B	
TDP1-3A1-B	B,D/4,1	C	
TDP1-3A1-C	B,A/5,13	D	
TP1-2	B,A/4,2	F	
TP1-2A	B,A/5,11	G	
TP1-2B	B,N/4,13	K	
TP1-2C	B,D/4,13	L	

TABLE 3, PANEL KEY TSPS (MOD 1)			
PANEL	GRID LOCATION	IDENTIFIER	
		SUB	M
T1H4A	B,A/4,6	L	
T1L4A-1	B,A/3,19	H	
T1L4A-2	B,A/4,4	J	

TABLE 4, RECEPTACLE KEY (MOD 1)	
IDENTIFIER	RECEPTACLE
D	DUPLEX
J	JUNCTION BOX
Q	QUAD
S	SINGLE
WB	WALKER BOX

DISTRIBUTION F: FURTHER DISSEMINATION ONLY AS DIRECTED BY:
S0SCS/SPC, SCHRIEVER AFB CD 80912 OR HIGHER DOD AUTHORITY; DCT 02

MODULE 1 AS-BUILT		MODULE 1 APPROVED FUTURE	
MODULE 1 FLOOR PLAN			
ECD-T8			

ADD	SIZE	CAGE CODE	DWG. NO.	REV.
REMOVE	D57402		546186	R
CHANGE	SCALE NOTED	GLENB00400MOD01	SHEET 14	

DESTRUCTION NOTICE- FOR CLASSIFIED DOCUMENTS, FOLLOW THE PROCEDURES IN DOD 5220.22-M, INDUSTRIAL SECURITY MANUAL, SECTION 11-19, OR DOD 5200.1-R, INFORMATION SECURITY PROGRAM REGULATION, CHAPTER IX.

DESTRUCTION NOTICE- FOR UNCLASSIFIED, LIMITED DOCUMENTS, DESTROY BY ANY METHOD THAT WILL PREVENT DISCLOSURE OR RECONSTRUCTION OF THE DOCUMENT.

WARNING, EXPORT-CONTROLLED

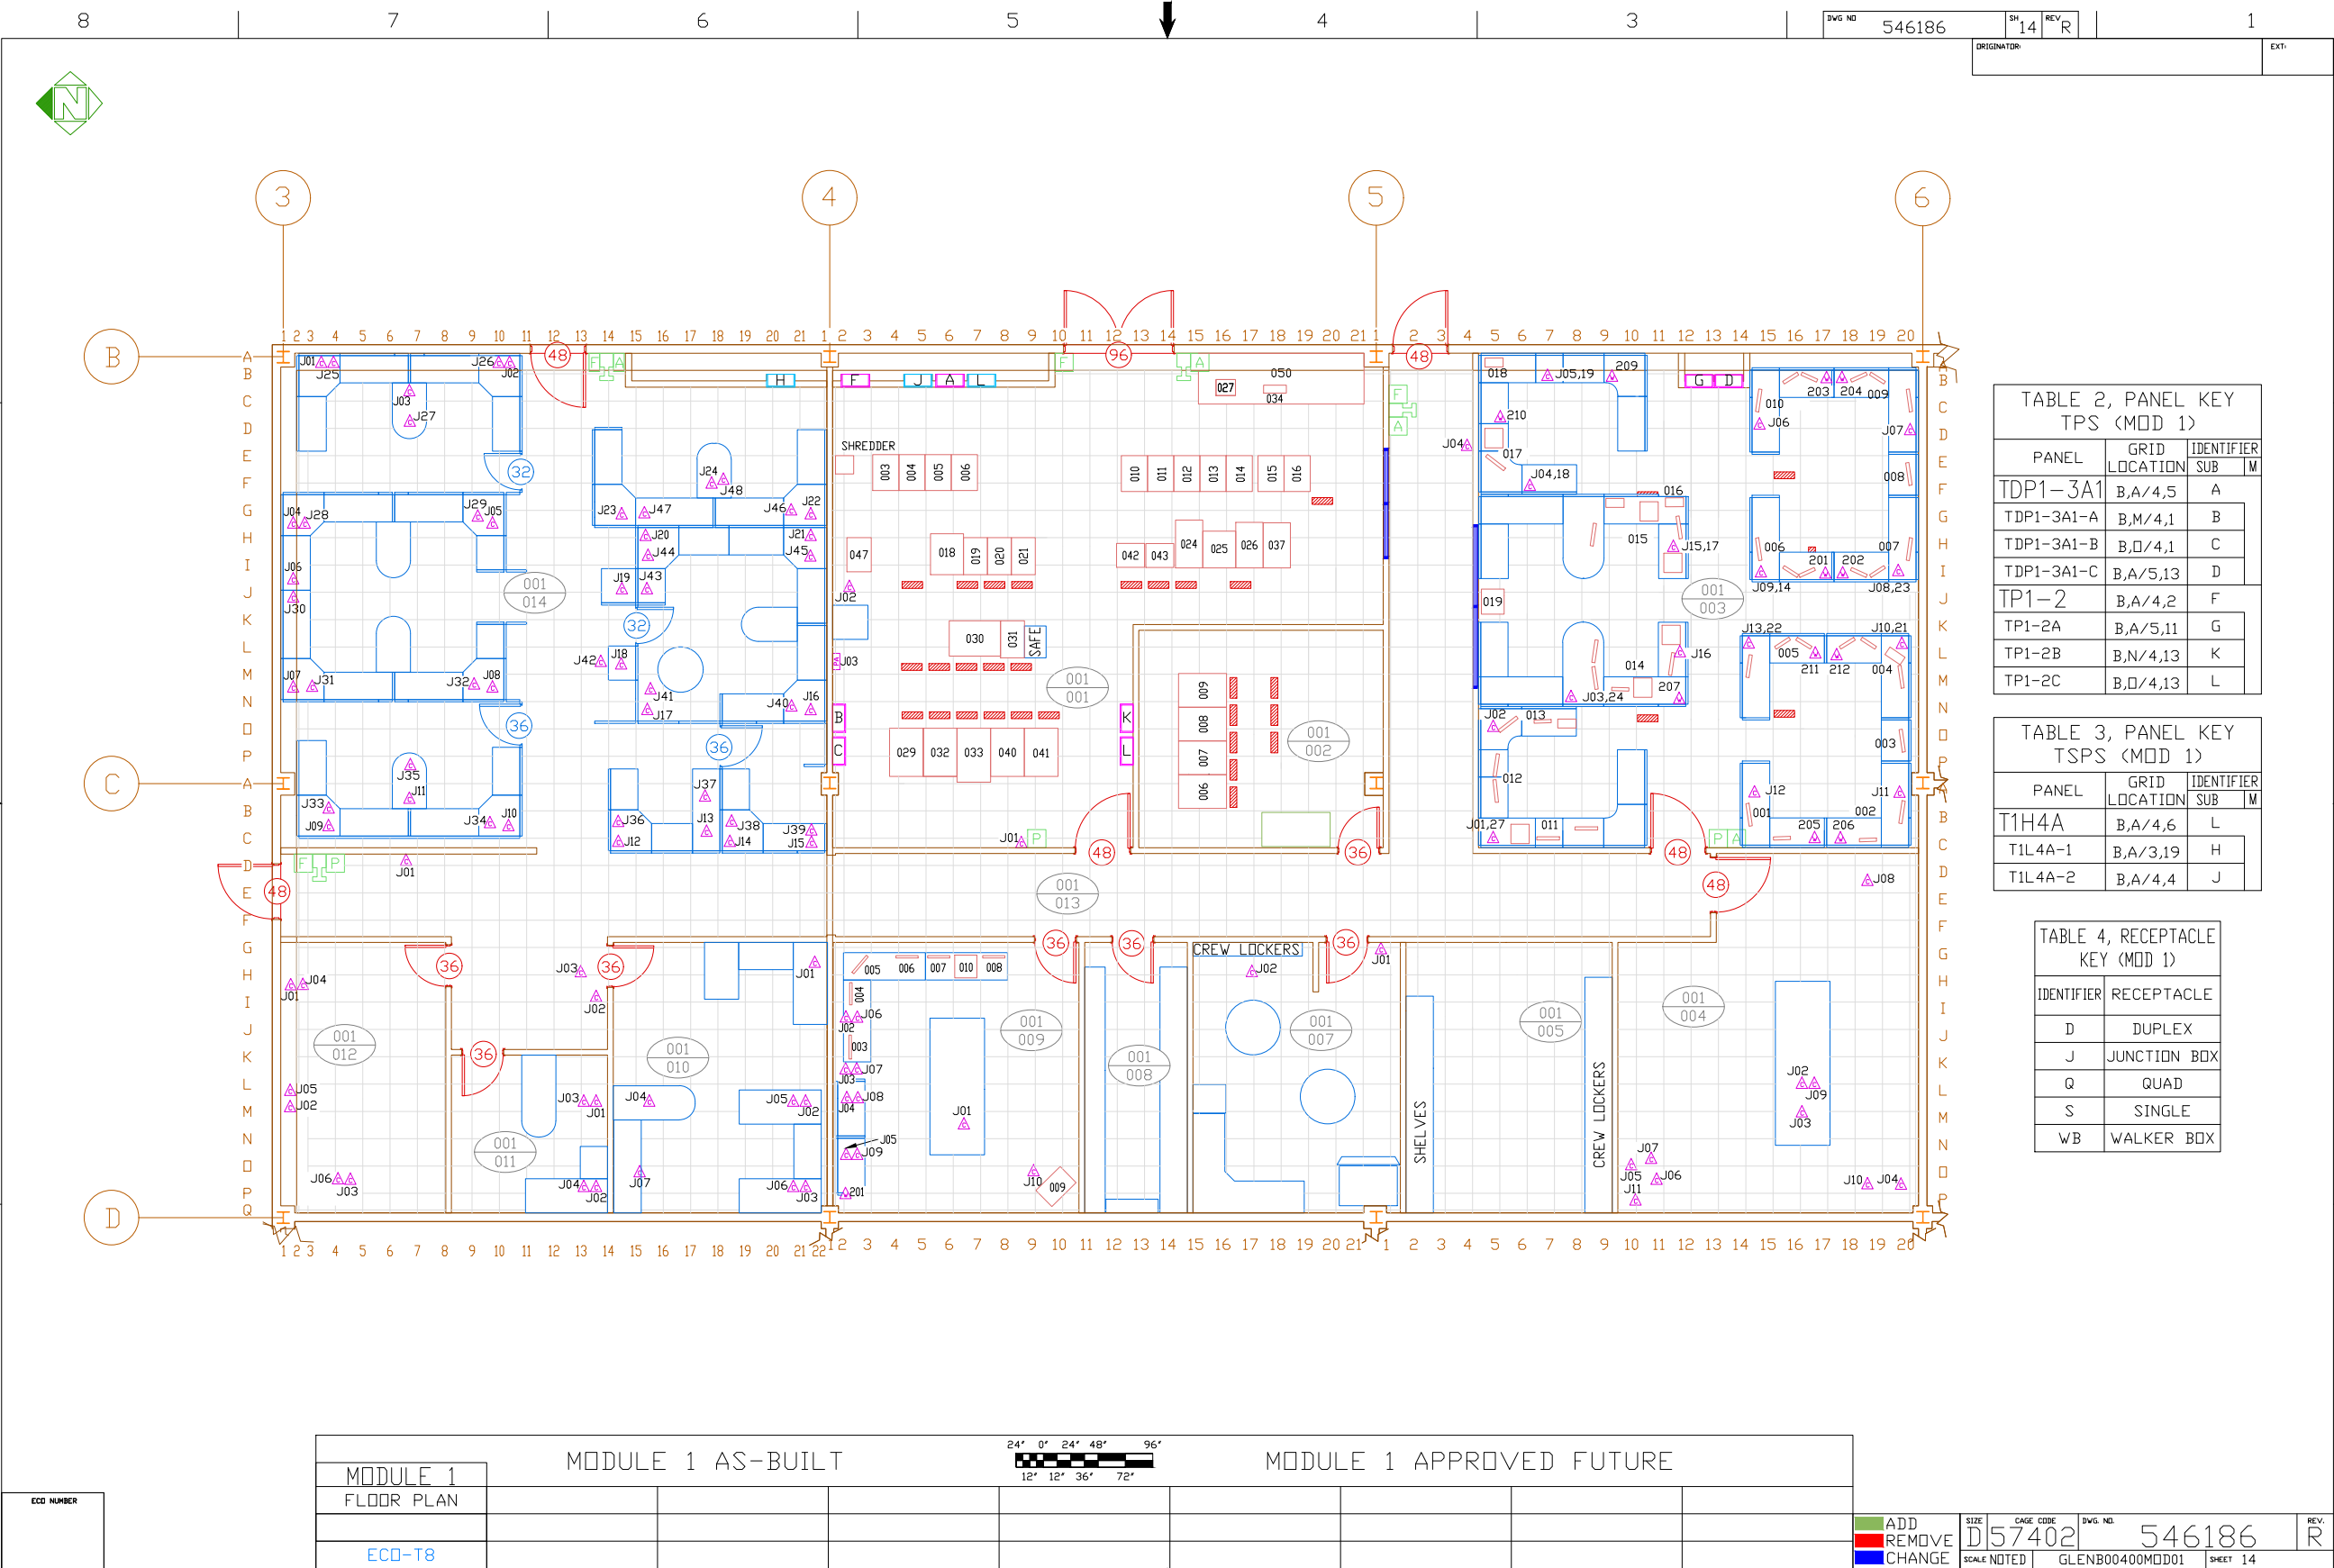


TABLE 2, PANEL KEY TPS (MOD 1)			
PANEL	GRID LOCATION	IDENTIFIER	
		SUB	M
TDP1-3A1	B,A/4,5	A	
TDP1-3A1-A	B,M/4,1	B	
TDP1-3A1-B	B,D/4,1	C	
TDP1-3A1-C	B,A/5,13	D	
TP1-2	B,A/4,2	F	
TP1-2A	B,A/5,11	G	
TP1-2B	B,N/4,13	K	
TP1-2C	B,D/4,13	L	

TABLE 3, PANEL KEY TSPS (MOD 1)			
PANEL	GRID LOCATION	IDENTIFIER	
		SUB	M
T1H4A	B,A/4,6	L	
T1L4A-1	B,A/3,19	H	
T1L4A-2	B,A/4,4	J	

TABLE 4, RECEPTACLE KEY (MOD 1)	
IDENTIFIER	RECEPTACLE
D	DUPLEX
J	JUNCTION BOX
Q	QUAD
S	SINGLE
WB	WALKER BOX

DISTRIBUTION F: FURTHER DISSEMINATION ONLY AS DIRECTED BY:
S0SCS/SPC, SCHRIEVER AFB CD 80912 OR HIGHER DOD AUTHORITY; DCT 02

MODULE 1 AS-BUILT		MODULE 1 APPROVED FUTURE	
MODULE 1 FLOOR PLAN			
ECD-T8			

ADD	SIZE	CAGE CODE	DWG. NO.	REV.
REMOVE	D57402		546186	R
CHANGE	SCALE NOTED	GLENB00400MOD01	SHEET 14	

DESTRUCTION NOTICE- FOR CLASSIFIED DOCUMENTS, FOLLOW THE PROCEDURES IN DOD 5220.22-M, INDUSTRIAL SECURITY MANUAL, SECTION 11-19, OR DOD 5200.1-R, INFORMATION SECURITY PROGRAM REGULATION, CHAPTER IX.

DESTRUCTION NOTICE- FOR UNCLASSIFIED, LIMITED DOCUMENTS, DESTROY BY ANY METHOD THAT WILL PREVENT DISCLOSURE OR RECONSTRUCTION OF THE DOCUMENT.

WARNING, EXPORT-CONTROLLED