




BASEMENT
1/8" = 1'-0"

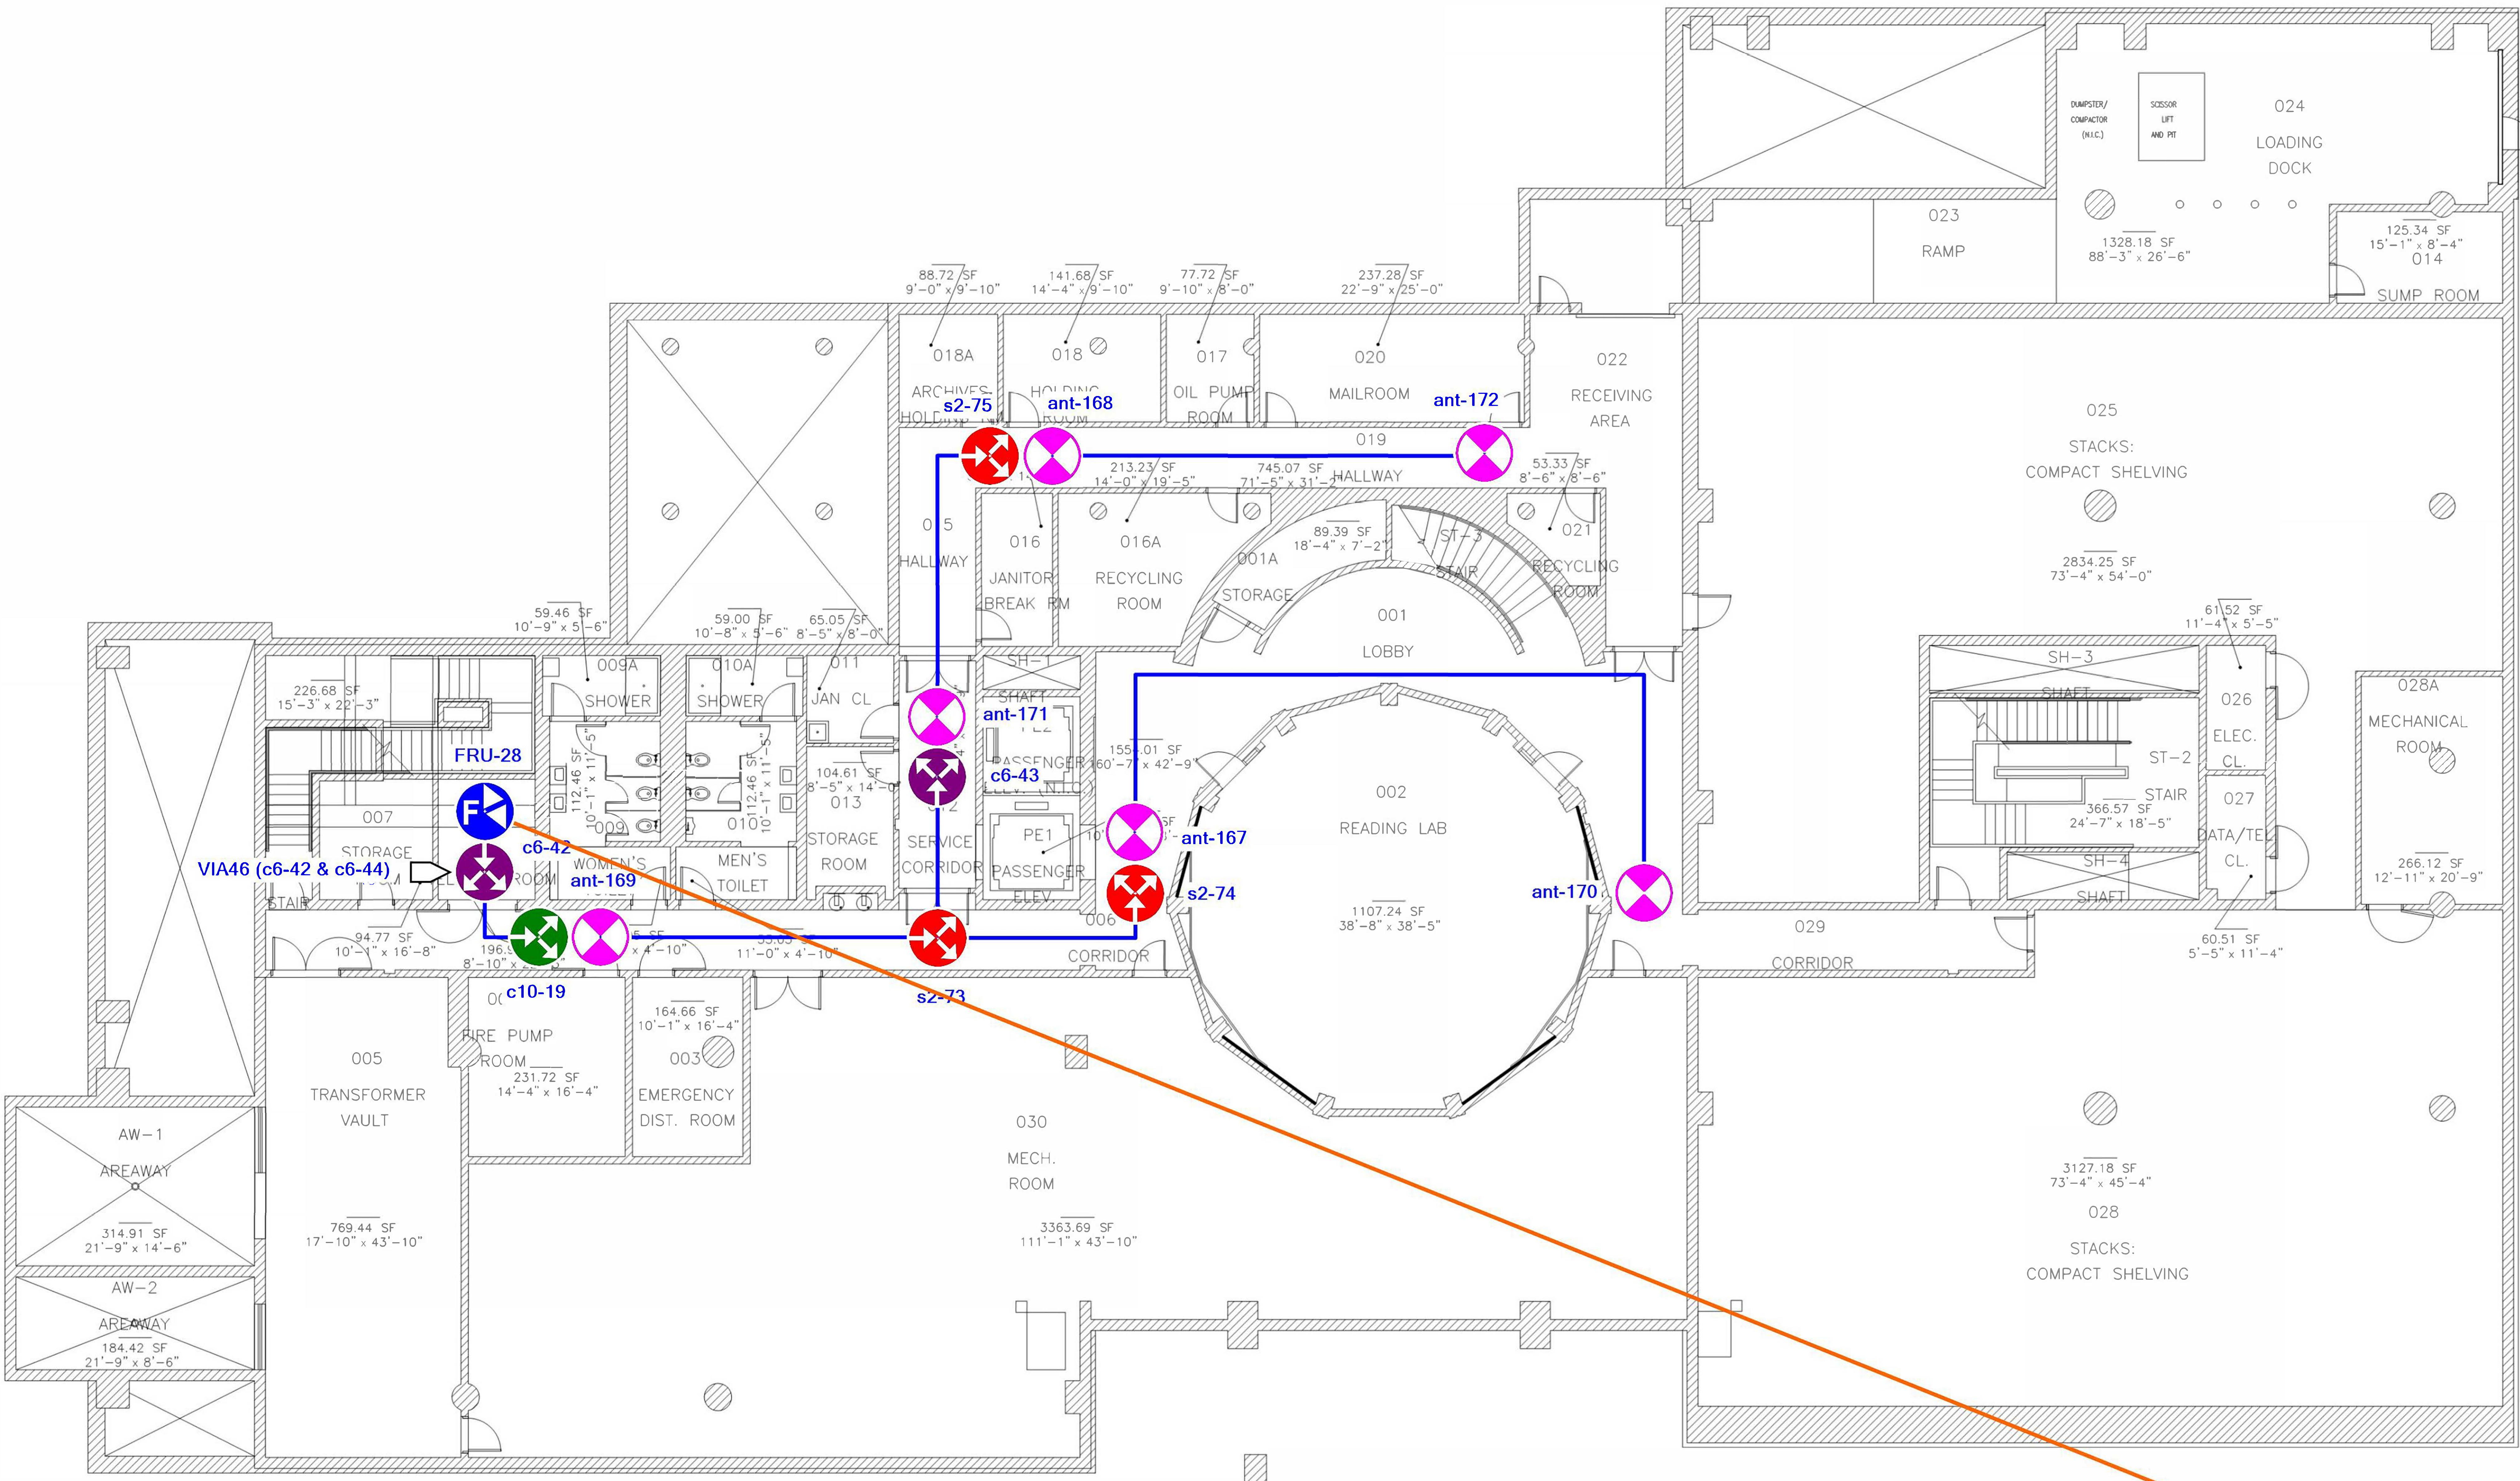

0 25 50
feet

Indoor prediction legend


Pictograms legend

- 1/2" Coax
- Antenna
- 2-Way Splitter
- 3-Way Splitter
- 4-Way Splitter
- 6dB Coupler
- 10dB Coupler
- Remote Unit

Project name
United States Military Academy West Point

Designer name

Jefferson Hall - Basement

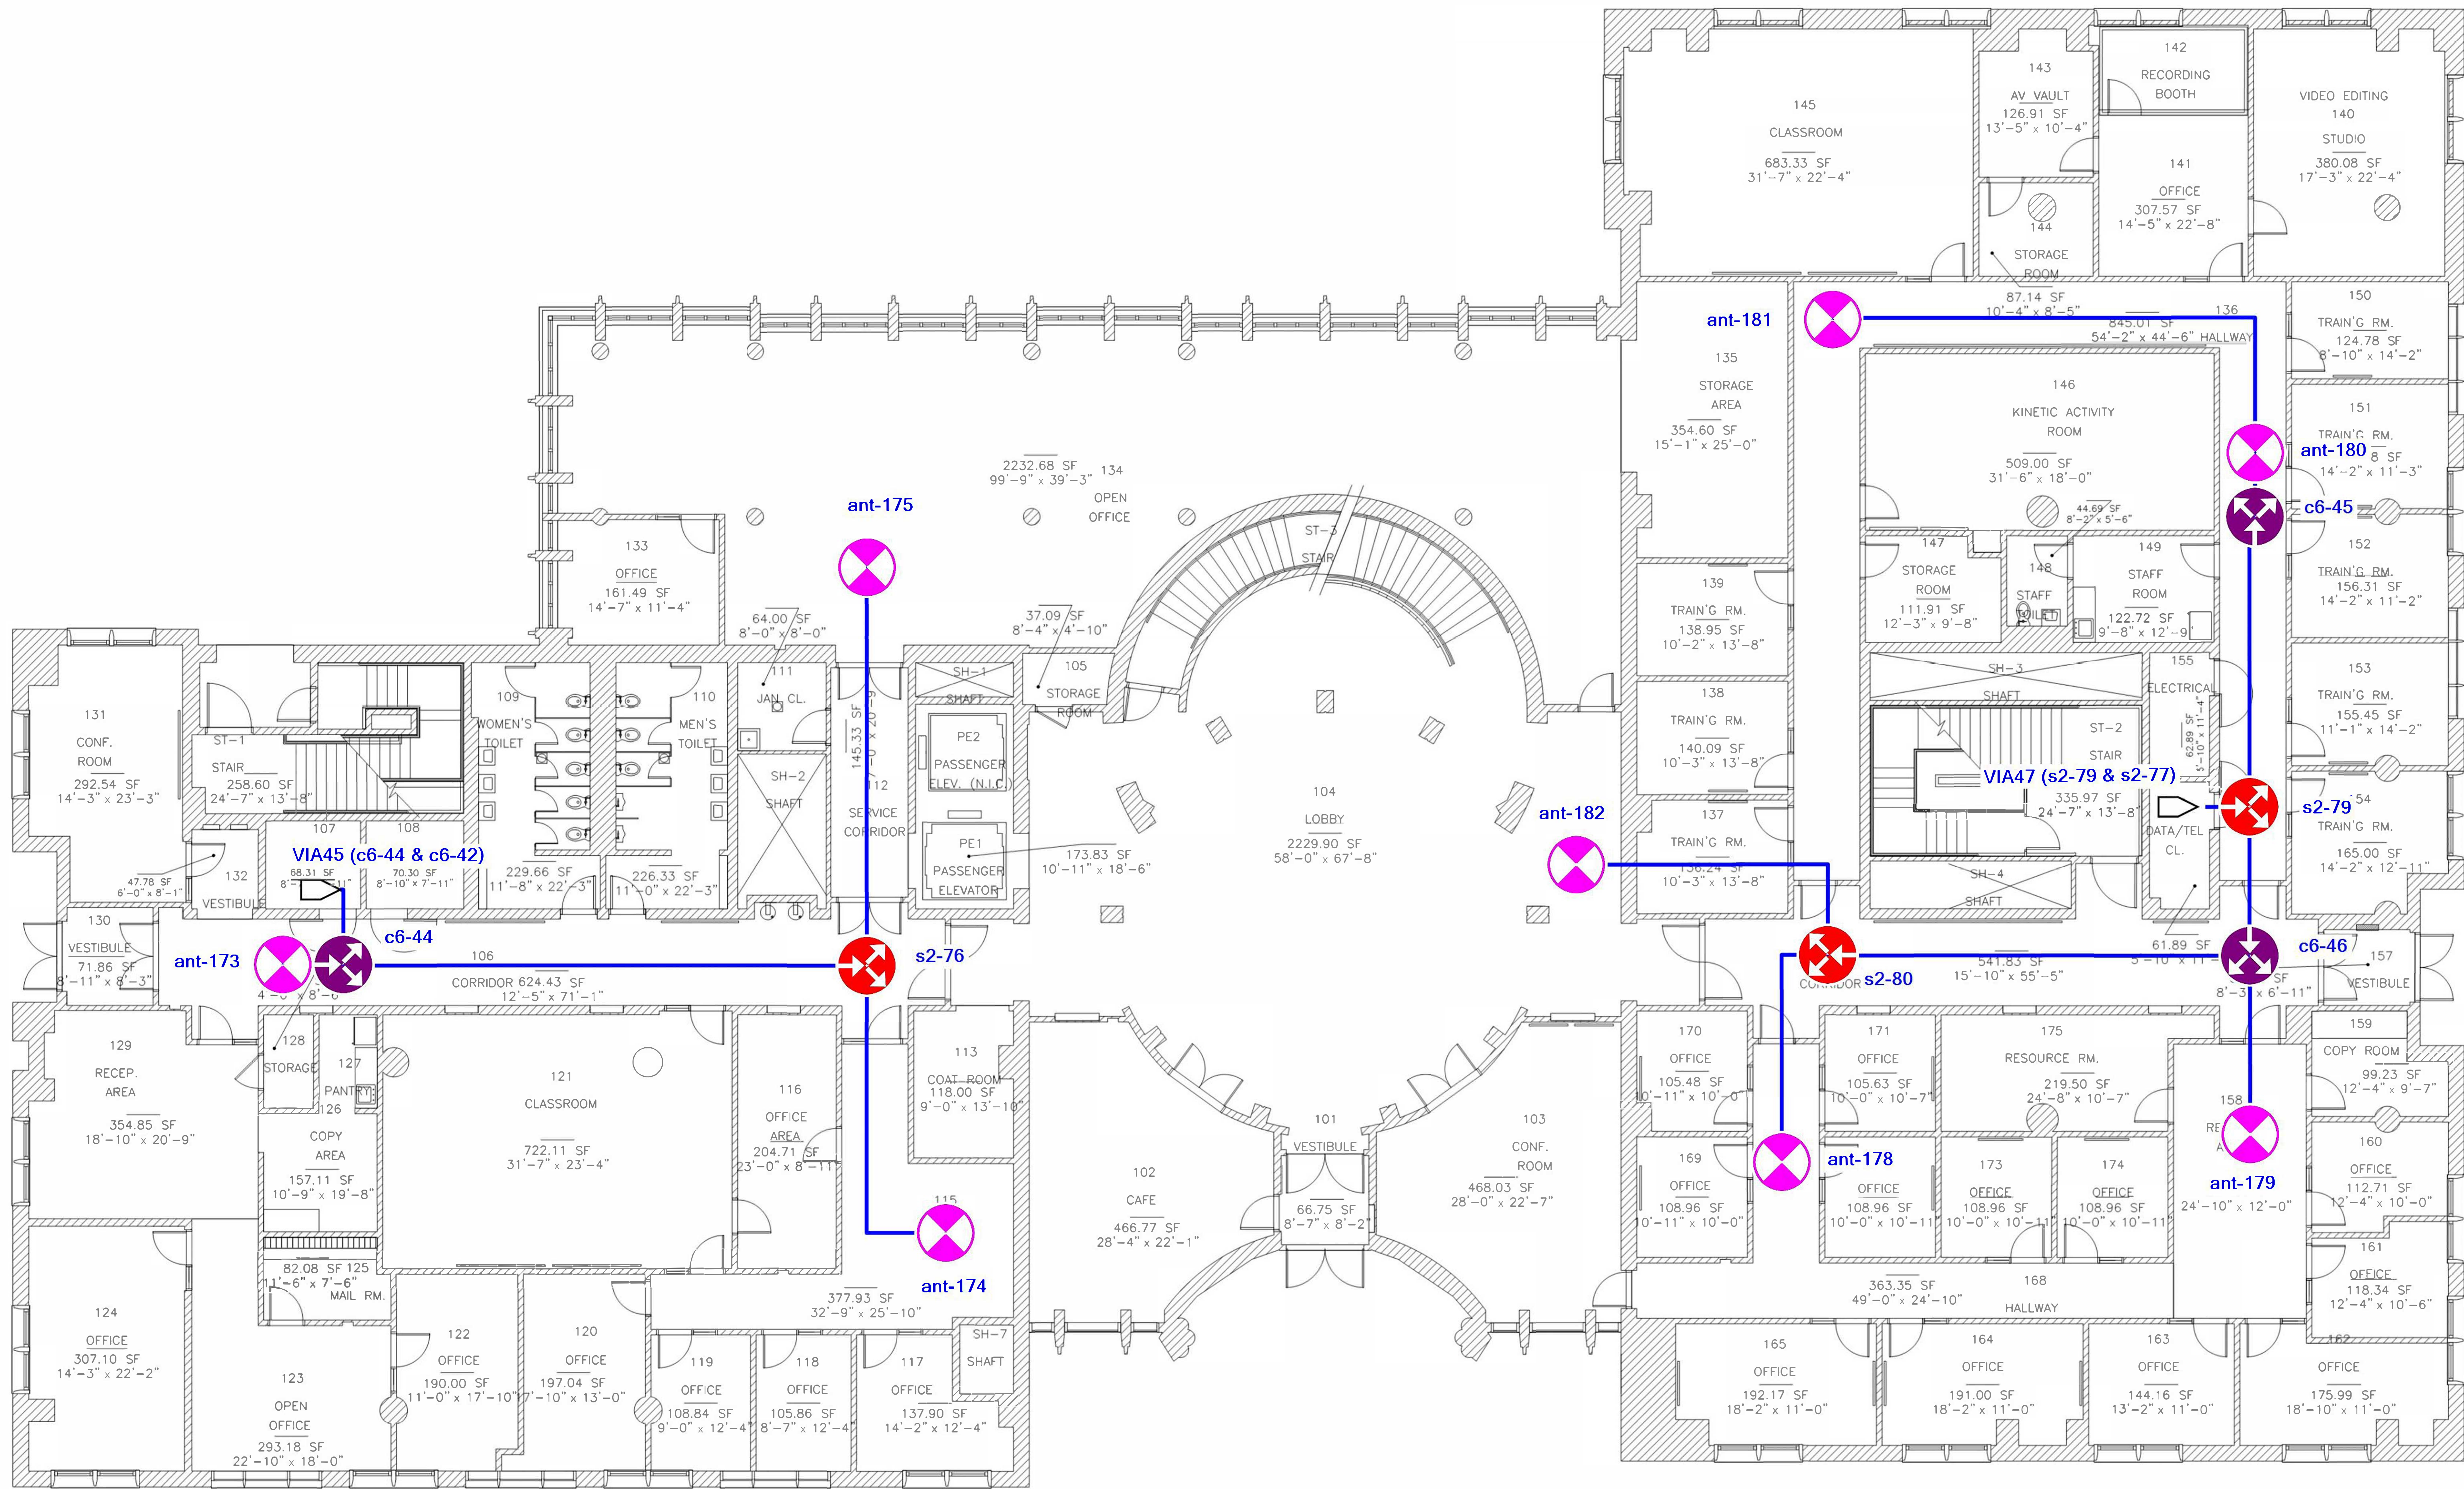

FIRST FLOOR
1/8" = 1'-0"



0

25

50

feet

Indoor prediction legend

Pictograms legend



- 1/2" Coax
- Antenna
- 2-Way Splitter
- 3-Way Splitter
- 4-Way Splitter
- 6dB Coupler
- 10dB Coupler
- Remote Unit

Project name

United States Military Academy West Point

Designer name

Jefferson Hall - First Floor

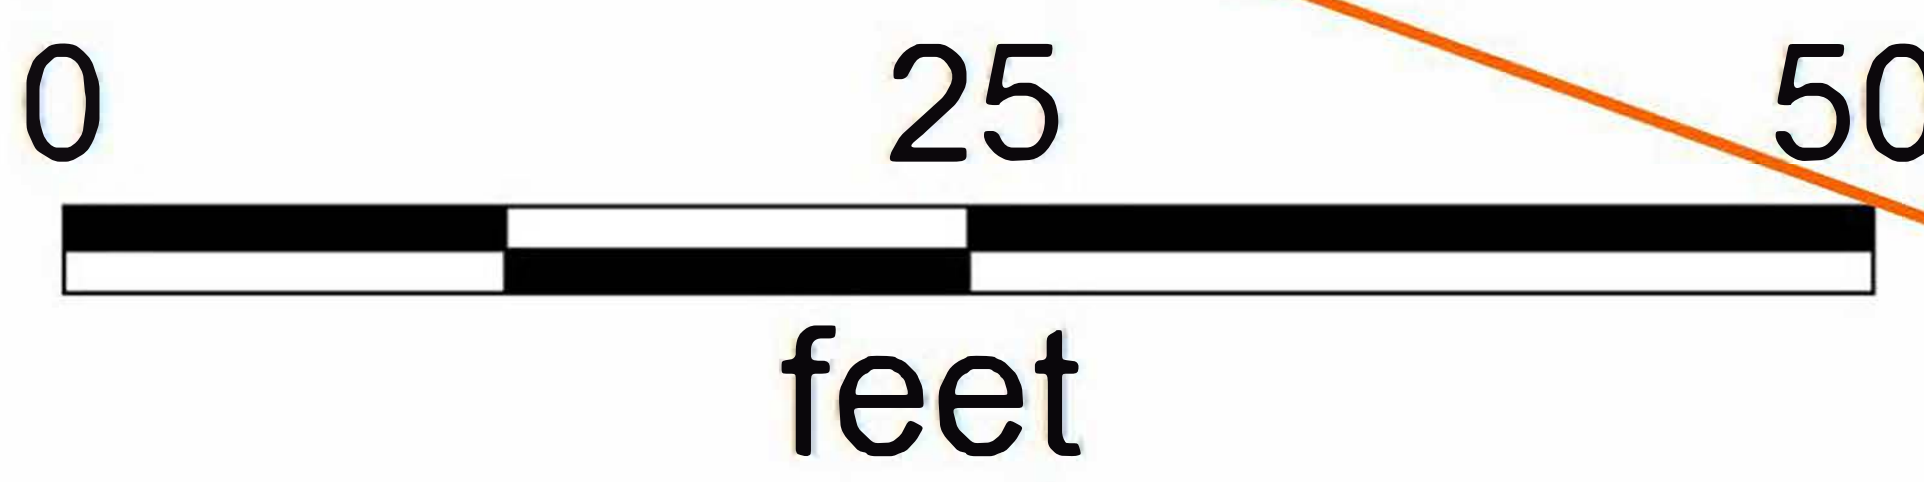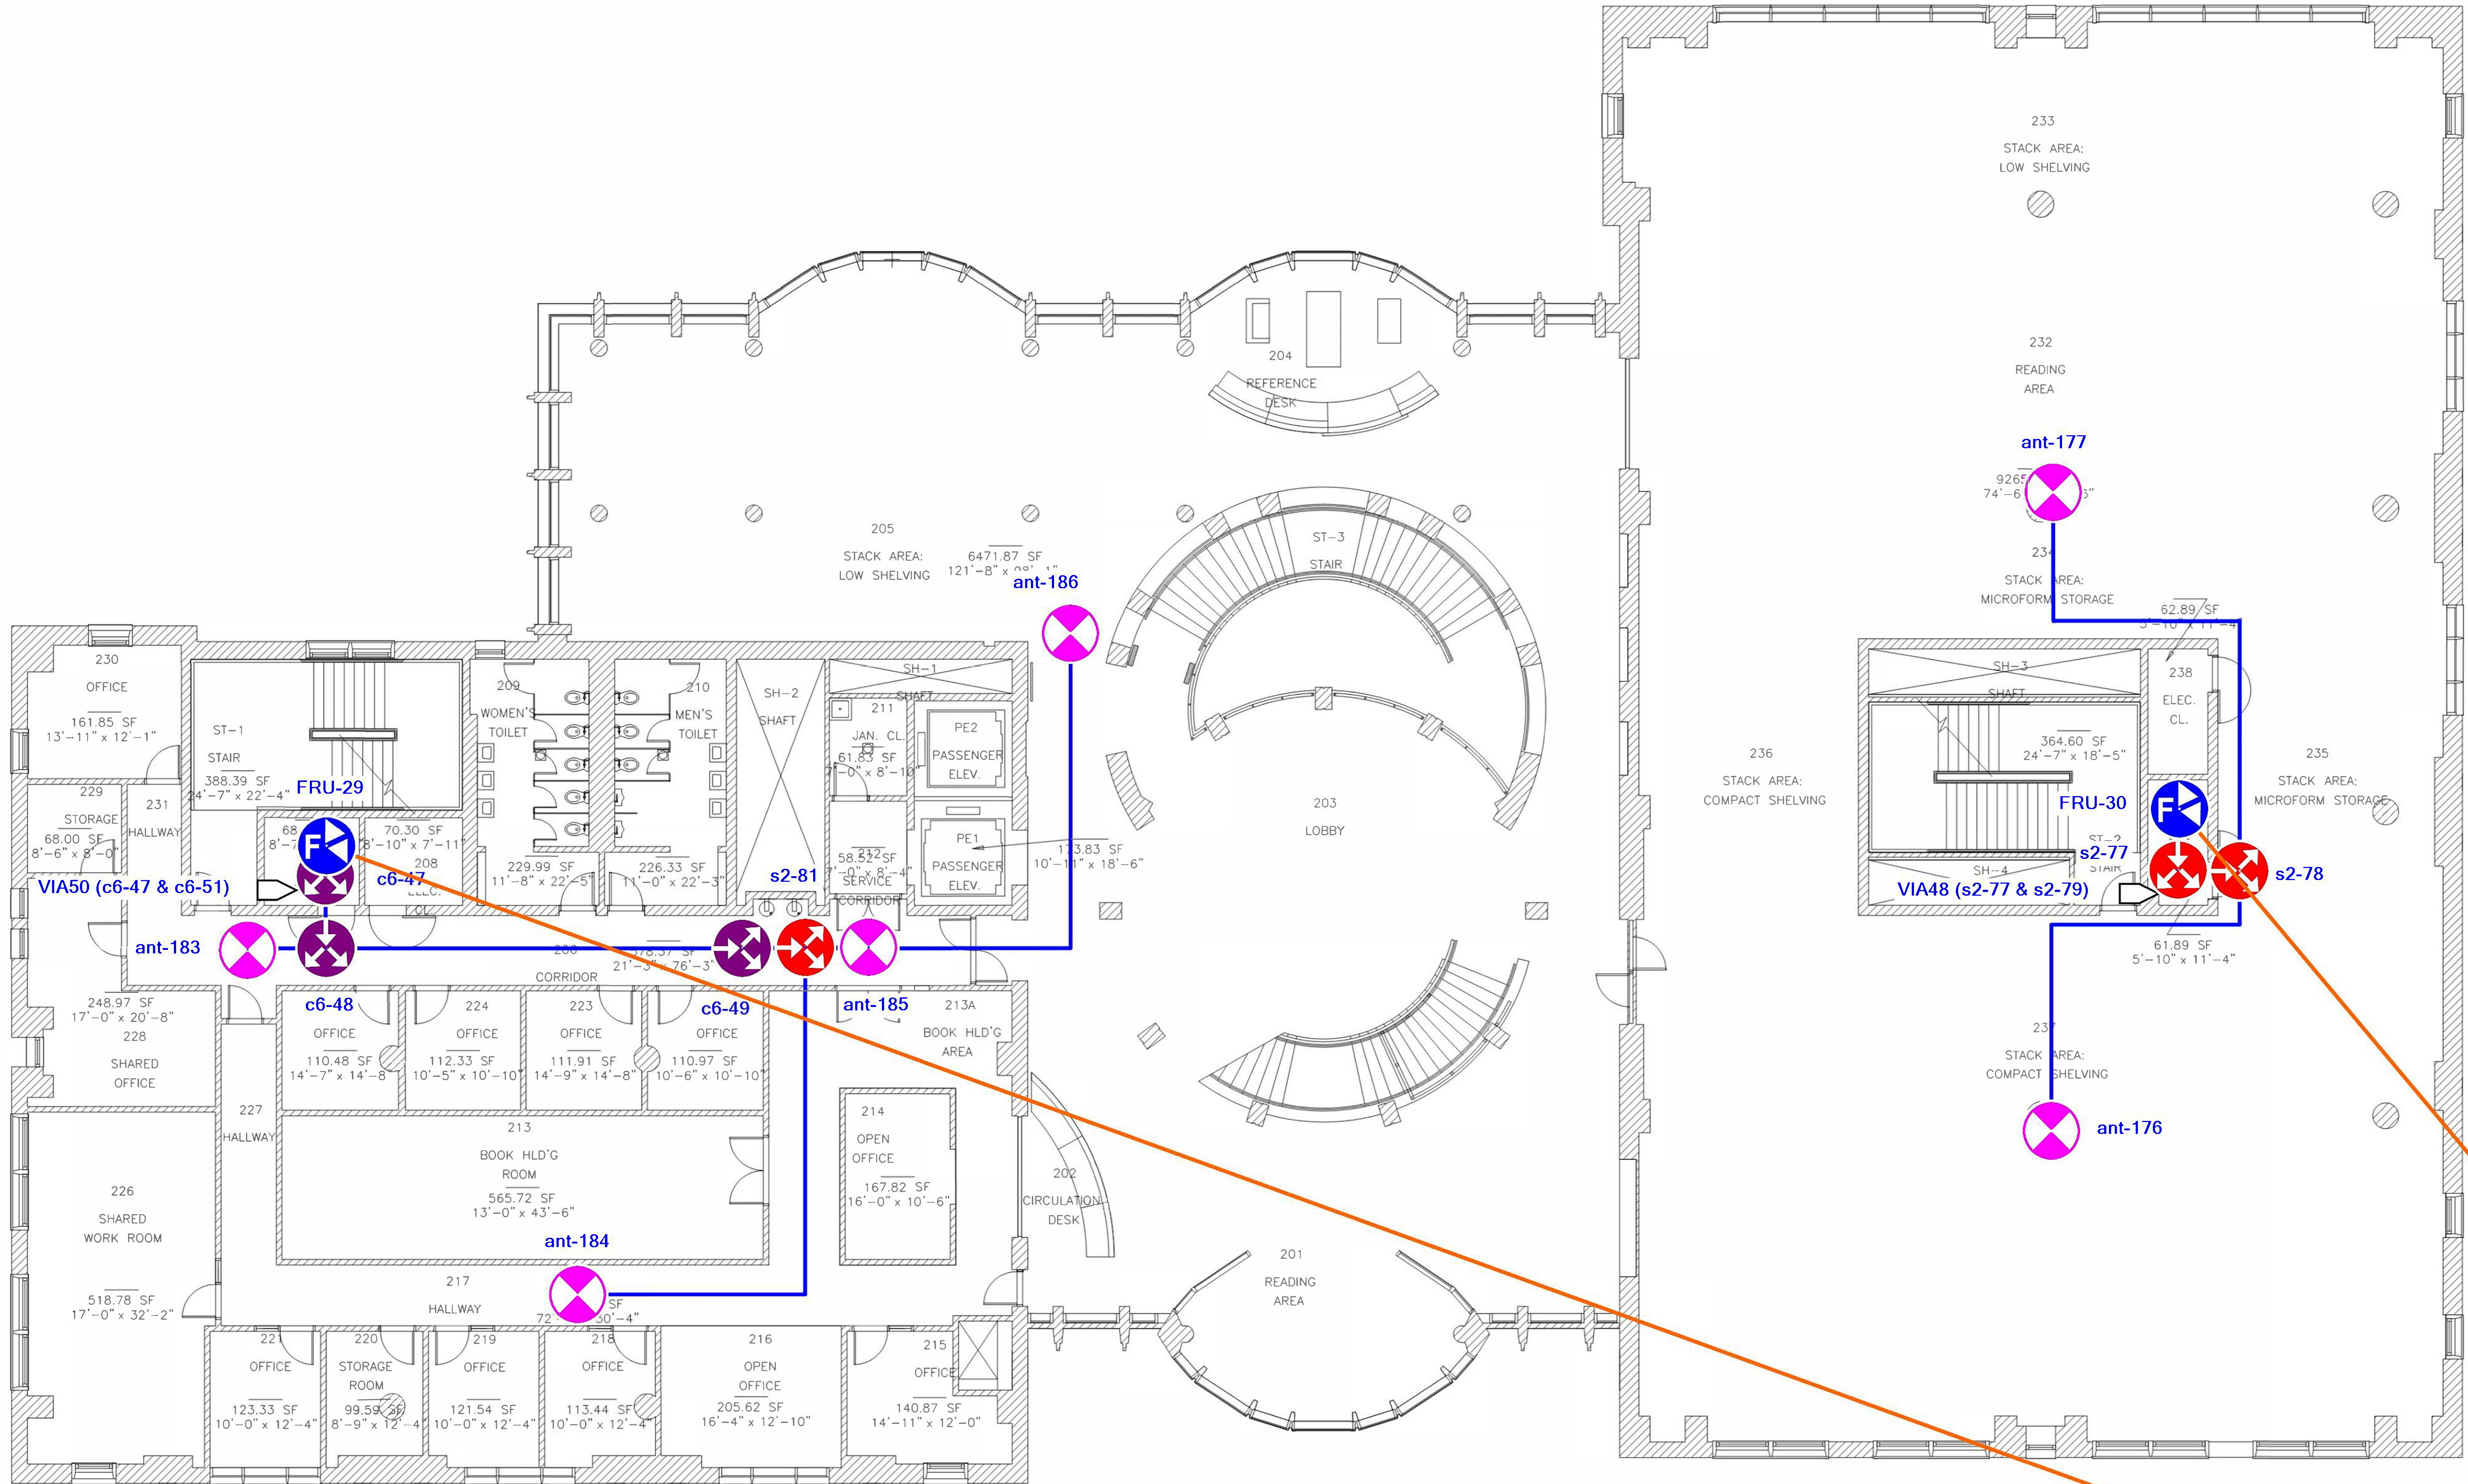

SECOND FLOOR
1/8" = 1'-0"

Indoor prediction legend

Pictograms legend


- 1/2" Coax
- Antenna
- 2-Way Splitter
- 3-Way Splitter
- 4-Way Splitter
- 6dB Coupler
- 10dB Coupler
- Remote Unit

Project name

United States Military Academy West Point

Designer name

Jefferson Hall - Second Floor

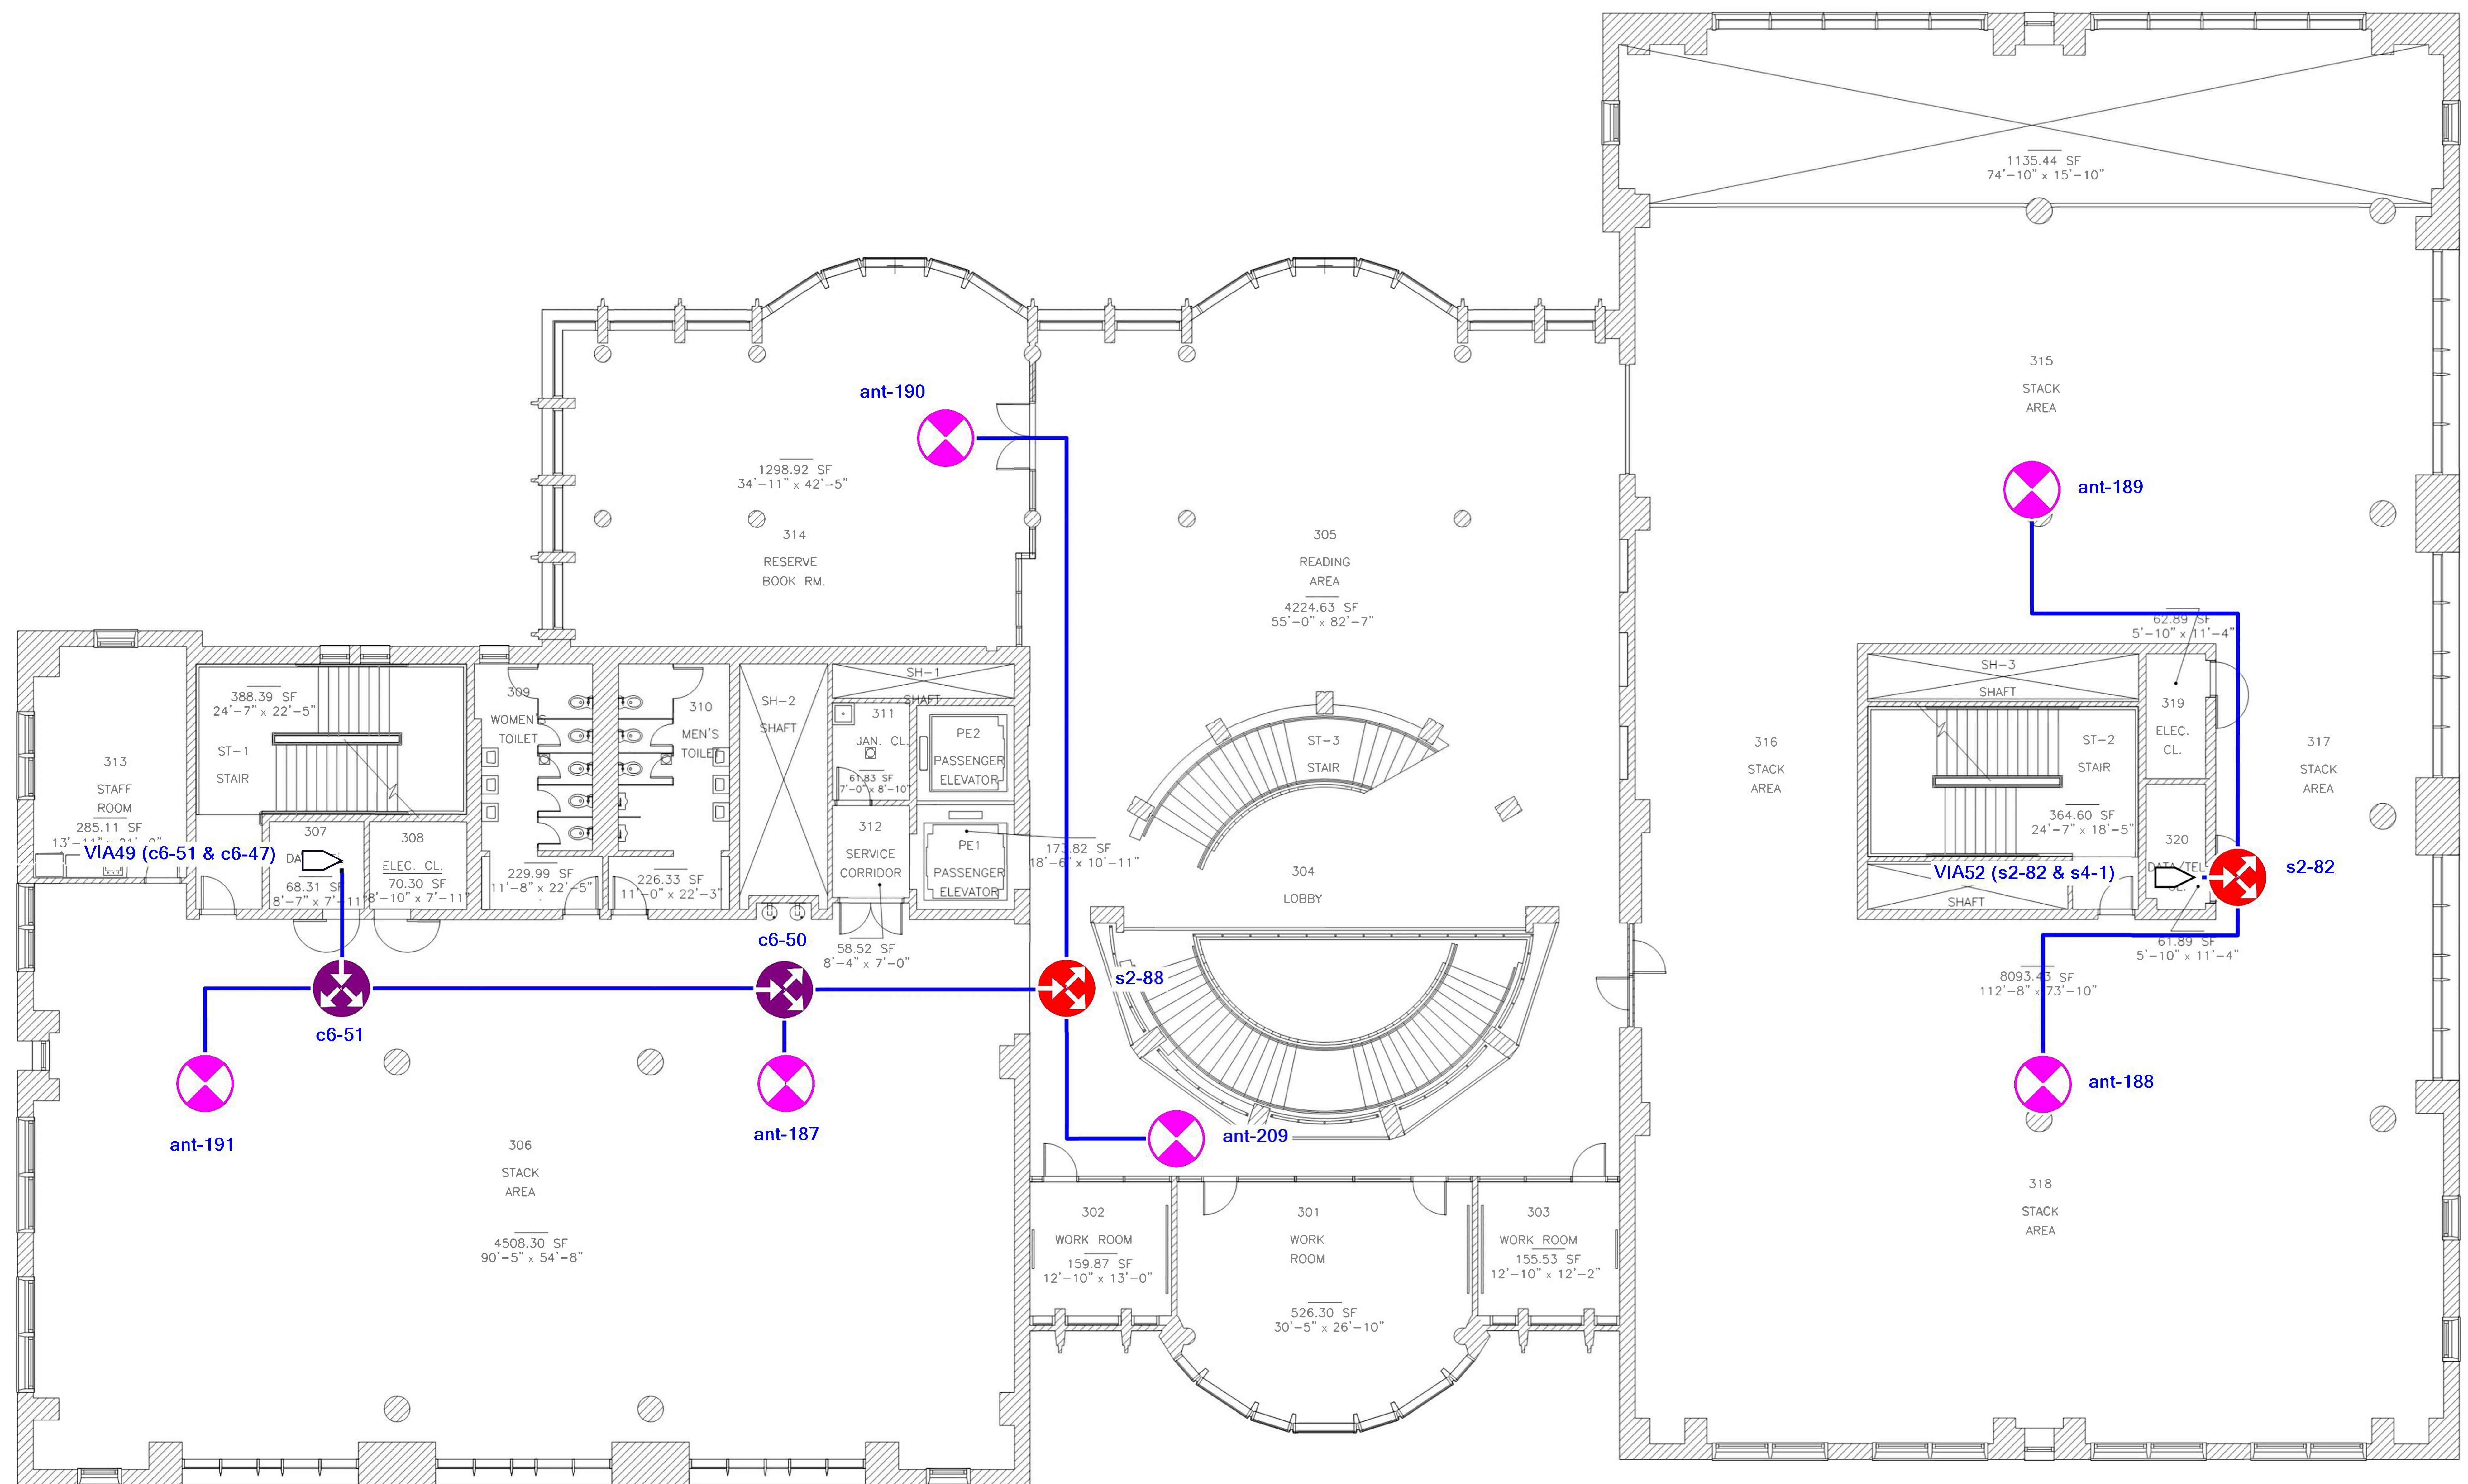

THIRD FLOOR
1/8" = 1'-0"

Indoor prediction legend

Pictograms legend


- 1/2" Coax
- Antenna
- 2-Way Splitter
- 3-Way Splitter
- 4-Way Splitter
- 6dB Coupler
- 10dB Coupler
- Remote Unit

Project name

United States Military Academy West Point

Designer name

Jefferson Hall - Third Floor

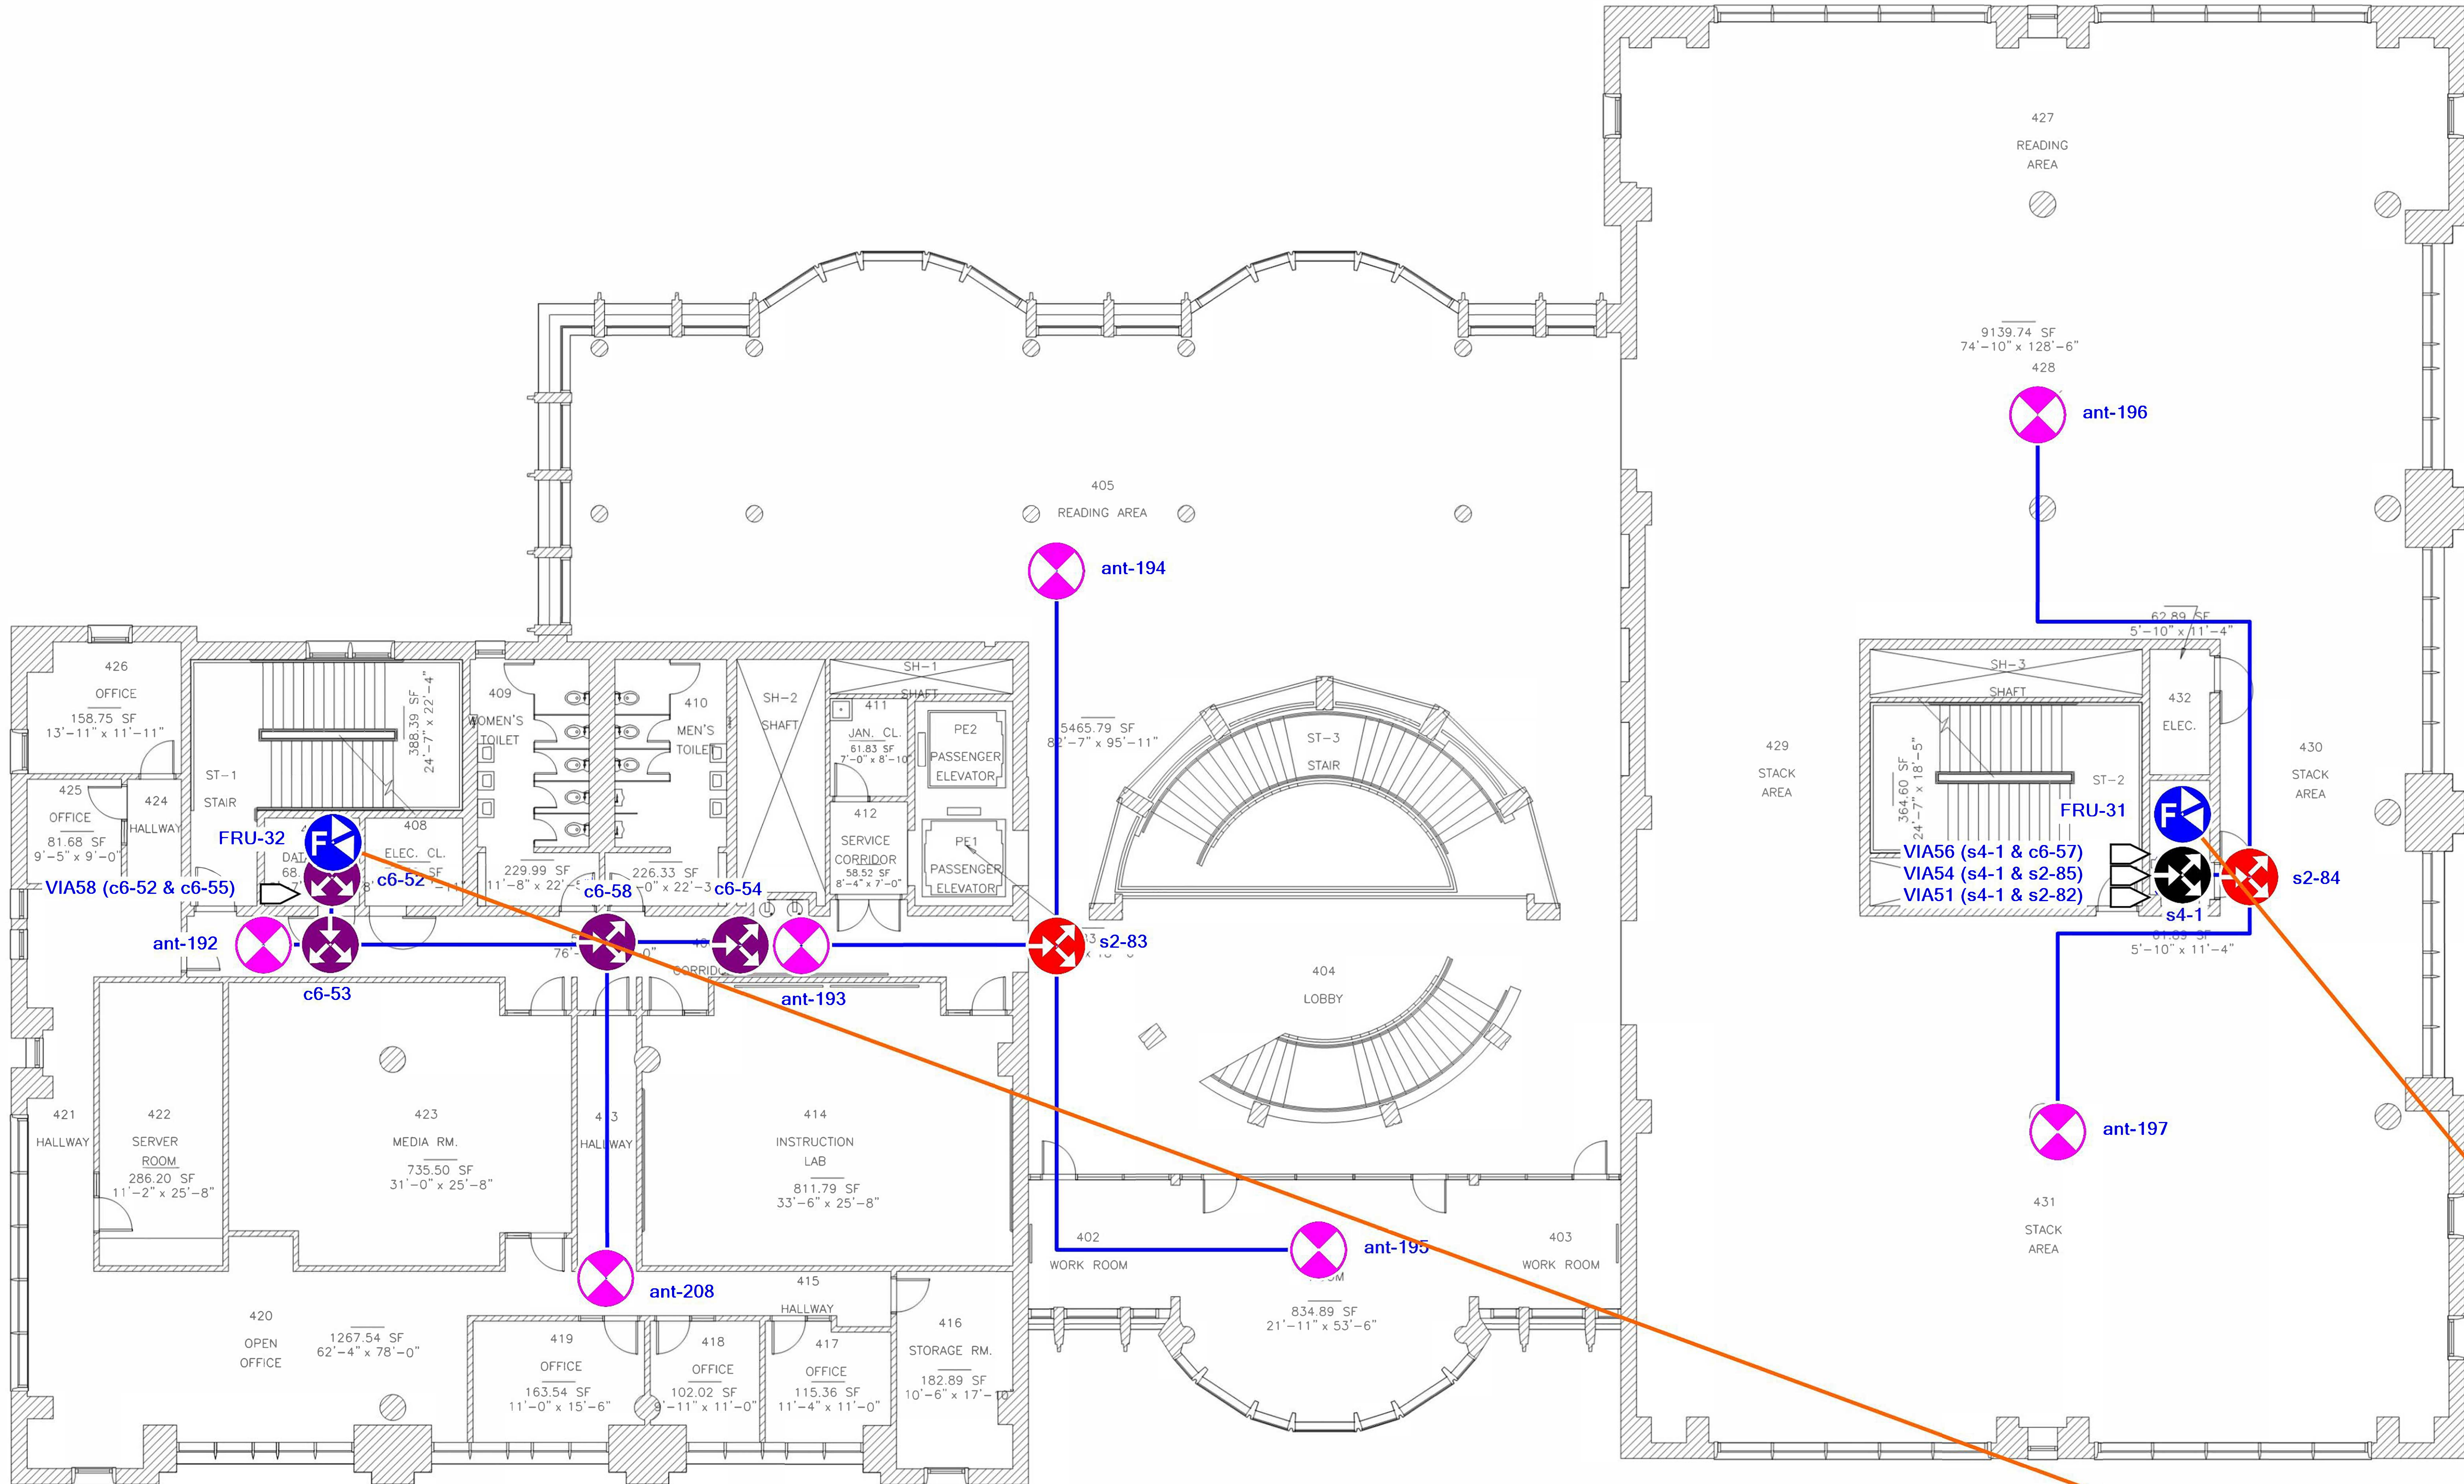

FOURTH FLOOR
1/8" = 1'-0"

Indoor prediction legend



Pictograms legend

- 1/2" Coax
- Antenna
- 2-Way Splitter
- 3-Way Splitter
- 4-Way Splitter
- 6dB Coupler
- 10dB Coupler
- Remote Unit

Project name

United States Military Academy West Point

Designer name

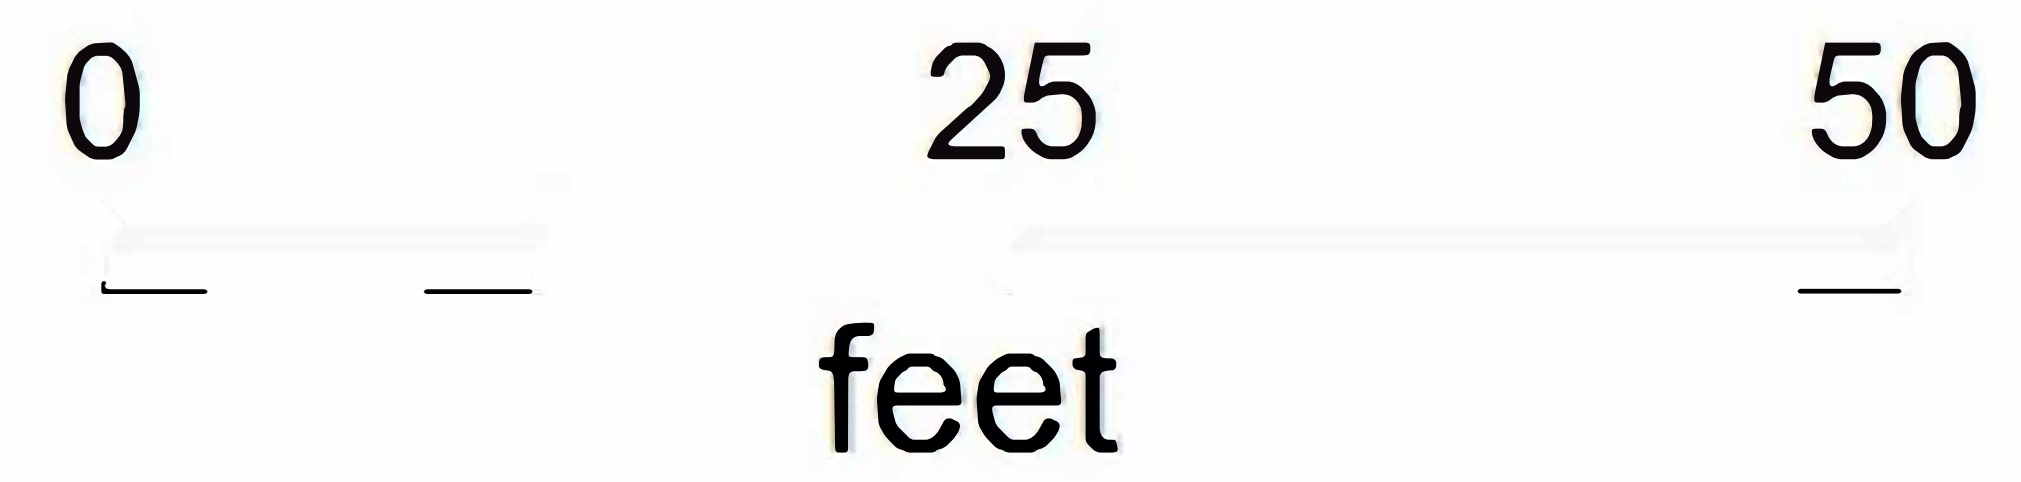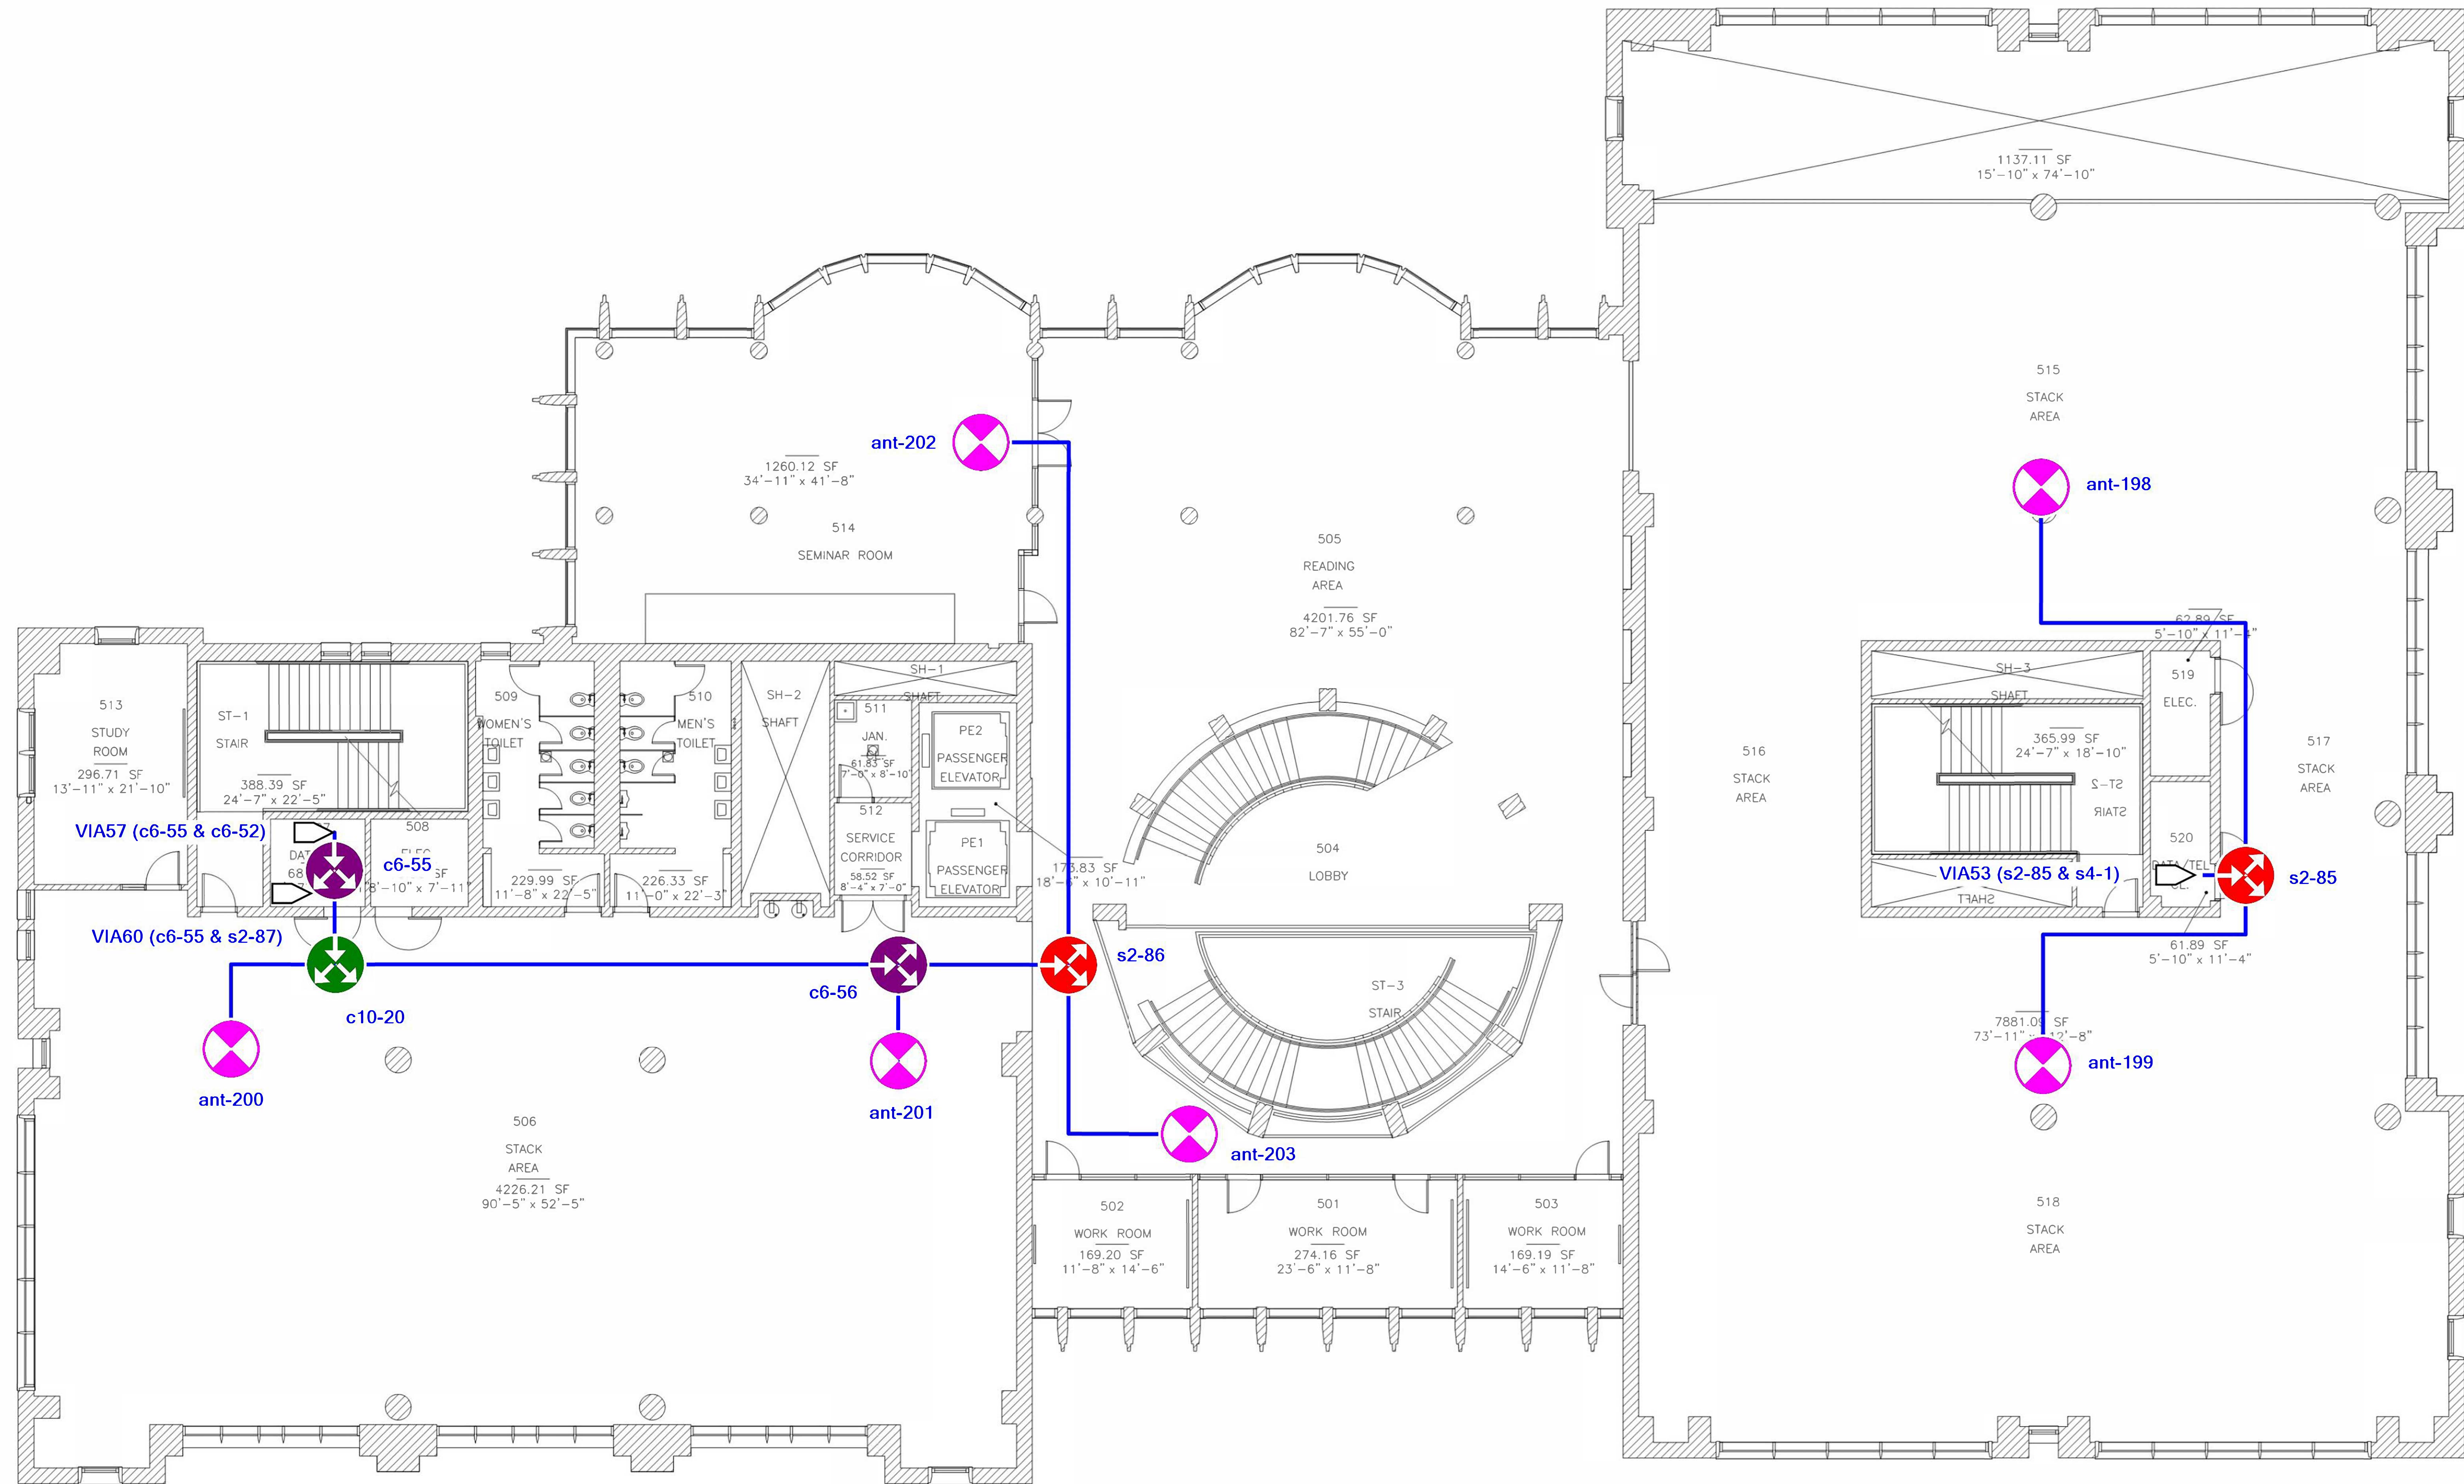

FIFTH FLOOR
1/8" = 1'-0"

Indoor prediction legend


Pictograms legend	
	1/2" Coax
	Antenna
	2-Way Splitter
	3-Way Splitter
	4-Way Splitter
	6dB Coupler
	10dB Coupler
	Remote Unit

Project name

United States Military Academy West Point

Designer name

Jefferson Hall - Fifth Floor

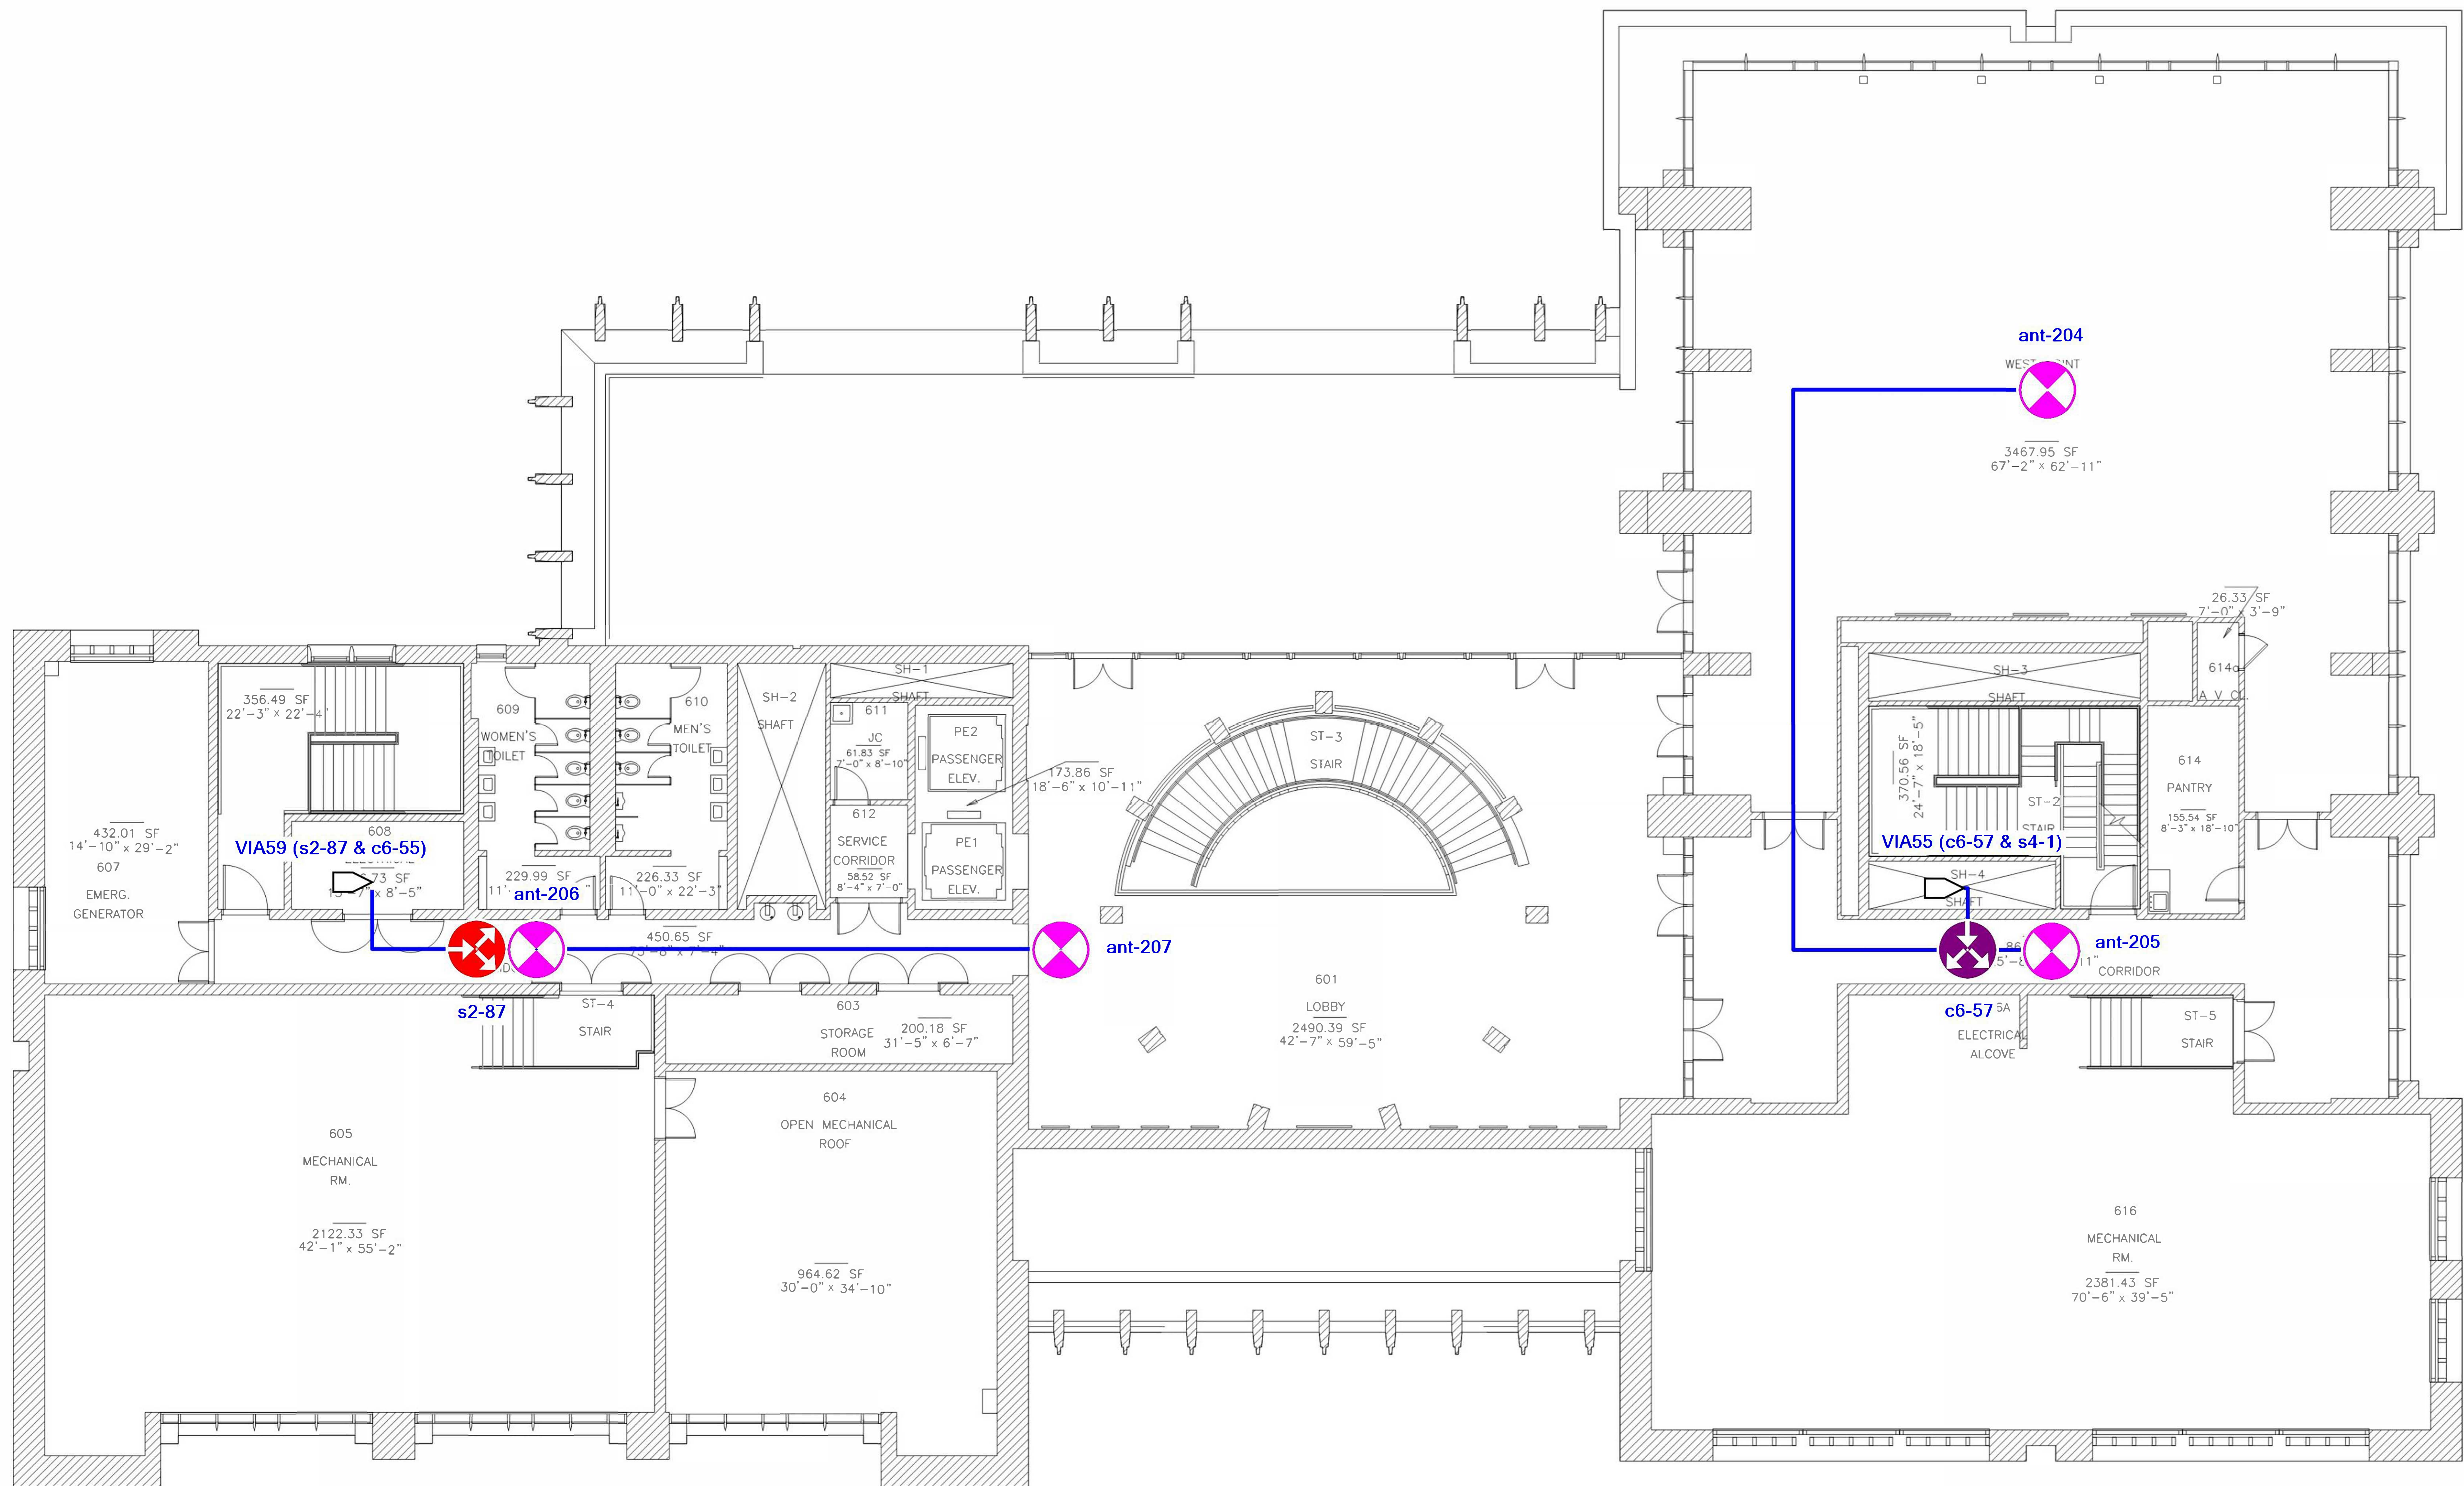

SIXTH FLOOR
1/8" = 1'-0"

Indoor prediction legend

Pictograms legend

- 1/2" Coax
- Antenna
- 2-Way Splitter
- 3-Way Splitter
- 4-Way Splitter
- 6dB Coupler
- 10dB Coupler
- Remote Unit

Project name

United States Military Academy West Point

Designer name