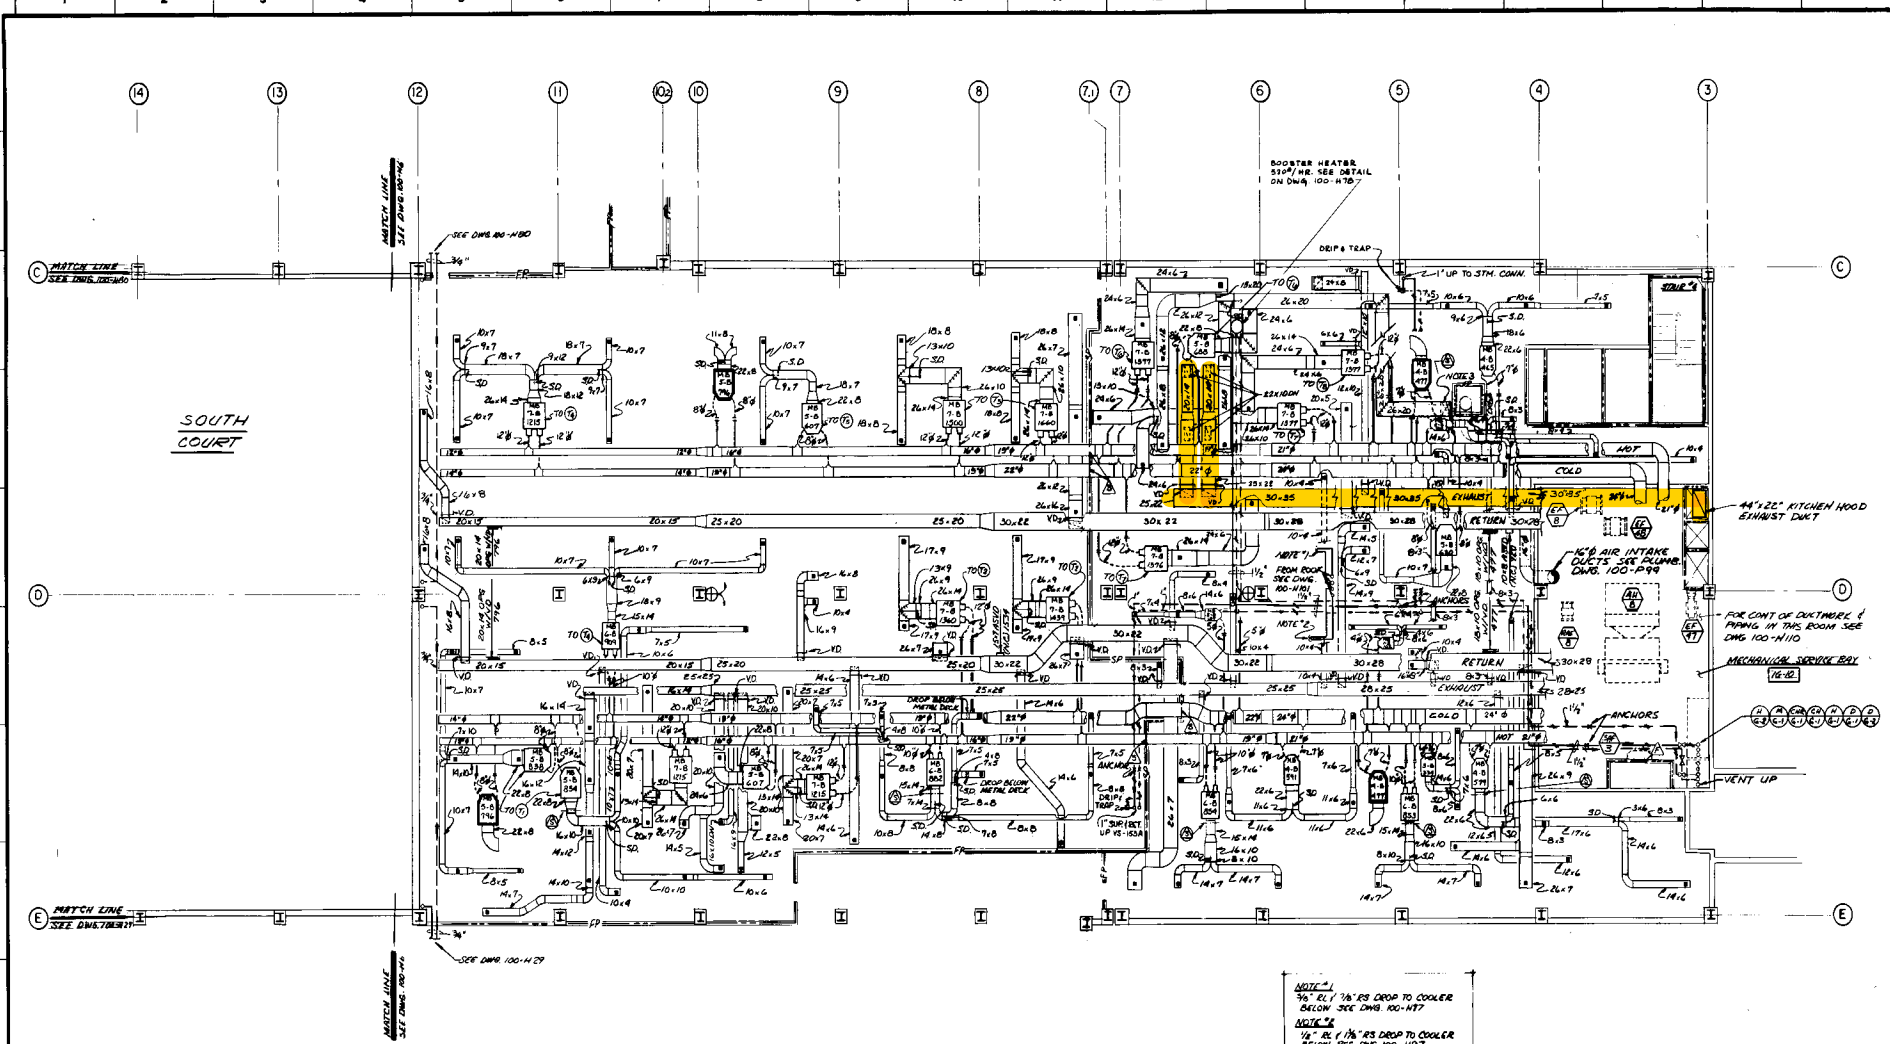



INTERSTITIAL PLAN FIRST FLOOR - AREA "G"
SCALE: 1/8" = 1'-0"

KEY PLAN

AS BUILT

BELLANTE, CLAUSS, MILLER AND NOLAN, INC.
CONSULTING ENGINEERS
130 NORTH WASHINGTON AVE., SCRANTON, PA. 18503

M.A.X. O. URBAHN ASSOC. INC.
ARCHITECTURE AND PLANNING
521 FIFTH AVE. - NEW YORK, N.Y. 10017

APPROVED PROJECT DIRECTOR

INTERSTITIAL PLAN
FIRST FLOOR — AREA G
BUILDING NO. 100

REPLACEMENT HOSPITAL PHASE VIII

VETERANS ADMINISTRATION
V.A.H., BRONX, N.Y.

Drawn L.W. Proj. Mgr. A.J.O.
Checked D.C. Date DEC. 8, 1975

REVISIONS

DRAWING NUMBER 100-H'98

Sheet of

Proj. No. 526-079

5-8-2-0102

THREE INCHES EQUALS ONE FOOT
ONE AND ONE HALF INCHES EQUALS ONE FOOT
ONE INCH EQUALS ONE FOOT
THREE QUARTER INCH EQUALS ONE FOOT
ONE HALF INCH EQUALS ONE FOOT
THREE EIGHTH INCH EQUALS ONE FOOT
ONE QUARTER INCH EQUALS ONE FOOT
ONE EIGHTH INCH EQUALS ONE FOOT